



221.80 Ha WIND POWER PROJECT  
AT GIM1 SITE CHITRADURGA (DIST), KARNATAKA STATE.  
AS BUILT DRAWING SUPERIMPOSED ON VILLAGE MAP  
FOR VILLAGE DODDAPURA AT GIM1 SITE


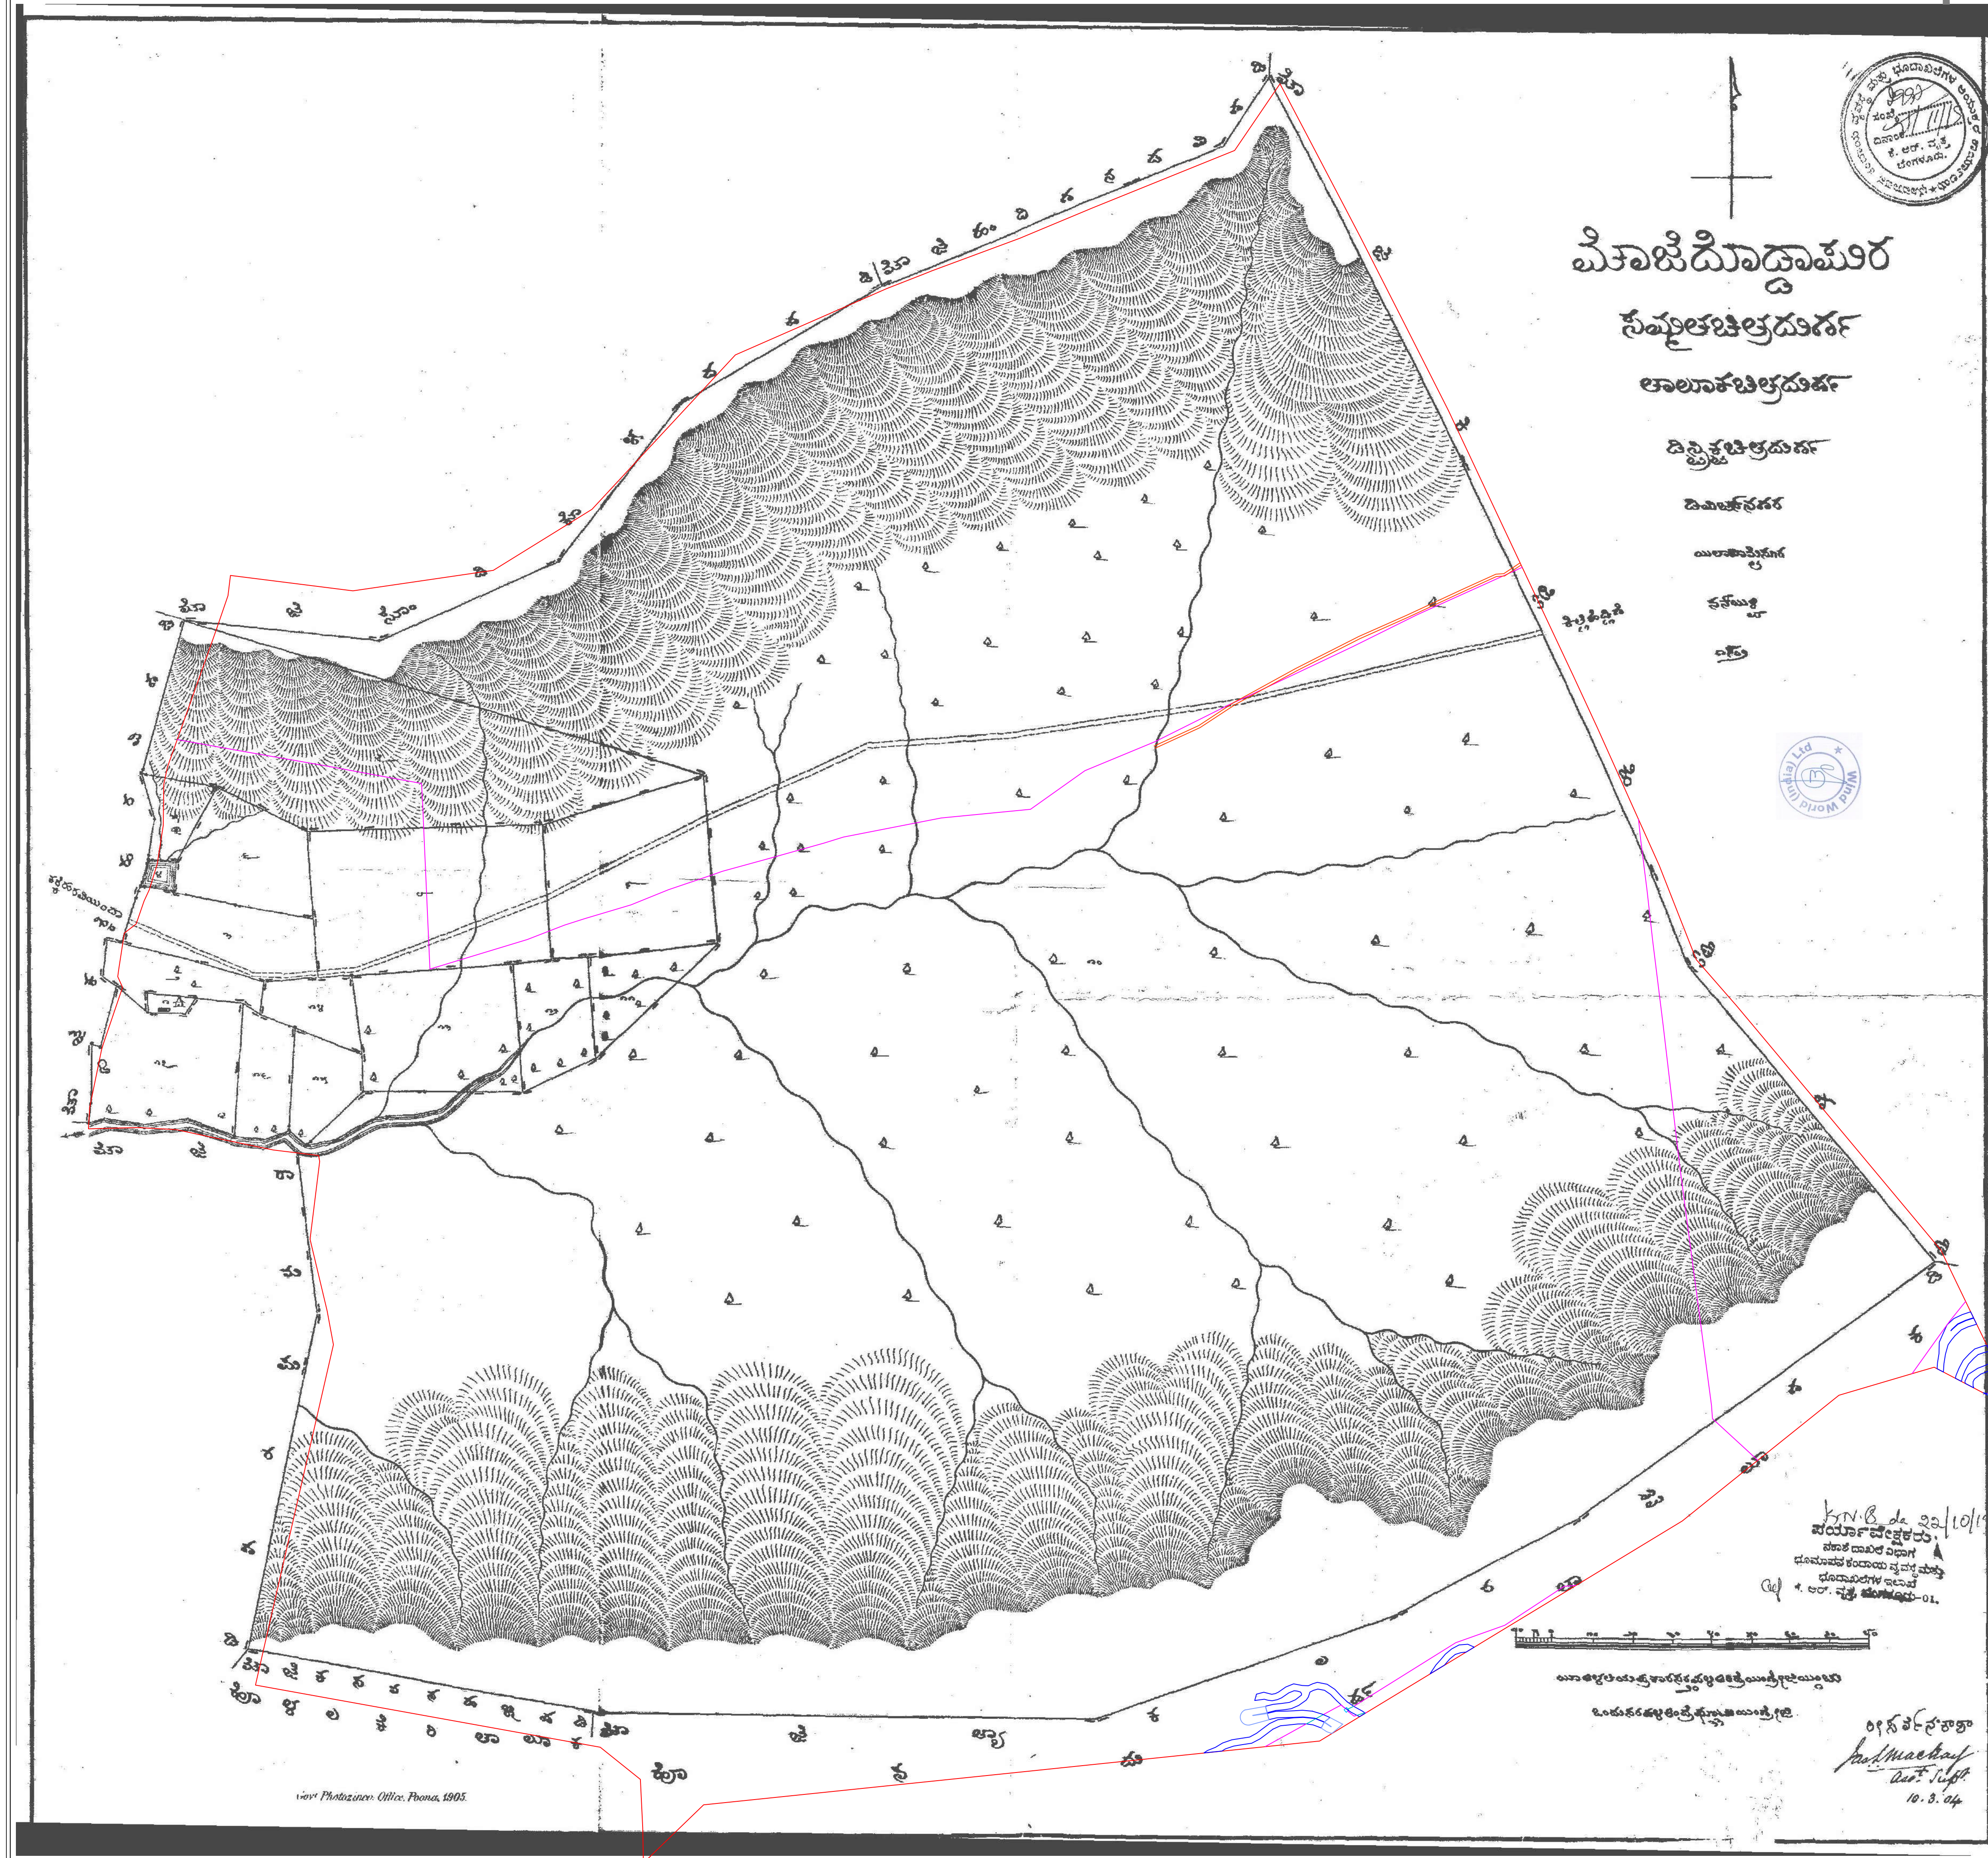


AS BUILT FEATURES	
FEATURE TYPE	LEGEND
	VILLAGE BOUNDARY
	FOREST AS BUILT ROAD
	NON FOREST ROAD
	INSIDE PLATFORM ROAD
	FOREST AS BUILT ELECTRIC LINE
	NON FOREST ELECTRIC LINE
	INSIDE ROAD ELECTRIC LINE
	FOREST AS BUILT VCB YARD
	NON FOREST VCB YARD
	FOREST AS BUILT PLATFORM AREA WITH NOS
	NOS.FOR COORDINATES OF ROAD & EP LINE

WIND WORLD (INDIA) LTD	
-- formerly known as --	
Scale:- 1 : 7920	
PROJECT:- WIND POWER PROJECT	
AT GIM1 SITE CHITRADURGA (DIST)	
KARNATAKA STATE	
TITLE:- VILLAGE MAP FOR DODDAPURA VILLAGE	
DRAWING NO:- KAR/GIM1/1	ASBUILT-1/1

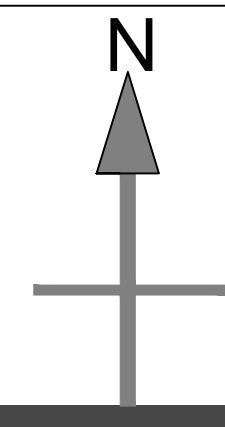

221.80 Ha WIND POWER PROJECT  
AT GIM1 SITE CHITRADURGA (DIST), KARNATAKA STATE.  
AS BUILT DRAWING SUPERIMPOSED ON VILLAGE MAP  
FOR VILLAGE KAKKEHARAVU AT GIM1 SITE

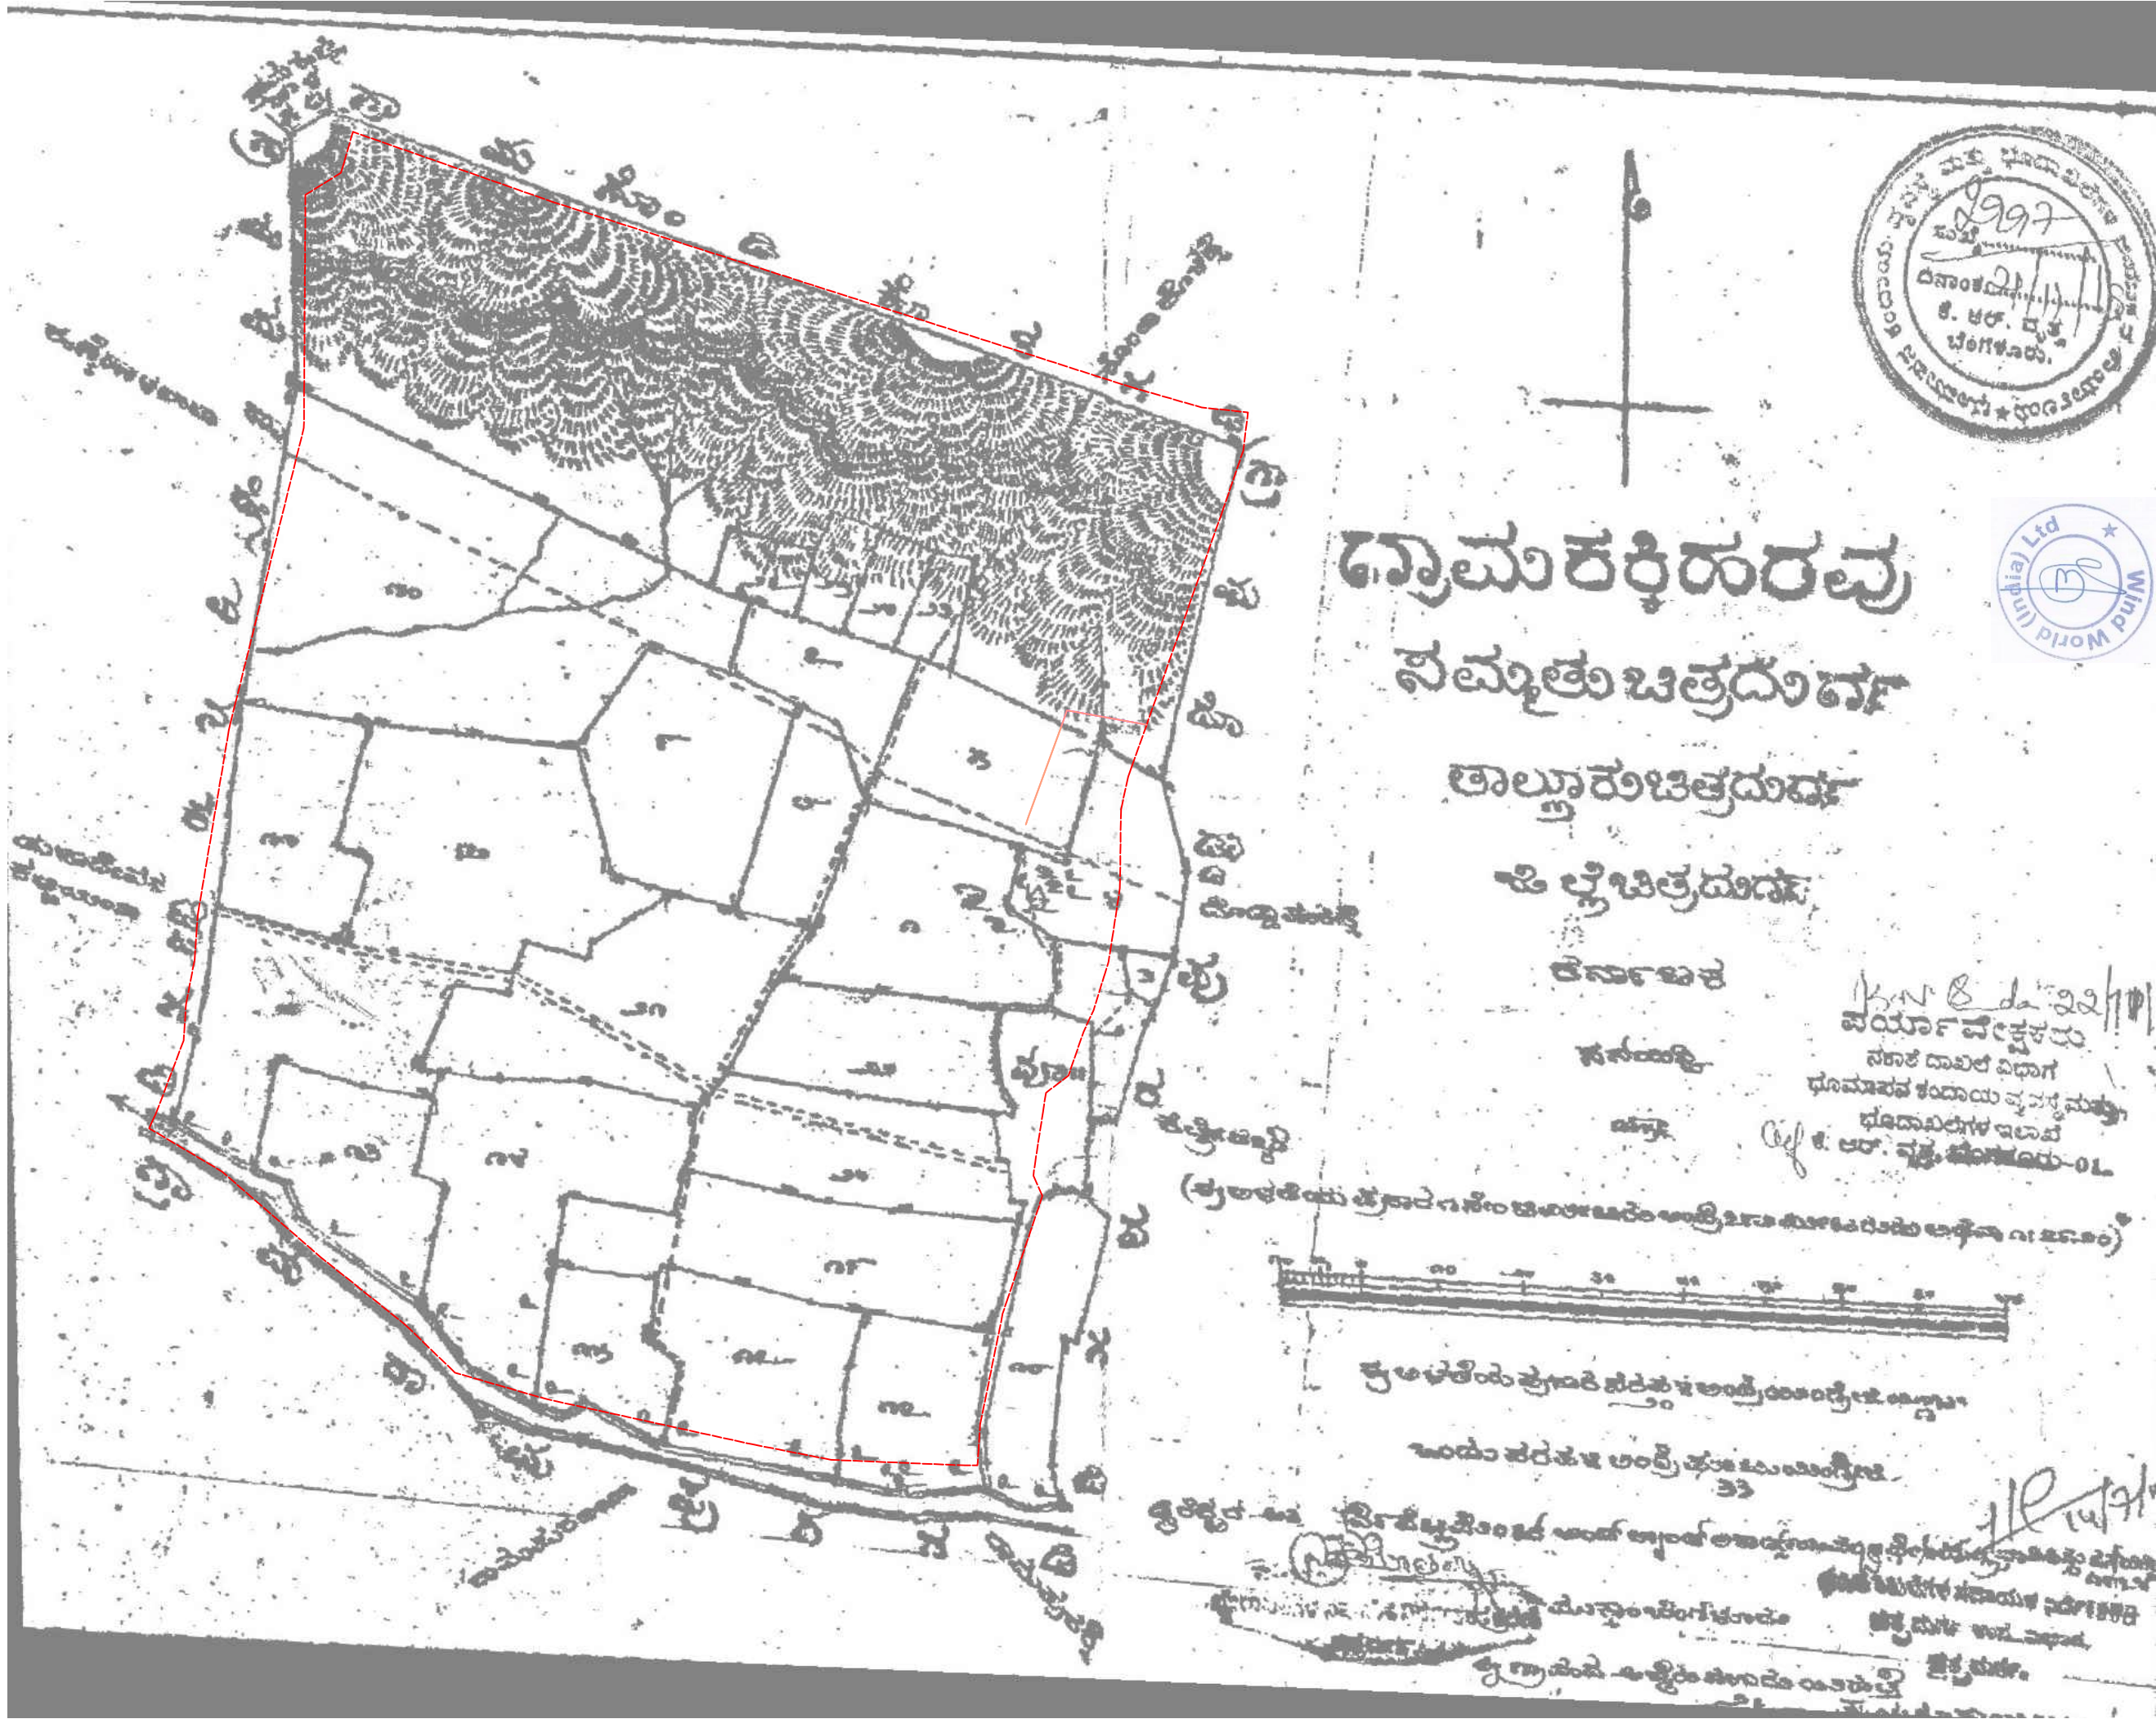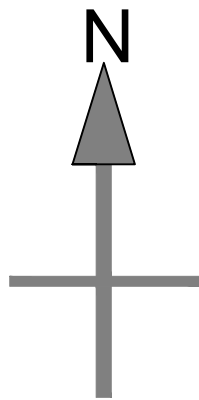

AS BUILT FEATURES	
FEATURE TYPE	LEGEND
-----	VILLAGE BOUNDARY
-----	FOREST AS BUILT ROAD
-----	NON FOREST ROAD
-----	INSIDE PLATFORM ROAD
-----	FOREST AS BUILT ELECTRIC LINE
-----	NON FOREST ELECTRIC LINE
-----	INSIDE ROAD ELECTRIC LINE
-----	FOREST AS BUILT VCB YARD
-----	NON FOREST VCB YARD
PL1	FOREST AS BUILT PLATFORM AREA WITH NOS
1 1	NOS.FOR COORDINATES OF ROAD & EP LINE



WIND WORLD (INDIA) LTD

-- formerly known as --

Scale:- 1 : 7920

PROJECT:- WIND POWER PROJECT  
AT GIM1 SITE CHITRADURGA (DIST)  
KARNATAKA STATE



TITLE:- VILLAGE MAP FOR KAKKEHARAVU VILLAGE

DRAWING NO.:- KAR/GIM1/1

ASBULT-1/1




221.80 Ha WIND POWER PROJECT  
AT GIM1 SITE CHITRADURGA (DIST), KARNATAKA STATE.  
AS BUILT DRAWING SUPERIMPOSED ON VILLAGE MAP  
FOR VILLAGE KALLEHADLU AT GIM1 SITE

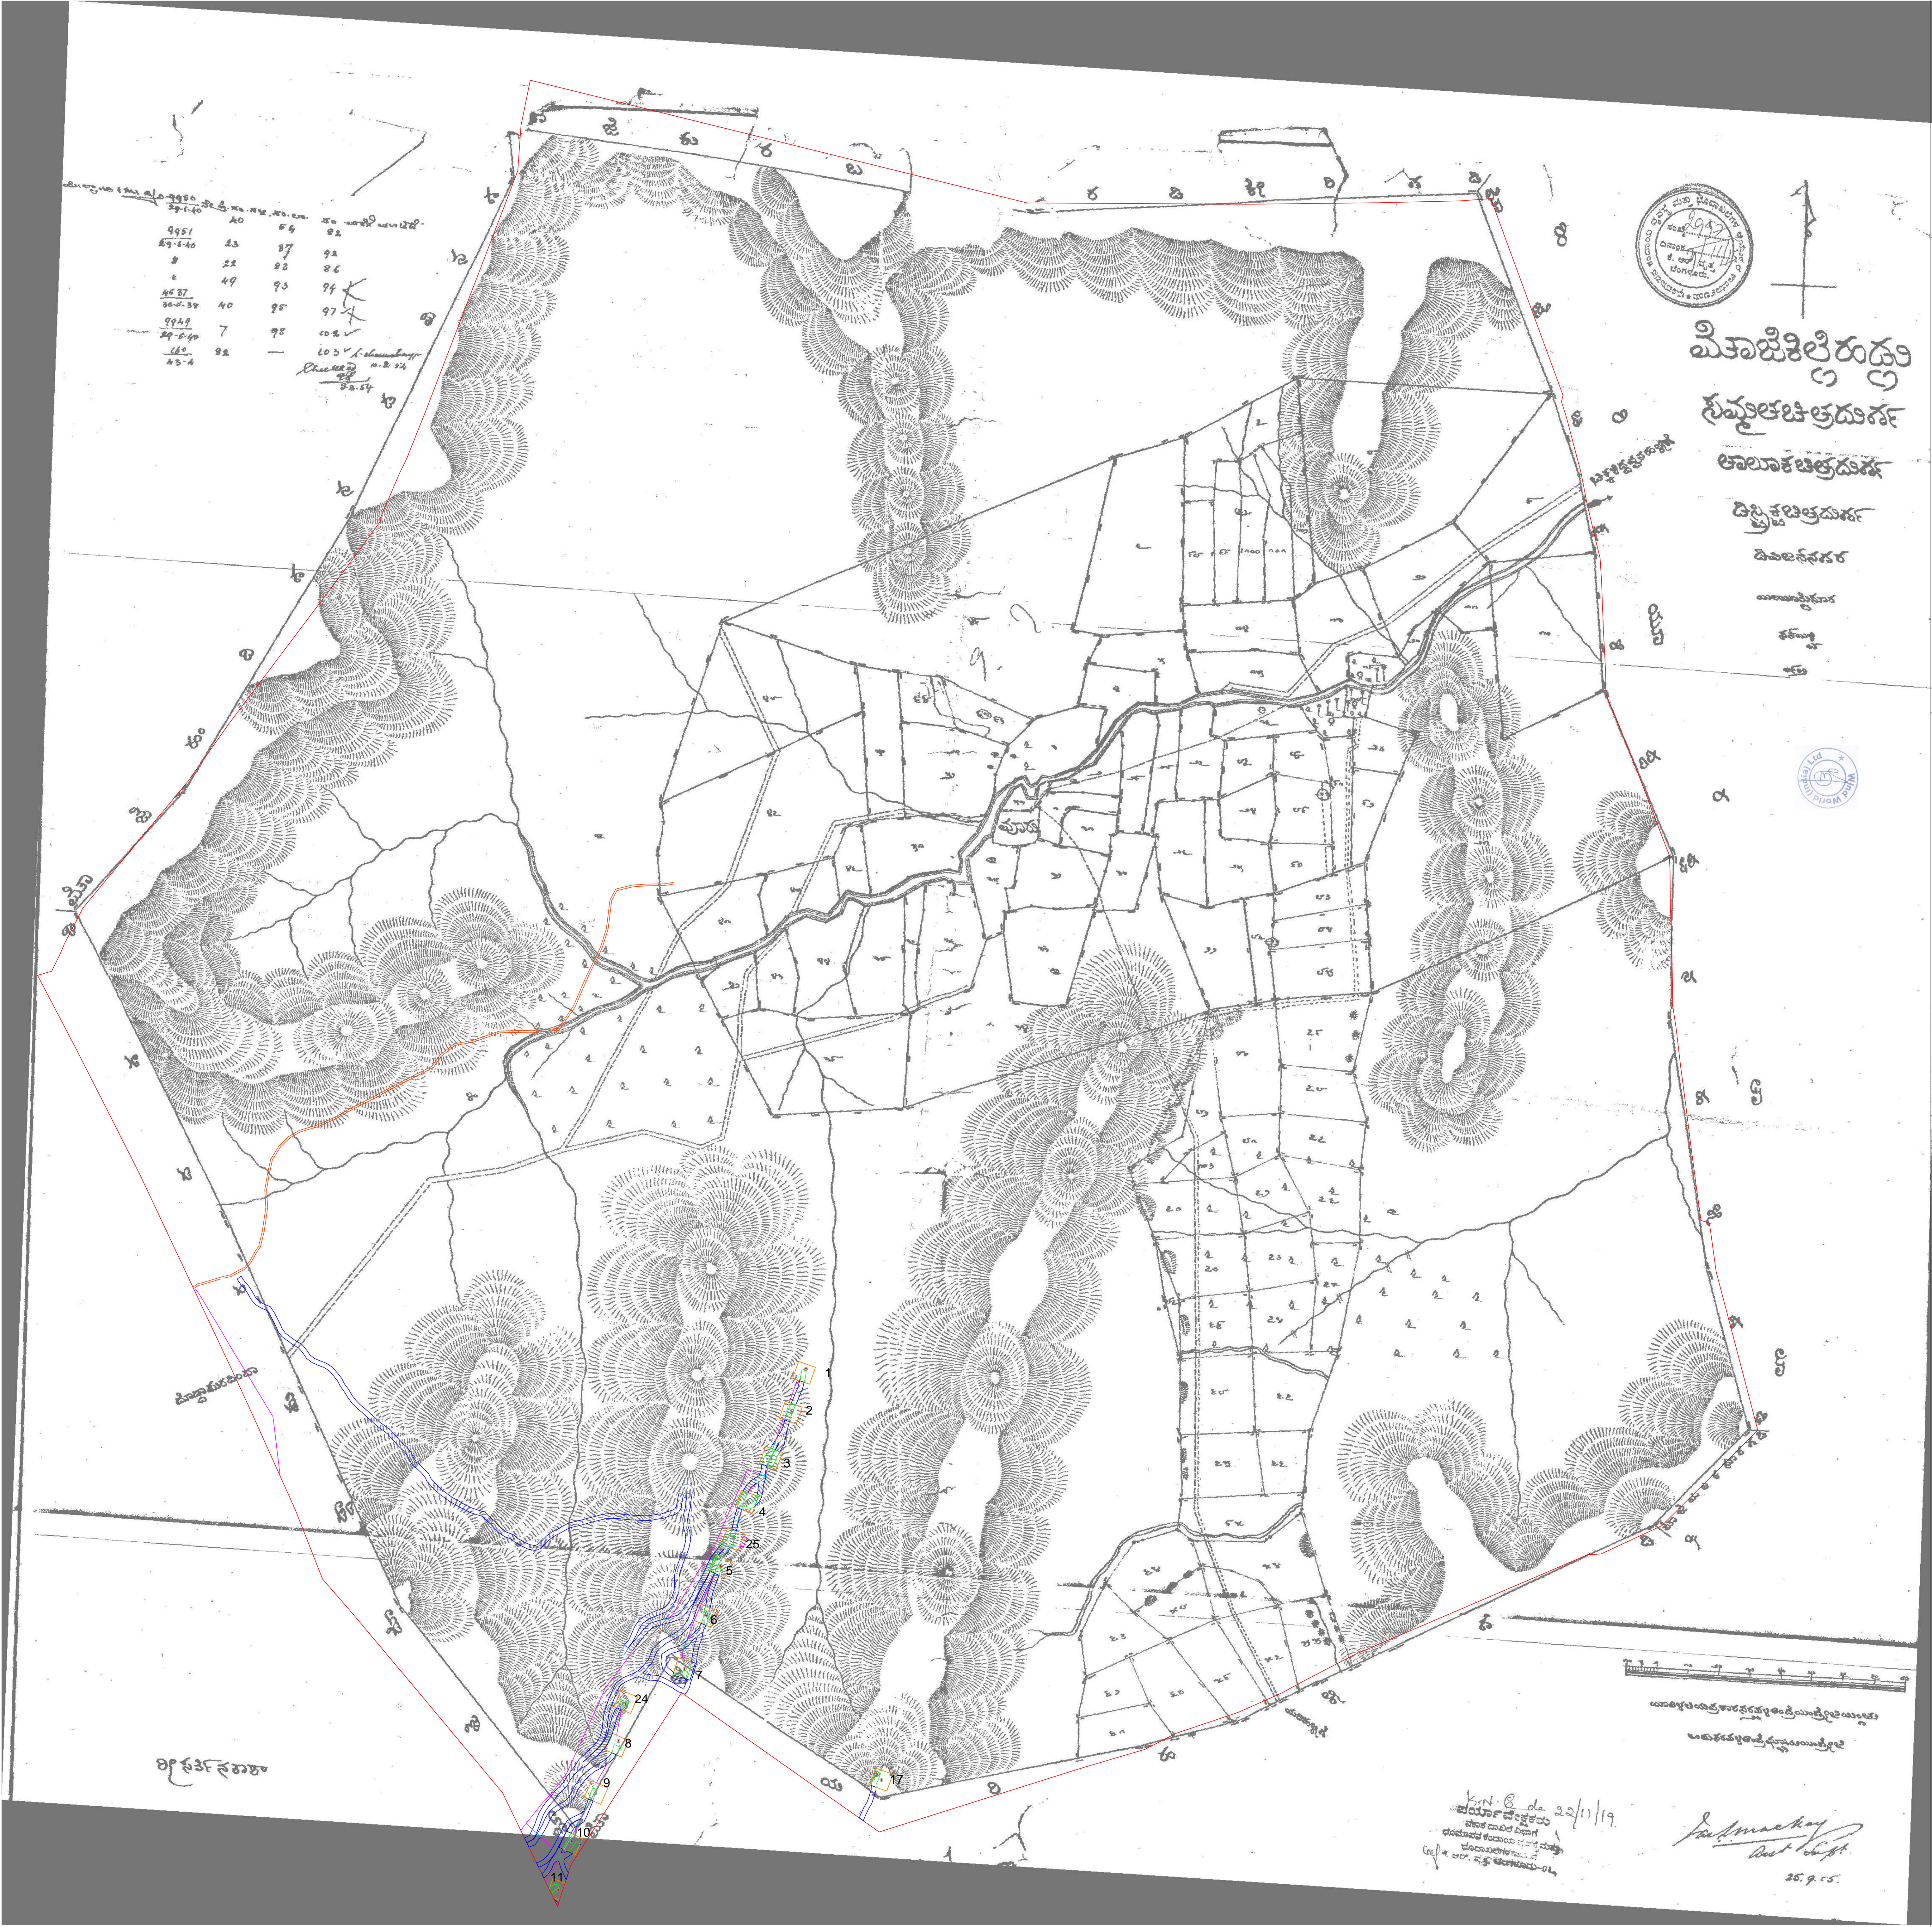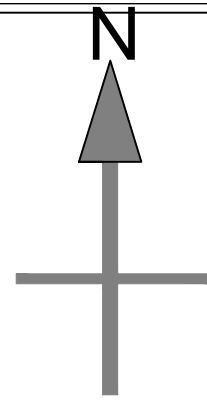


AS BUILT FEATURES	
FEATURE TYPE	LEGEND
	VILLAGE BOUNDARY
	FOREST AS BUILT ROAD
	NON FOREST ROAD
	INSIDE PLATFORM ROAD
	FOREST AS BUILT ELECTRIC LINE
	NON FOREST ELECTRIC LINE
	INSIDE ROAD ELECTRIC LINE
	FOREST AS BUILT VCB YARD
	NON FOREST VCB YARD
	FOREST AS BUILT PLATFORM AREA WITH NOS
	NOS.FOR COORDINATES OF ROAD & EF LINE

WIND WORLD (INDIA) LTD	
-- formerly known as --	
Scale:-	1 : 7920
PROJECT:-	WIND POWER PROJECT AT GIM1 SITE CHITRADURGA (DIST) KARNATAKA STATE
TITLE:-	VILLAGE MAP FOR KALLEHADLU VILLAGE
DRAWING NO.:-	KAR/GIM1/1
	ASBUILT-1/1





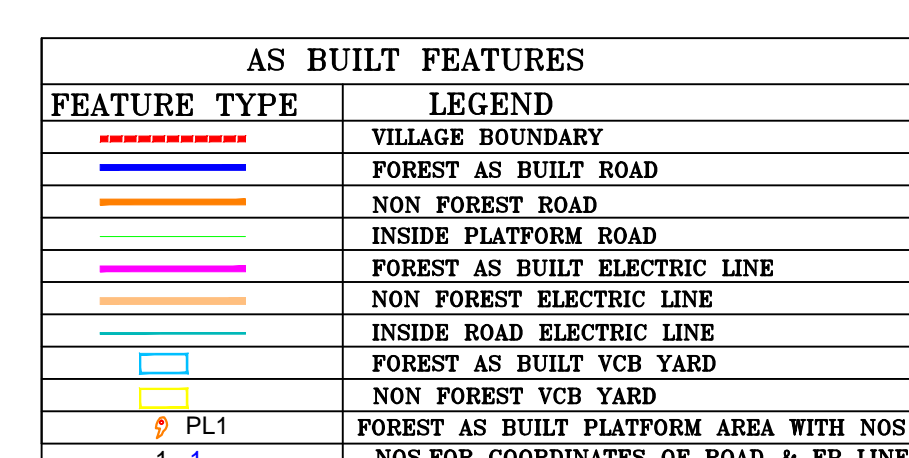







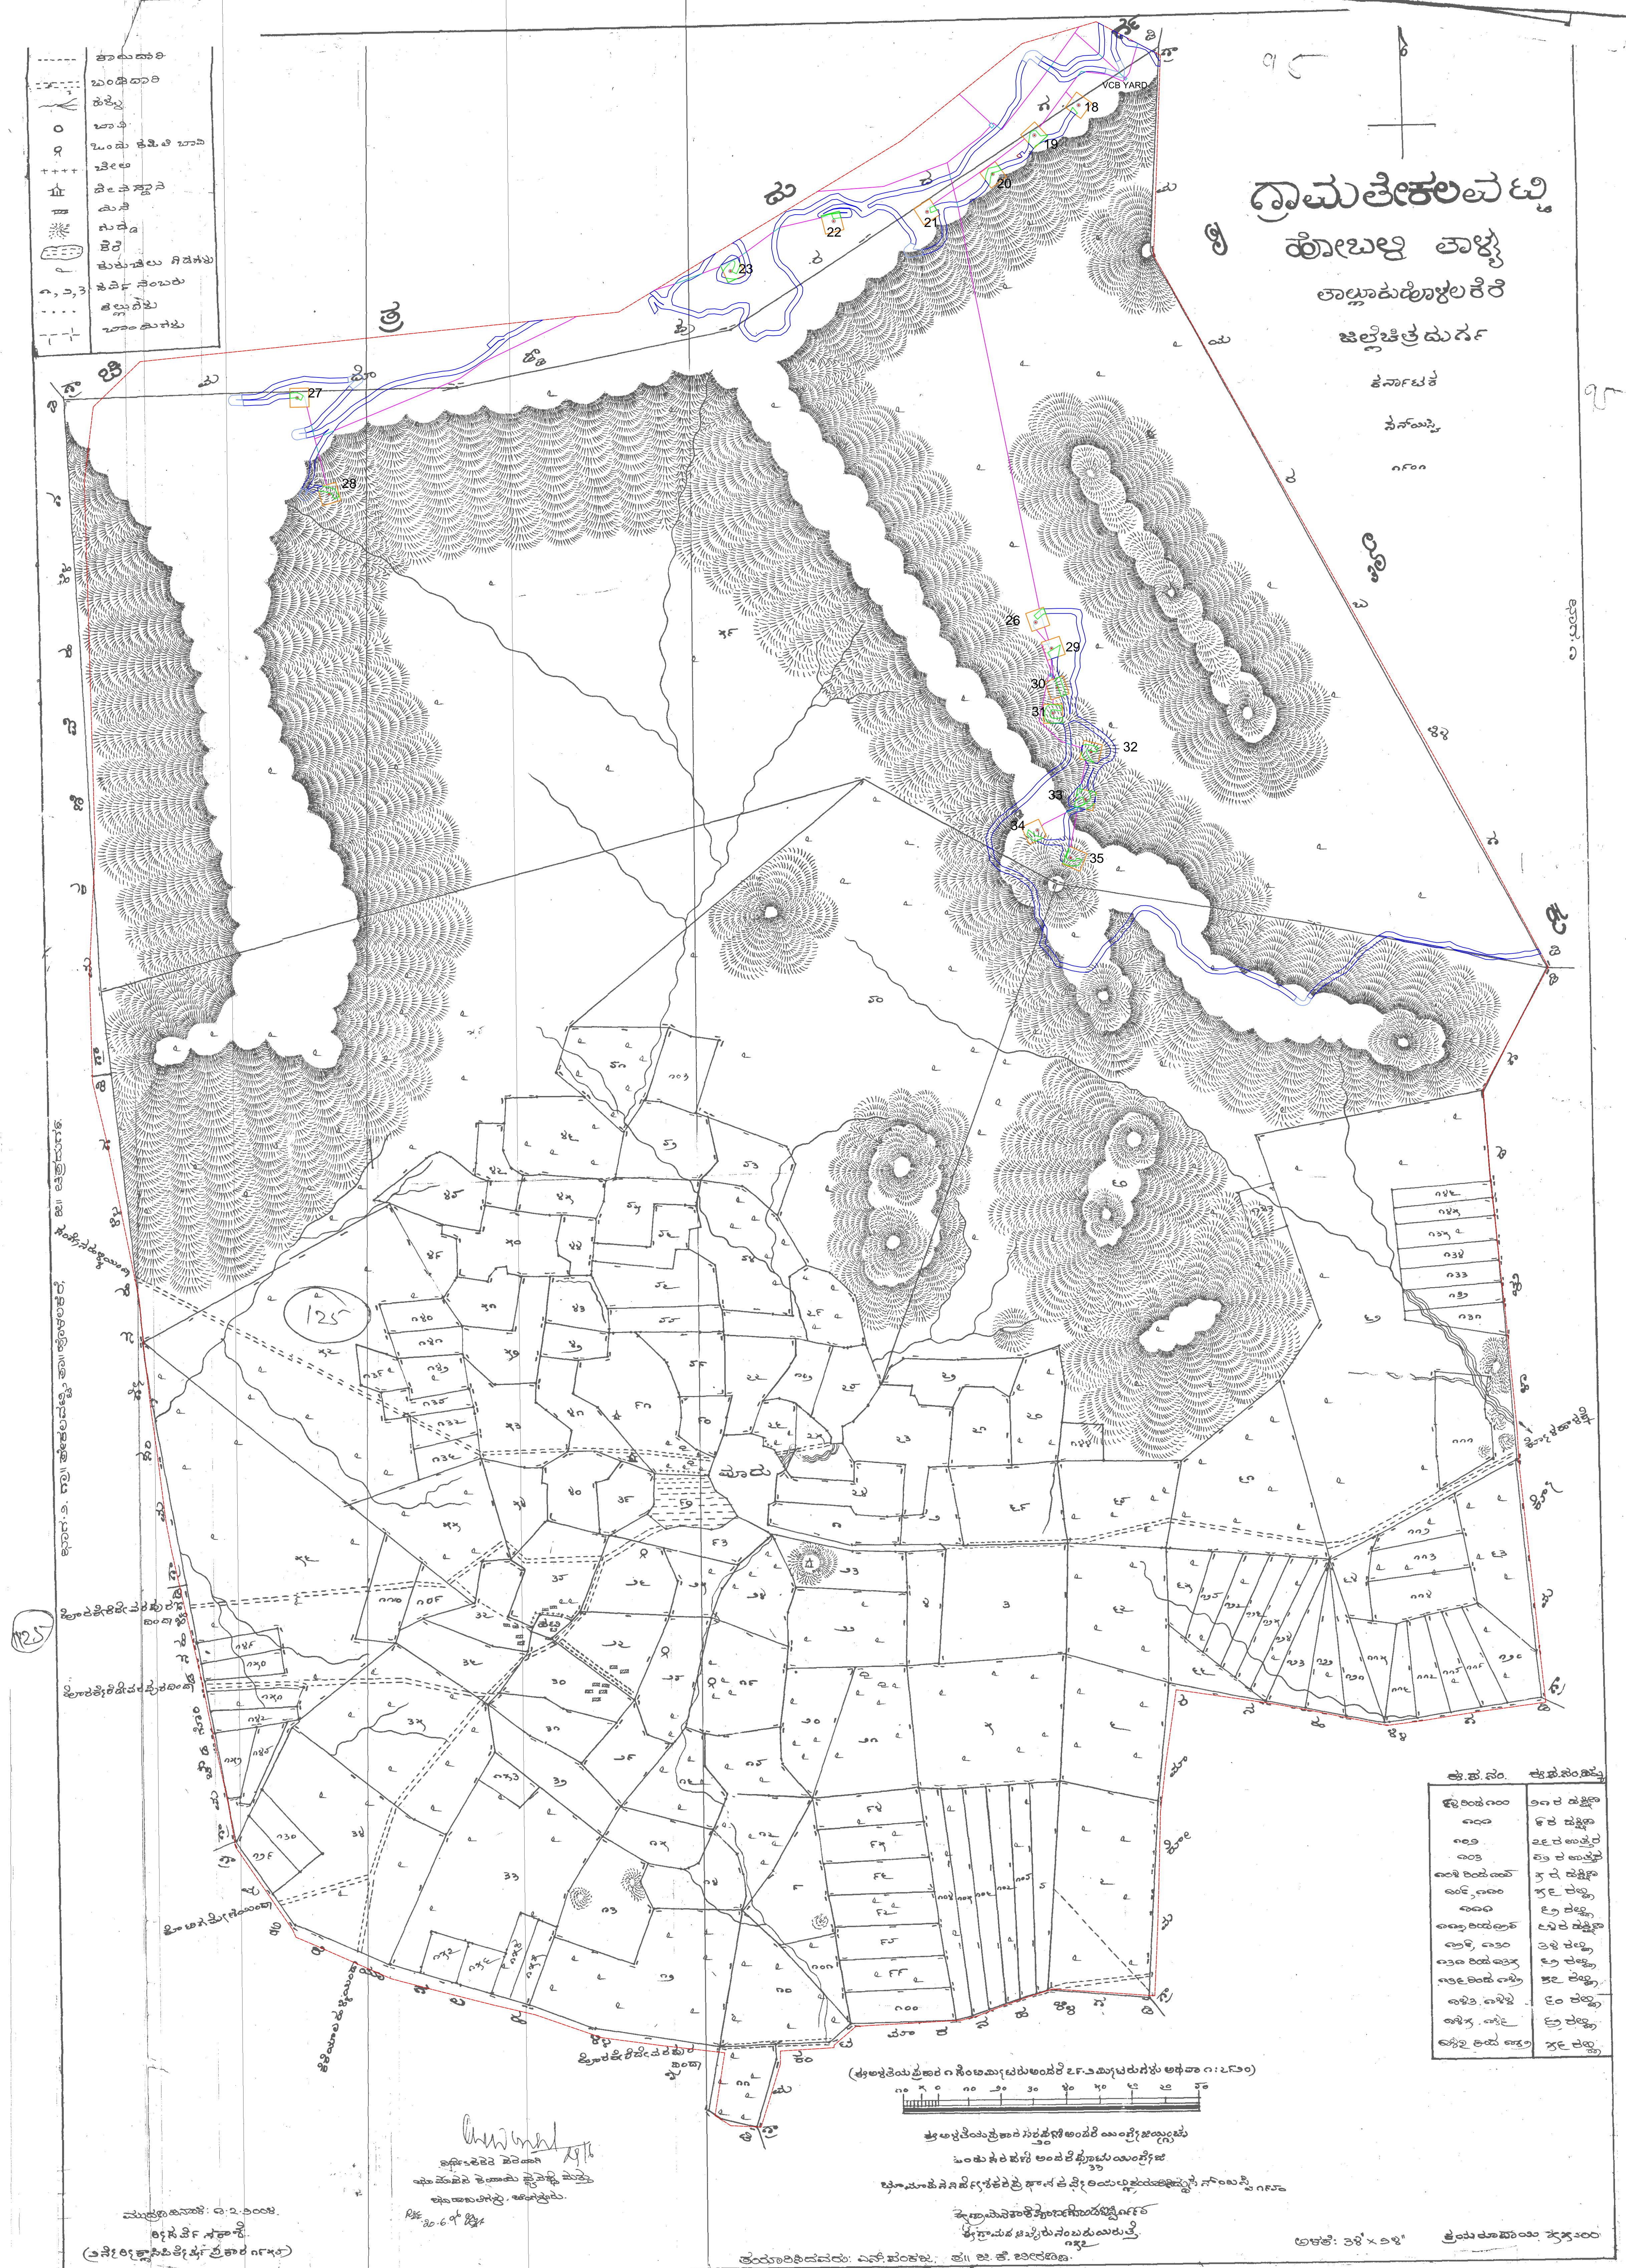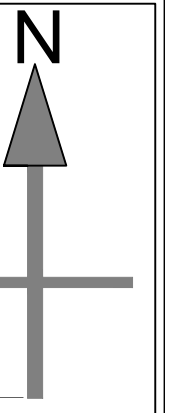


 <b>WIND WORLD (INDIA) LTD</b> <i>-- formerly known as --</i>		
Scale:- 1 : 7920		
<b>PROJECT:-</b>	<b>WIND POWER PROJECT</b> <b>AT GIMI SITE CHITRADURGA (DIST)</b> <b>KARNATAKA STATE</b>	
<b>TITLE:-</b>	<b>VILLAGE MAP FOR KOLALU VILLAGE</b>	
<b>DRAWING NO.:-</b>	<b>KAR/GIM/1</b>	<b>ASBUT-1/1</b>



221.80 Ha WIND POWER PROJECT  
AT GIM1 SITE CHITRADURGA (DIST), KARNATAKA STATE.  
AS BUILT DRAWING SUPERIMPOSED ON VILLAGE MAP  
FOR VILLAGE THEKALAVATTI AT GIM1 SITE





AS BUILT FEATURES	
FEATURE TYPE	LEGEND
	VILLAGE BOUNDARY
	FOREST AS BUILT ROAD
	NON FOREST ROAD
	INSIDE PLATFORM ROAD
	FOREST AS BUILT ELECTRIC LINE
	NON FOREST ELECTRIC LINE
	INSIDE ROAD ELECTRIC LINE
	FOREST AS BUILT VCB YARD
	NON FOREST VCB YARD
 PL1	FOREST AS BUILT PLATFORM AREA WITH NOS

 <b>WIND WORLD (INDIA) LTD</b>	
<i>-- formerly known as --</i>	
<b>Scale:- 1 : 7920</b>	
<b>PROJECT:-</b>	<b>WIND POWER PROJECT AT GIMI SITE CHITRADURGA (DIST) KARNATAKA STATE</b>
<b>TITLE:-</b>	<b>VILLAGE MAP FOR THEKALAVATTI VILLAGE</b>
<b>DRAWING NO.</b>	<b>THIS DRAWING IS</b>



221.80 Ha WIND POWER PROJECT  
AT GIM1 SITE CHITRADURGA (DIST), KARNATAKA STATE.  
AS BUILT DRAWING SUPERIMPOSED ON VILLAGE MAP  
FOR VILLAGE YAREHALLI AT GIM1 SITE

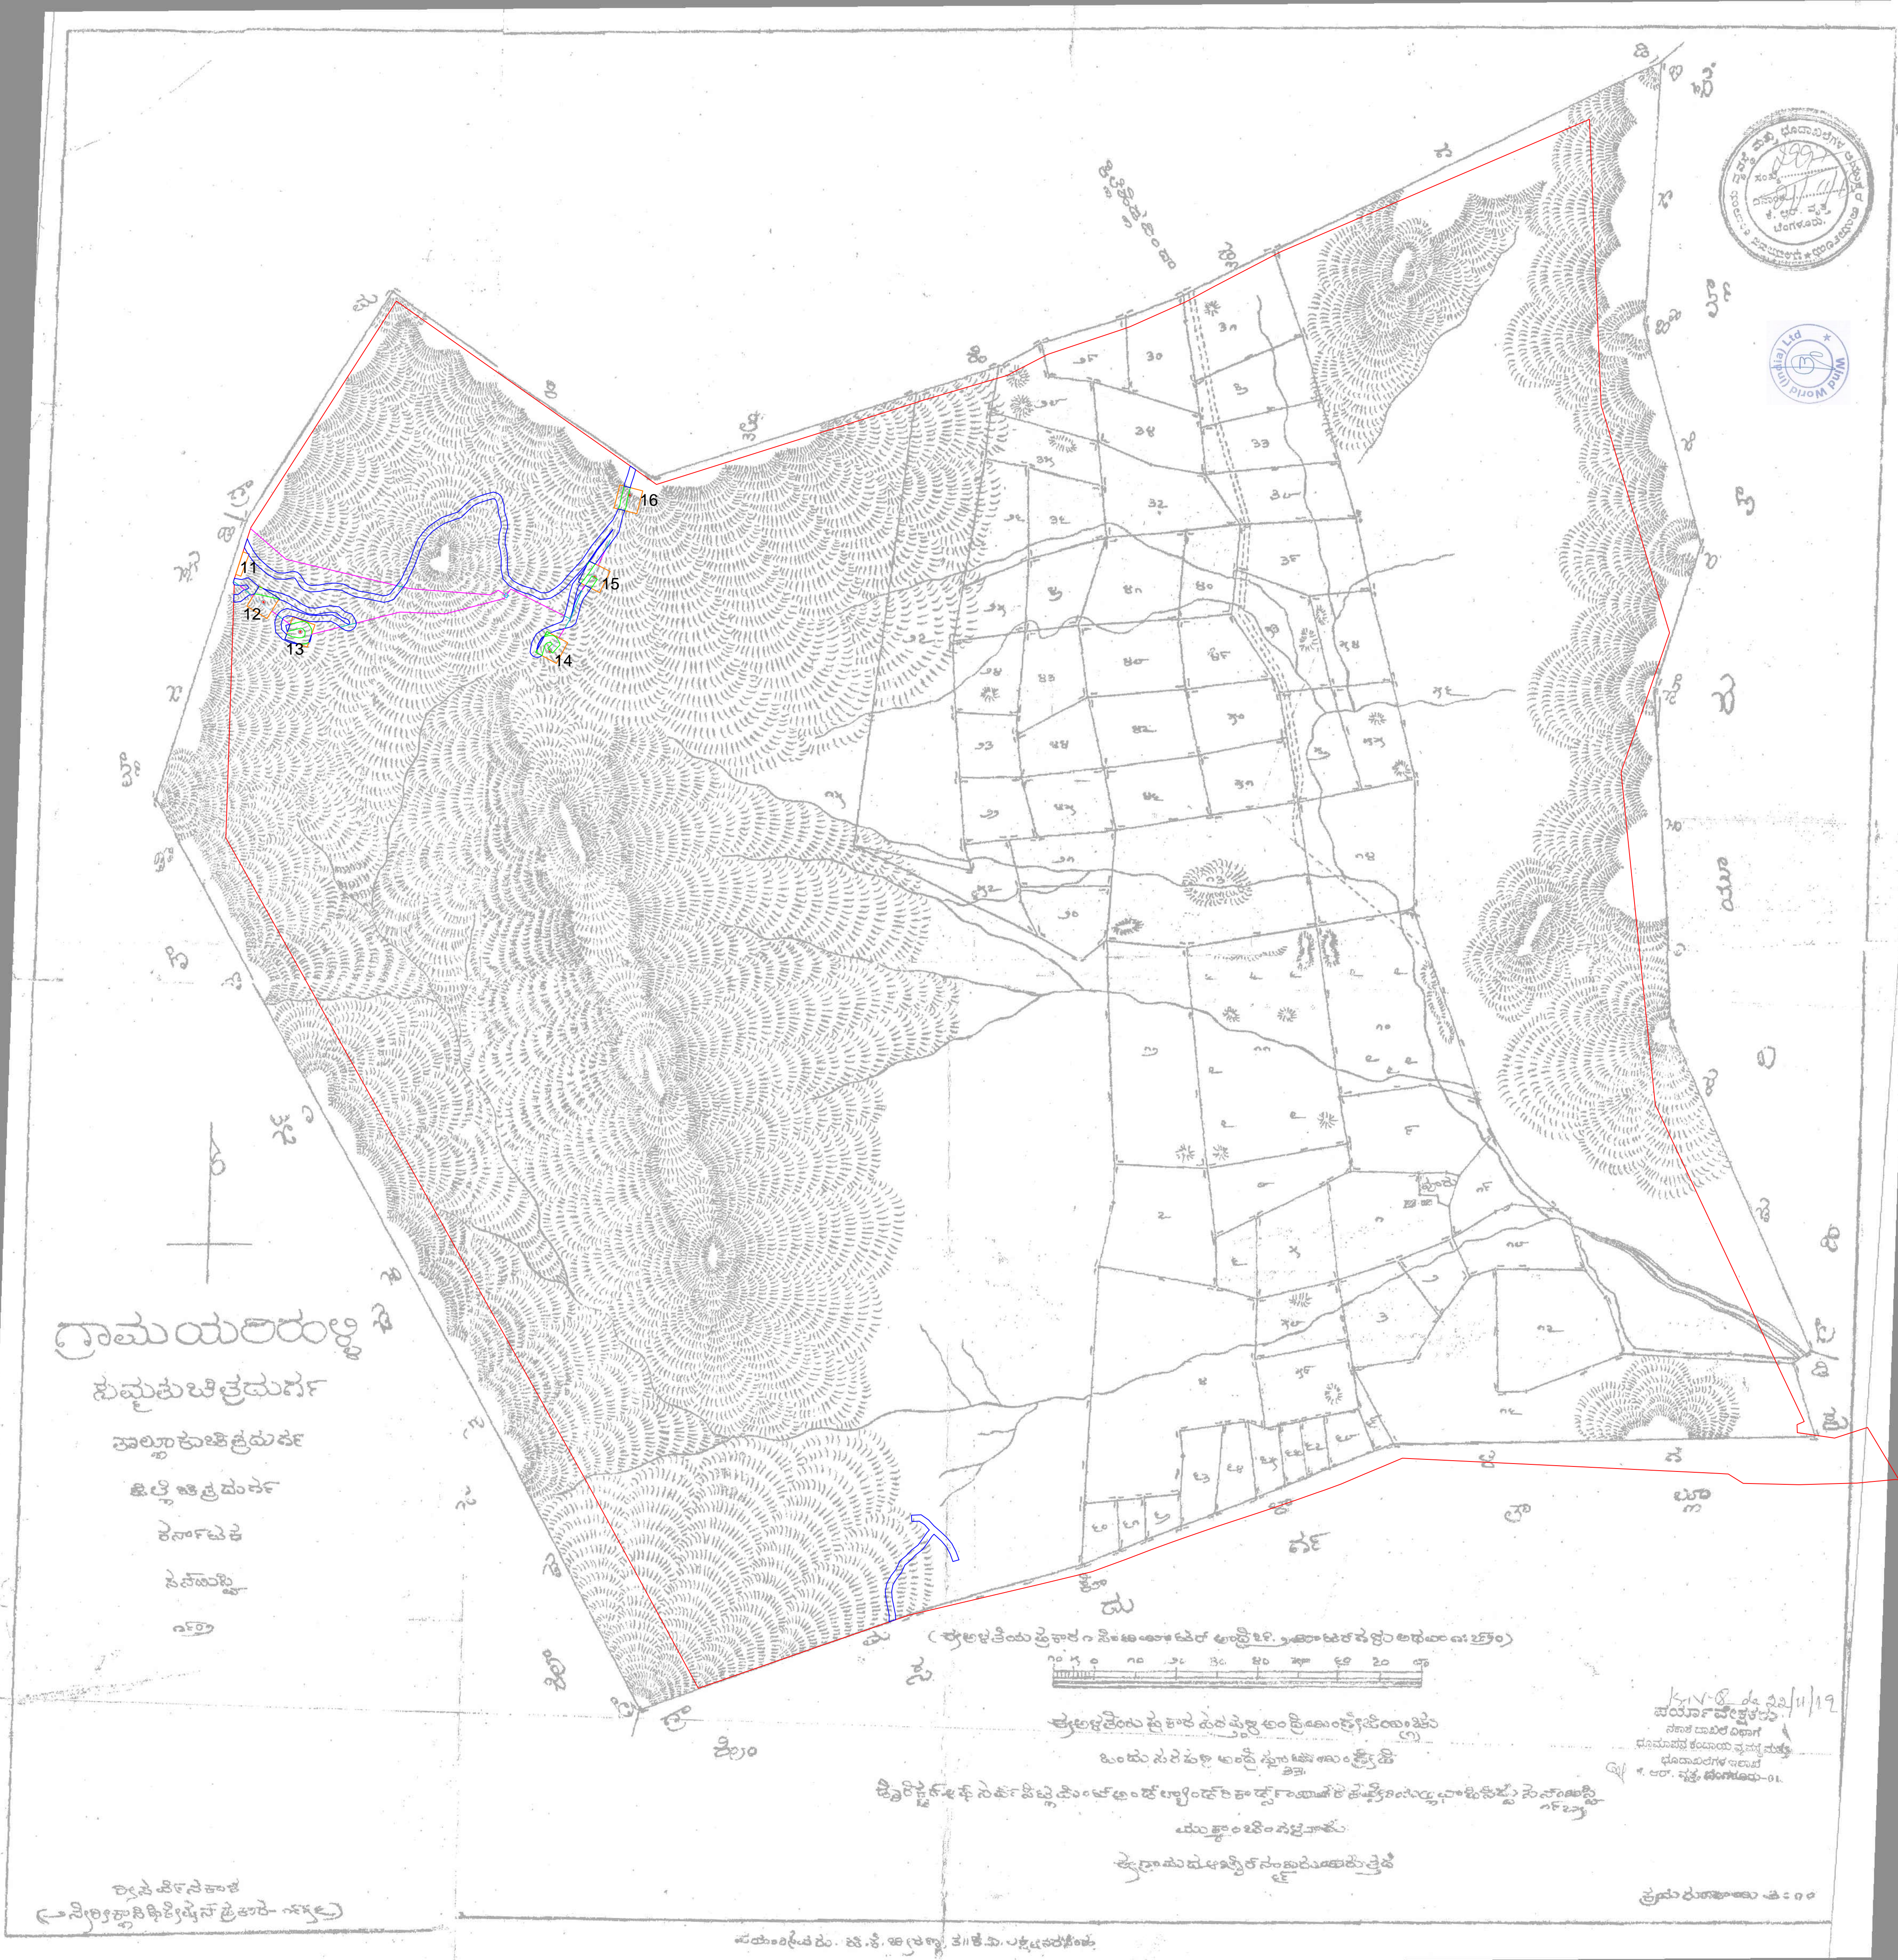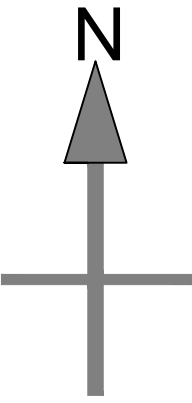

AS BUILT FEATURES	
FEATURE TYPE	LEGEND
	VILLAGE BOUNDARY
	FOREST AS BUILT ROAD
	NON FOREST ROAD
	INSIDE PLATFORM ROAD
	FOREST AS BUILT ELECTRIC LINE
	NON FOREST ELECTRIC LINE
	INSIDE ROAD ELECTRIC LINE
	FOREST AS BUILT VCB YARD
	NON FOREST VCB YARD
	PL1
	FOREST AS BUILT PLATFORM AREA WITH NOS
	NOS.FOR COORDINATES OF ROAD & EP LINE

WIND WORLD (INDIA) LTD	
-- formerly known as --	
Scale:- 1 : 7020	
PROJECT:- WIND POWER PROJECT AT GIM1 SITE CHITRADURGA (DIST) KARNATAKA STATE	
TITLE:- VILLAGE MAP FOR YAREHALLI VILLAGE	
DRAWING NO.:- KAR/GIM1/1	ASBUILT-1/1