



221.80 Ha WIND POWER PROJECT  
AT VVS SITE CHITRADURGA (DIST), KARNATAKA STATE.  
AS BUILT DRAWING SUPERIMPOSED ON VILLAGE MAP  
FOR VILLAGE ITTIGEHALI AT VVS SITE



Sl. No.	Area (Ha)	Area (Acres)
1	221.80	546.00
2	10.00	24.71
3	5.00	12.35
4	2.50	6.18
5	1.25	3.09
6	0.62	1.54
7	0.31	0.77
8	0.15	0.37
9	0.08	0.19
10	0.04	0.10
11	0.02	0.05
12	0.01	0.02
13	0.01	0.02
14	0.01	0.02
15	0.01	0.02
16	0.01	0.02
17	0.01	0.02
18	0.01	0.02
19	0.01	0.02
20	0.01	0.02

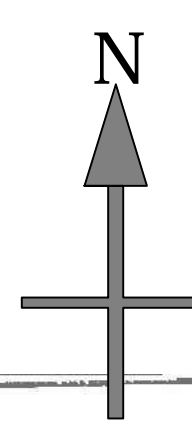

ವಿಶಾಖಾ ಯಜ್ಞಾಂಗಣ  
ಸಮಾಜ ಸಂಸ್ಥೆ  
ಅಧ್ಯಕ್ಷರು  
ಕಾರ್ಯದರ್ಶಿ  
ಯಜ್ಞಾಂಗಣ  
ಕಾರ್ಯದರ್ಶಿ  
ಕಾರ್ಯದರ್ಶಿ


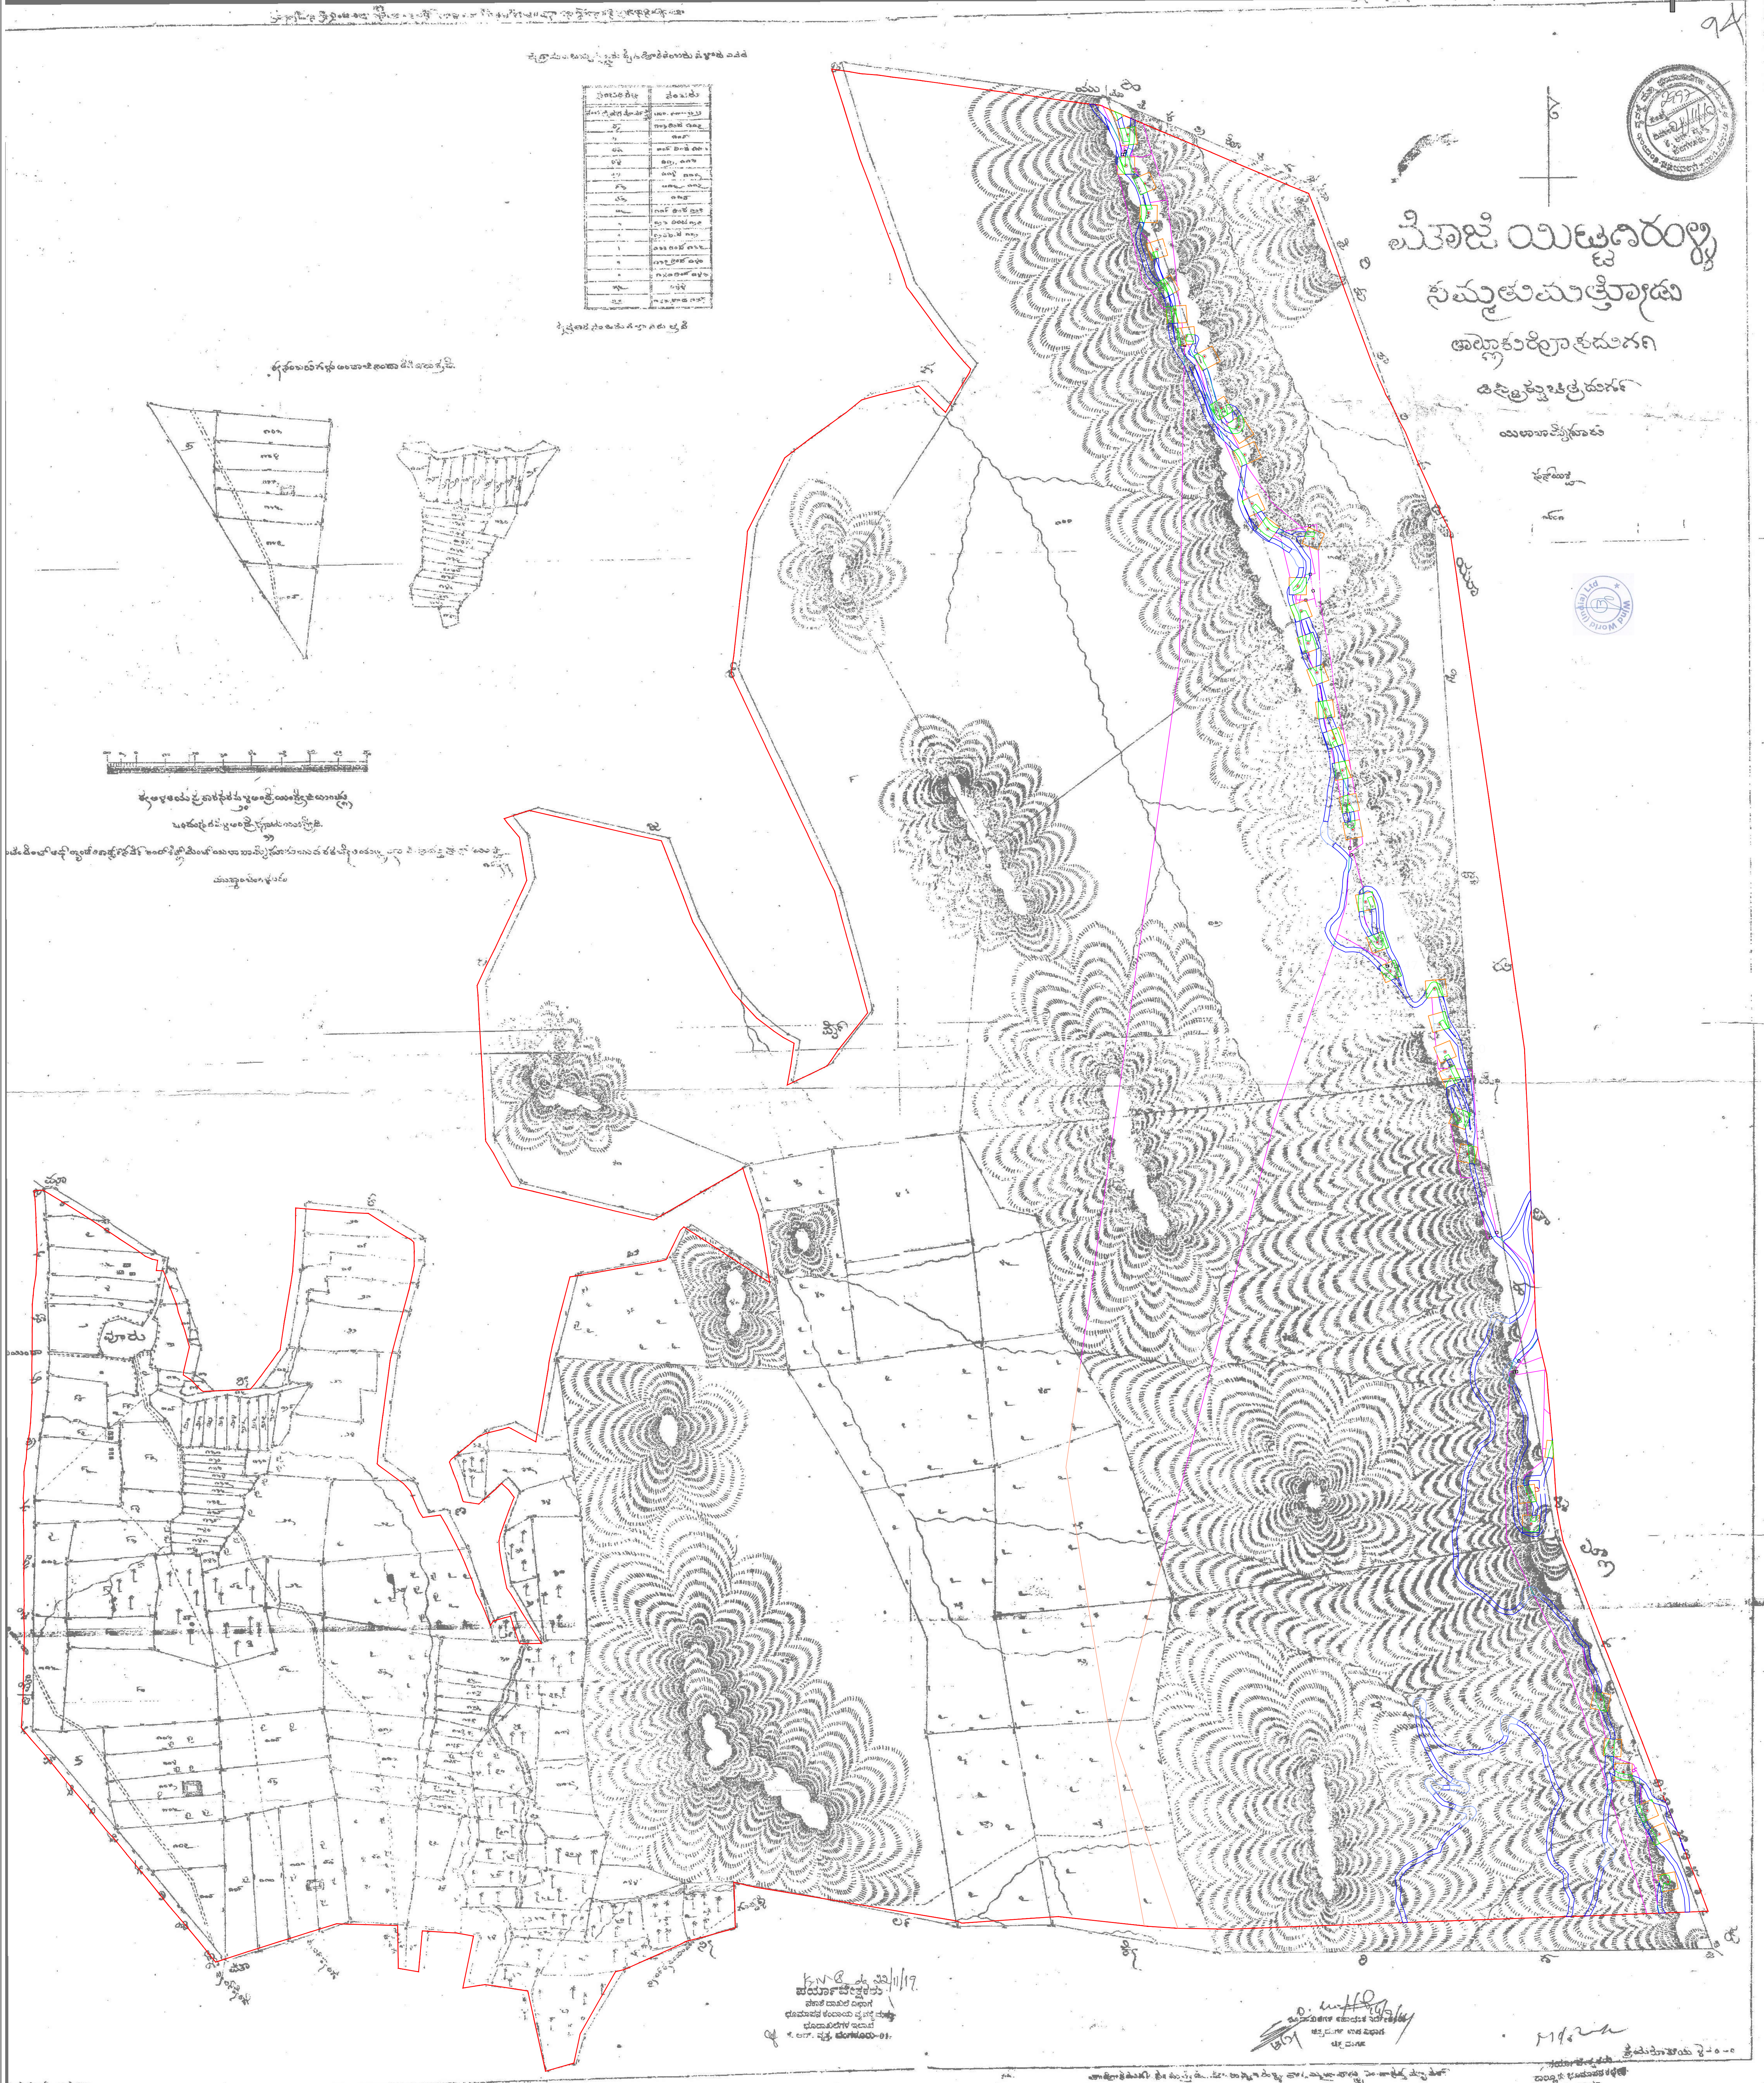


AS BUILT FEATURES	LEGEND
—	VILLAGE BOUNDARY
—	FOREST AS BUILT ROAD
—	NON FOREST ROAD
—	INSIDE PLATFORM ROAD
—	FOREST AS BUILT ELECTRIC LINE
—	NON FOREST ELECTRIC LINE
—	INSIDE ROAD ELECTRIC LINE
—	FOREST AS BUILT VCB YARD
—	NON FOREST VCB YARD
—	FOREST AS BUILT PLATFORM AREA WITH NOS
—	NOS FOR COORDINATES OF ROAD & EP LINE

WIND WORLD (INDIA) LTD
Scale:- 1 : 7920
PROJECT:- WIND POWER PROJECT AT VANIVILASAGAR SITE CHITRADURGA (DIST) KARNATAKA STATE
TITLE:- VILLAGE MAP FOR ITTIGEHALI VILLAGE
DRAWING NO:- KAR/VVS/1
ASBUILT-1/1



221.80 Ha WIND POWER PROJECT  
AT VVS SITE CHITRADURGA (DIST), KARNATAKA STATE.  
AS BUILT DRAWING SUPERIMPOSED ON VILLAGE MAP  
FOR VILLAGE GUDDADA NERALEKERE AT VVS SITE

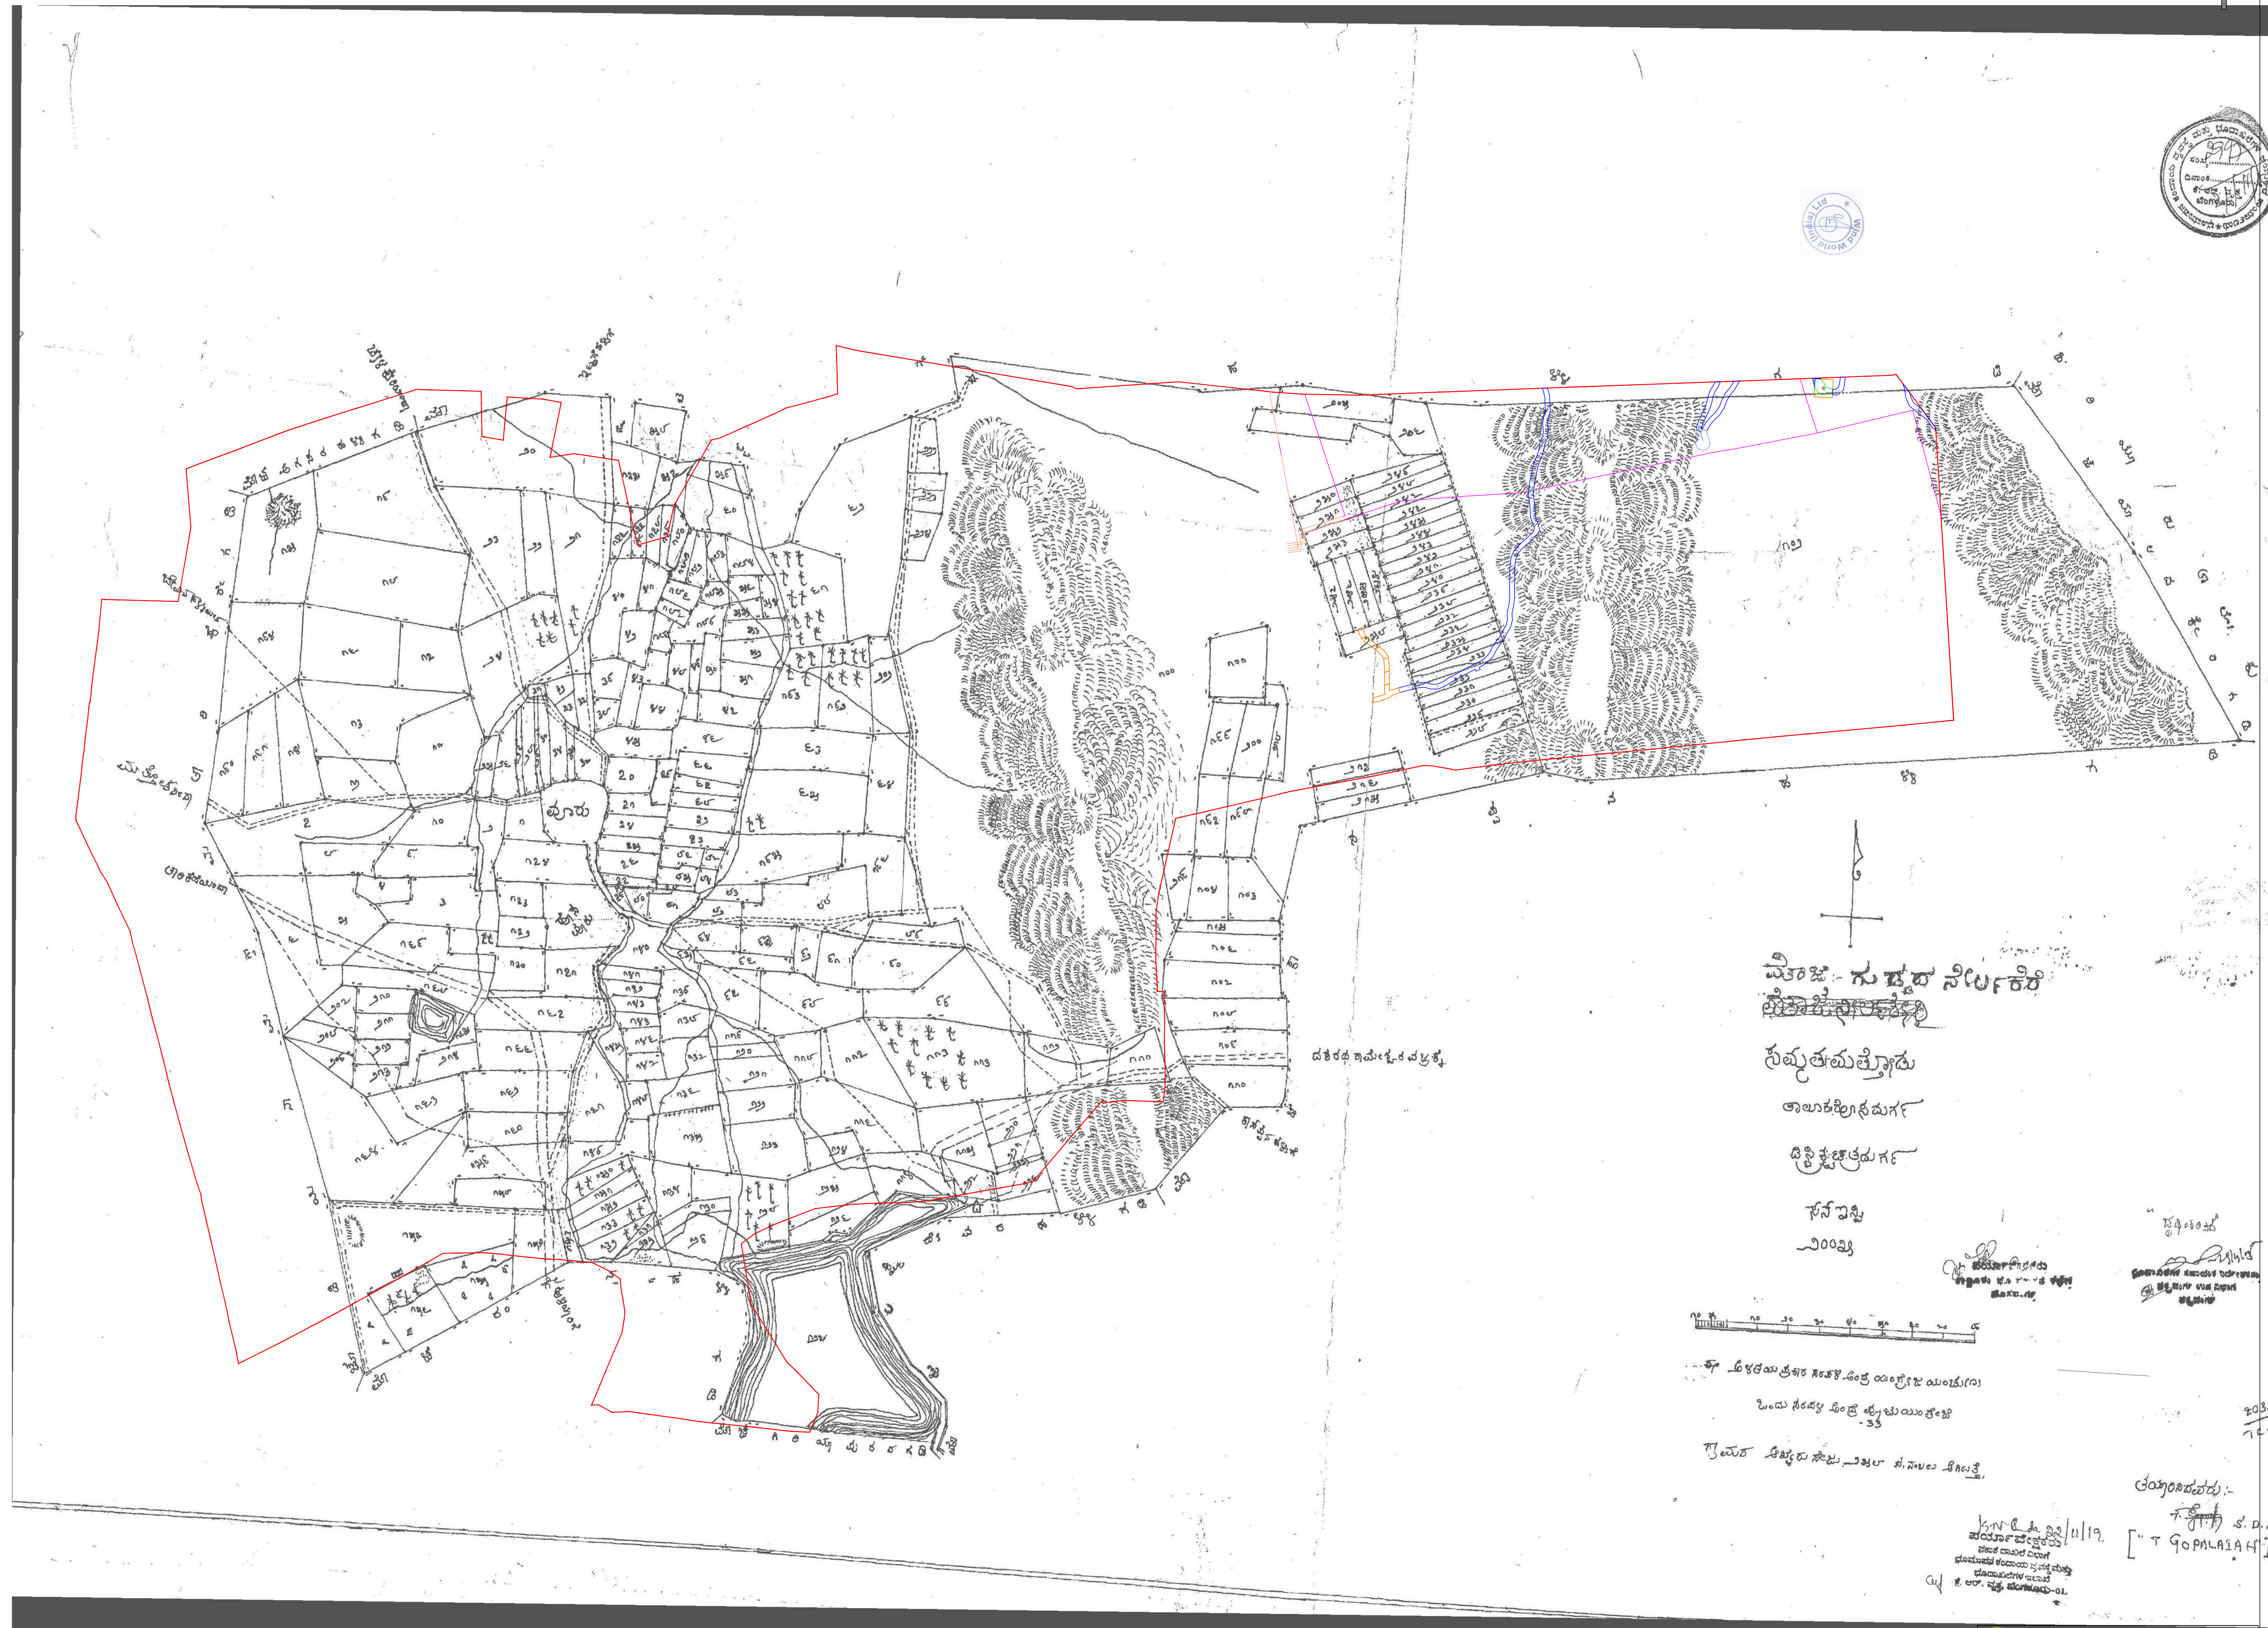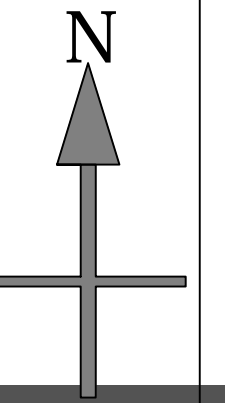

ಮೊಜ್ಜು ಗುಡ್ಡದ ನೆರಾಳೆಕರೆ  
ಚಿತ್ರದುರ್ಗ ಜಿಲ್ಲೆ

ನವುತಮತ್ತಿಗುಡ್ಡ

ತಾಲೂಕು

ಜಿಲ್ಲೆ

ಸೆಪ್ಟೆಂಬರ್

2003



ಈ ನಕ್ಷೆಯು ತಿಳಿದು ಕೊಡುವ ಯಾವುದೇ ಮಾಹಿತಿಯನ್ನು  
ಒಂದು ಸೇವೆಯನ್ನು ಒದಗಿಸುವುದಿಲ್ಲ.

ಗ್ರಾಮ ಪಂಚಾಯತ್ ಸಂಸ್ಥೆ, 2003 ರ ನವೆಂಬರ್ ತಿಂಗಳು.

2003/04  
76.5 ಕೆ.ಮೀ. ಉದ್ದದ  
ಪುಟ್ಟುಪುಟ್ಟು

ಕರ್ನಾಟಕ ಸರ್ಕಾರ  
ಪ್ರಾದೇಶಿಕ ಸರ್ಕಾರ  
ಜಿಲ್ಲಾ ಸರ್ಕಾರ

ಕರ್ನಾಟಕ ಸರ್ಕಾರ  
ಪ್ರಾದೇಶಿಕ ಸರ್ಕಾರ  
ಜಿಲ್ಲಾ ಸರ್ಕಾರ

AS BUILT FEATURES	
FEATURE TYPE	LEGEND
VILLAGE BOUNDARY	— formerly known as —
FOREST AS BUILT ROAD	—
NON FOREST ROAD	—
INSIDE PLATFORM ROAD	—
FOREST AS BUILT ELECTRIC LINE	—
NON FOREST ELECTRIC LINE	—
INSIDE ROAD ELECTRIC LINE	—
FOREST AS BUILT VCB YARD	—
NON FOREST VCB YARD	—
FOREST AS BUILT PLATFORM AREA WITH NOS	—
NON FOREST COORDINATES OF ROAD & EP LINE	—

WIND WORLD (INDIA) LTD
Scale:- 1 : 7920
PROJECT:- WIND POWER PROJECT AT VANIVILASAGAR SITE CHITRADURGA (DIST) KARNATAKA STATE
TITLE:- VILLAGE MAP FOR G.NERALEKERE VILLAGE
DRAWING NO:- KAR/VVS/1
ASBUILT-1/1



221.80 Ha WIND POWER PROJECT  
AT VVS SITE CHITRADURGA (DIST), KARNATAKA STATE.  
AS BUILT DRAWING SUPERIMPOSED ON VILLAGE MAP  
FOR VILLAGE HALDYAMENAHALLI AT VVS SITE

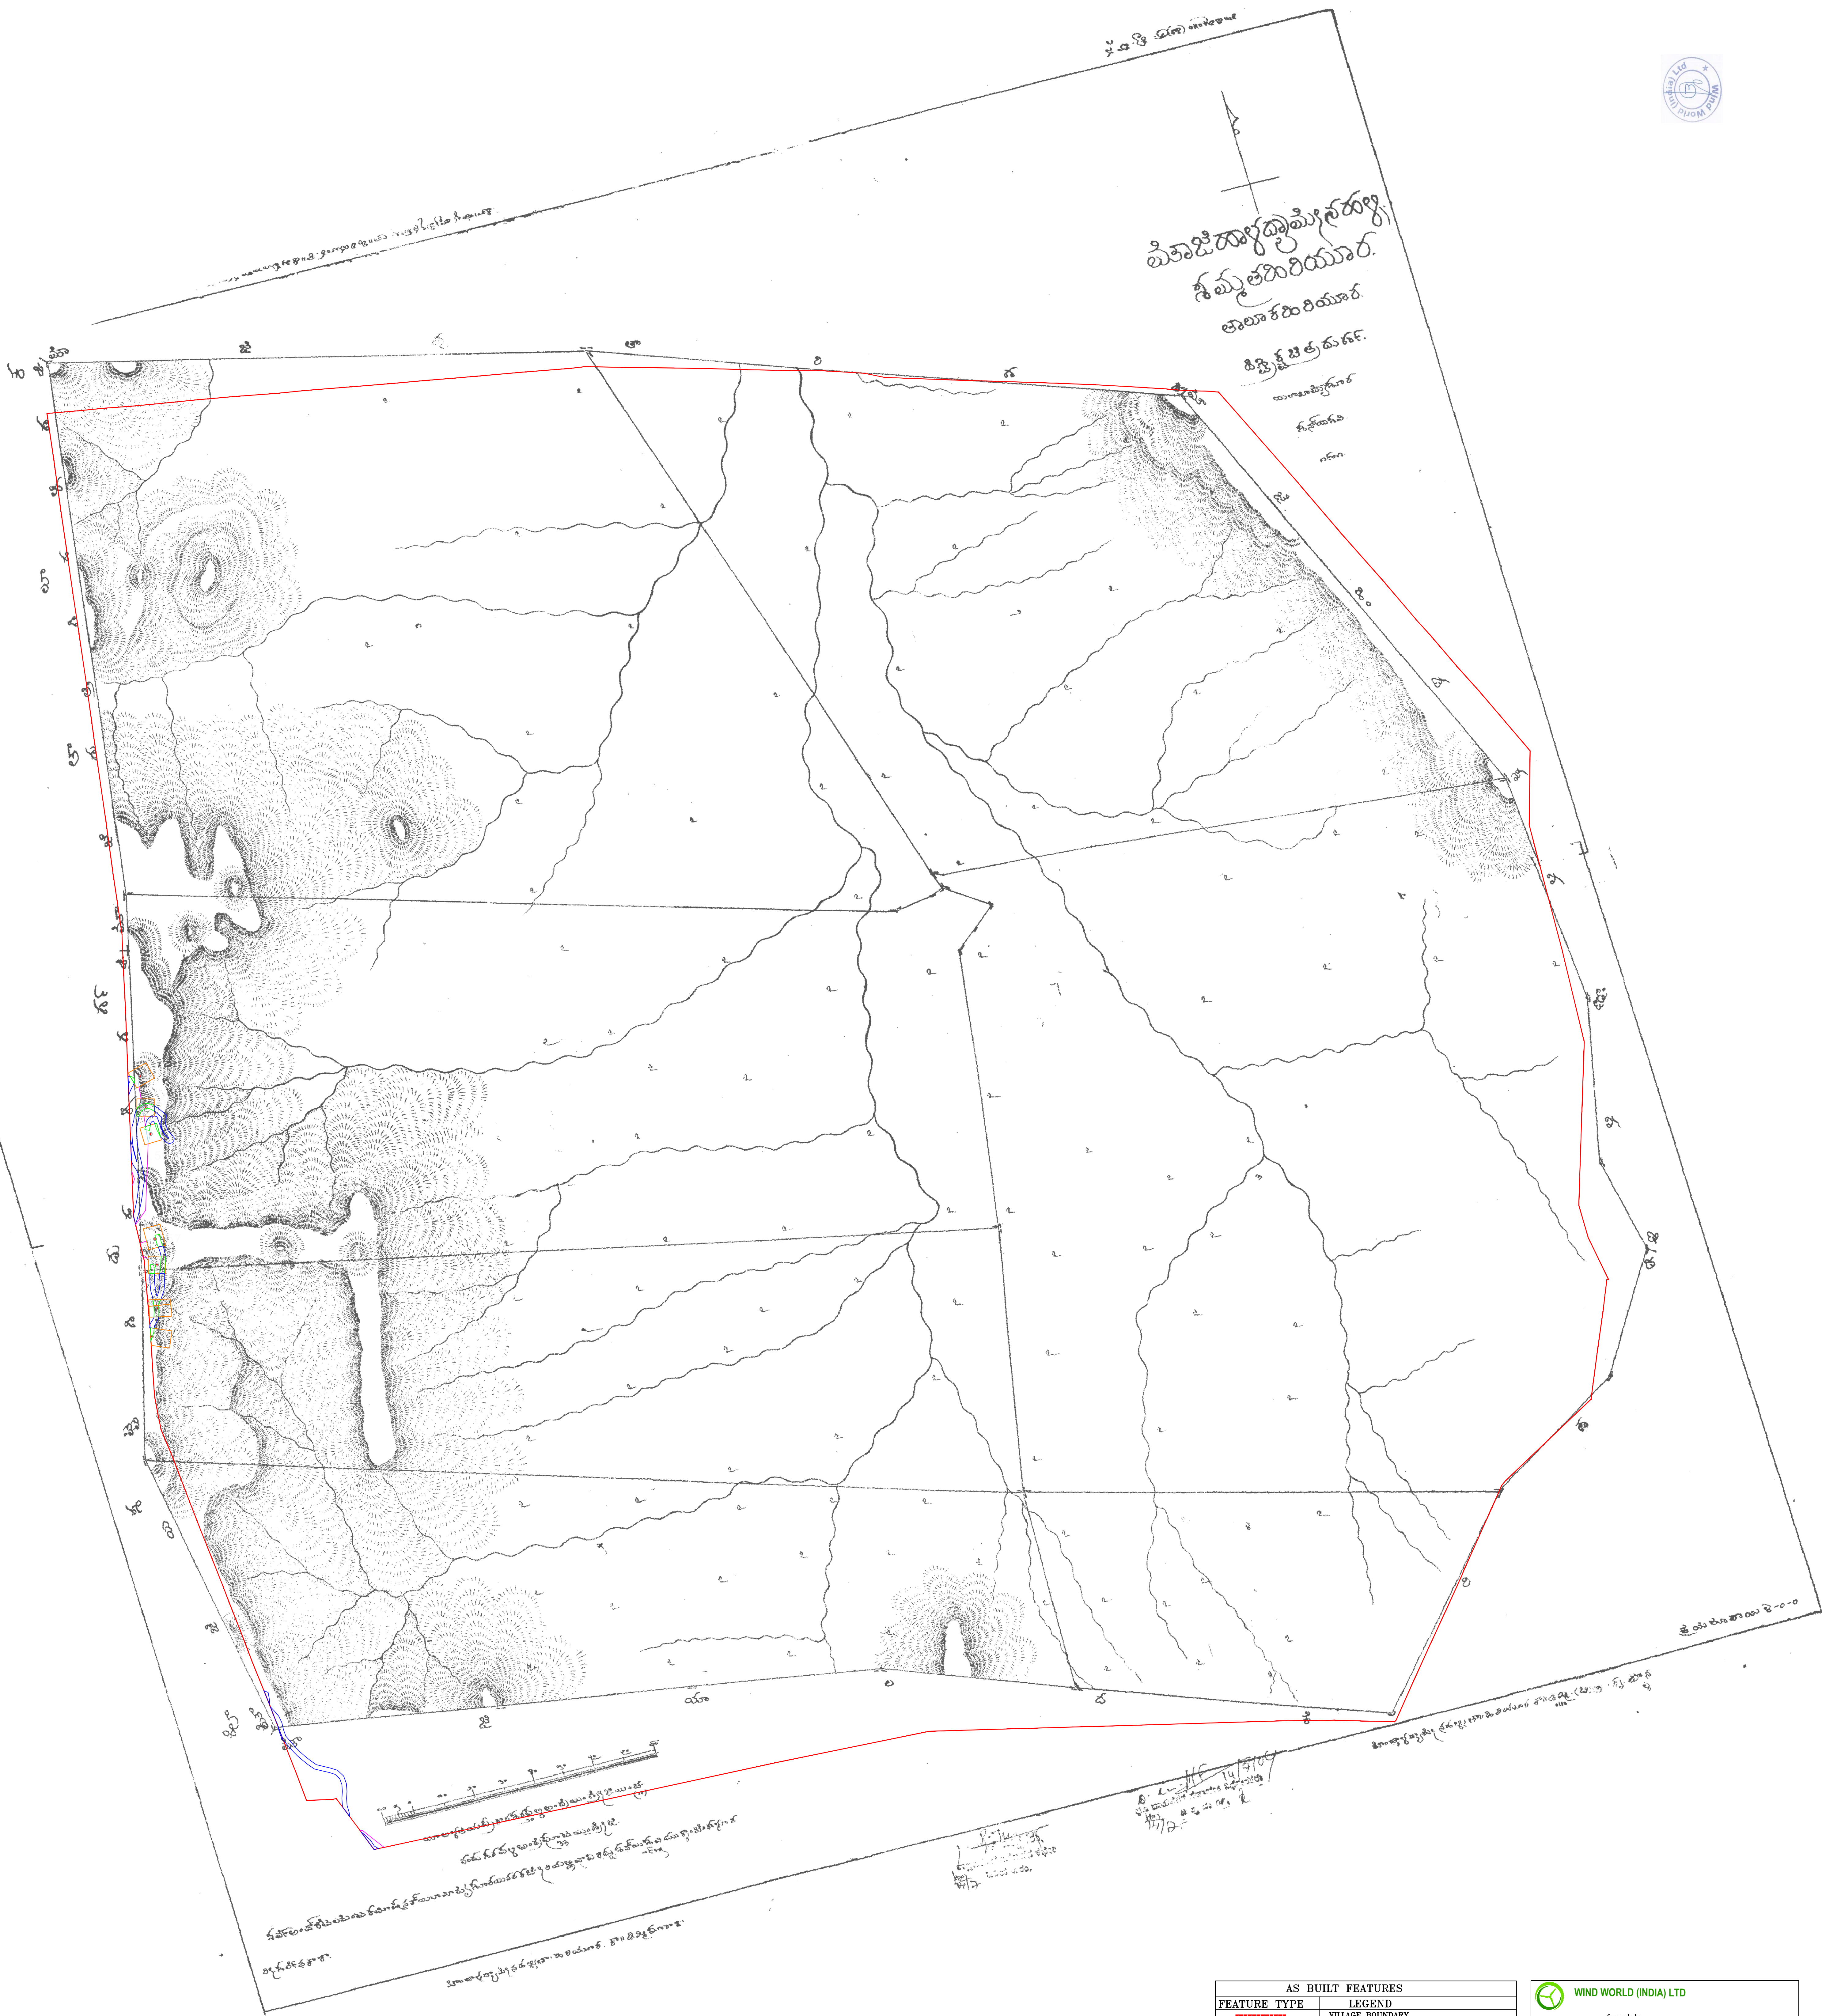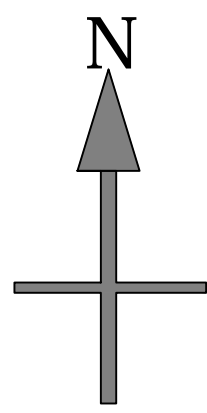


AS BUILT FEATURES	
FEATURE TYPE	LEGEND
	VILLAGE BOUNDARY
	FOREST AS BUILT ROAD
	NON FOREST ROAD
	INSIDE PLATFORM ROAD
	FOREST AS BUILT ELECTRIC LINE
	NON FOREST ELECTRIC LINE
	INSIDE ROAD ELECTRIC LINE
	FOREST AS BUILT VCB YARD
	NON FOREST VCB YARD
	PL-1
	FOREST AS BUILT PLATFORM AREA WITH NOS
	NOS.FOR COORDINATES OF ROAD & EP LINE

WIND WORLD (INDIA) LTD -- formerly known as --	
Scale:- 1 : 7920	
PROJECT:- WIND POWER PROJECT AT VANULASAGAR SITE CHITRADURGA (DIST) KARNATAKA STATE	
TITLE:- VILLAGE MAP FOR HALDYAMENAHALLI VILLAGE	
DRAWING NO.:- KAS/VVS/1	ASBUILT-1/1



221.80 Ha WIND POWER PROJECT  
AT VVS SITE CHITRADURGA (DIST), KARNATAKA STATE.  
AS BUILT DRAWING SUPERIMPOSED ON VILLAGE MAP  
FOR VILLAGE KATTIHOLE AT VVS SITE

N

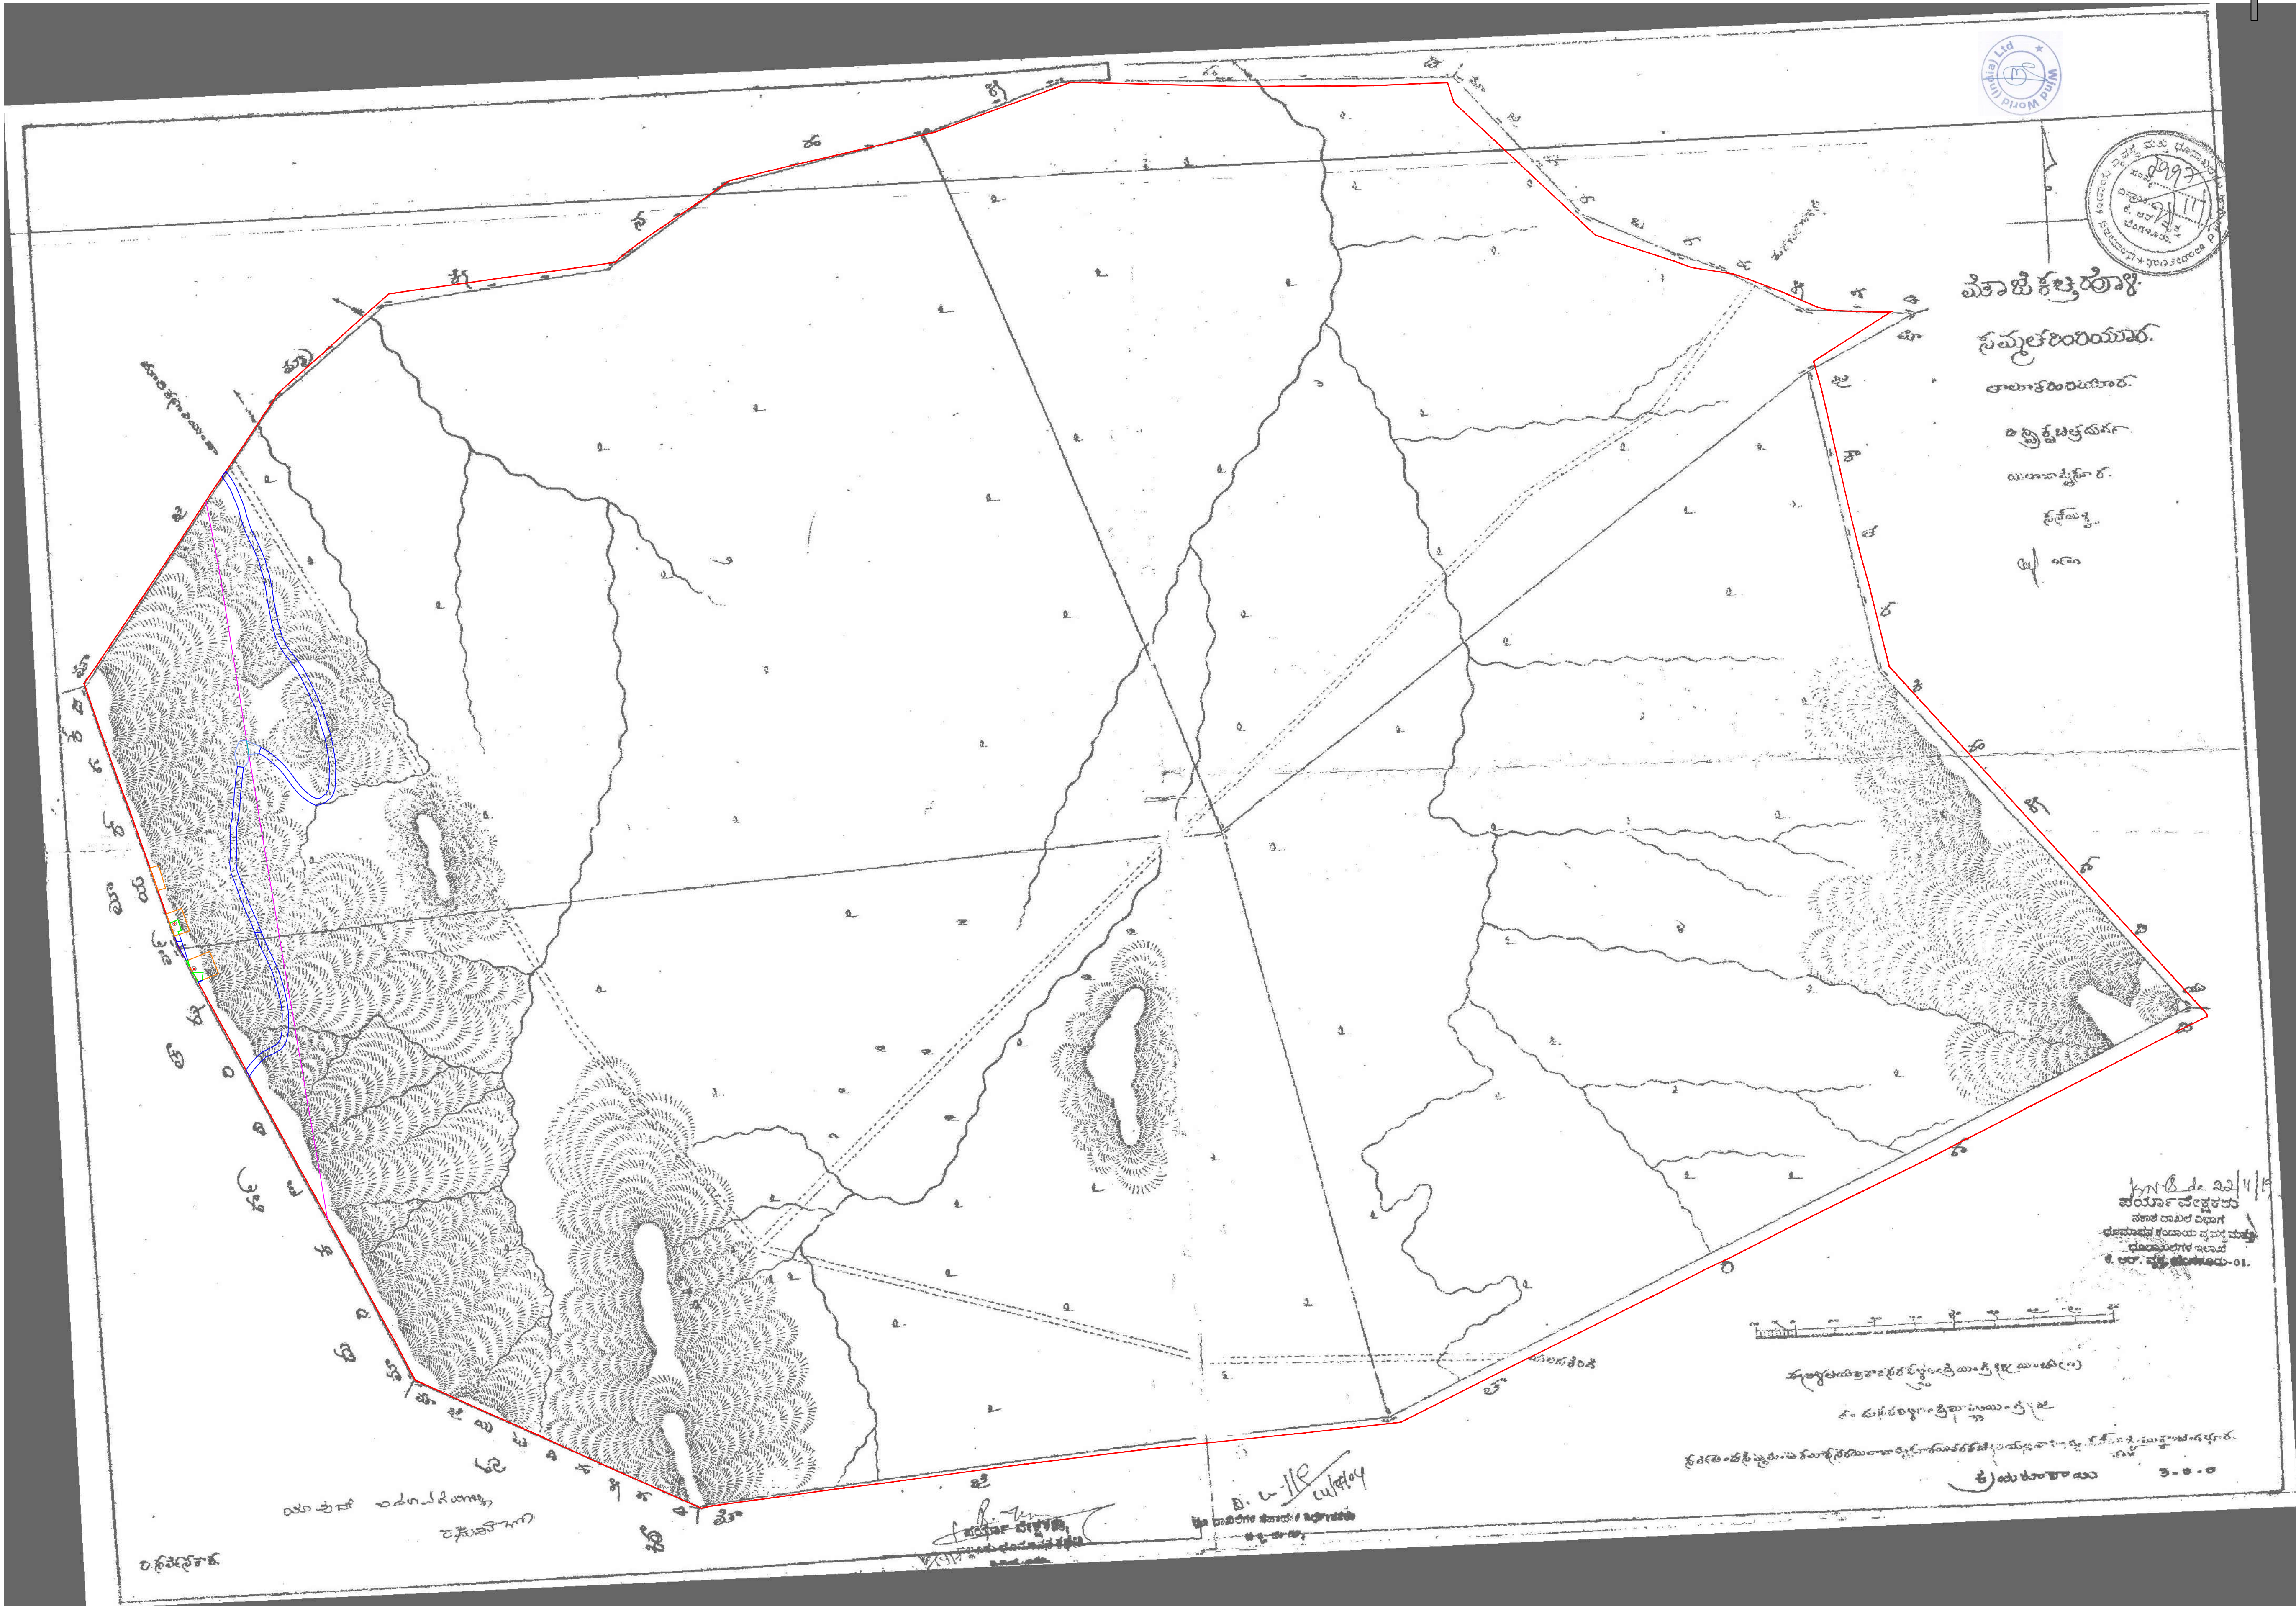












AS BUILT FEATURES	
FEATURE TYPE	LEGEND
	VILLAGE BOUNDARY
	FOREST AS BUILT ROAD
	NON FOREST ROAD
	INSIDE PLATFORM ROAD
	FOREST AS BUILT ELECTRIC LINE
	NON FOREST ELECTRIC LINE
	INSIDE ROAD ELECTRIC LINE
	FOREST AS BUILT VCB YARD
	NON FOREST VCB YARD
	FOREST AS BUILT PLATFORM AREA WITH NOS
	NOS.FOR COORDINATES OF ROAD & EF LINE

WIND WORLD (INDIA) LTD	
- formerly known as -	
Scale:- 1 : 7920	
PROJECT:- WIND POWER PROJECT AT VANILASAGAE SITE CHITRADURGA (DIST) KARNATAKA STATE	
TITLE:- VILLAGE MAP FOR KATTIHOLE VILLAGE	
DRAWING NO:- KAR/VVS/1	ASBUILT-1/1







AS BUILT FEATURES	
FEATURE TYPE	LEGEND
	VILLAGE BOUNDARY
	FOREST AS BUILT ROAD
	NON FOREST ROAD
	INSIDE PLATFORM ROAD
	FOREST AS BUILT ELECTRIC LINE
	NON FOREST ELECTRIC LINE
	INSIDE ROAD ELECTRIC LINE
	FOREST AS BUILT VCB YARD
	NON FOREST VCB YARD
	FOREST AS BUILT PLATFORM AREA WITH NOS
	NOS FOR COORDINATES OF ROAD & EP LINE



221.80 Ha WIND POWER PROJECT  
AT VVS SITE CHITRADURGA (DIST), KARNATAKA STATE.  
AS BUILT DRAWING SUPERIMPOSED ON VILLAGE MAP  
FOR VILLAGE VANIVILASAPURA AT VVS SITE

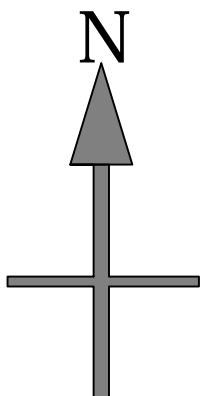

AS BUILT FEATURES	
FEATURE TYPE	LEGEND
-----	VILLAGE BOUNDARY
-----	FOREST AS BUILT ROAD
-----	NON FOREST ROAD
-----	INSIDE PLATFORM ROAD
-----	FOREST AS BUILT ELECTRIC LINE
-----	NON FOREST ELECTRIC LINE
-----	INSIDE ROAD ELECTRIC LINE
-----	FOREST AS BUILT VCB YARD
-----	NON FOREST VCB YARD
-----	FOREST AS BUILT PLATFORM AREA WITH NOS
-----	NOS.FOR COORDINATES OF ROAD & EP LINE



WIND WORLD (INDIA) LTD

-- formerly known as --

Scale:- 1 : 8000


PROJECT:- WIND POWER PROJECT  
AT VANIVILASAGAR SITE CHITRADURGA (DIST)  
KARNATAKA STATE

TITLE:- VILLAGE MAP FOR VANIVILASAPURA VILLAGE

DRAWING NO.:- KAR/VVS/1

ASBUILT-1/1

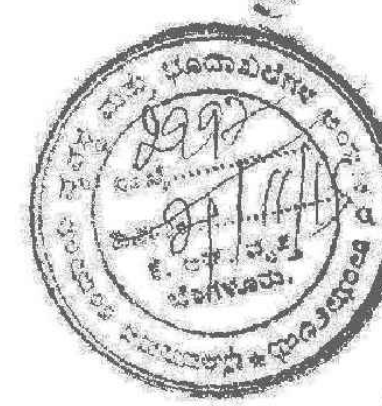

[illegible]

၂၇။ အထွေထွေအားဖြင့် ဤအချက်အလက်များသည်  
 အောက်ဖော်ပြပါအတိုင်း ဖြစ်ပေါ်ခဲ့သည်။

[illegible]

100-111111-111111  
100-111111-111111  
100-111111-111111  
100-111111-111111

ಮೆಕಾಜಿಯಾಲದಕೆರೆ

ಸಹ್ಯಾದ್ರಿಯ ಪರ್ವತ ಶ್ರೇಣಿ

అంతా పురిచియ్యాను

యలవజ్జీవారు

ॐ नमो भगवते वासुदेवाय

8/2/75

శ్రీమద్భగవద్గీతా ప్రకాశిక

[illegible]

ముక్తావధేంద్రులు

62.  $\frac{1}{x^2} = x^{-2}$   $\frac{d}{dx} x^{-2} = -2x^{-3} = -\frac{2}{x^3}$

AS BUILT FEATURES	
FEATURE TYPE	LEGEND
	VILLAGE BOUNDARY
	FOREST AS BUILT ROAD
	NON FOREST ROAD
	INSIDE PLATFORM ROAD
	FOREST AS BUILT ELECTRIC LINE
	NON FOREST ELECTRIC LINE
	INSIDE ROAD ELECTRIC LINE
	FOREST AS BUILT VCB YARD
	NON FOREST VCB YARD
	FOREST AS BUILT PLATFORM AREA WITH NON FOREST CORRIDOR



WIND WORLD (INDIA) LTD

-- formerly known as --

Scale

**PROJECT:-** WIND POWER PROJECT  
AT VANIVILASAGAR SITE CHITRADURGA (DIST)  
KARNATAKA STATE



**TITLE:- VILLAGE MAP FOR YALADAKERE VILLAGE**

DRAWING NO.:- KAR/VVS/1

ASBULT-1/1



221.80 Ha WIND POWER PROJECT  
AT VVS SITE CHITRADURGA (DIST), KARNATAKA STATE.  
AS BUILT DRAWING SUPERIMPOSED ON VILLAGE MAP  
FOR VILLAGE MYAKANAHALLI AT VVS SITE

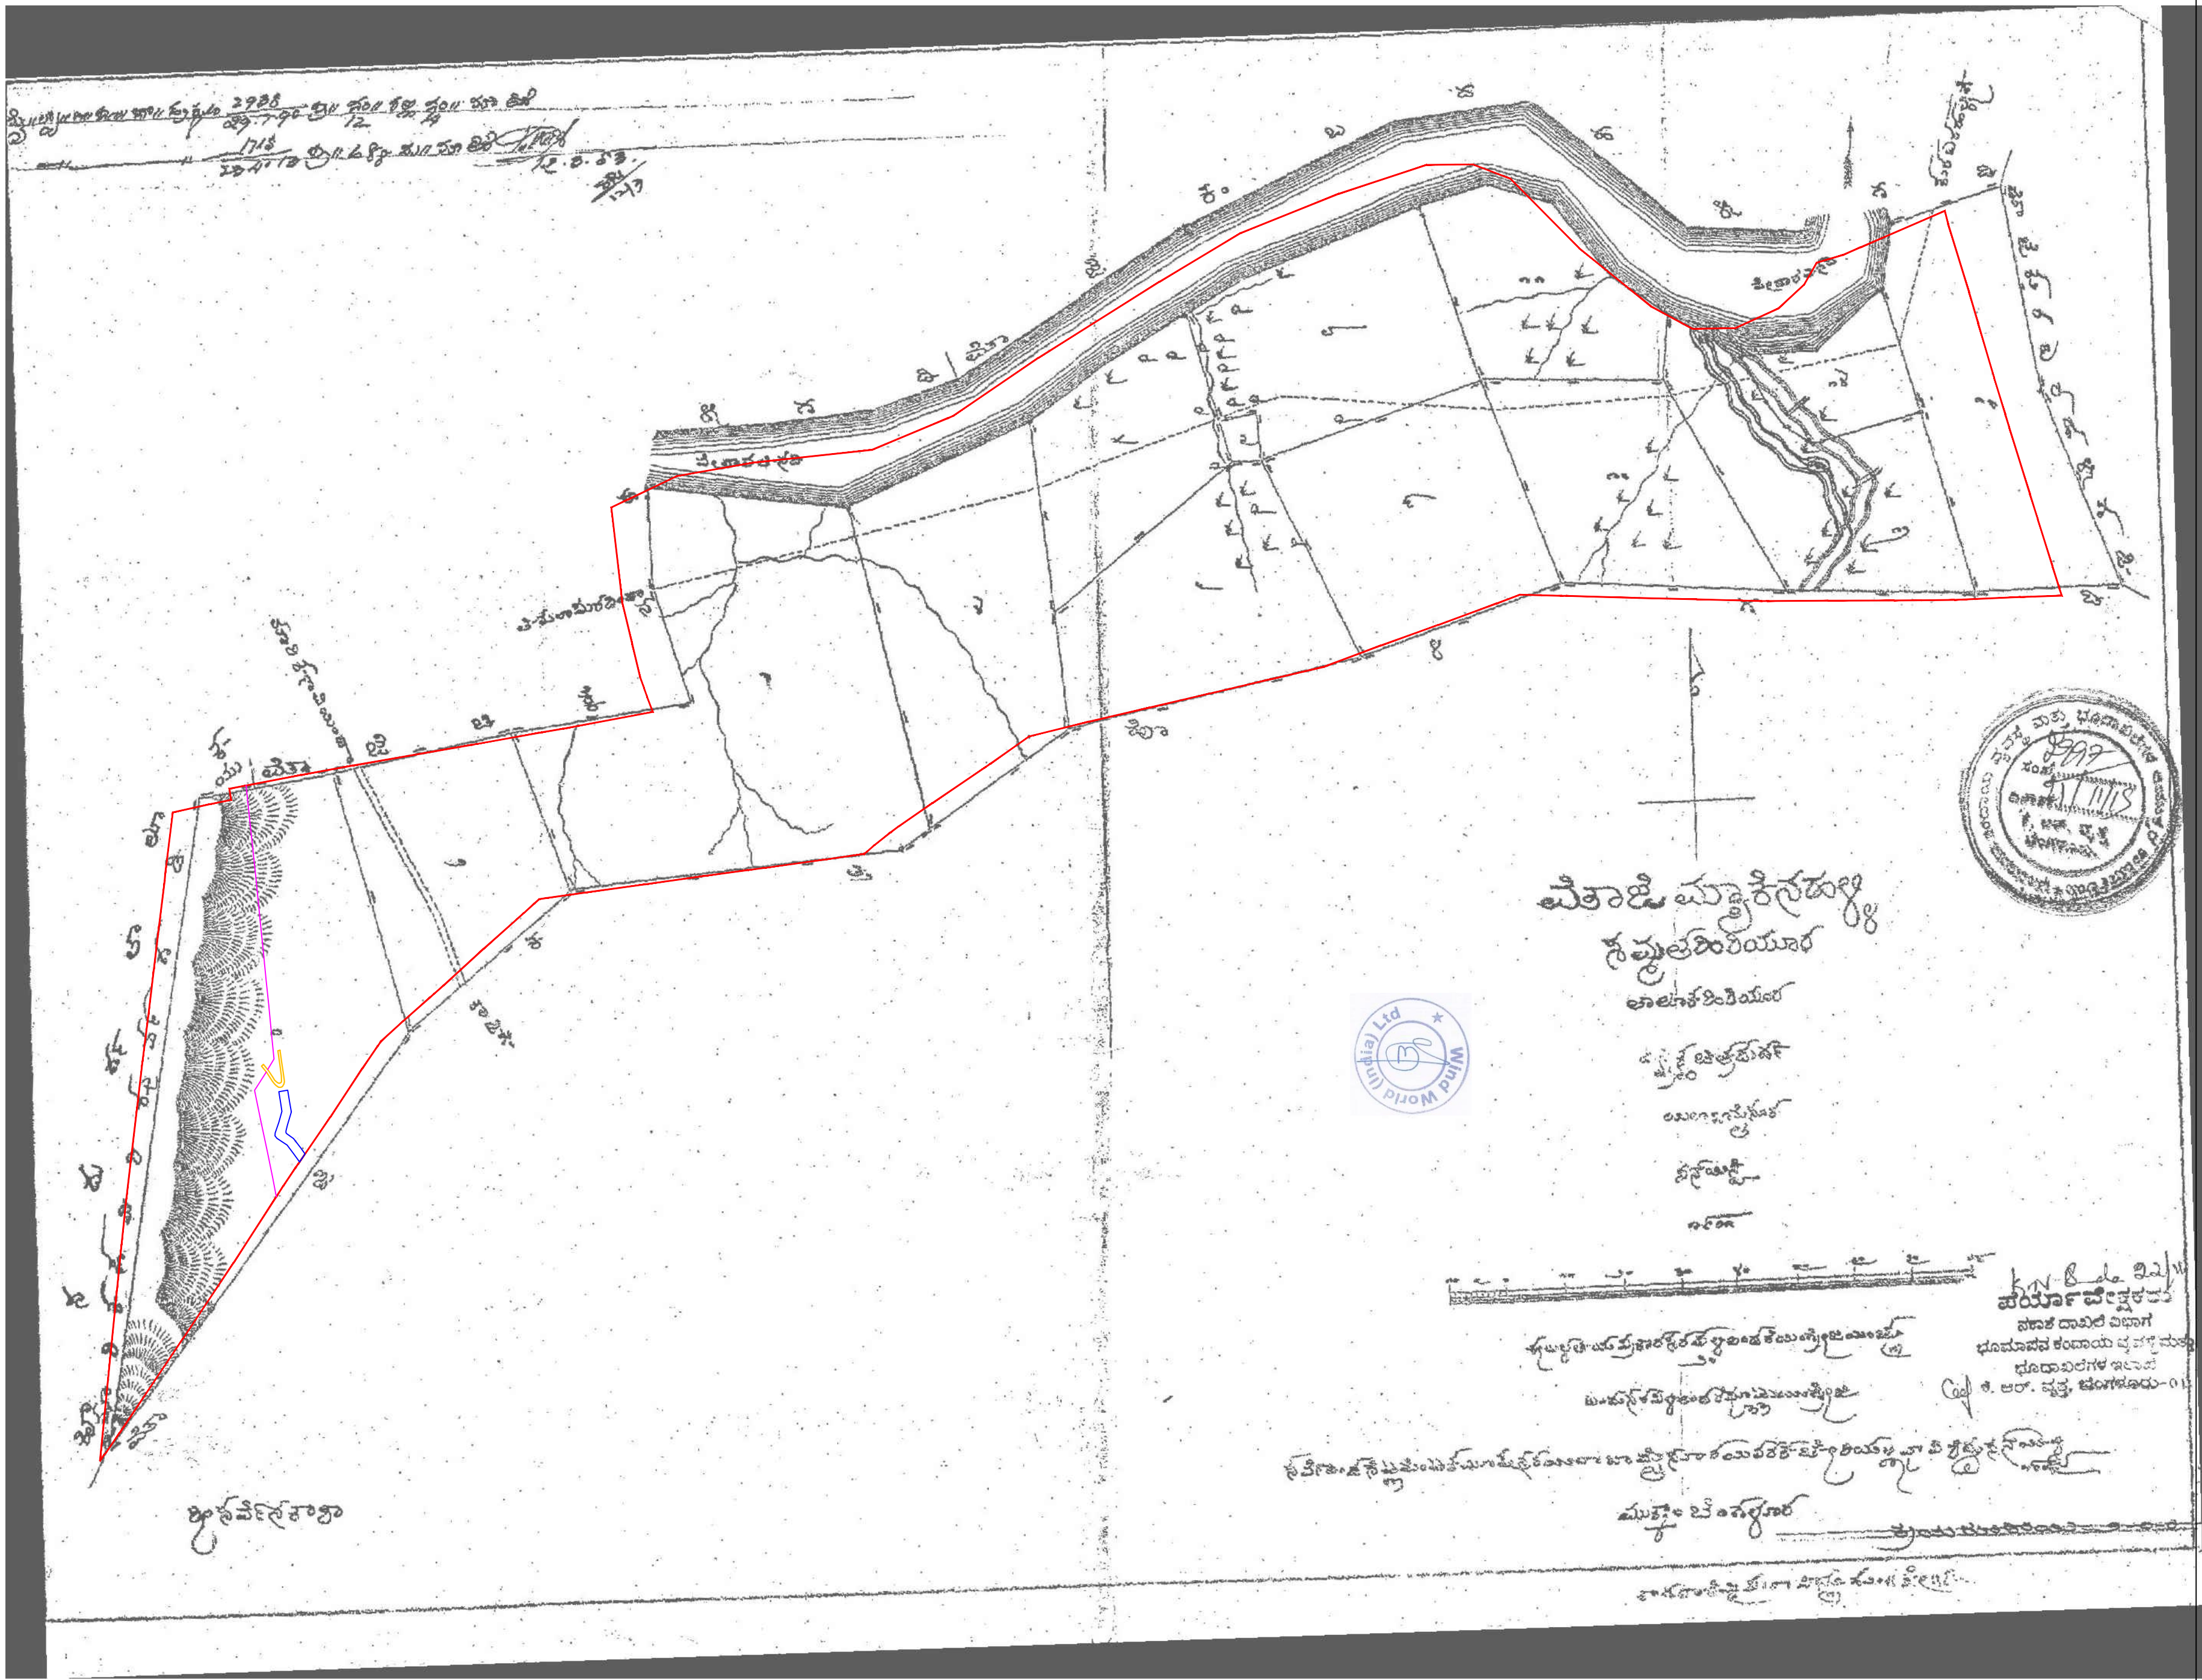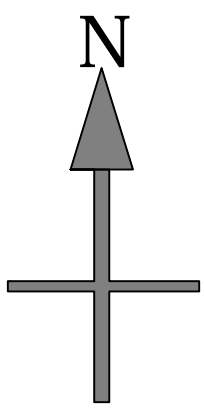

AS BUILT FEATURES	
FEATURE TYPE	LEGEND
	VILLAGE BOUNDARY
	FOREST AS BUILT ROAD
	NON FOREST ROAD
	INSIDE PLATFORM ROAD
	FOREST AS BUILT ELECTRIC LINE
	NON FOREST ELECTRIC LINE
	INSIDE ROAD ELECTRIC LINE
	FOREST AS BUILT VCB YARD
	NON FOREST VCB YARD
	FOREST AS BUILT PLATFORM AREA WITH NOS
	NOS.FOR COORDINATES OF ROAD & EP LINE

WIND WORLD (INDIA) LTD -- formerly known as --	
Scale:- 1 : 7920	
PROJECT:- WIND POWER PROJECT AT VANIVILASAGAR SITE CHITRADURGA (DIST) KARNATAKA STATE	
TITLE:- VILLAGE MAP FOR MYAKANAHALLI VILLAGE	
DRAWING NO.:- KAR/VVS/1	ASBULT-1/1