

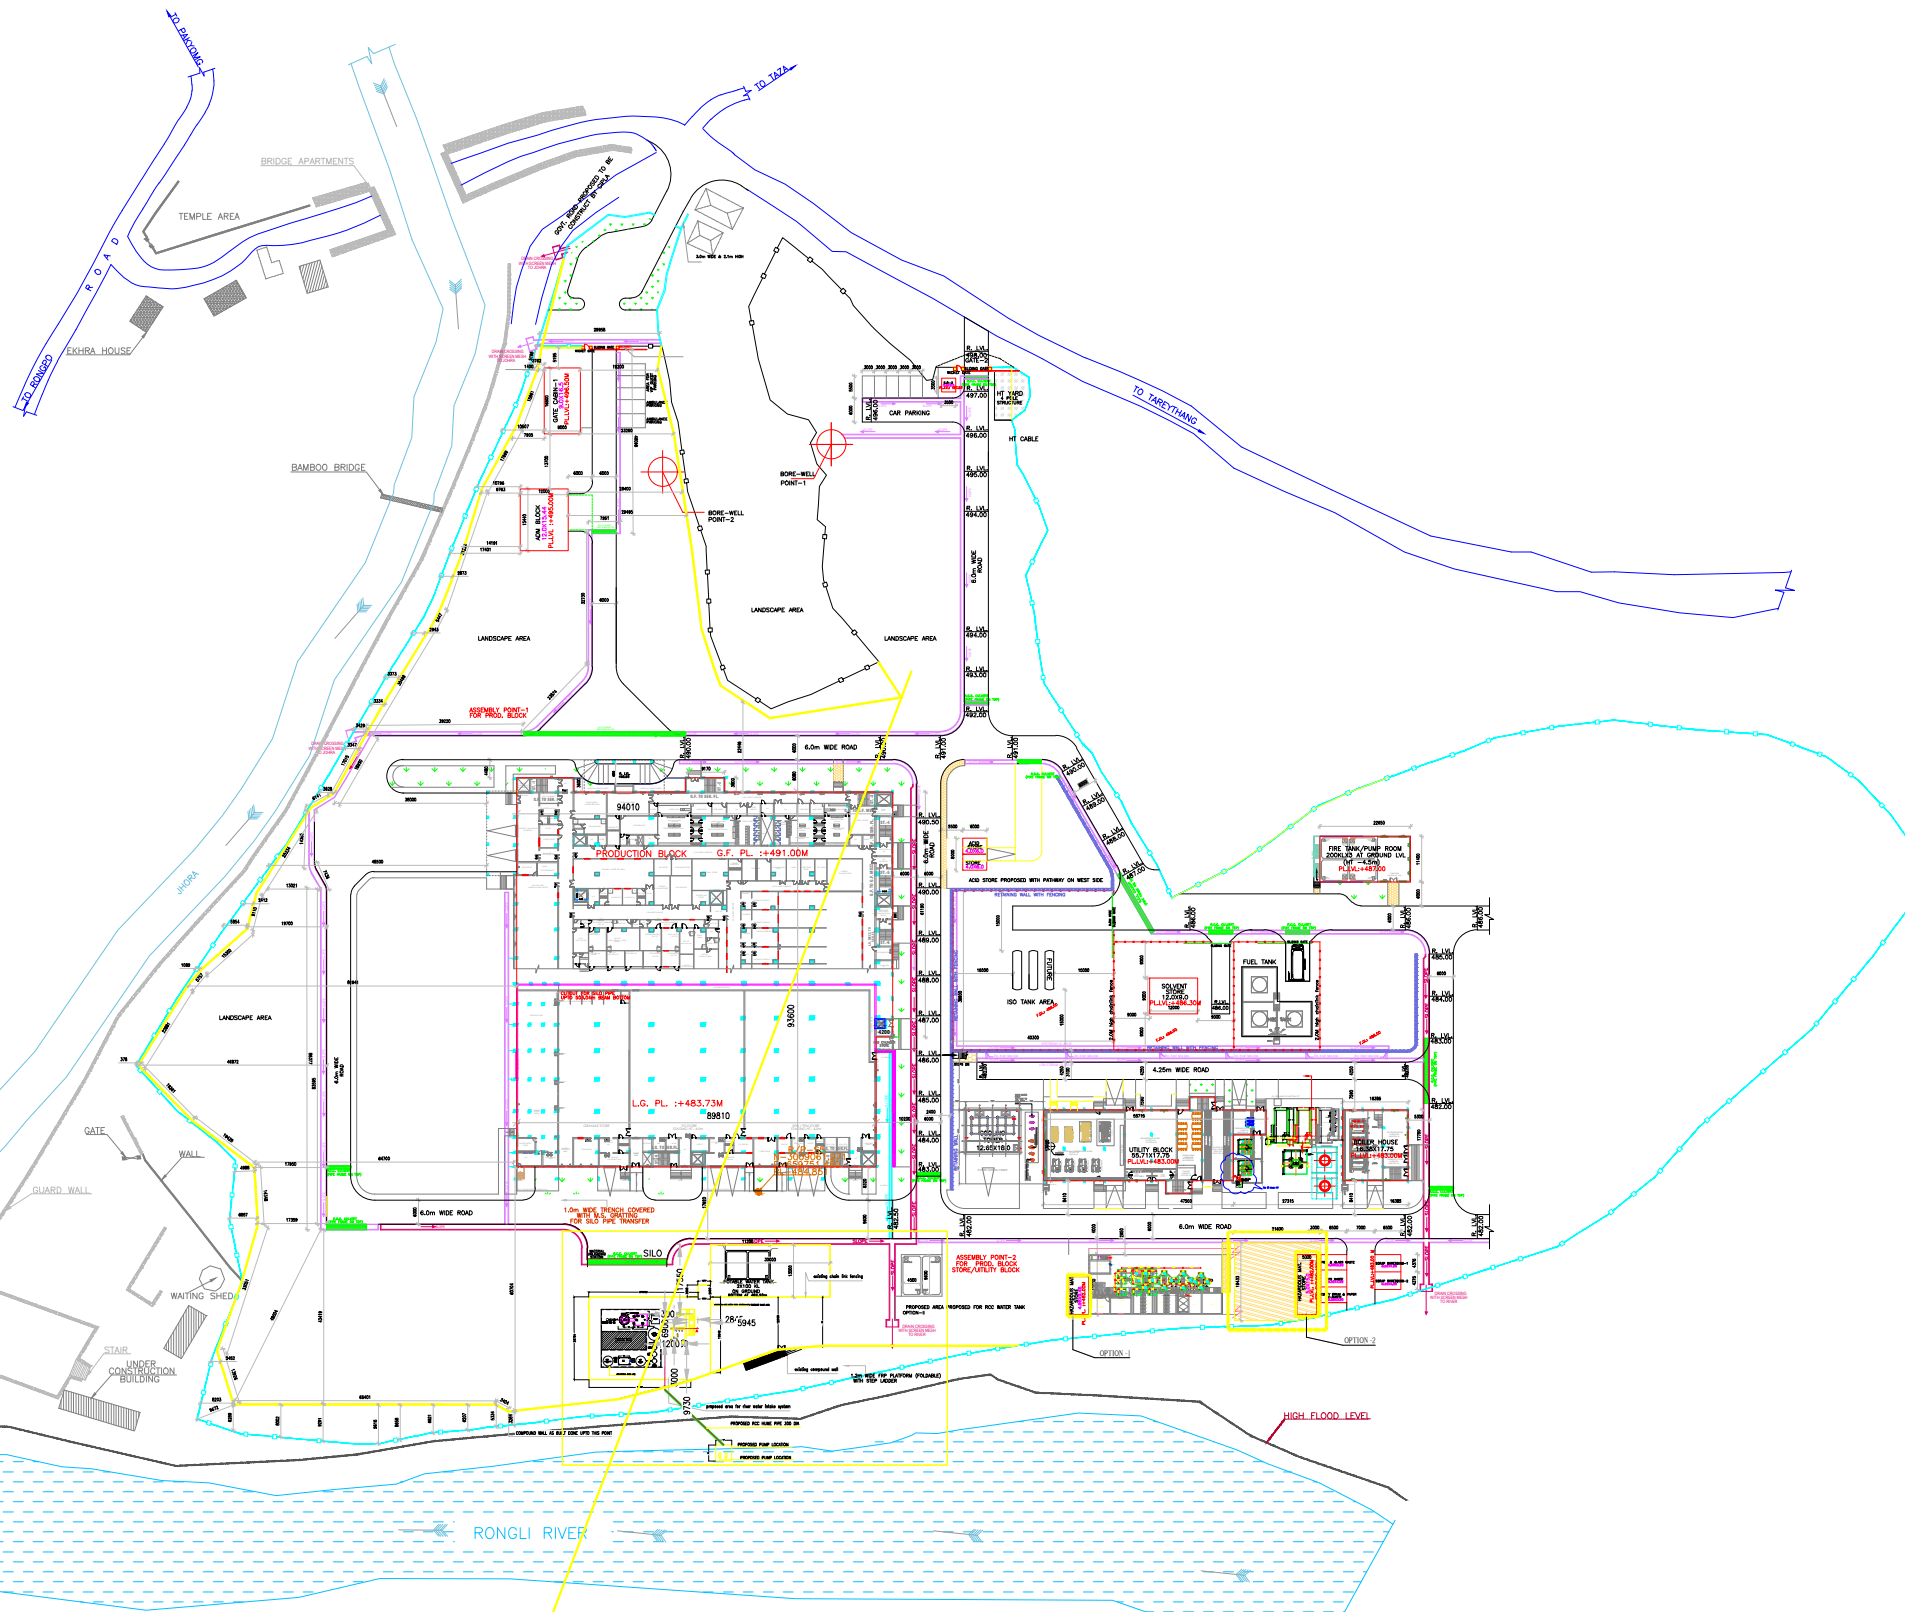


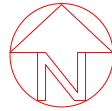


- NOTES :**
1. ALL DIMENSIONS AND SIZES ARE INDICATED IN MILLIMETER UNLESS OTHERWISE SPECIFIED.
 2. ALL ELEVATIONS LEVEL ARE INDICATED IN METER UNLESS OTHERWISE SPECIFIED.
 3. FOR ACTUAL ELEVATIONS LEVEL REFER TO CIVIL DRAWINGS.
 4. THE DRAWING MUST BE READ IN CONJUNCTION WITH ALL ARCHITECTURAL, STRUCTURAL AND OTHER ENGINEERING DRAWINGS.
 5. THE CONTRACTOR MUST VERIFY ALL DIMENSIONS AT SITE AND REPORT ABOUT ANY DISCREPANCIES TO THE CONSULTANTS.

GRAPHICAL SCALE (METERS)

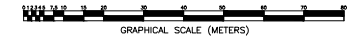

ISSUES		
No.	DATE	ISSUES TO

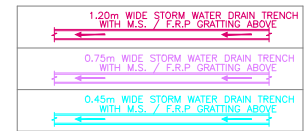

- Boundary as earlier survey
- Existing compound wall

1.0	12.04.2016	A.B.	POINTS RECEIVED FROM MR. BIMAL CHETTRI ON 12.04.2016	LKD
0.9	23.01.2016	A.B.	COOLING TOWER ADDED AS PER DISCUSSION WITH MR. ASHOK ARYA	LKD
0.8	18.11.2015	A.B.	POTABLE / RAW WATER TANK AREA RELOCATED AS PER MAIL RECEIVED ON 18.11.2015	LKD
0.7	23.09.2015	A.B.	SILLO AREA INCORPORATED AS PER MAIL ON 23.09.15	LKD
0.6	12.09.2015	A.B.	GATE CABIN-1 SHIFTED TOWARDS THE NORTH BY 5M AS PER MAIL FROM CIPLA ON 11.09.2015	LKD
0.5	05.09.2015	A.B.	WEIGH BRIDGE RELOCATED AS PER MAIL FROM CIPLA ON 05.09.2015	LKD
0.4	18.08.2015	A.B.	LAYOUT REVISED AS PER MEETING AT CIPLA SIKKIM LAYOUT RECEIVED FROM DCPL SIKKIM IN 17.08.15	LKD
0.3	10.07.2015	A.B.	LAYOUT SOFT COPY HAND OVER TO SKD DURING MEETING AT CIPLA MUMBAI (08.07.2015)	SKD
0.2	04.07.2015	A.B.	AS PER MOM RECEIVED FROM DCPL MUMBAI ON 04.07.2015	KKD
0.1	30.06.2015	A.B.	AS PER DISC. OF KYD WITH CLIENT	KKD
No.	DATE	REV.BY:	DESCRIPTION	CHECKED BY
REVISIONS				

REFERENCE DRAWING:

CLIENT:- **M/S. CIPLA LTD. RORATHANG-SIKKIM**

PROJECT CONSULTANT:- **Doshi Consultants (P) Ltd.**
401-CITY CENTER, 570 M.G. ROAD, INDORE-1 (M.P.)INDIA.
PH.NO.:+91-731-2541457,+91-731-4011555
E-Mail : projects@doshicon.com

DRAWING TITLE: **SITE PLAN**
Actual Plot Boundary For Forest Dept. Survey

PROJECT TITLE: PHARMA PROJECT			
RELEASED FOR:	DESIGNED BY:	DESIGNED BY:	08.04.2014
STUDY & APPROVAL	APPROVA	08.04.2014	
SCALE: 1:800@A1	CHECKED BY:	CHECKED BY:	08.04.2014
DRAWING No: 3/486/CIPLA-II/SP/AR-101	APPROVED BY:	APPROVED BY:	08.04.2014
	VER. No:	CR 2.7	WR 1.0

COMPOUND WALL AS BUILT DONE UPTO THIS LINE **SITE PLAN -WR-1.0**

THIS DRAWING IS THE PROPERTY OF DOSHI CONSULTANTS (P) LTD. AND MUST NOT BE COPIED WITHOUT THEIR WRITTEN CONSENT NOR MADE KNOWN TO THE THIRD PARTY.