



No. D43K8
Scale 1:50,000

D43K3 (57B/3)	D43K7 (57B/7)	D43K11 (57B/11)
D43K4 (57B/4)	D43K8 (57B/8) Chitradurga KARNATAKA	D43K12 (57B/12)
D43Q1 (57C/1)	D43Q5 (57C/5)	D43Q9 (57C/9)

1 Chikmagalur, KARNATAKA.
2 Tumkur, KARNATAKA.

भारतीय सर्वेक्षण विभाग SURVEY OF INDIA

1st Edition 2010.

Price: Rs. 103/-

CONVENTIONAL SYMBOLS

Express highway, with toll, with bridge, with distance stone	20
Roads, metalled, according to importance	14
Roads, double carriageway, according to importance	14
Unmetalled road, Cart track, Push track with gate, Foot path	14
Stream, with track in bed, unconfined. Canal	14
Dam: masonry or rock-filled, earthenwork. Well	14
River: dry water channel, with island & rocks. Tidal river	14
Submerged rocks. Shoal. Swamp. Reeds	14
Well: lined, unlined. Tube-well. Spring. Tanks: perennial, dry	14
Embankment: earth or rock. Embankment ground	14
Railways, broad gauge: double, single with station, under construction	14
Railways, other gauges: double, single with station, under construction	14
Mineral line or tramway. Kin. Cutting with tunnel	14
Contours with sub-features. Rocky slopes. Cliffs	14
Sand features (Tidal, (Z)land (high) permanent, (S)unesis (shifting)	14
Towns or Villages: inhabited, deserted. Fort	14
Habitat: permanent, temporary. Town. Artificial	14
Temple. Chhatra. Church. Mosque. Igloo. Tomb. Graves	14
Lighthouse. Lightship. Buoy: lighted, unlighted. Anchorage	14
Mine: Vene on trails. Grass. Scrub	14
Palms: palmyra, other. Plantain. Conifer. Bamboo. Other trees	14
Areas: cultivated, wooded. Surveyed tree	14
Boundary, international	14
State: demarcated, undemarcated	14
District: subdivision: taluk or taluk forest	14
Boundary: surveyed, unlocated	14
Height, triangulated: station, point, approximate	14
Benchmark: geodetic, tertiary, canal	14
Post office. Telegraph office. Overhead tank	14
Post house or inspection bungalow. Coast house. Police station	14
Camping ground. Forest: reserved, protected	14
Spaced names: administrative, locality or tribal	14
Hospital. Dispensary. Veterinary: Hospital / Dispensary	14
Aerodrome. Helipad. Tourist site	14
Power line: with pylons surveyed, with poles unsurveyed	14

REFERENCES


NH 13 National Highway No. 13 NH 4 National Highway No. 4

NOTES

Heights are in metres and above Indian mean sea level.
Contours are approximate.
A relative height, R, represents the approximate height, in metres, between the top and bottom of a steep slope.
Unmetalled roads are jeepable in dry season.
The kilometre stone numbers along roads and railways are shown in slant type, e.g., '3' whereas the telephone numbers along roads and canals are shown in upright type, e.g., '2'.
Tanks shown dry, in this area usually contain water from July to February.
A relative height, e.g., '20' marked along a canal, indicates the height of the top of the canal embankment above the adjacent country.
Belted trees are shown thus: T
Wooded areas are shown thus: T

COMPILATION INDEX

A. Surveyed during 1974-75. Updated for major details during 2005-06.

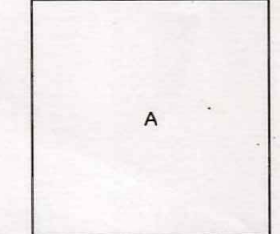

Projection - UTM Datum - WGS 84

Magnetic Variation from True North about 1° West in 2005.

1:50,000


500 m to 1 km
2 cm to 1 km
CONTOUR INTERVAL 20 METRES

For further details about this map, please contact
Director
Karnataka Geo-Spatial Data Centre
Survey of India, Koramangala II Block
Bangalore.

WEBSITE - www.surveyofindia.gov.in

Reproduction in whole or part by any means is prohibited
without the written permission of Survey of India, the
National Mapping Agency.

GOVERNMENT OF INDIA COPYRIGHT, 2010.

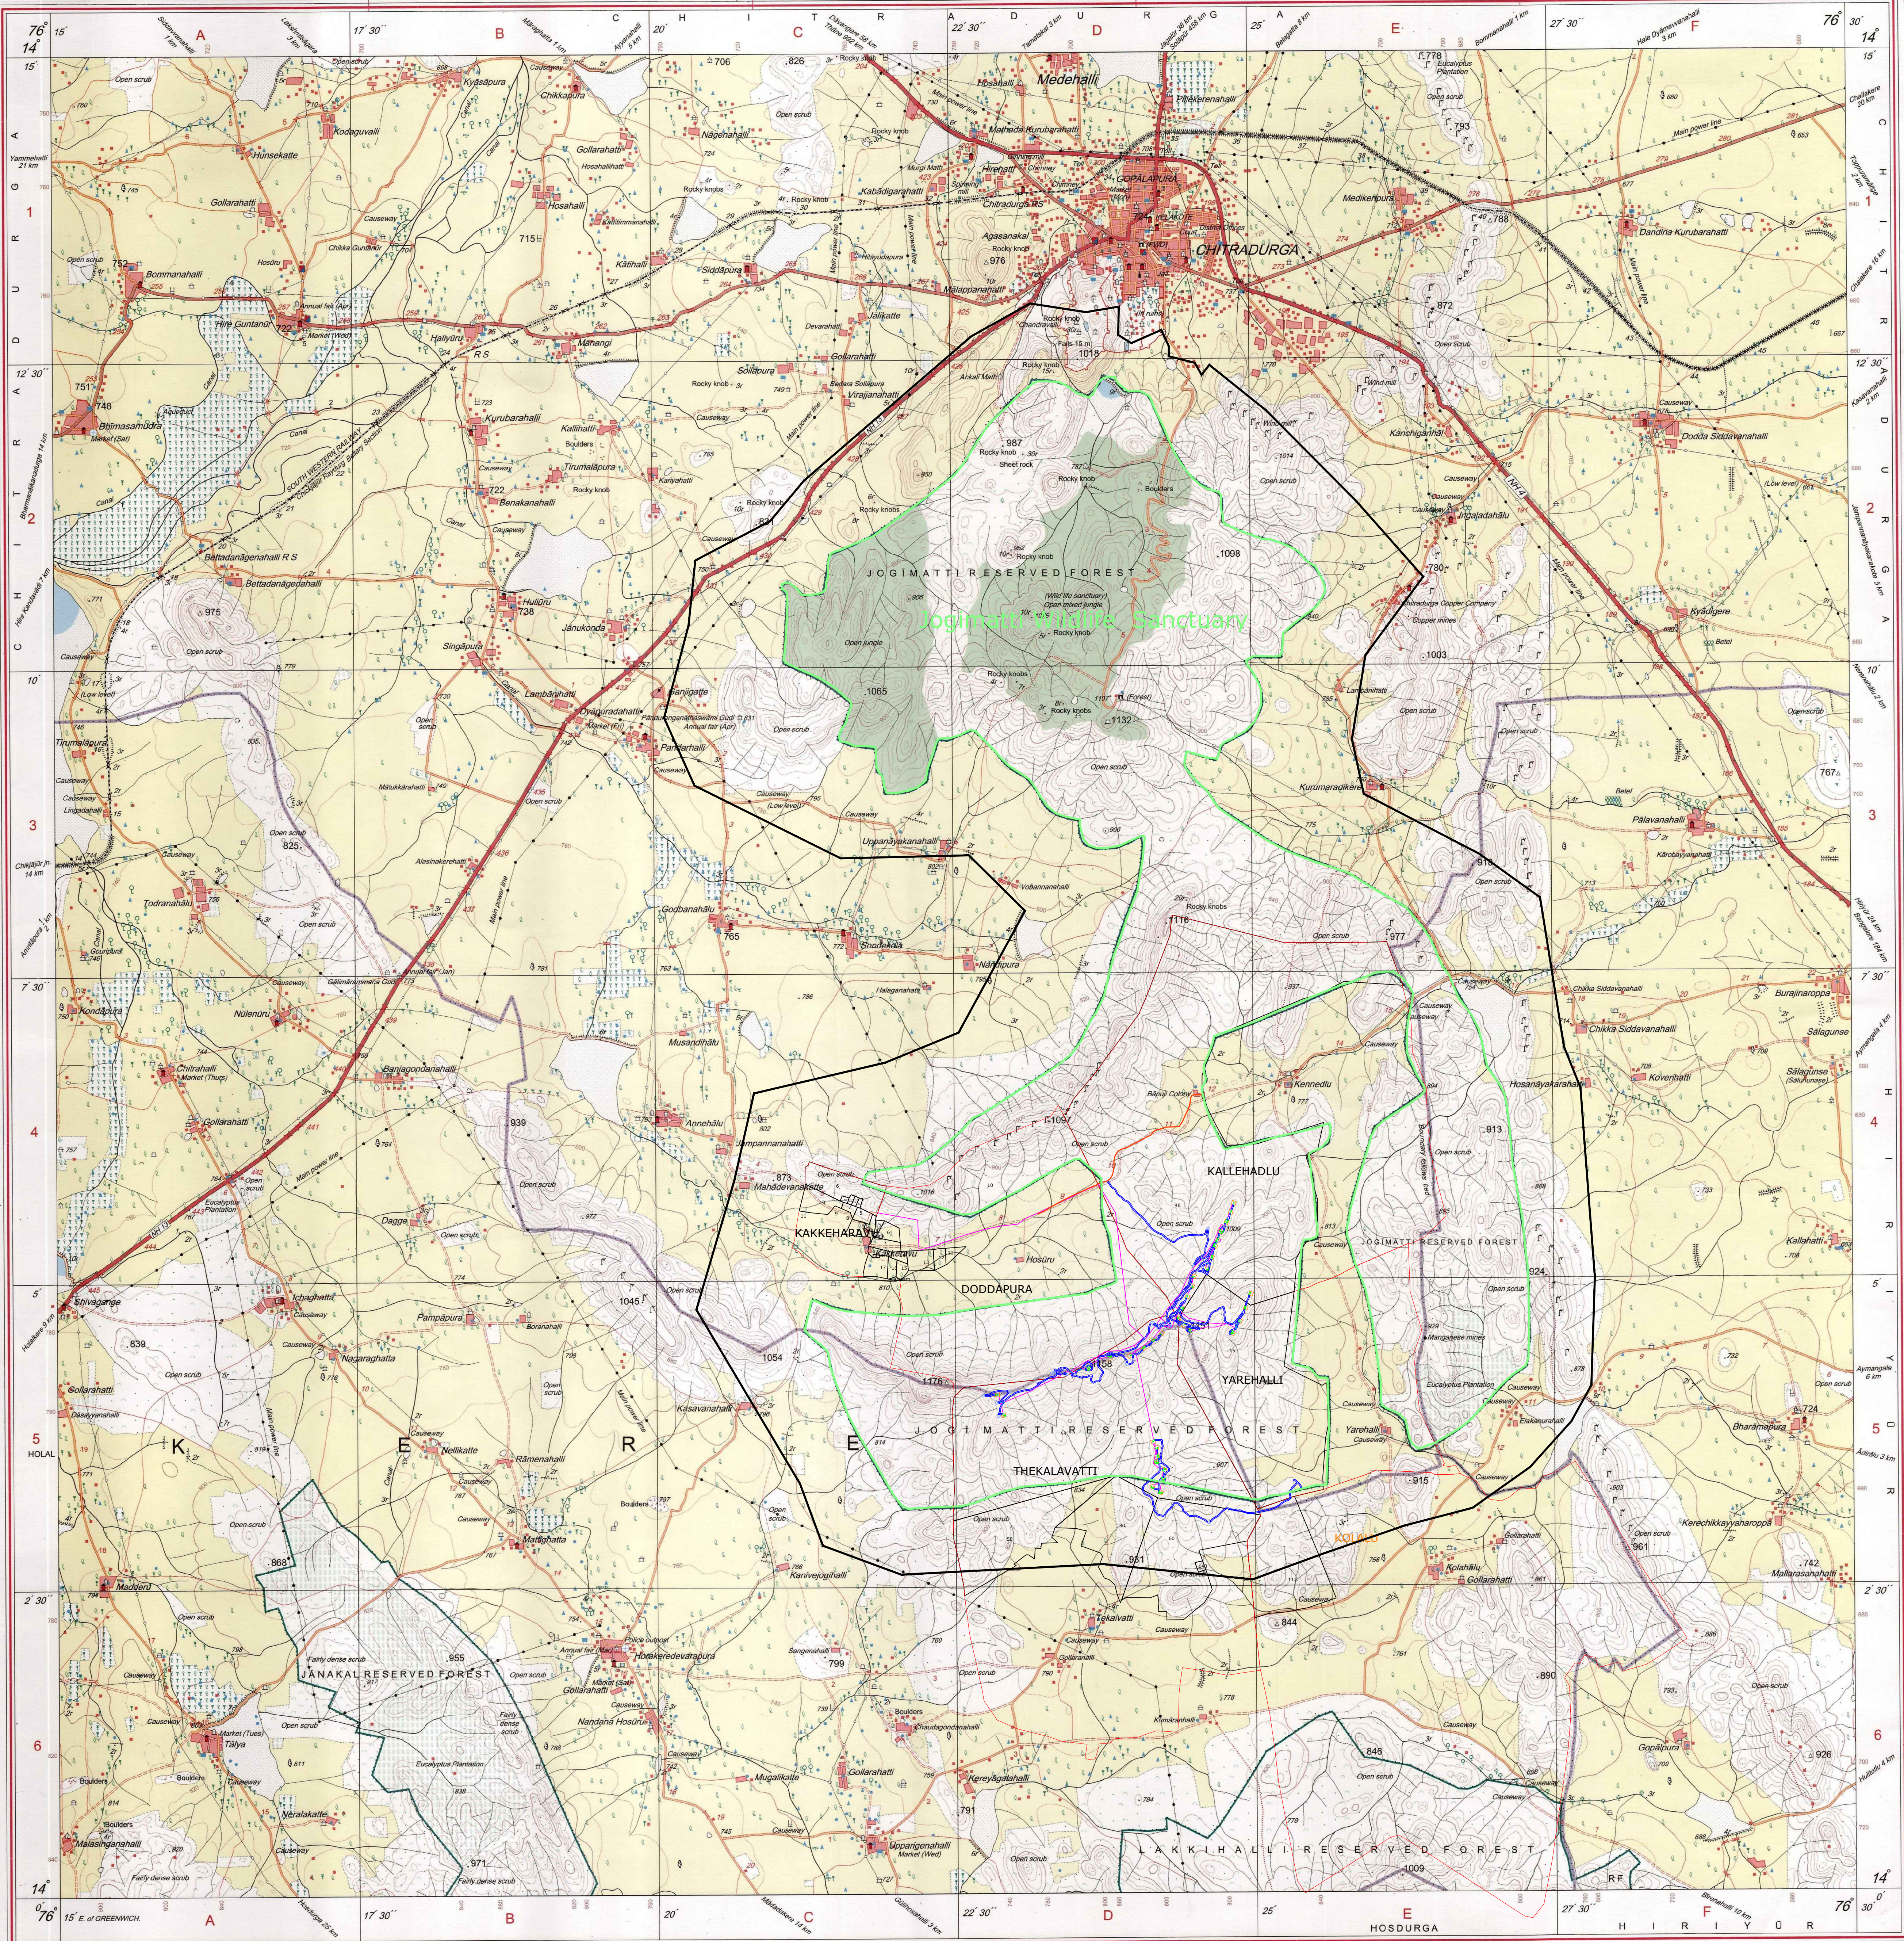

REG. No. 9474 - SPG D-10 (Karnataka GDC-1:50,000-10131).

वर्तमान में सर्वेक्षण के लिए उपयुक्त है।
Published under the direction of Dr. Swarni Subba Rao, Surveyor General of India,
Survey of India, Hathi Bunka Estate, Post Box No. 37, Dehra Dun - 248001 (Uttarakhand),
Department of Science & Technology, Government of India.

PRINTED AT THE SOUTHERN PRINTING GROUP OF SURVEY OF INDIA.

- formerly known as -

Scale:- 1 : 50000

PROJECT:- WIND POWER PROJECT
AT GIM1 SITE CHITRADURGA (DIST)
KARNATAKA STATE

TITLE:- AS BUILT MOSAIC MAP FOR GIM1 SITE

DRAWING NO.:- KAR/GIM1/1

ASBUILT-1/1

BOUNDARY TYPE	LEGEND
Green line	JOGIMATTI WILDLIFE SANCTUARY
Red line	ECO-SENSITIVE ZONE OF JOGIMATTI WILDLIFE SANCTUARY

AS BUILT FEATURES	LEGEND
Blue line	VILLAGE BOUNDARY
Red line	FOREST AS BUILT ROAD
Blue line	INSIDE PLATFORM ROAD
Red line	FOREST AS BUILT ELECTRIC LINE
Blue line	INSIDE ROAD ELECTRIC LINE
Red line	FOREST AS BUILT YCB YARD
Blue line	INSIDE ROAD YCB YARD
Red line	FOREST AS BUILT PLATFORM AREA WITH NO
Blue line	INSIDE ROAD COORDINATES OF ROAD & BE LINE