
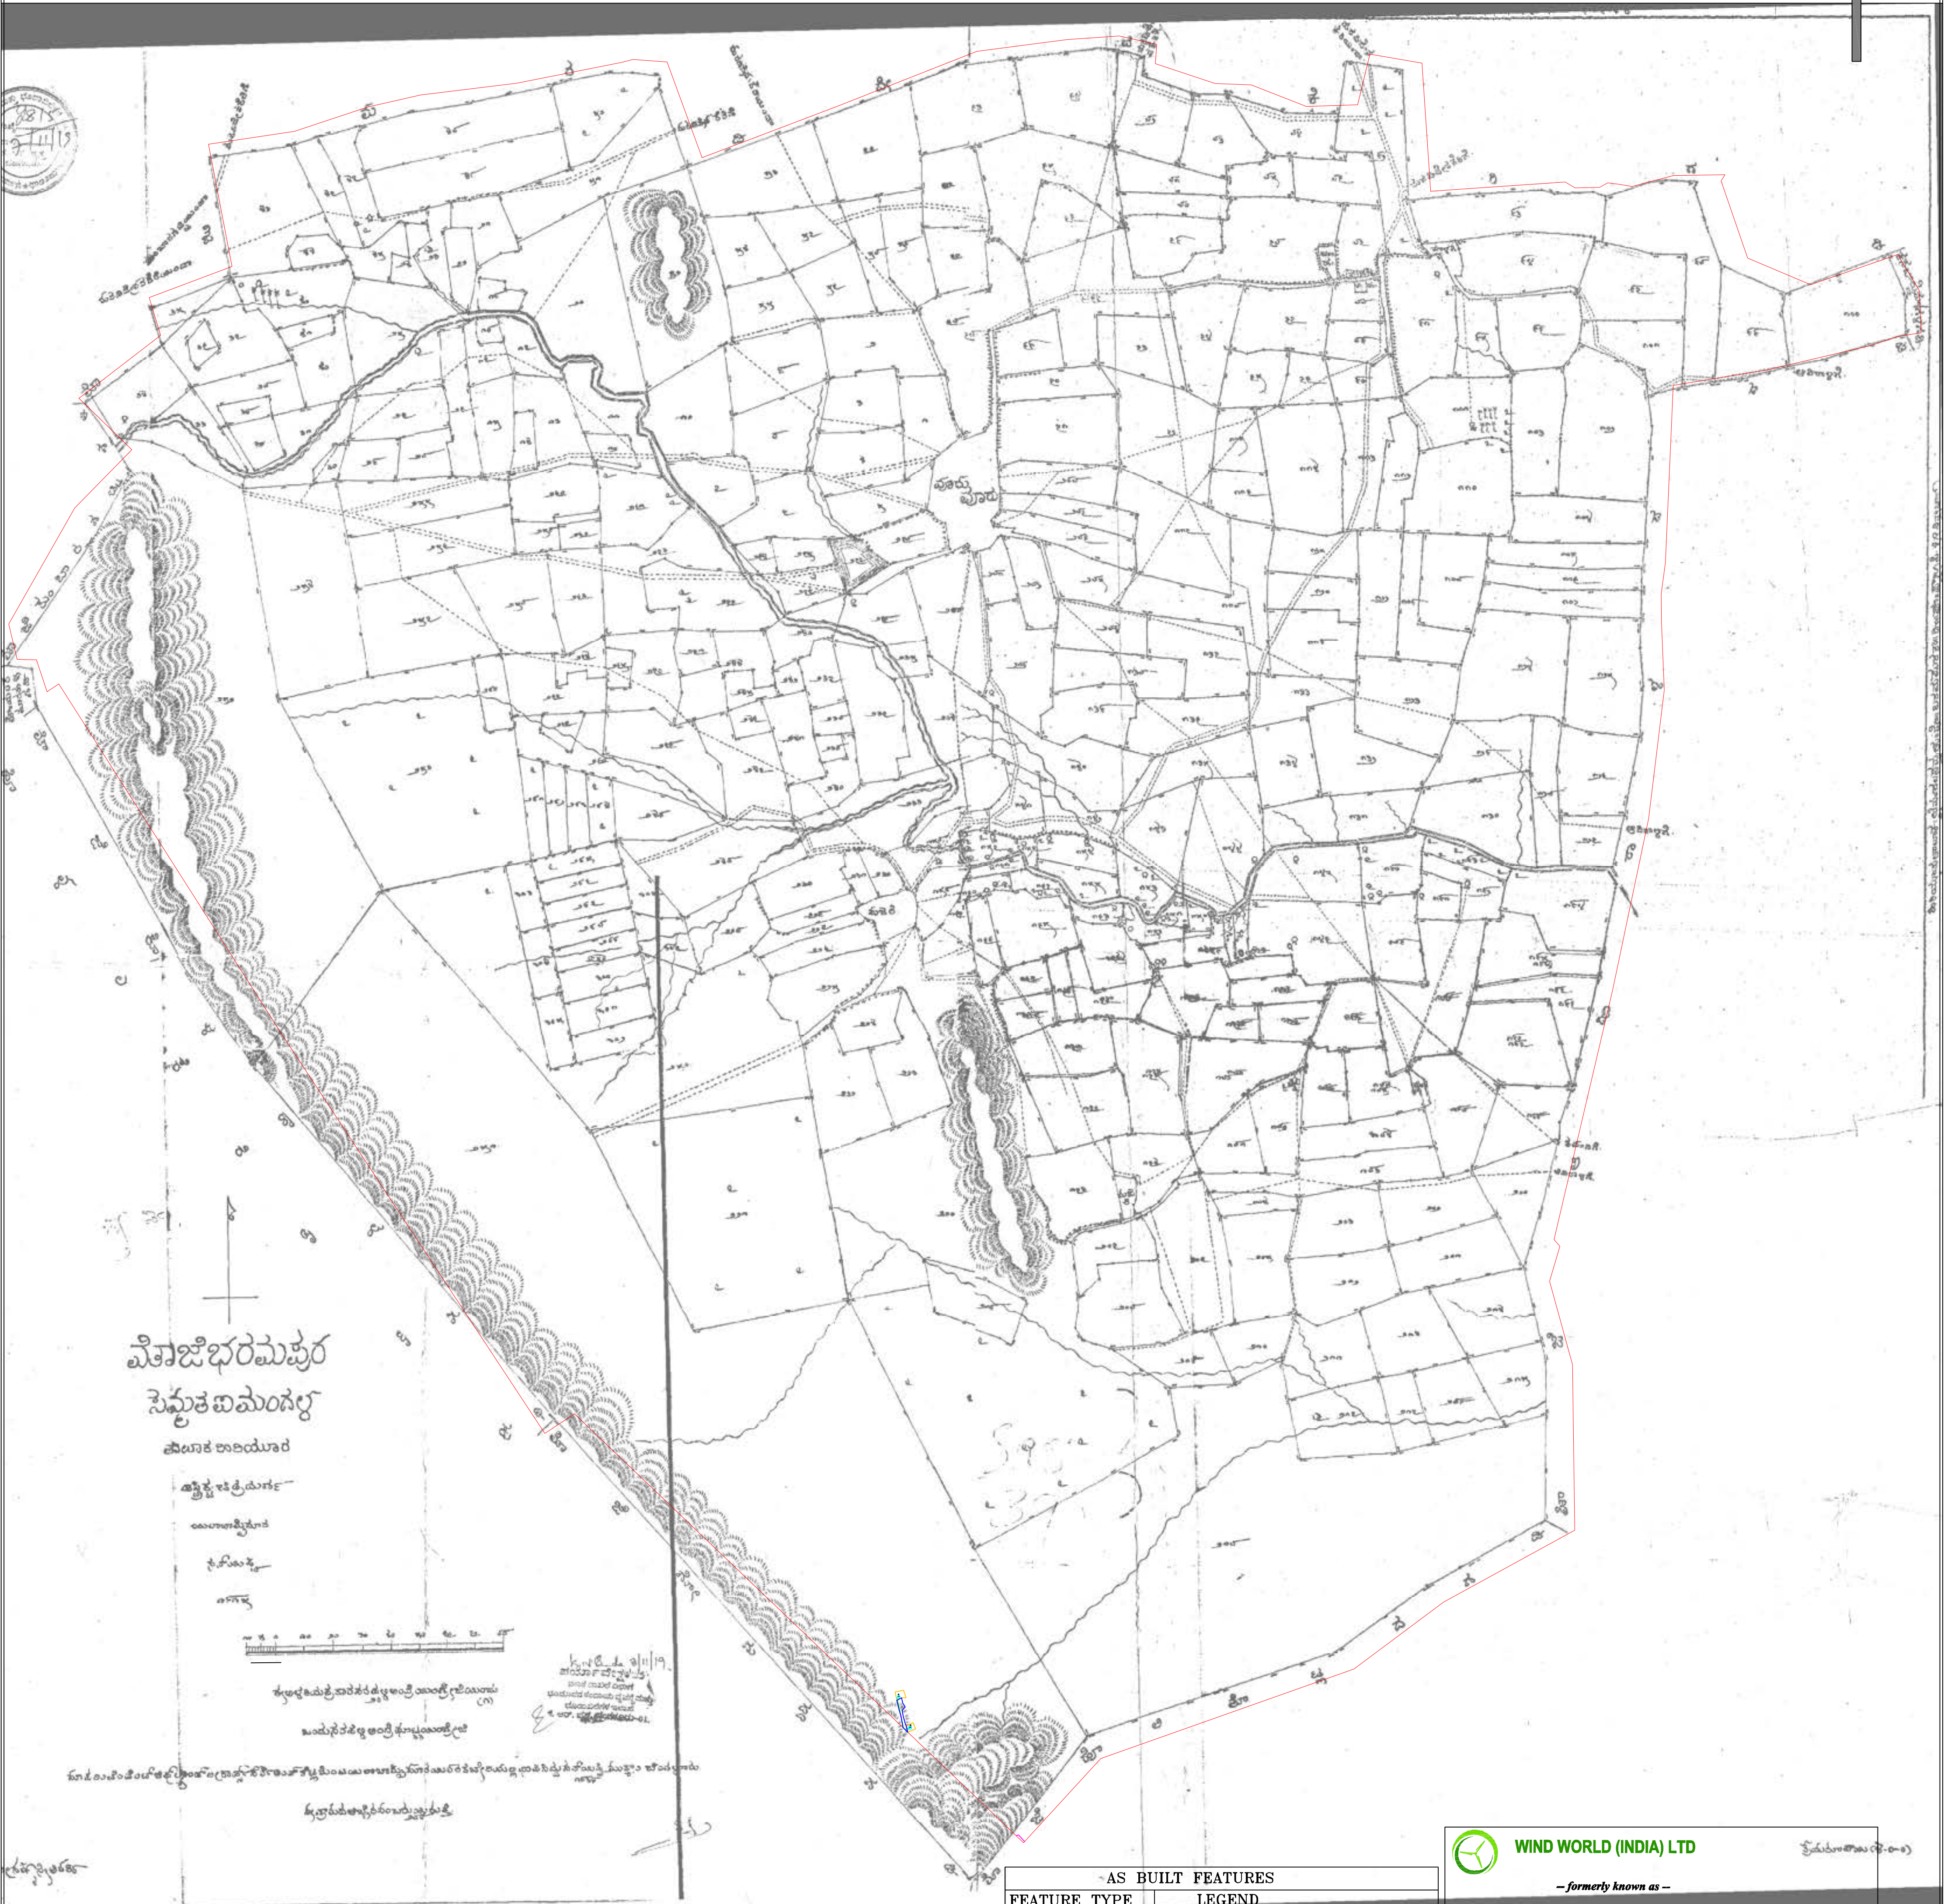



WIND POWER PROJECT
AT GOGUDDA SITE CHITRADURGA(DIST), KARNATAKA STATE.
AS BUILT DRAWING SUPERIMPOSED ON VILLAGE MAP
FOR BRAHMAPURA VILLAGE AT GOGUDDA SITE

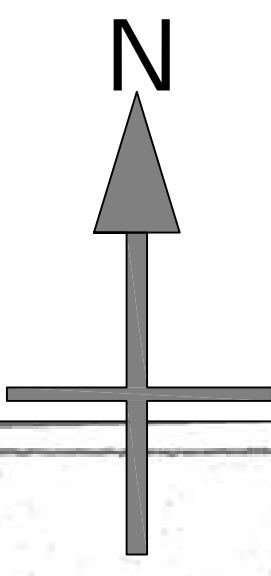

AS BUILT FEATURES	
FEATURE TYPE	LEGEND
	VILLAGE BOUNDARY
	AS BUILT ROAD
	NON FOREST ROAD
	AS BUILT ELECTRIC LINE
	NON FOREST ELECTRIC LINE
	AS BUILT VCB YARD
	NON FOREST VCB YARD
	AS BUILT PLATFORM AREA WITH NOS
	NON FOREST PLATFORM AREA WITH NOS
	NOS.FOR COORDINATES OF ROAD & EP LINE

**WIND WORLD (INDIA) LTD**
— formerly known as —



Scale:- 1 : 8000

PROJECT:- WIND POWER PROJECT
AT GOGUDDA SITE CHITRADURGA (DIST)
KARNATAKA STATE

TITLE:- VILLAGE MAP FOR BRAHMAPURA VILLAGE

DRAWING NO.:- KAR/GOGUDDA/1 ASBUILT-1/1

WIND POWER PROJECT
AT GOGUDDA SITE CHITRADURGA(DIST), KARNATAKA STATE.
AS BUILT DRAWING SUPERIMPOSED ON VILLAGE MAP
FOR GOGUDDA VILLAGE AT GOGUDDA SITE

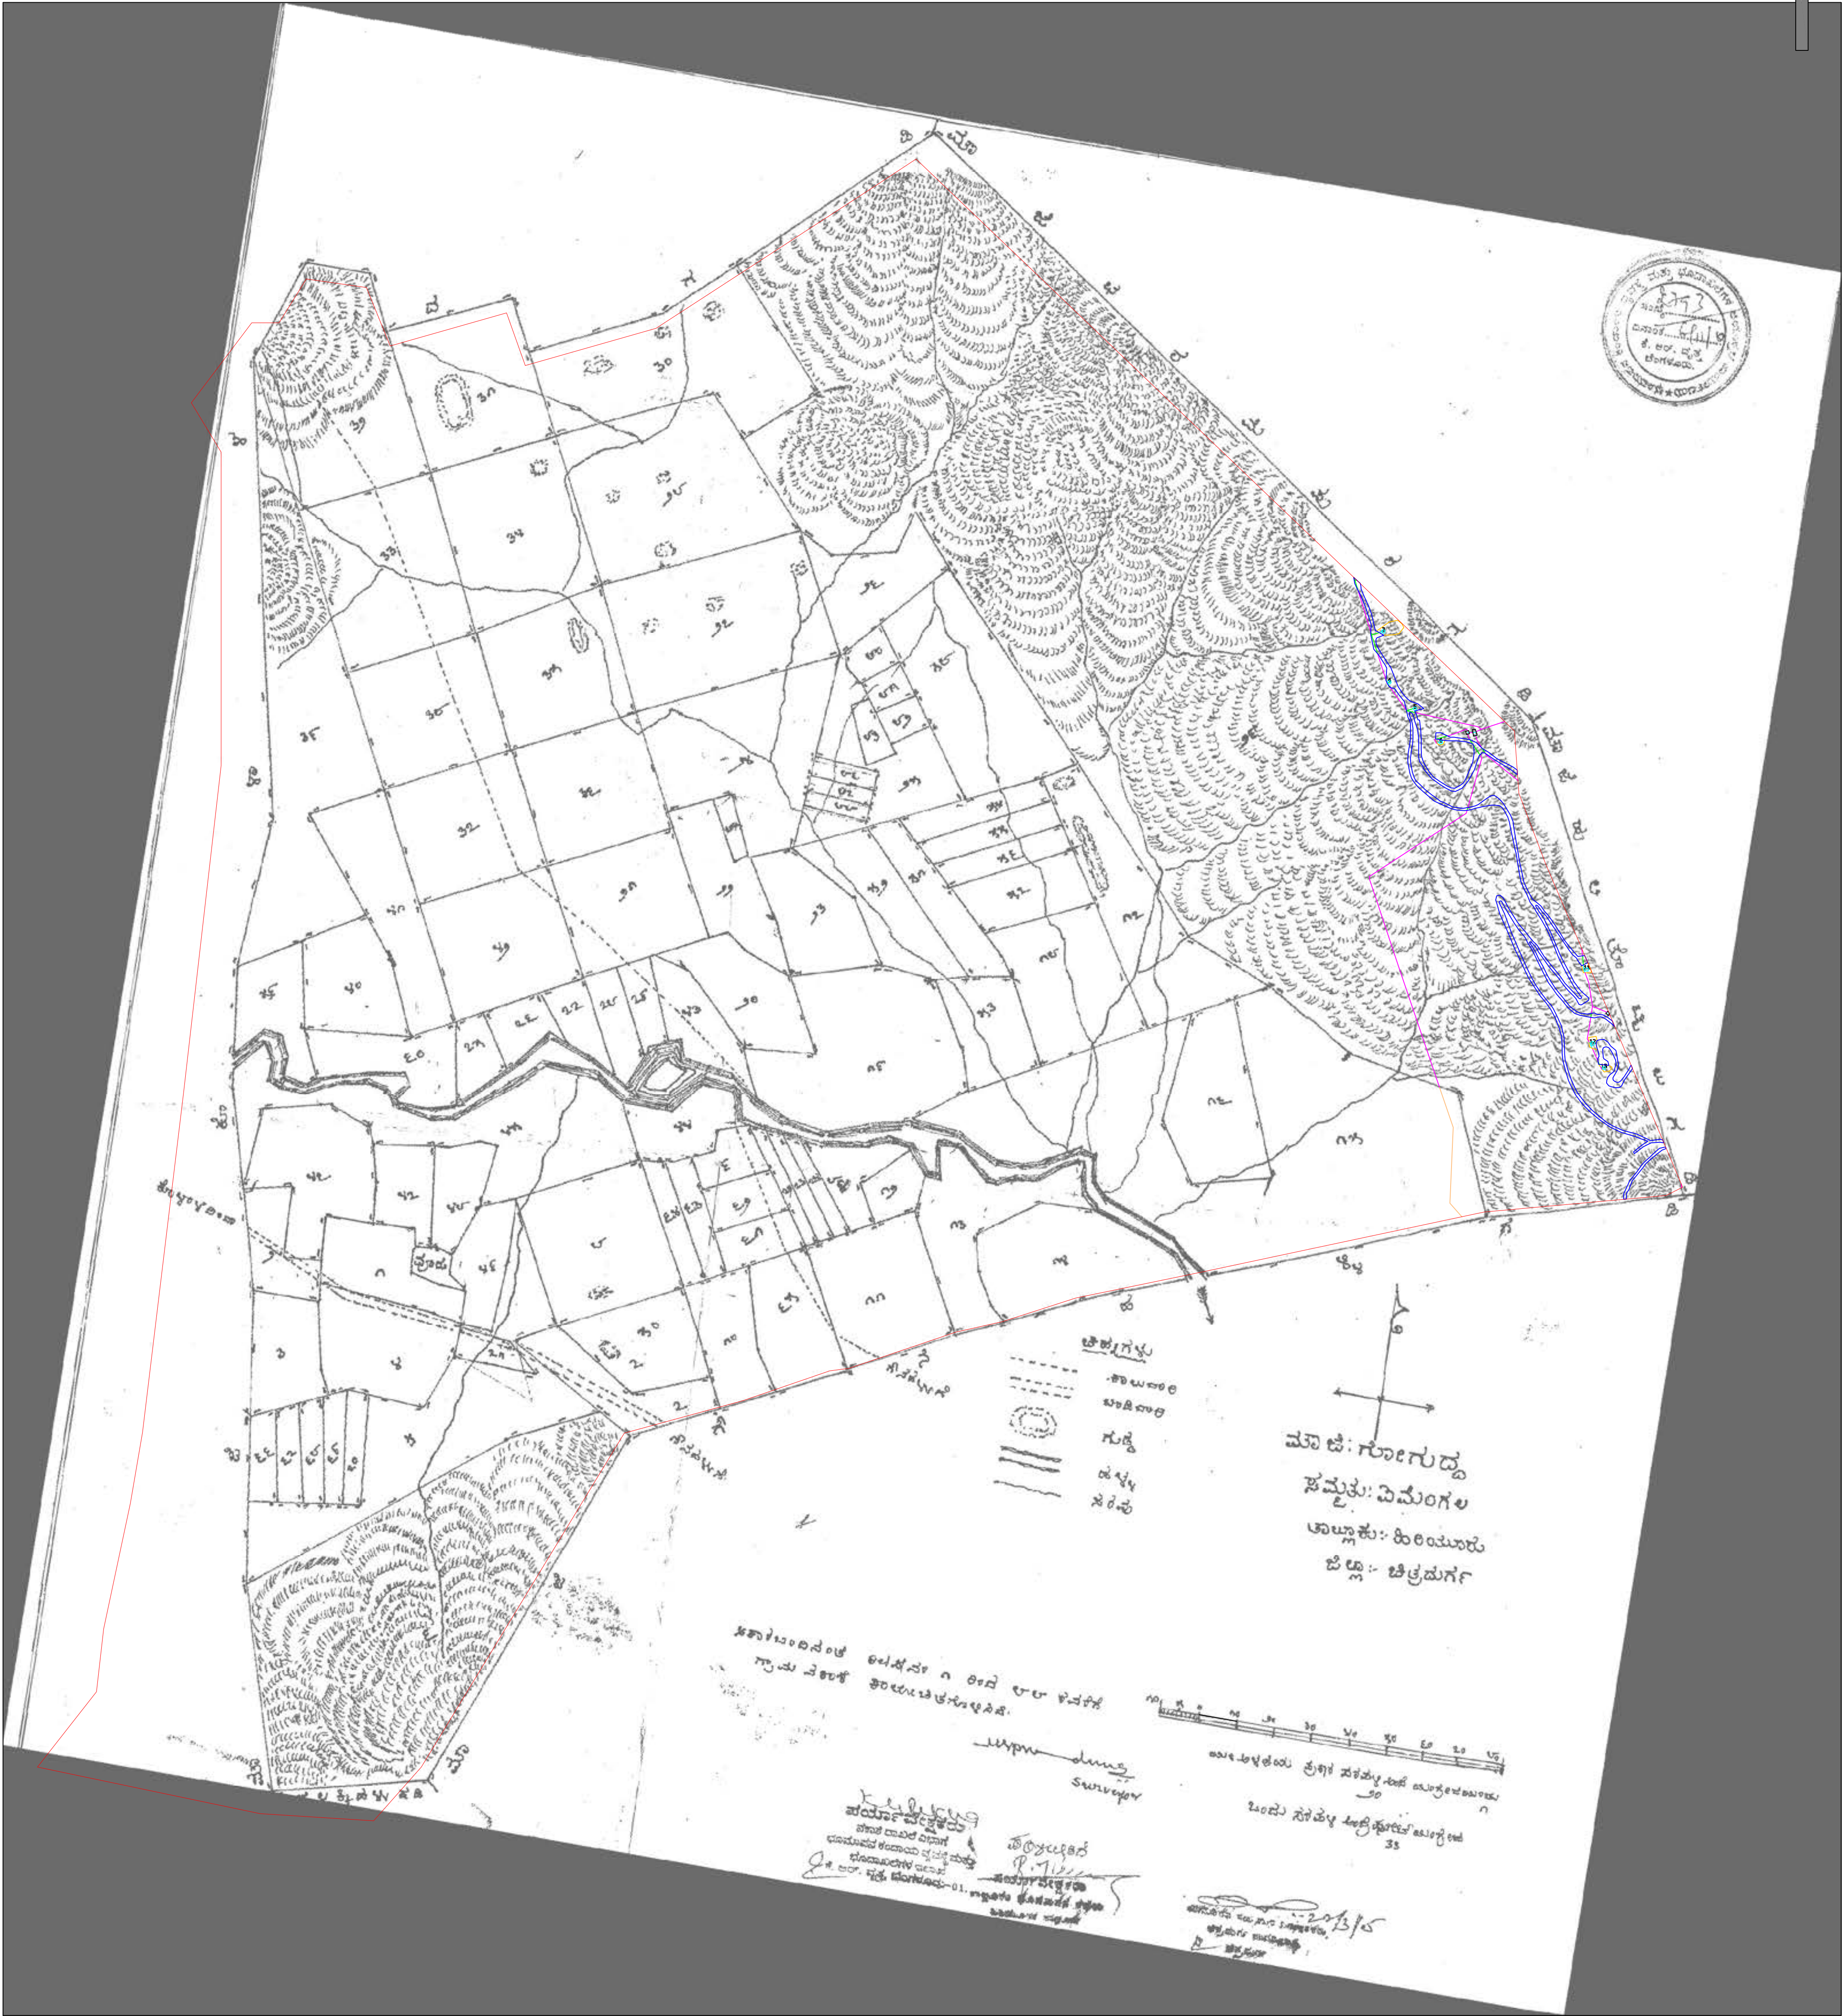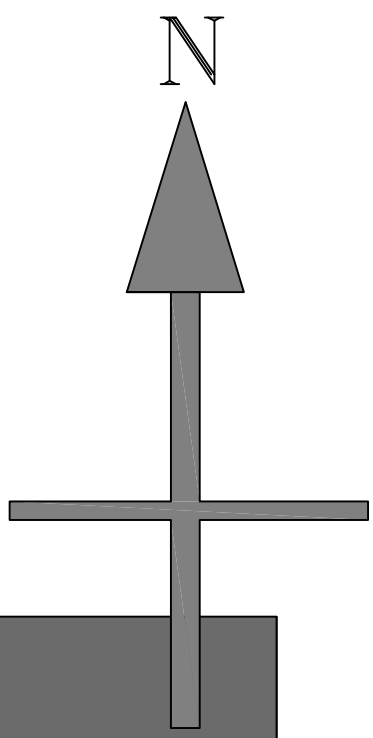

AS BUILT FEATURES	
FEATURE TYPE	LEGEND
	VILLAGE BOUNDARY
	AS BUILT ROAD
	NON FOREST ROAD
	AS BUILT ELECTRIC LINE
	NON FOREST ELECTRIC LINE
	AS BUILT VCB YARD
	NON FOREST VCB YARD
1	AS BUILT PLATFORM AREA WITH NOS
1	NON FOREST PLATFORM AREA WITH NOS
1	NOS.FOR COORDINATES OF ROAD & EP LINE



WIND WORLD (INDIA) LTD

— formerly known as —

Scale:- 1 : 8000


PROJECT:- WIND POWER PROJECT
AT GOGUDDA SITE CHITRADURGA (DIST)
KARNATAKA STATE

TITLE:- VILLAGE MAP FOR GOGUDDA VILLAGE

DRAWING NO.:- KAR/GOGUDDA/1

ASBULT-1/1

WIND POWER PROJECT
AT GOGUDDA SITE CHITRADURGA(DIST), KARNATAKA STATE.
AS BUILT DRAWING SUPERIMPOSED ON VILLAGE MAP
FOR GOWNAHALLI VILLAGE AT GOGUDDA SITE

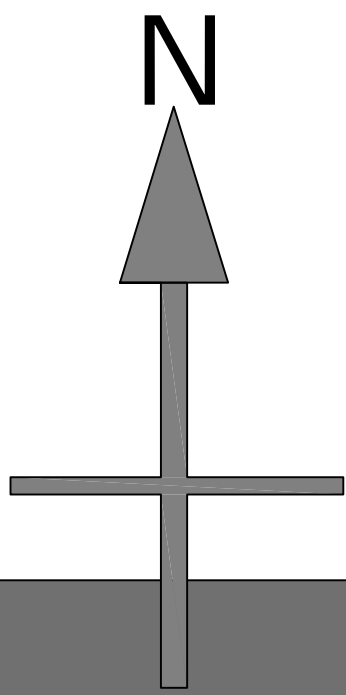

AS BUILT FEATURES	
FEATURE TYPE	LEGEND
	VILLAGE BOUNDARY
	AS BUILT ROAD
	NON FOREST ROAD
	AS BUILT ELECTRIC LINE
	NON FOREST ELECTRIC LINE
	AS BUILT VCB YARD
	NON FOREST VCB YARD
1	AS BUILT PLATFORM AREA WITH NOS
1	NON FOREST PLATFORM AREA WITH NOS
1	NOS.FOR COORDINATES OF ROAD & EP LINE



WIND WORLD (INDIA) LTD

— formerly known as —

Scale:- 1 : 8000

PROJECT:- WIND POWER PROJECT
AT GOGUDDA SITE CHITRADURGA (DIST)
KARNATAKA STATE


TITLE:- VILLAGE MAP FOR GOWNAHALLI VILLAGE

DRAWING NO.:- KAR/GOGUDDA/1

ASBULT-1/1

WIND POWER PROJECT
AT GOGUDDA SITE CHITRADURGA(DIST), KARNATAKA STATE.
AS BUILT DRAWING SUPERIMPOSED ON VILLAGE MAP
FOR GUDIHAL VILLAGE AT GOGUDDA SITE

N

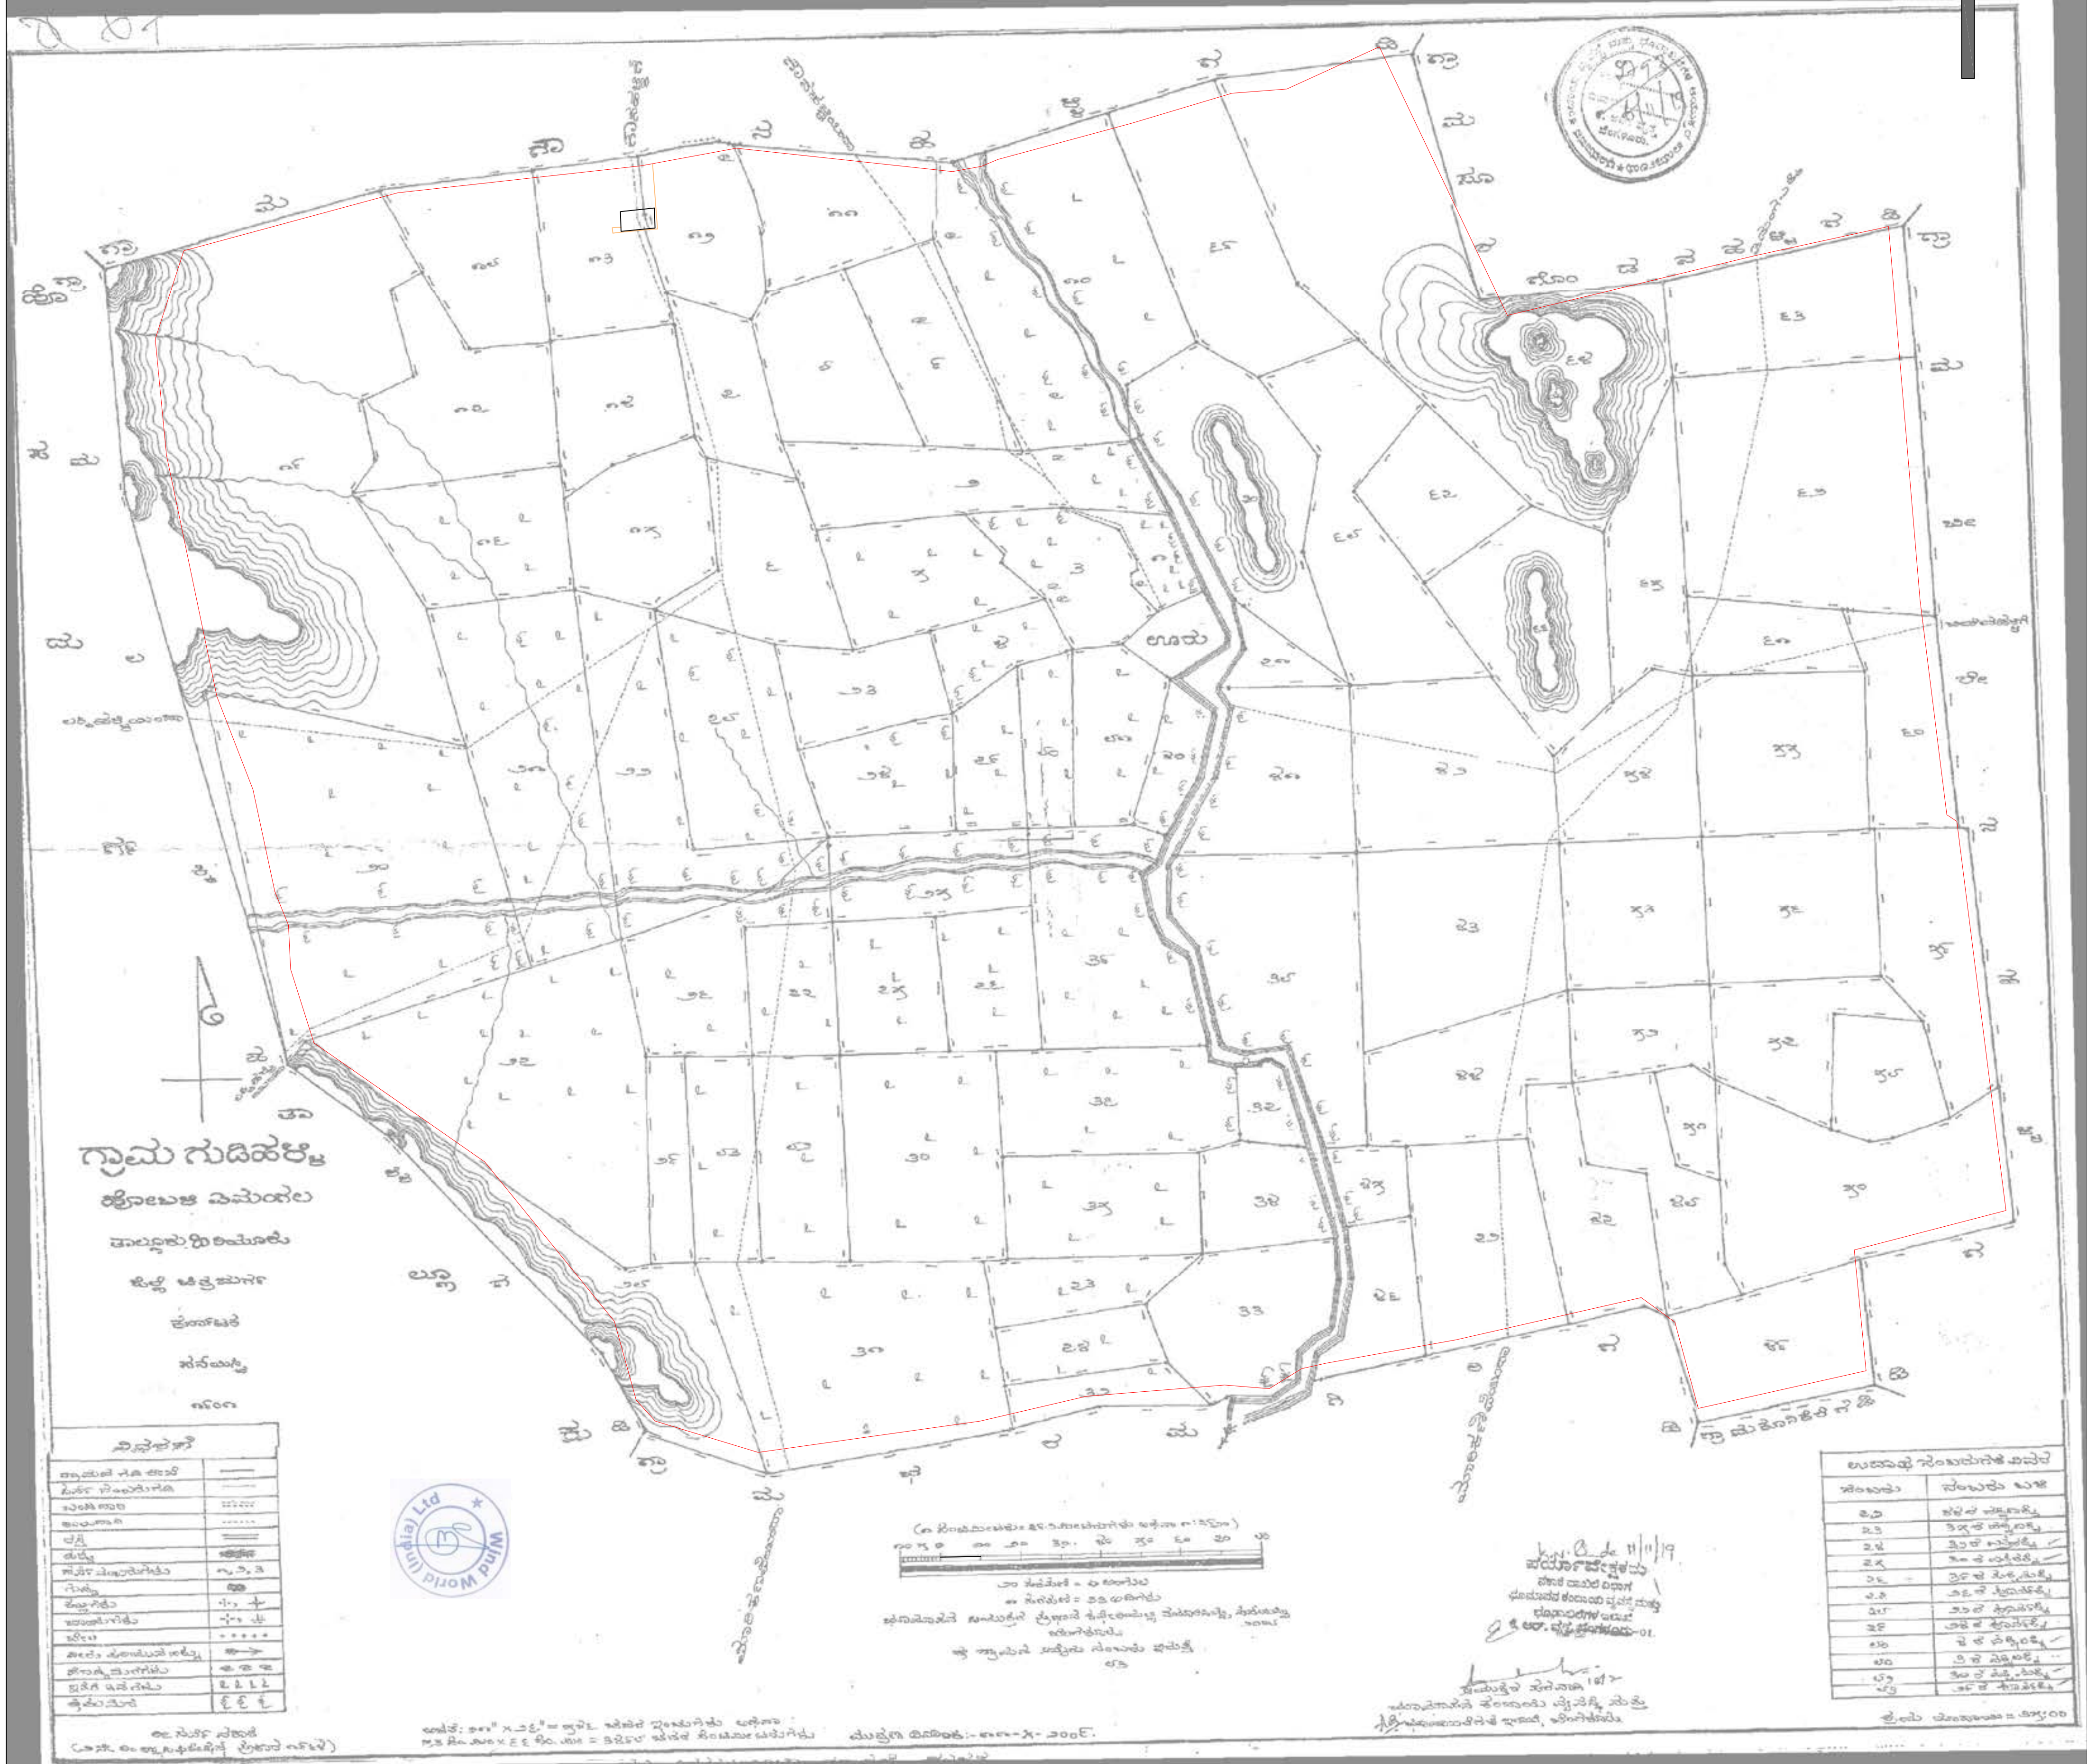

AS BUILT FEATURES	
FEATURE TYPE	LEGEND
	VILLAGE BOUNDARY
	AS BUILT ROAD
	NON FOREST ROAD
	AS BUILT ELECTRIC LINE
	NON FOREST ELECTRIC LINE
	AS BUILT VCB YARD
	NON FOREST VCB YARD
	AS BUILT PLATFORM AREA WITH NOS
	NON FOREST PLATFORM AREA WITH NOS



WIND WORLD (INDIA) LTD

—formerly known as —

Scale:- 1 : 8000



PROJECT:- WIND POWER PROJECT
AT GOGUDDA SITE CHITRADURGA (DIST)
KARNATAKA STATE

TITLE:- VILLAGE MAP FOR GUDIHAL VILLAGE


DRAWING NO.:- KAR/GOGUDDA/1

ASBULT-1/1

WIND POWER PROJECT
AT GOGUDDA SITE CHITRADURGA(DIST), KARNATAKA STATE.
AS BUILT DRAWING SUPERIMPOSED ON VILLAGE MAP
FOR HULITOTLU VILLAGE AT GOGUDDA SITE

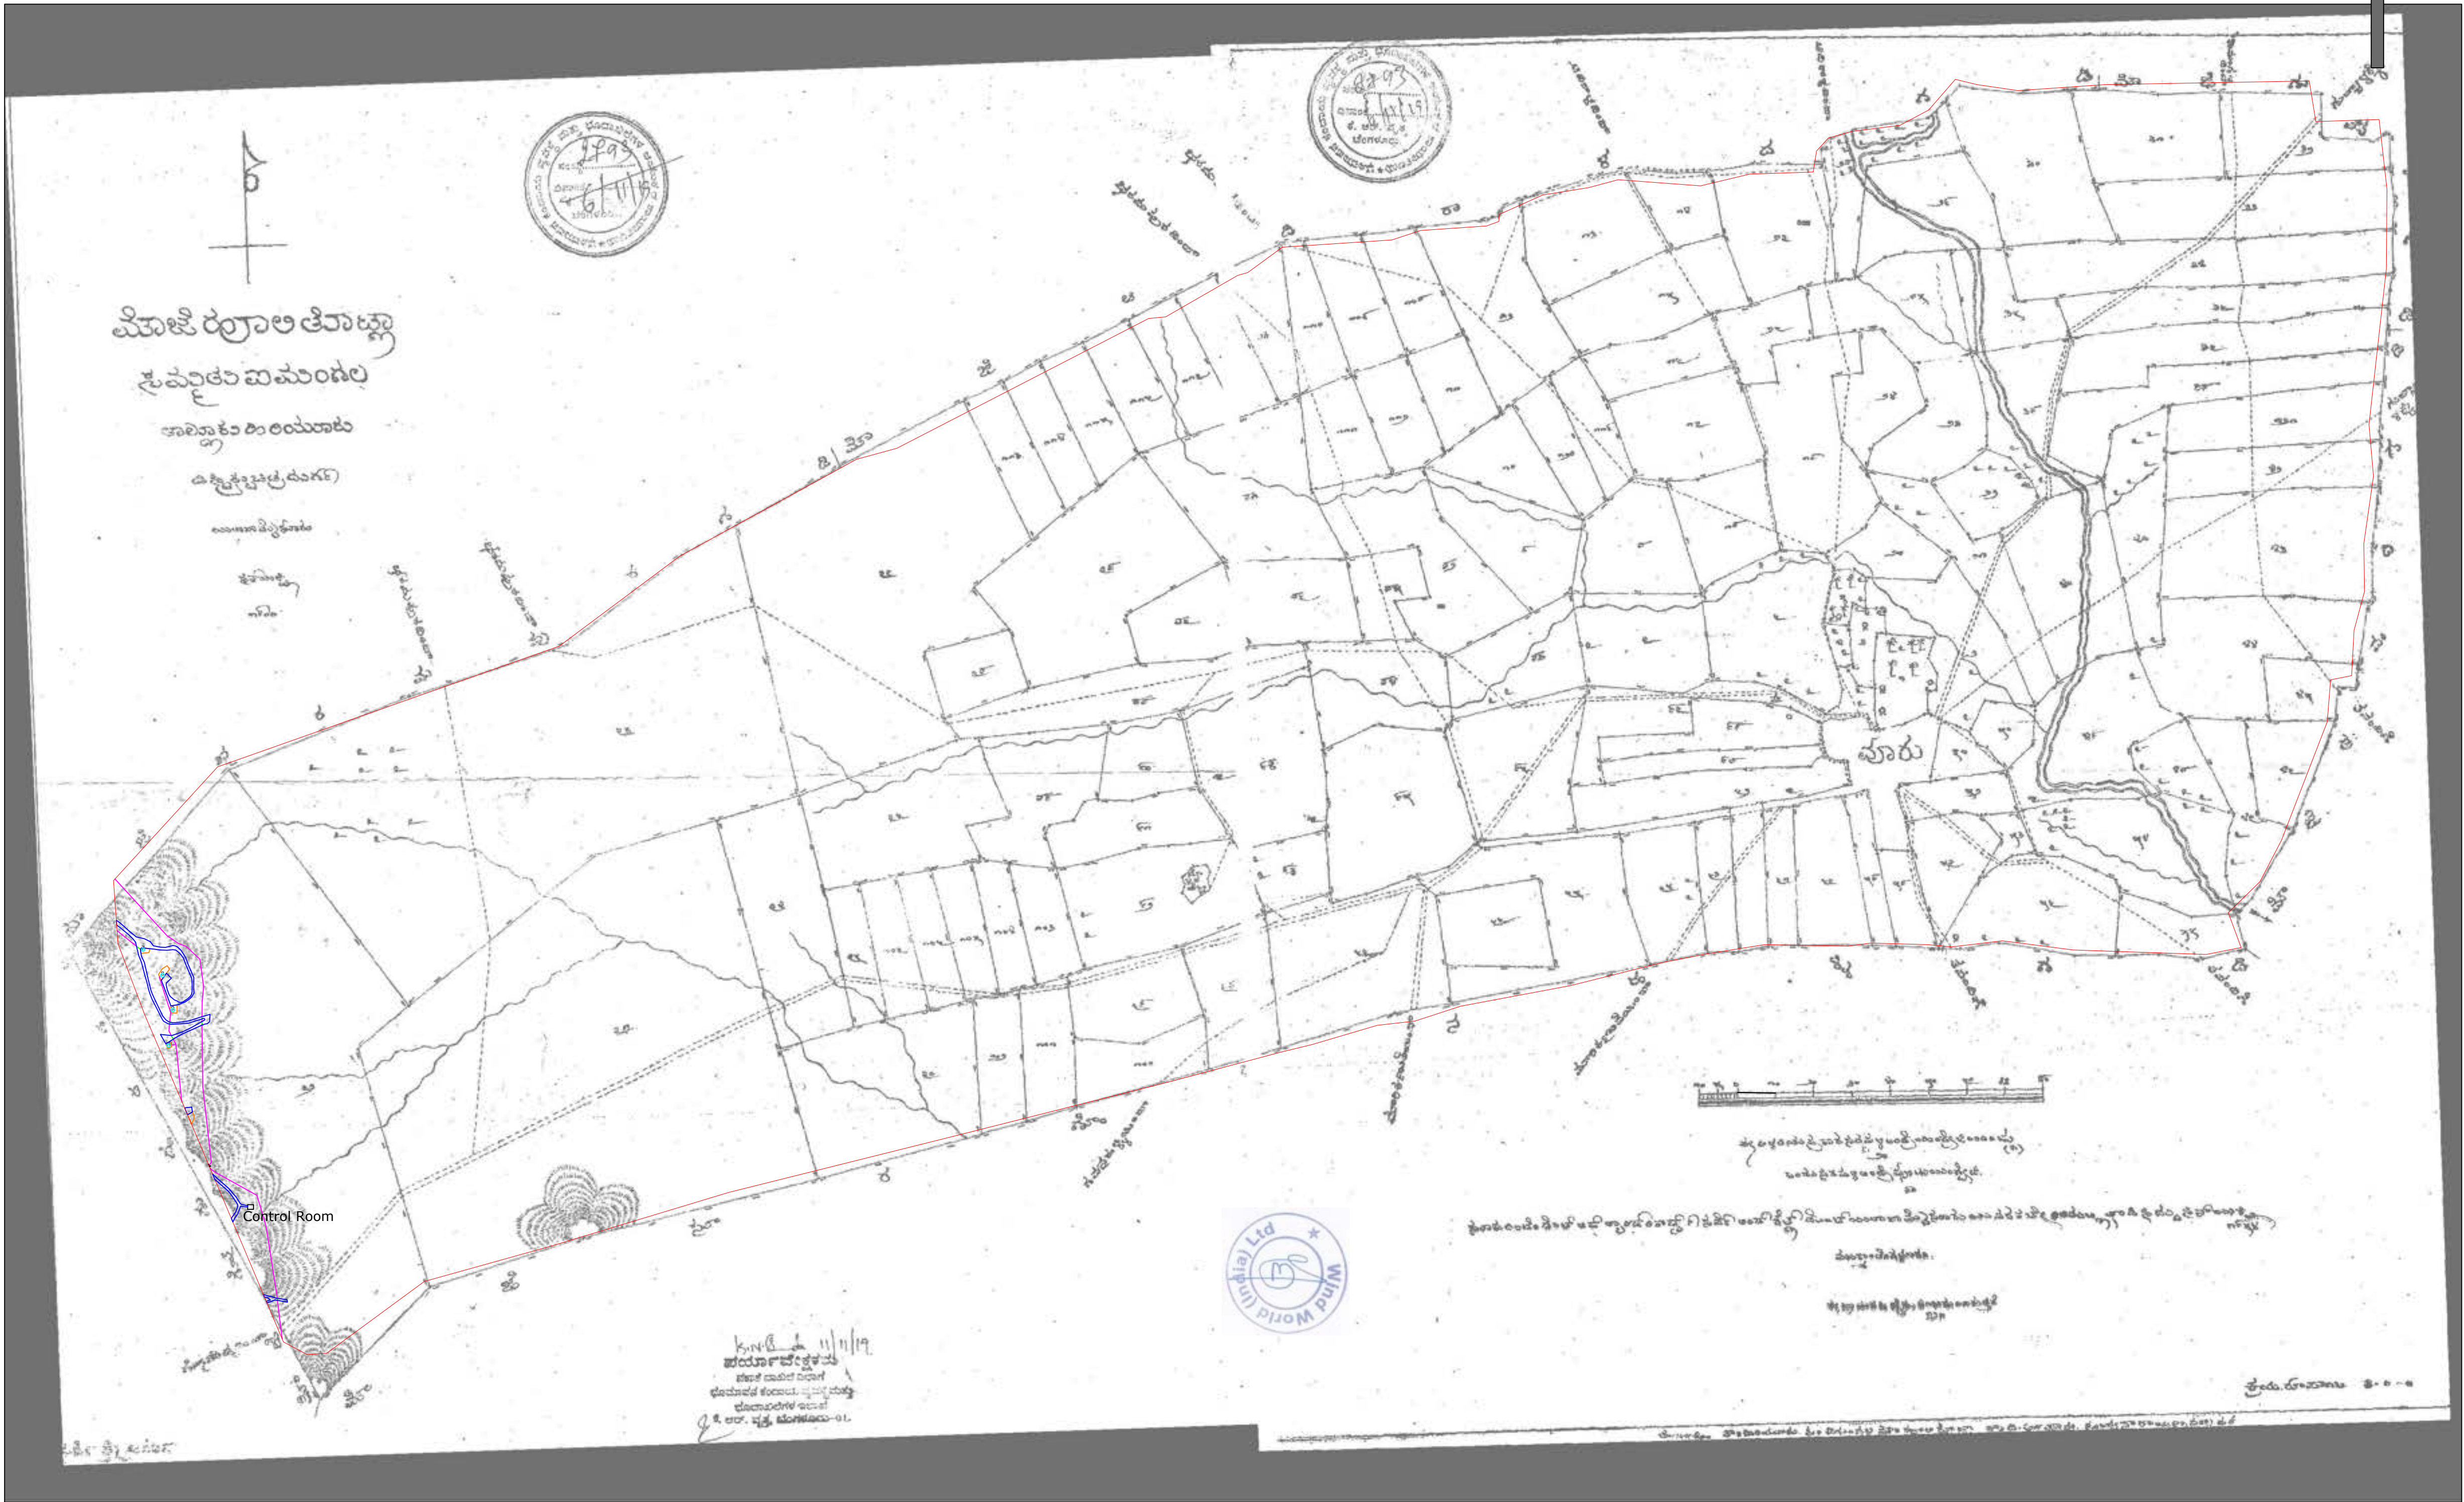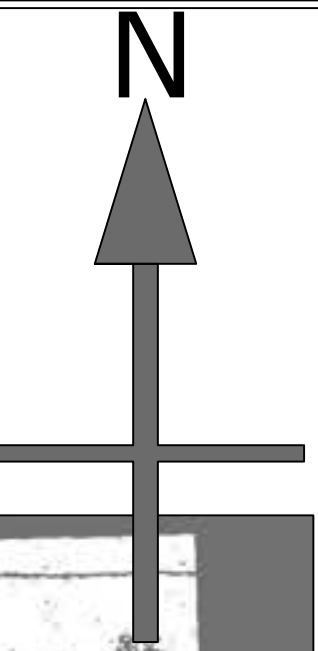

AS BUILT FEATURES	
FEATURE TYPE	LEGEND
	VILLAGE BOUNDARY
	AS BUILT ROAD
	NON FOREST ROAD
	AS BUILT ELECTRIC LINE
	NON FOREST ELECTRIC LINE
	AS BUILT VCB YARD
	NON FOREST VCB YARD
	AS BUILT PLATFORM AREA WITH NOS
	NON FOREST PLATFORM AREA WITH NOS

**WIND WORLD (INDIA) LTD**
-- formerly known as --

Scale:- 1 : 8000










PROJECT:- WIND POWER PROJECT
AT GOGUDDA SITE CHITRADURGA (DIST)
KARNATAKA STATE


TITLE:- VILLAGE MAP FOR HOLITOTLU VILLAGE

DRAWING NO.:- KAR/GOGUDDA/1

ASBULT-1/1



AS BUILT FEATURES	
FEATURE TYPE	LEGEND
	VILLAGE BOUNDARY
	AS BUILT ROAD
	NON FOREST ROAD
	AS BUILT ELECTRIC LINE
	NON FOREST ELECTRIC LINE
	AS BUILT VCB YARD
	NON FOREST VCB YARD
 1	AS BUILT PLATFORM AREA WITH NOS
 1	NON FOREST PLATFORM AREA WITH NOS

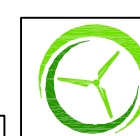

—formerly known as—

PROJECT:- WIND POWER PROJECT
AT GOGUDDA SITE CHITRADURGA (DIST)
KARNATAKA STATE

DRAWING NO.:- KAR/GOGUDDA/1	ASBULT-1/1
-----------------------------	------------