


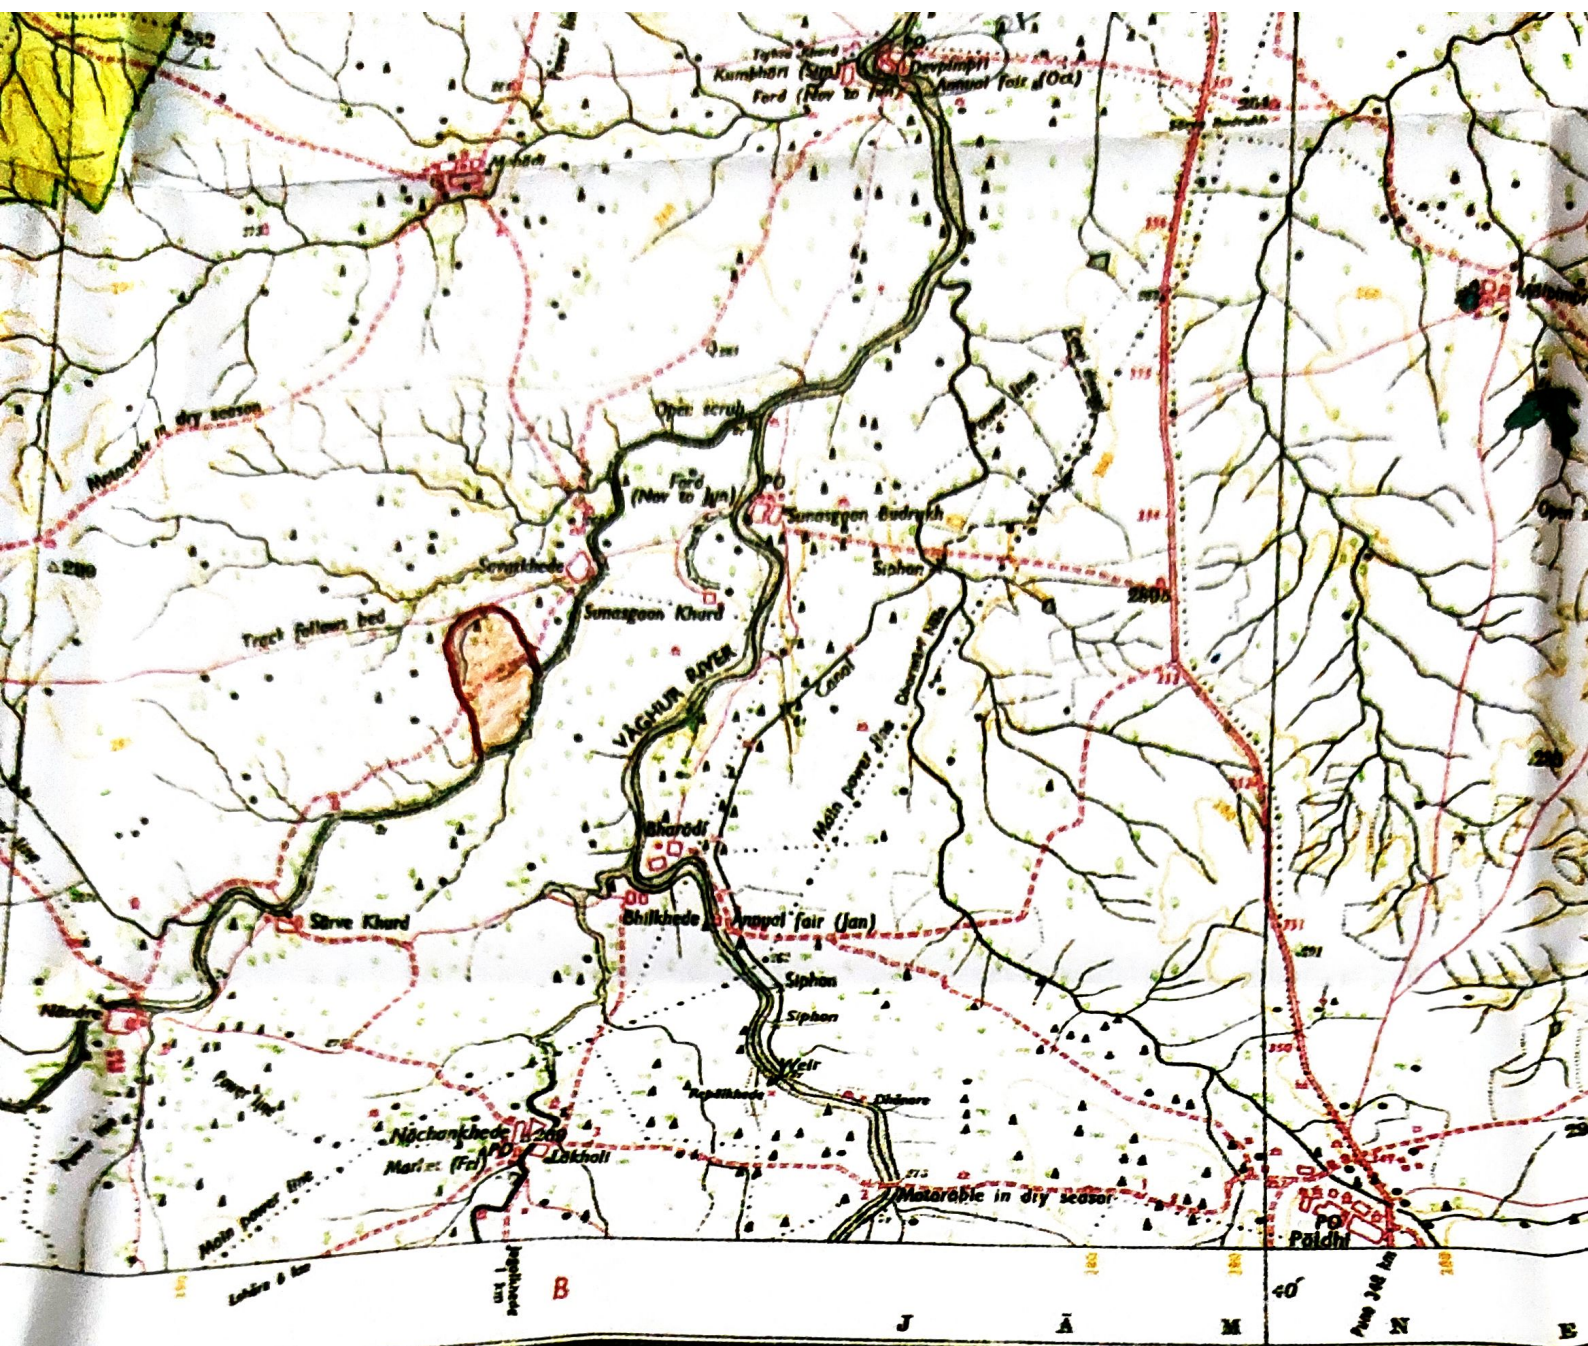

Sheet number, the direction of Major-General K.L. Khosla, B.Sc., B.E.(Civil), F.I.S., F.I.E., F.I.G.U., M.A.S.C.E.(U.S.A.), Surveyor General of India, 1977.

1:50,000

2 cm to 1 km

0 1 2 3 4 5 6 7 Kilometres

HEIGHTS & CONTOURS IN METRES

CONTOUR INTERVAL 20 METRES

Water features are shown in blue where dry generally contain water.

Cultivated areas are coloured yellow

The exterior boundaries of areas of forest or Protected Forests are shown by red hand-drawn

Contours are approximate

A relative height, Δr , represents the approximate height, in metres, between the top and bottom of a steep slope.

Wooded areas are coloured green. Scattered trees and other vegetation are in green, but prominent surveyed trees are in black

* Not applicable

Triangulated heights and contours in this sheet have not been adjusted to the heights of the spirit-levelled bench-marks and may not be in accordance with them.

Kilometre stone numbers along roads and the railway are shown in slant type, e.g., '5' whereas milestone numbers are shown in upright, e.g., '5'.

Seasonal roads, in this sheet, against which there is no descriptive remark, are generally passable in dry season.