





निर्यात के लिए नहीं NOT FOR EXPORT

OPEN SERIES
MAP

No. D43K8

Scale 1:50,000

D43K3 (57B/3)	D43K7 (57B/7)	D43K11 (57B/11)
D43K4 (57B/4)	D43K8 (57B/8) Chitradurga KARNATAKA	D43K12 (57B/12)
D43Q1 (57C/1)	D43Q5 (57C/5)	D43Q9 (57C/9)

1 Chikmagalur, KARNATAKA.
2 Tumkur, KARNATAKA.

भारतीय सर्वेक्षण विभाग SURVEY OF INDIA

1st Edition 2010.

Price: Rs. 103/-

CONVENTIONAL SYMBOLS

Express highway, with toll, with bridge, with distance stone	20
Roads, metalled, according to importance	
Roads, double cartway, according to importance	
Unmetalled road, cart-track, pack-track with pass, foot-path	
Streams, with track in bed, underflow, Canal	
Dams, masonry or rock-filled, earthwork, Weir	
River, dry with water channel, with island & rocks, Tidal river	
Submerged rocks, Shoal, Swamp, Reeds	
Wells, lined, unlined, Tube-well, Spring, Tank, perennial, dry	
Embankments, road or rail, Broken ground	
Railways, broad gauge, double, single with station, under constn.	
Railways, other gauges, double, single with distance stone, do.	
Mineral line or tramway, K.M. Cutting with tunnel	
Contours with sub-features, Rocky slopes, Cliffs	
Sand features (1 flat, (2 sand hillock, (3 dunes, (4 shilling)	
Towns or Villages, inhabited, deserted, Fort	
Huts, permanent, temporary, Tower, Antiquities	
Temples, Chhatra, Church, Mosque, Jagin, Tomb, Graves	
Lighthouses, Lightship, Buoy, Lighted, unlighted, Andonage	
Mine, Vine on trellis, Grass, Scrub	
Palms, palm-tree, other, Prawn, Conifer, Bamboo, Other trees	
Areas, cultivated, wooded, Surveyed tree	
Boundary, International	
states, demarcated, undemarcated	
district, subdivision, taluk or Block, forest	
Boundary pillars, surveyed, unlocated	
Heights, triangulated, station, point, approximate	
Bench-mark, geodetic, tertiary, canal	
Post office, Telegraph office, Overhead tank	
Rest house or inspection bungalow, Circuit house, Police station	
Camping ground, Forest, reserved, protected	
Spaced names, administrative, locality or tribal	
Hospital, Dispensary, Veterinary, hospital / dispensary	
Aerodrome, Heliport, Tourist site	
Power line, with pylons surveyed, with poles unsurveyed	

REFERENCES

NH 13 National Highway No. 13 NH 4 National Highway No. 4

NOTES

Heights are in metres and above Indian mean sea level.
Contours are approximate.
A relative height, e.g., 10, represents the approximate height, in metres, between the top and bottom of a steep slope.
Unmetalled roads are jeepable in dry season.
The kilometre scale numbers along roads and railways are shown in upright type, e.g., '5' whereas the milestone numbers along roads and canals are shown in upright type, e.g., '5'.
Tanks shown in this area usually contain water from July to February.
A relative height, e.g., -10, marked along a canal, indicates the height of the top of the canal embankment above the adjacent country.
Borehole trees are shown thus: .
Windmill are shown thus: .

COMPILED INDEX

A. Surveyed during 1974-75. Updated for major details during 2005-06.

Projection - UTM Datum - WGS 84

Magnetic Variation from True North about $1\frac{1}{2}^{\circ}$ West in 2005.
(Decreasing by about $1'$ annually)

1:50,000

500 m to 1 cm
1:50,000
2 cm to 1 km
3 Kilometres

CONTOUR INTERVAL 20 METRES


For further details about this map, please contact

Director
Karnataka Geo-Spatial Data Centre
Survey of India, Koramangla II Block
Bangalore.

WEBSITE - www.surveyofindia.gov.in

Reproduction in whole or part by any means is prohibited
without the written permission of Survey of India, the
National Mapping Agency.

GOVERNMENT OF INDIA COPYRIGHT, 2010.

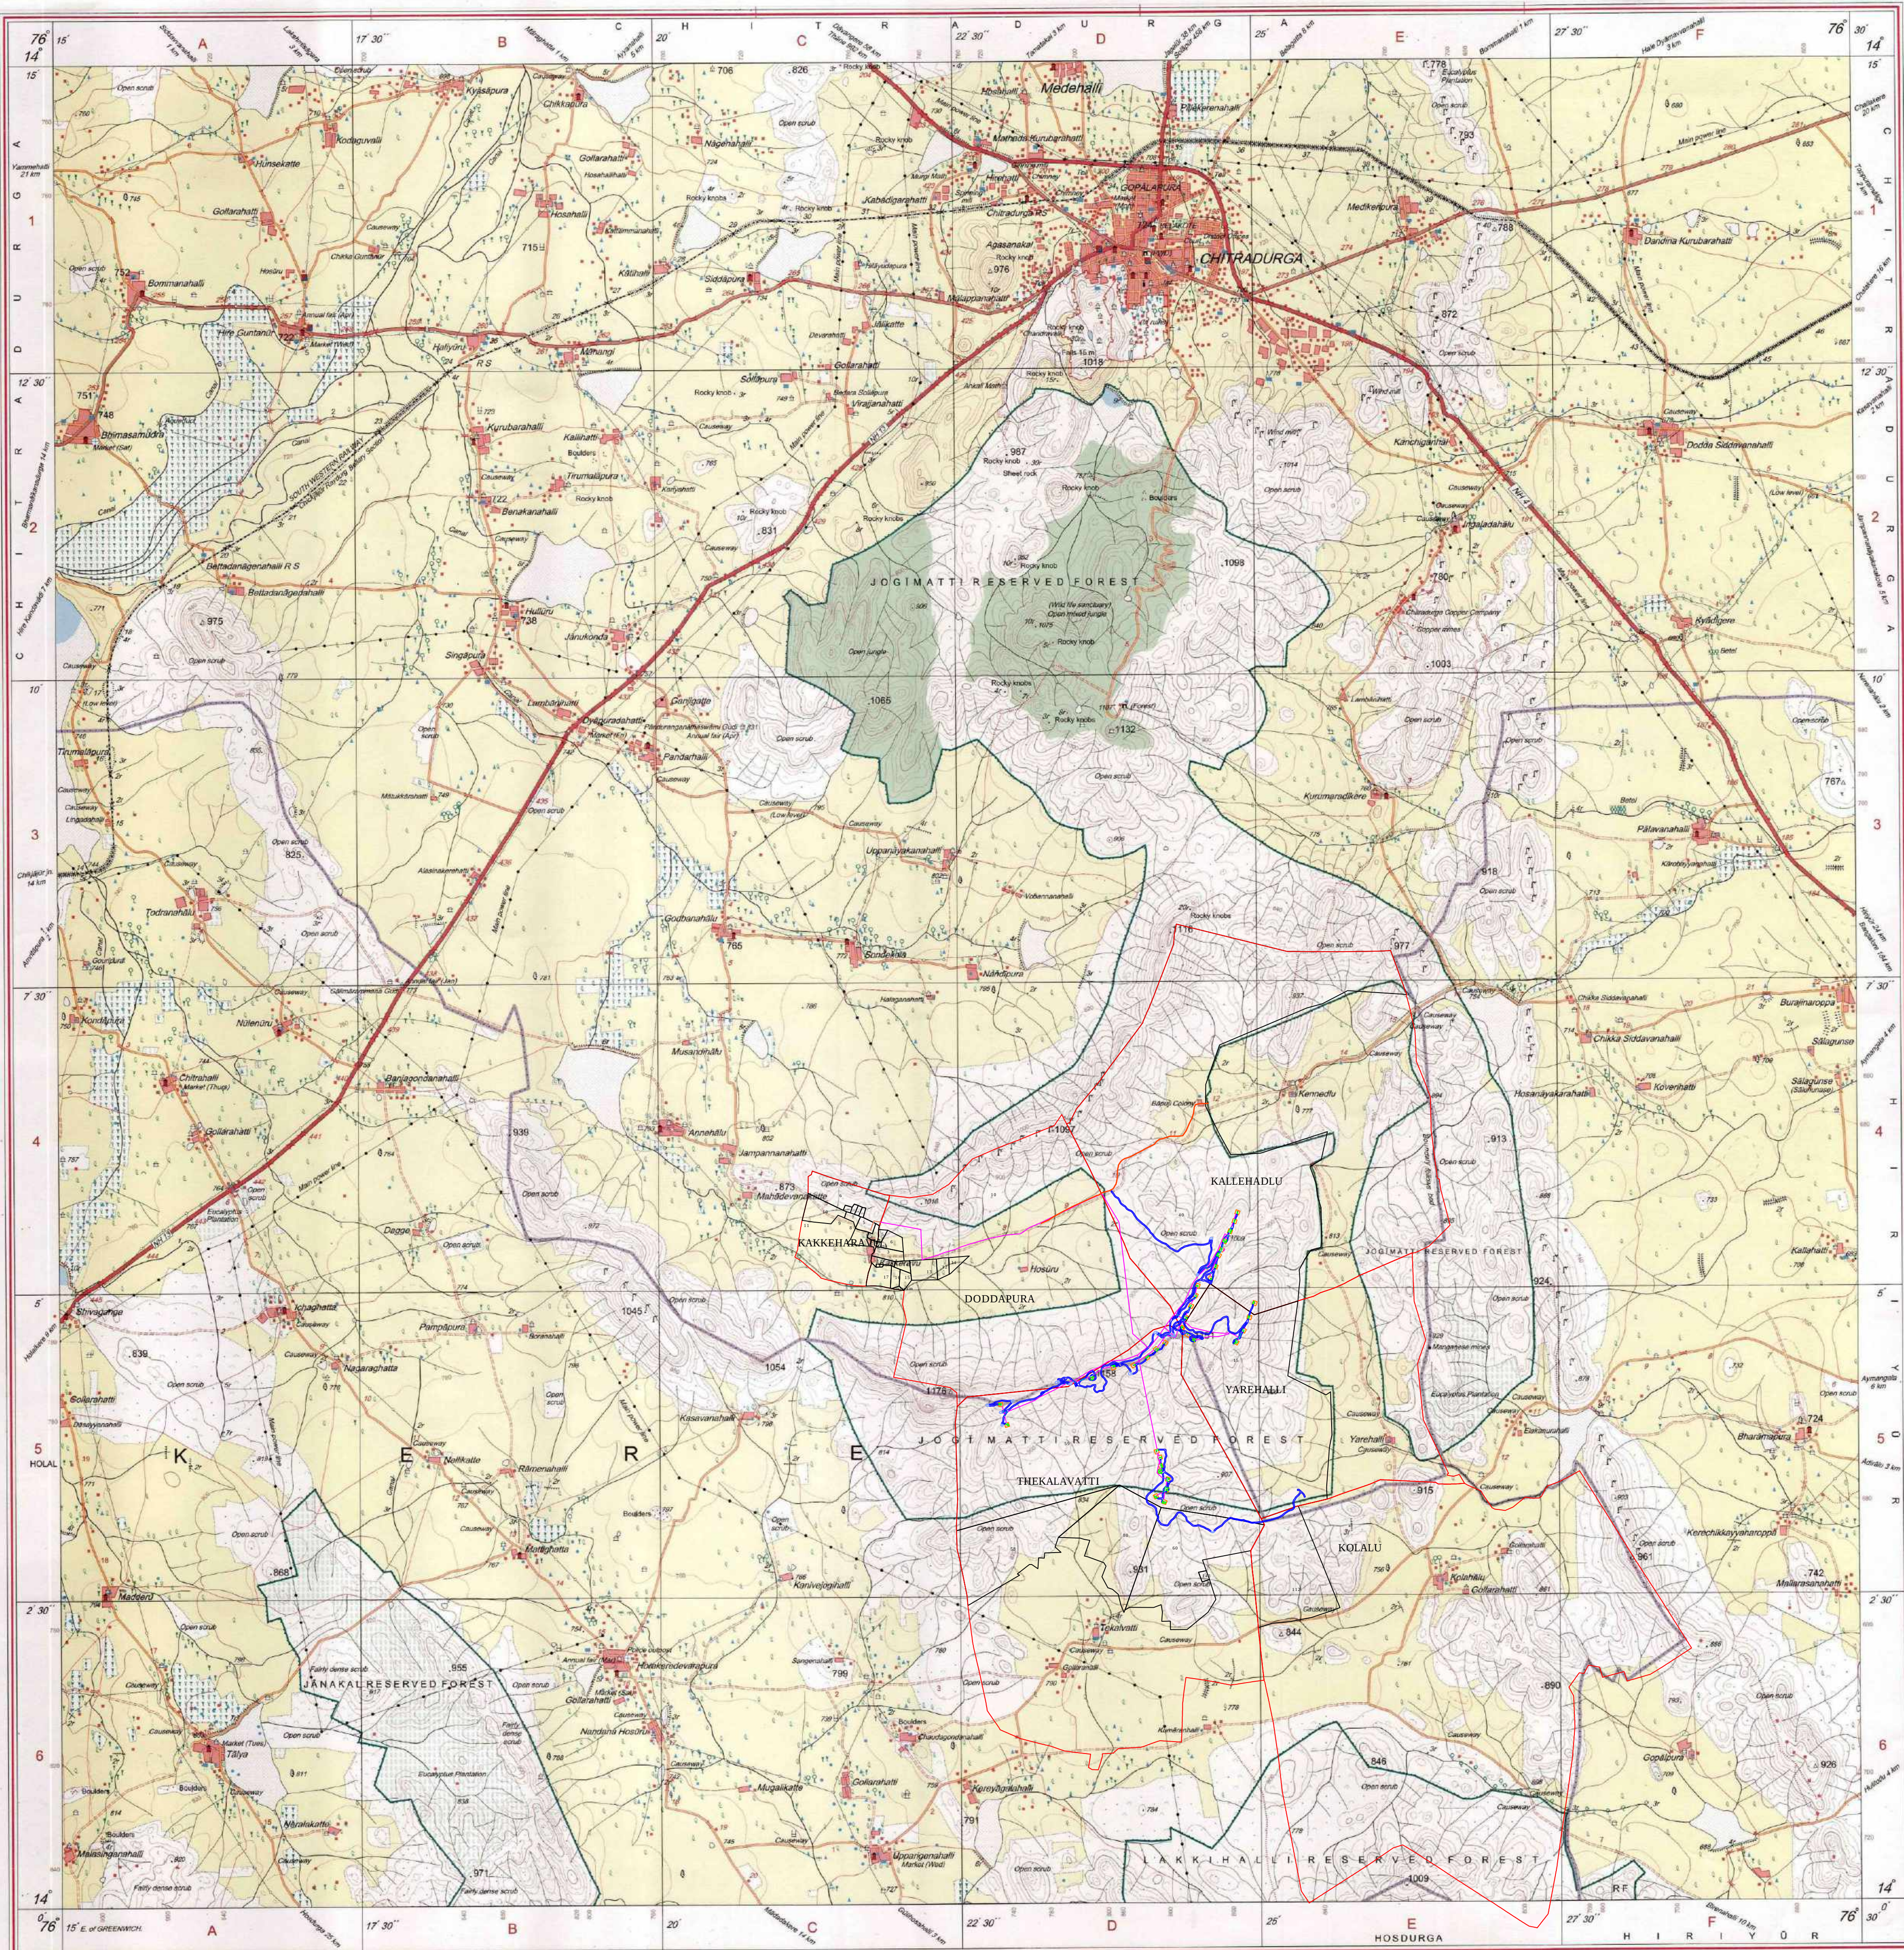

REG. No. 5476 - SPG D-10 (Karnataka GDC-1:50,000) 101315.

भारत के सर्वेक्षक: डॉ. सर्वेक्षण विभाग के निदेशन में प्रकाशित,
Published under the direction of Dr. Swarni Subba Rao, Surveyor General of India,
Survey of India, Hishibunka Estate, Post Box No. 37, Dehra Dun - 248001 (Uttarakhand),
Department of Science & Technology, Government of India.

PRINTED AT THE SOUTHERN PRINTING GROUP OF SURVEY OF INDIA.



WIND WORLD (INDIA) LTD

— formerly known as —

Scale: 1 : 50000

PROJECT:- WIND POWER PROJECT
AT GIM1 SITE CHITRADURGA (DIST)
KARNATAKA STATE

TITLE:- AS BUILT MOSAIC MAP FOR GIM1 SITE

DRAWING NO:- KAR/GIM1/1

ASBUILT-1/1

AS BUILT FEATURES	
FEATURE TYPE	LEGEND
	VILLAGE BOUNDARY
	FOREST AS BUILT ROAD
	NON FOREST ROAD
	INSIDE PLATFORM ROAD
	CURVATURE
	FOREST AS BUILT ELECTRIC LINE
	NON FOREST ELECTRIC LINE
	INSIDE ROAD ELECTRIC LINE
	FOREST AS BUILT VCB YARD
	NON FOREST VCB YARD
	FOREST AS BUILT PLATFORM AREA WITH NOS
	NON FOREST COORDINATES OF ROAD & BP LINE