


Map Showing the Forest Area for Diversion for laying of OFC from Kadirinaidupalli to Nellore District Border in Compartment No:412,413,410,409 in Singannapalli, Udayagiri Velugunda Reserved Forest Singannapalli & Kadirinaidupalli North Beat, Kadirinaidupalli Section, Atmakur Range of Nellore Division - in Favor of Reliance JIO Infocomm Ltd.



Scale : 1:30000

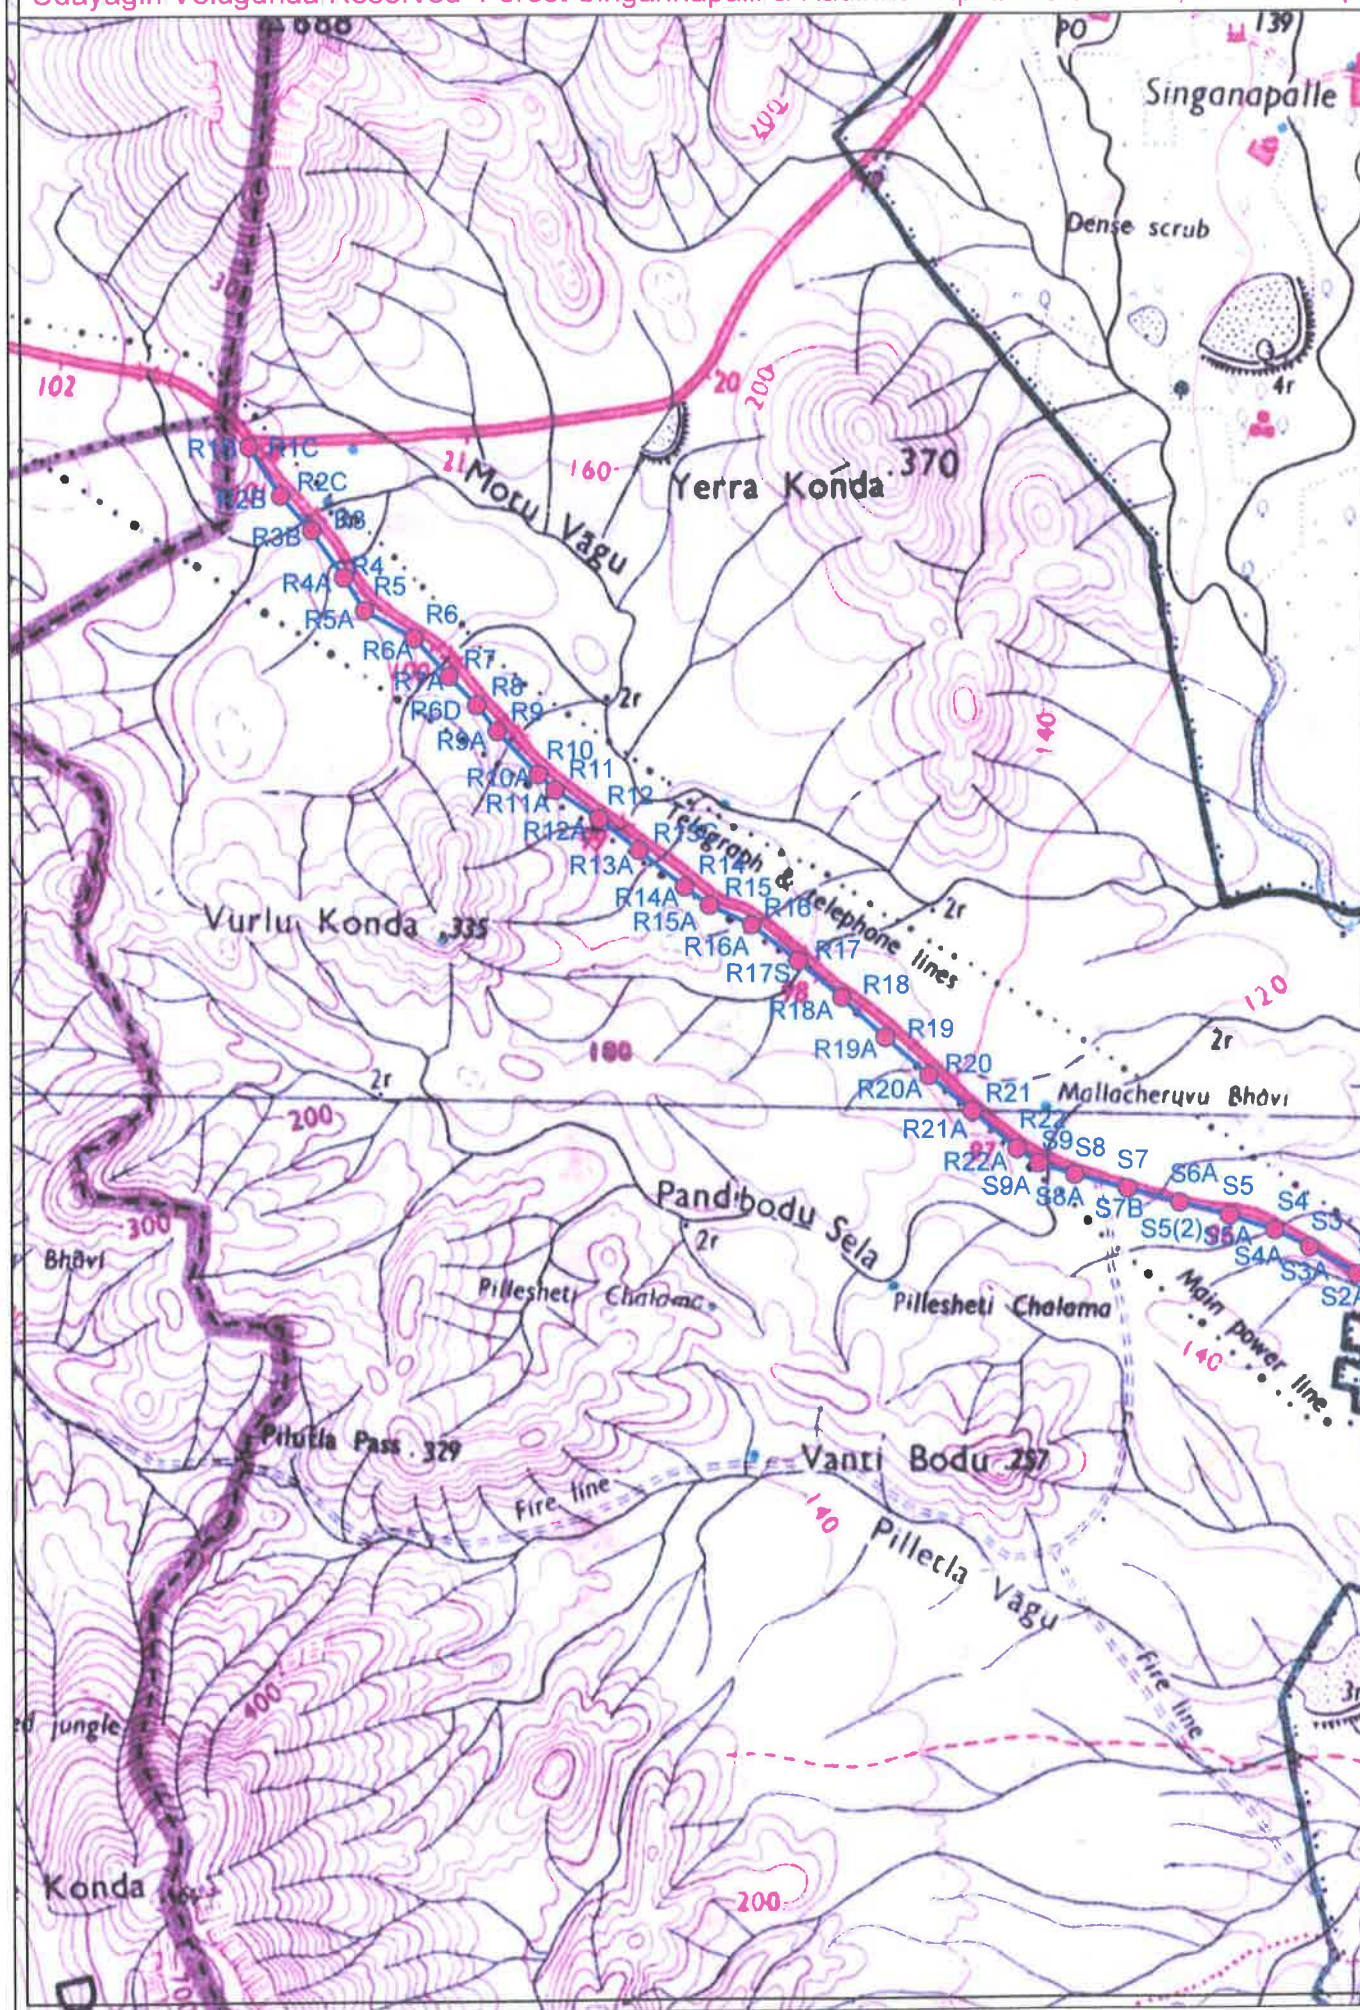

S no	Name	Easting	Northing	Elevation	Latitude	Longitude
1	T03	317293.321199	1622708.501230	153.629	14.67177315	79.30329947
2	T1	317324.419806	1622386.580180	145.781	14.66886590	79.30361059
3	T1F	317324.055583	1622386.544650	145.809	14.66886555	79.30360721
4	T2A	317297.599907	1622601.154190	149.541	14.67080329	79.30334667
5	T2B	317297.103658	1622601.080880	149.539	14.67080259	79.30334206
6	T3A	317293.648441	1622708.584860	153.497	14.67177393	79.30330250
7	T4	317337.668219	1622807.015750	156.412	14.67266648	79.30370431
8	T4B	317338.048855	1622806.805260	156.368	14.67266460	79.30370786
9	T5	317411.379453	1622871.240310	156.760	14.67325191	79.30438414
10	T5A	317411.712416	1622871.011940	156.670	14.67324987	79.30438725
11	T6	317607.399427	1622981.537280	151.256	14.67426199	79.30619625
12	T6A	317607.181414	1622981.929270	151.296	14.67426552	79.30619420
13	S10A	317311.456201	1622301.115880	139.365	14.66809263	79.30349619
14	S10B	317310.898756	1622301.190590	139.535	14.66809327	79.30349101
15	S11	317254.301316	1622111.211610	140.427	14.66637250	79.30297883
16	S11A	317254.860325	1622111.229190	140.511	14.66637270	79.30298402
17	S12	317211.934216	1621901.121420	139.058	14.66447094	79.30260015
18	S12A	317212.146871	1621901.039130	138.640	14.66447021	79.30260213
19	S13	317167.964836	1621689.600400	142.280	14.66255633	79.30220671
20	S13D	317167.536521	1621689.710580	142.467	14.66255730	79.30220272
21	S14	317149.885881	1621604.433890	142.554	14.66178542	79.30204481
22	S14A	317150.257858	1621604.384200	142.467	14.66178499	79.30204827
23	S15	317067.420939	1621458.237010	140.532	14.66045857	79.30128946
24	S15B	317068.007530	1621458.085550	140.736	14.66045724	79.30129492
25	S16A	317025.512804	1621246.764250	133.316	14.65854454	79.30091516




Legend

- DGPS Survey Points (represented by a red dot)
- Surveyed Area (represented by a red line)

Surveyed Area : 0.25 Ha

Map Showing the Forest Area for Diversion for laying of OFC from Marripadu to Gangunta in Compartment No:411,389,390 in Bommavaram & Udayagiri Yerragonda Reserved Forest, Bommavaram & Rajupalem Beat, Marripadu Section,Atmakur Range of Nellore Division - in Favor of Reliance JIO Infocomm Ltd.

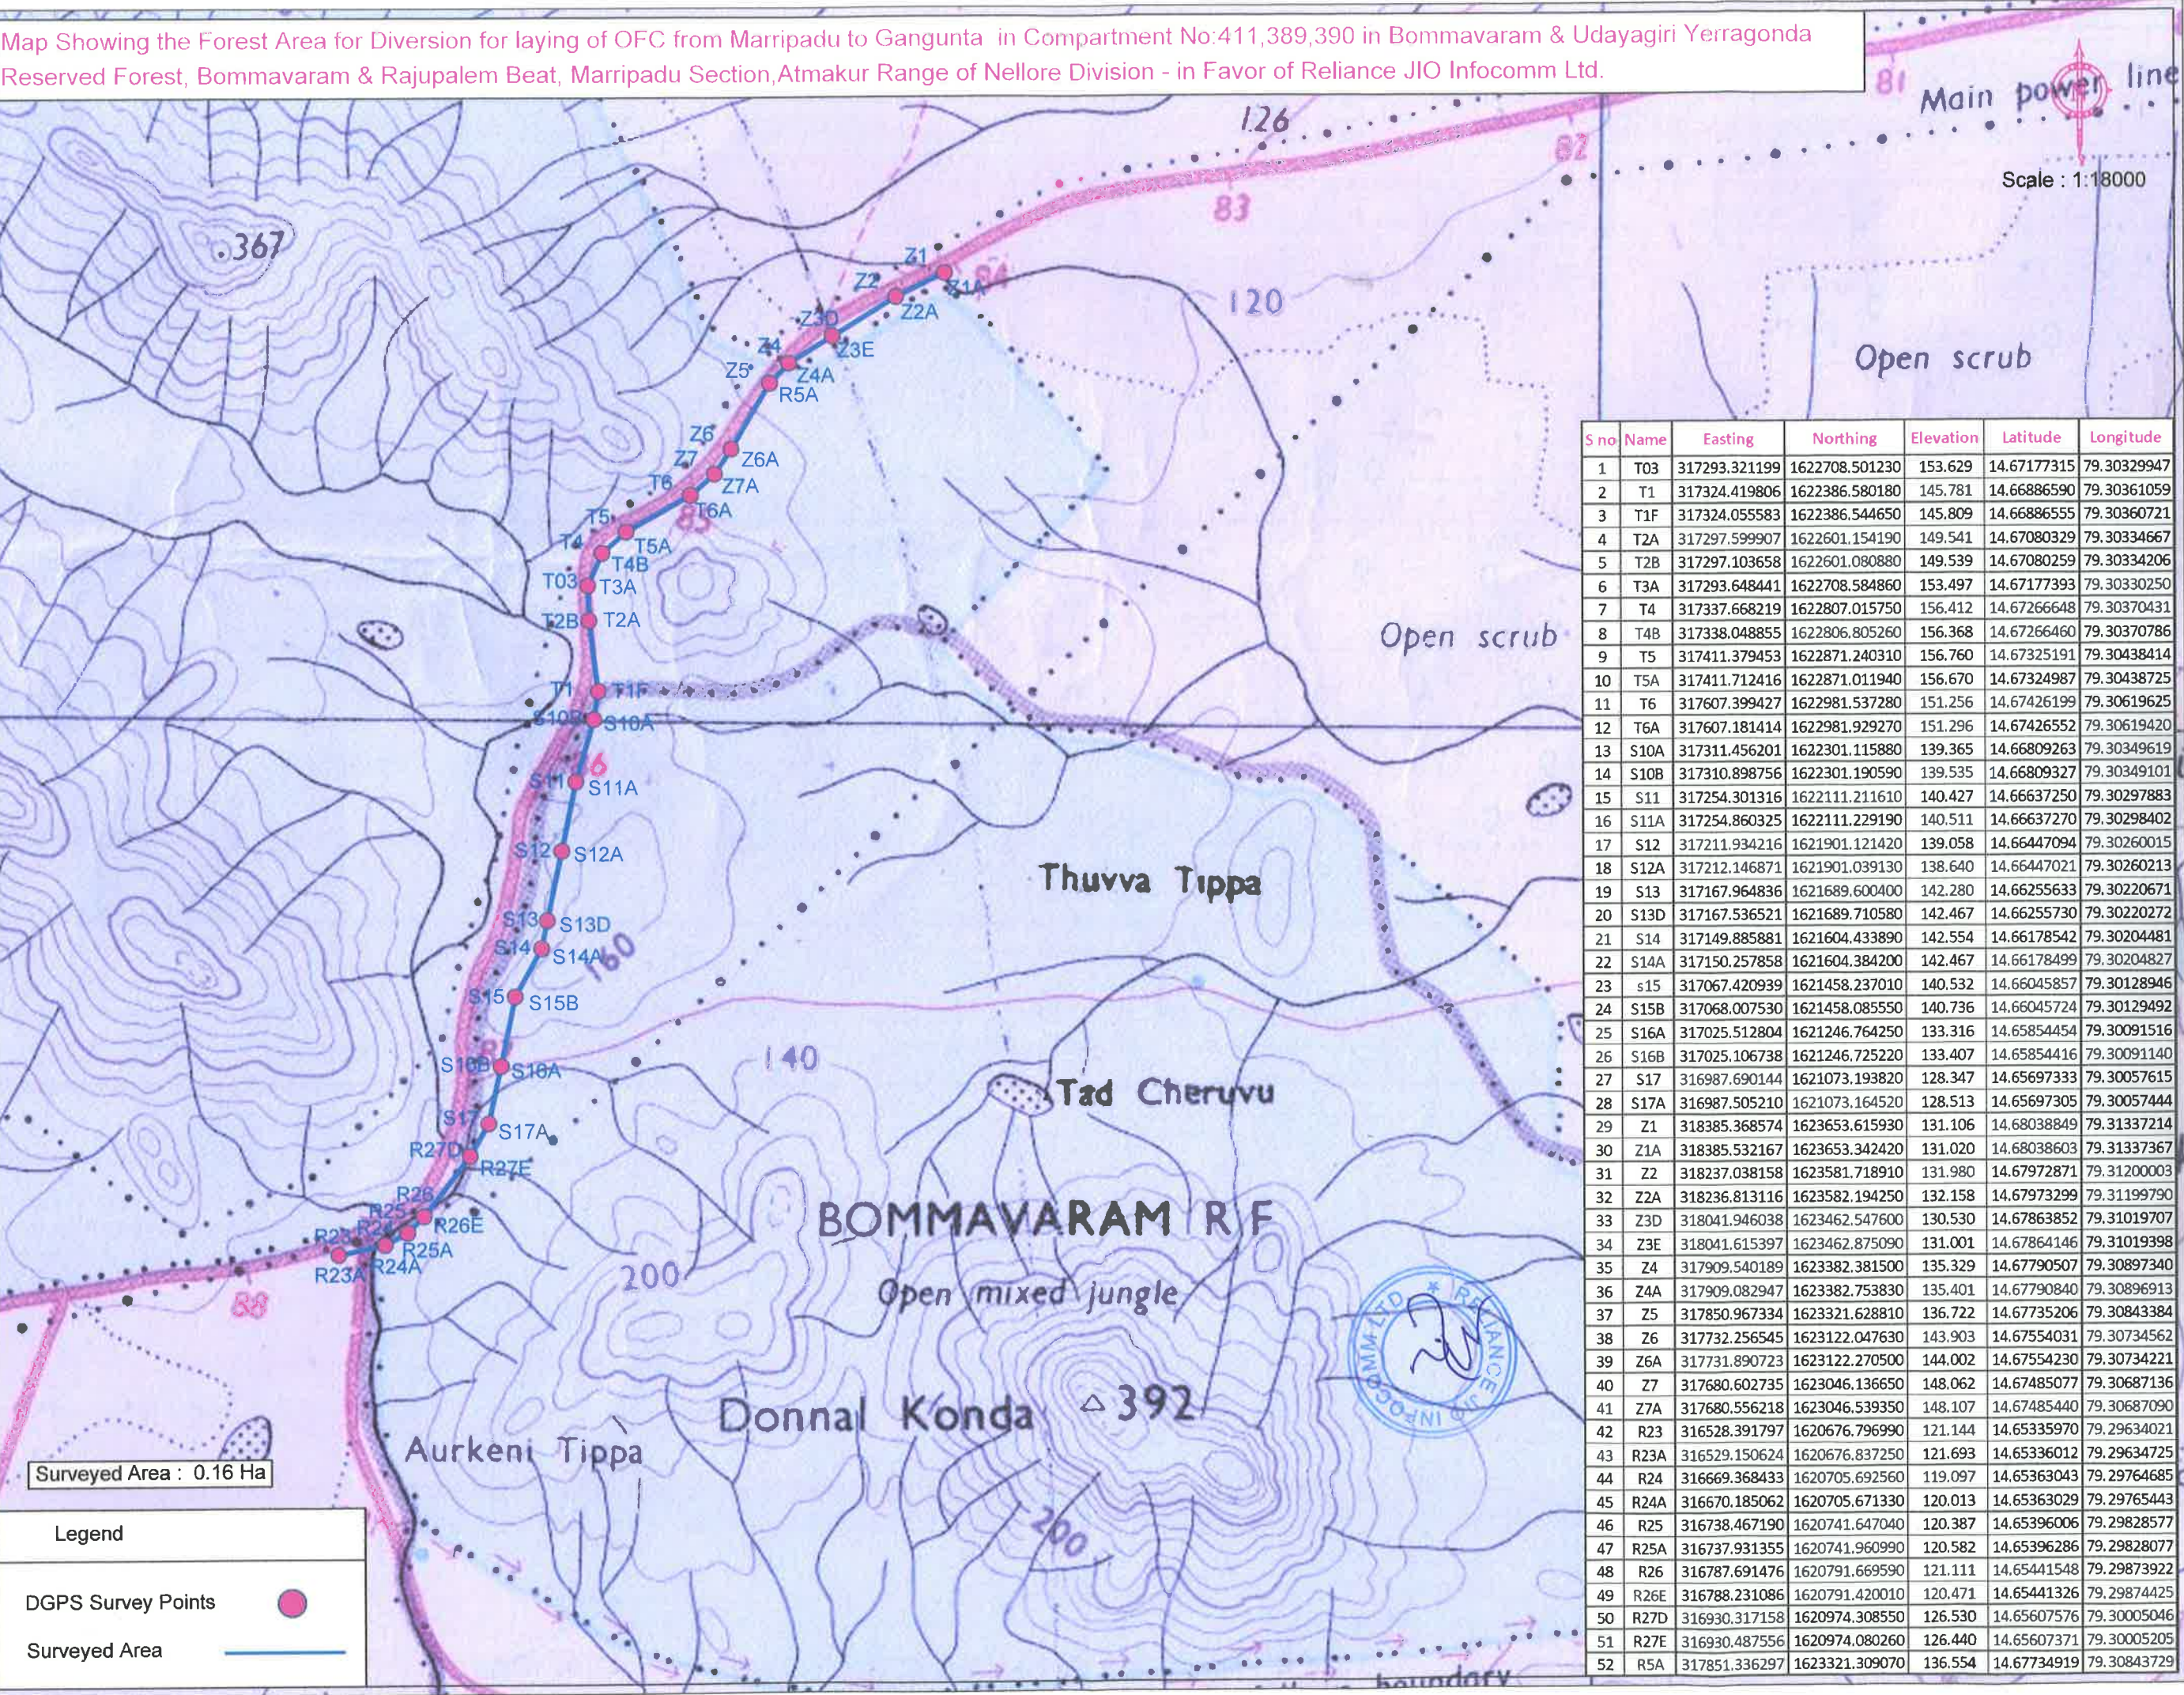

Map Showing the Forest Area for Diversion for laying of OFC from Chinakraka to Akbarabad in Compartment No:586,587 in Manubolupadu Extension, Reserved Forest,Dagadarthi Beat,Racherlapadu Section & Kavali Range of Nellore Division - in Favor of Reliance JIO Infocomm Ltd.

SCALE - 1:16000

Sno	Name	Easting	Northing	Elevation	Latitude	Longitude
1	Q1	376434.466061	1626537.905250	42.966	14.70975131	79.85223399
2	Q1A	376434.269298	1626538.313260	43.08	14.70975499	79.85223215
3	Q2	376570.160493	1626597.927940	42.911	14.71030013	79.85349141
4	Q2A	376569.962207	1626598.229490	42.905	14.71030285	79.85348955
5	Q3	376782.429437	1626689.949390	41.468	14.71114172	79.85545585
6	Q3A	376782.352081	1626690.498290	41.518	14.71114668	79.85545776
7	Q4	376977.682465	1626777.333520	41.312	14.71194059	79.8572678
8	Q4A	376977.519294	1626777.768220	41.457	14.71194451	79.85726626
9	Q5	377188.889216	1626869.722720	41.562	14.71278542	79.85922504
10	Q5Z	377188.892529	1626870.135200	41.697	14.71278915	79.85922505
11	Q6	377393.306628	1626958.843000	41.013	14.71360037	79.86111194
12	Q6A	377393.198561	1626959.291350	41.039	14.71360442	79.86111837
13	Q7	377563.208595	1627032.047380	43.000	14.71426986	79.86269395
14	Q7X	377562.669965	1627032.534460	43.131	14.71427424	79.86268892
15	Q8	377759.703567	1627085.331500	43.311	14.71476048	79.86451643
16	Q8A	377759.540055	1627085.728370	43.359	14.71476406	79.8645149
17	Q9A	377967.153371	1627143.725180	43.755	14.71529778	79.86644042
18	Q9B	377967.191268	1627143.283390	43.751	14.71529379	79.8664408
19	Q10	378167.642643	1627197.056990	43.992	14.71588980	79.86830002
20	Q10A	378167.474939	1627197.452140	44.013	14.71579255	79.86829844
21	Q11	378292.147232	1627231.294240	43.387	14.71610412	79.86945479
22	Q11A	378291.793760	1627231.742100	43.413	14.71610815	79.86945148
23	Q12	378437.178117	1627272.992520	42.434	14.71648763	79.87079985
24	Q12B	378437.263926	1627272.562290	42.281	14.71648374	79.87080067
25	Q13	378514.858299	1627048.573910	41.679	14.71446247	79.87153176
26	Q13X	378514.407922	1627048.443880	41.624	14.71446127	79.87152758
27	Q14	378590.267702	1626814.662690	39.602	14.71235139	79.87224299
28	Q14A	378590.658144	1626814.926650	39.675	14.71235380	79.87224661
29	Q15A	378661.024861	1626616.841130	40.583	17.71056634	79.87290934
30	Q15B	378661.085906	1626616.911370	40.235	17.71056698	79.8729099

Surveyed Area : 0.12 Ha

Legend

DGPS Survey Points



Surveyed Area



Existing Road



MANUBOLUPĀDU
EXTENTION
RESERVED FOREST

Unmetalled road under construction

Open scrub and cactus

Manubolupādu


Lingālapādu



Map Showing the Forest Area for Diversion for laying of OFC from Kaligiri to Kavali in Compartment No:61 in Kavali Extension Reserved Forest, Kavali Range, Kavali Beat & Kavali Section of Nellore Division - in Favor of Reliance JIO Infocomm Ltd.




Scale : 1:18000

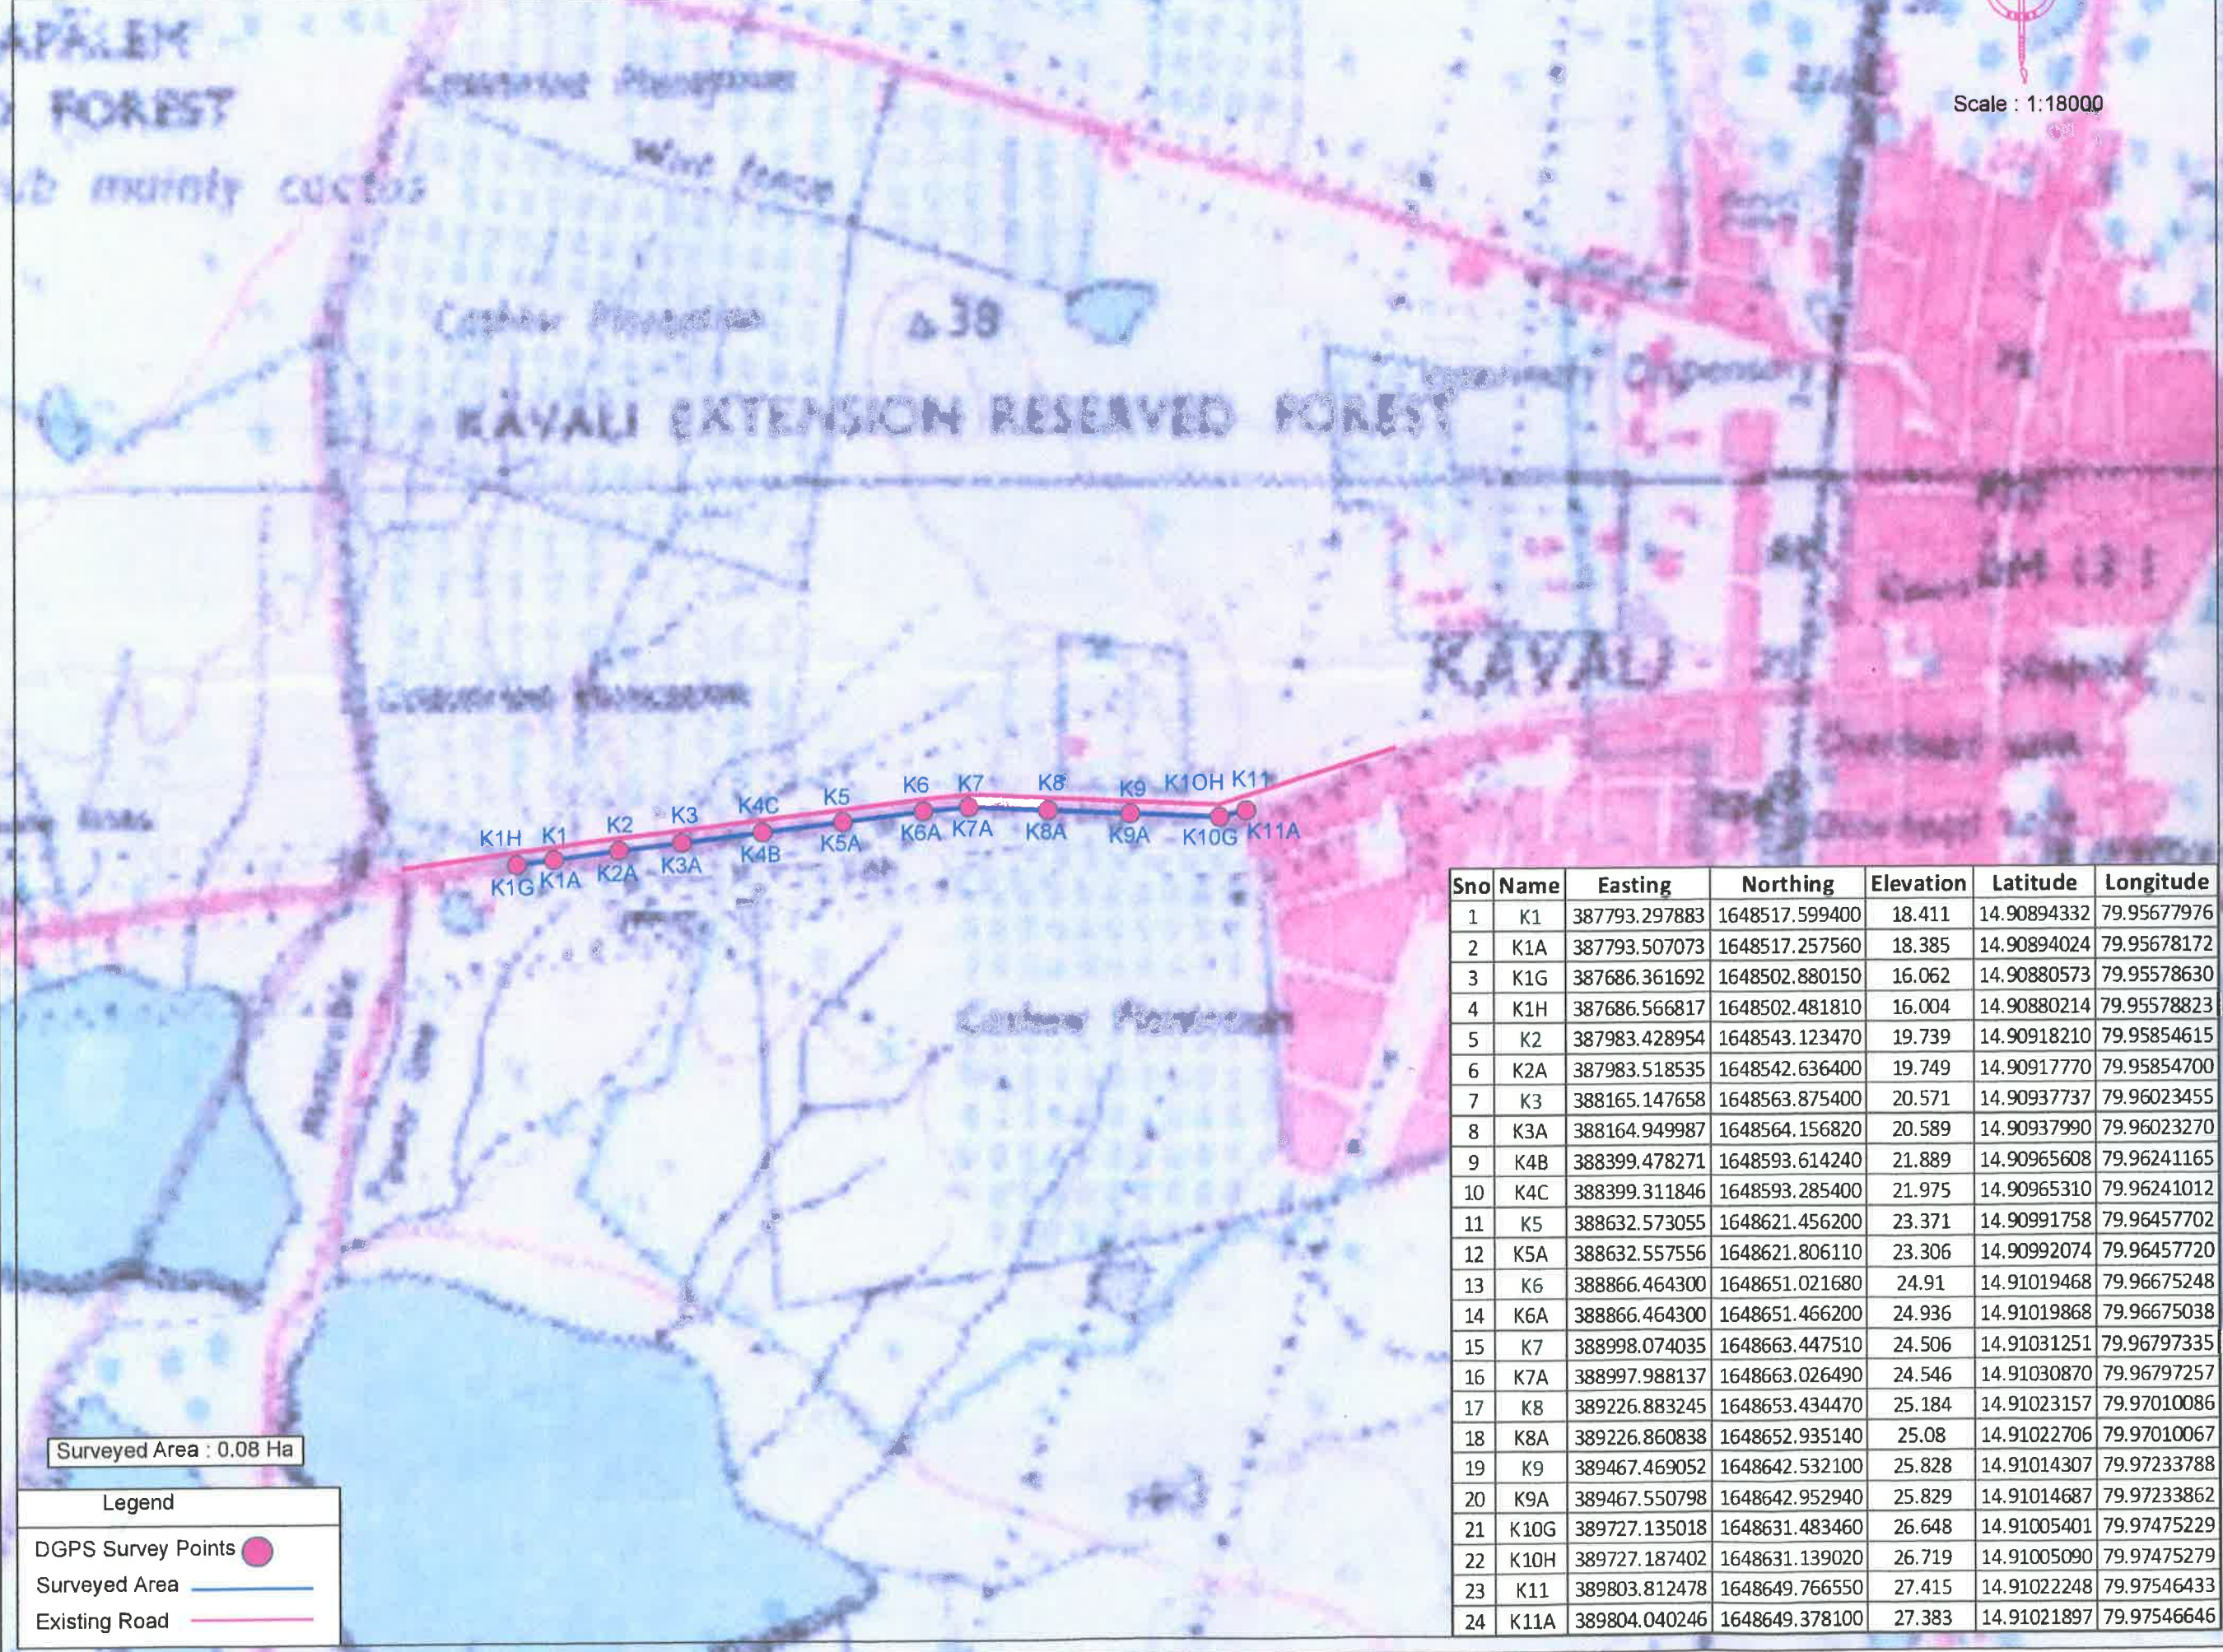

Map Showing the Forest Area for Diversion for laying of OFC from Degapudi to Sydapuram in Compartment No:105 in Sydapuram Reserved Forest, Nellore Range, Sydapuram Beat & Guduru Section of Nellore Division - in Favor of Reliance JIO Infocomm Ltd.



SCALE - 1:10000

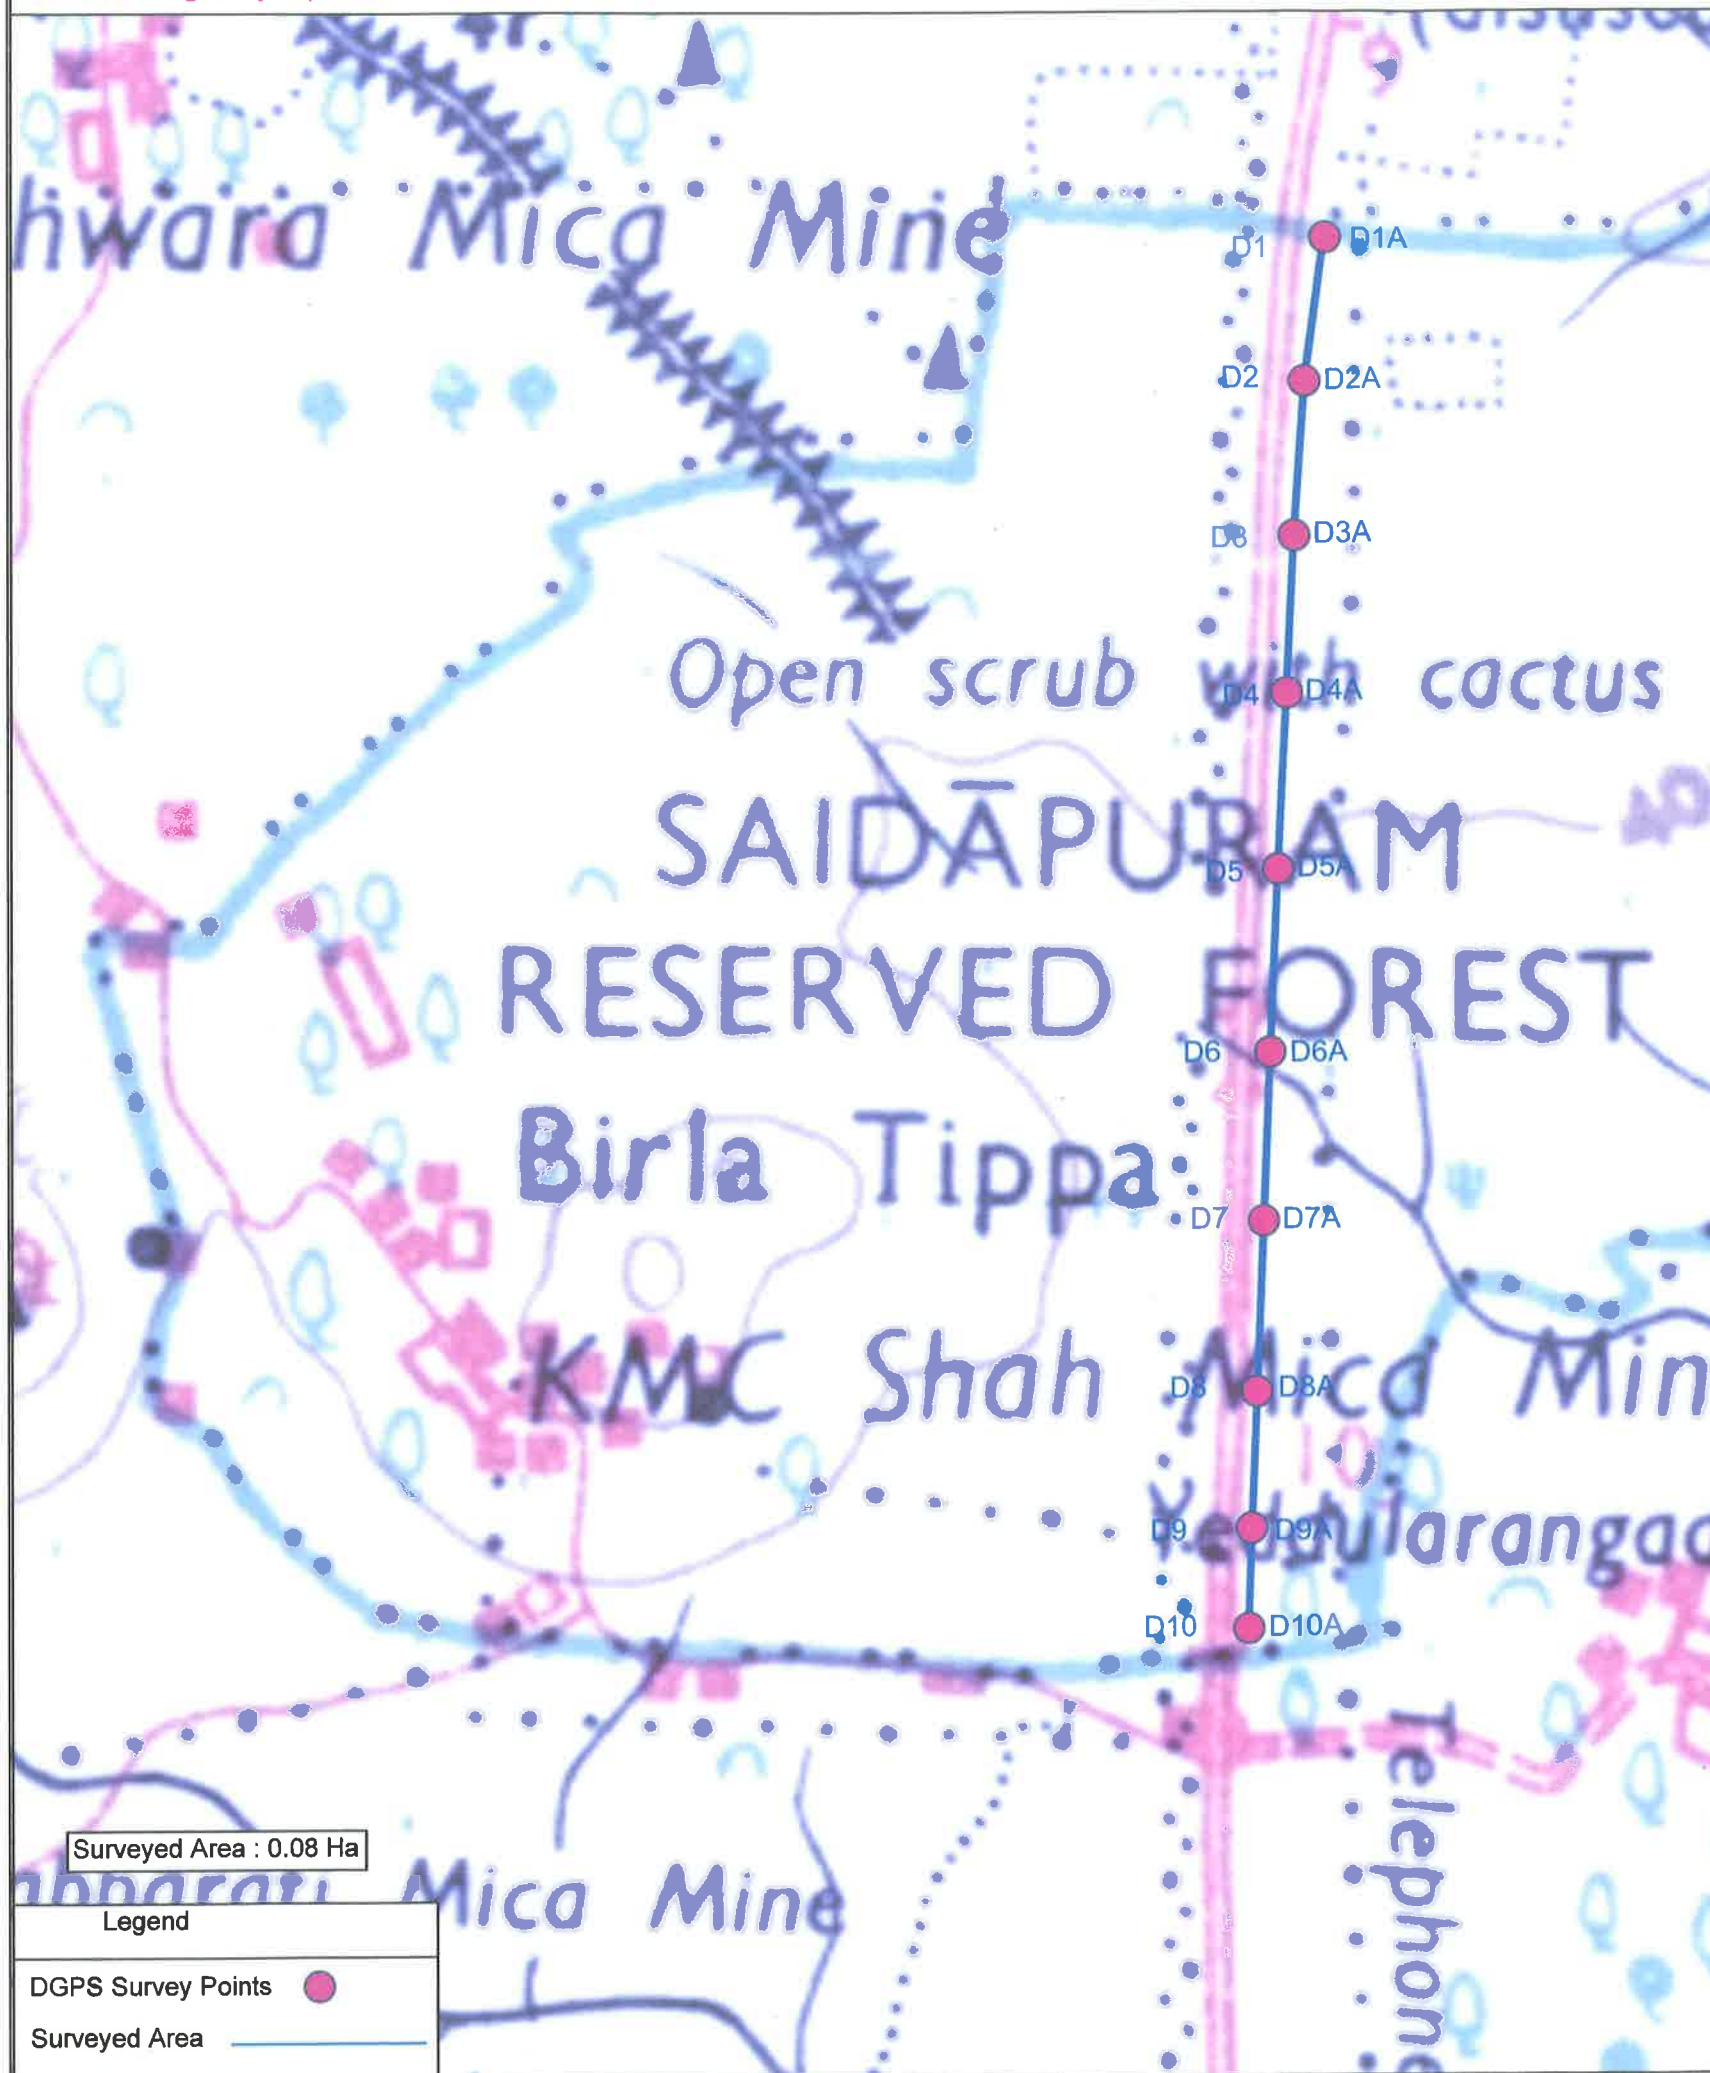

Sl.No	Name	Easting	Northing	Elevation	Latitude	Longitude
1	D1	364141.72654	1572067.12219	43.556	14.21677221	79.74084602
2	D10	364009.56642	1570253.30597	31.909	14.20036951	79.73971211
3	D10A	364009.16546	1570253.51070	31.906	14.20037134	79.73970838
4	D1A	364143.39283	1572068.02273	46.551	14.21678043	79.74086141
5	D2	364112.99006	1571908.50022	45.463	14.21533692	79.74058767
6	D2A	364112.59559	1571908.64536	45.356	14.21533821	79.740584
7	D3A	364095.09643	1571703.94507	47.075	14.21348694	79.74043209
8	D3C	364095.48817	1571703.83894	47.105	14.213486	79.74043572
9	D4	364082.22353	1571495.03834	46.685	14.21159787	79.74032325
10	D4A	364081.73284	1571495.12086	46.551	14.21159859	79.7403187
11	D5	364066.58925	1571261.24047	41.221	14.20948366	79.74019008
12	D5A	364066.08908	1571261.14004	41.182	14.20948273	79.74018545
13	D6	364051.79110	1571018.32458	35.805	14.20728706	79.7400651
14	D6D	364052.17056	1571018.30029	35.715	14.20728686	79.74006862
15	D7	364039.12359	1570794.28895	33.724	14.20526124	79.73995893
16	D7E	364039.46890	1570794.33387	33.579	14.20526167	79.73996213
17	D8	364026.59086	1570567.67708	34.887	14.20321214	79.73985414
18	D8A	364026.21853	1570567.65176	34.963	14.2032119	79.73985069
19	D9	364015.98223	1570386.80704	33.012	14.20157662	79.73976488
20	D9A	364015.76868	1570386.88303	32.761	14.2015773	79.7397629

Surveyed Area : 0.08 Ha

Legend

DGPS Survey Points ●


Surveyed Area —




Map Showing the Forest Area for Diversion for laying of OFC from Pamuru to Udaygiri in Compartment No:459 in Guvvadi West Reserved Forest of Arlapadia Beat, Krishnampalli Section, Udayagiri Range of Nellore Division - in Favor of Reliance JIO Infocomm Ltd.

Map.01

SCALE - 1:14000

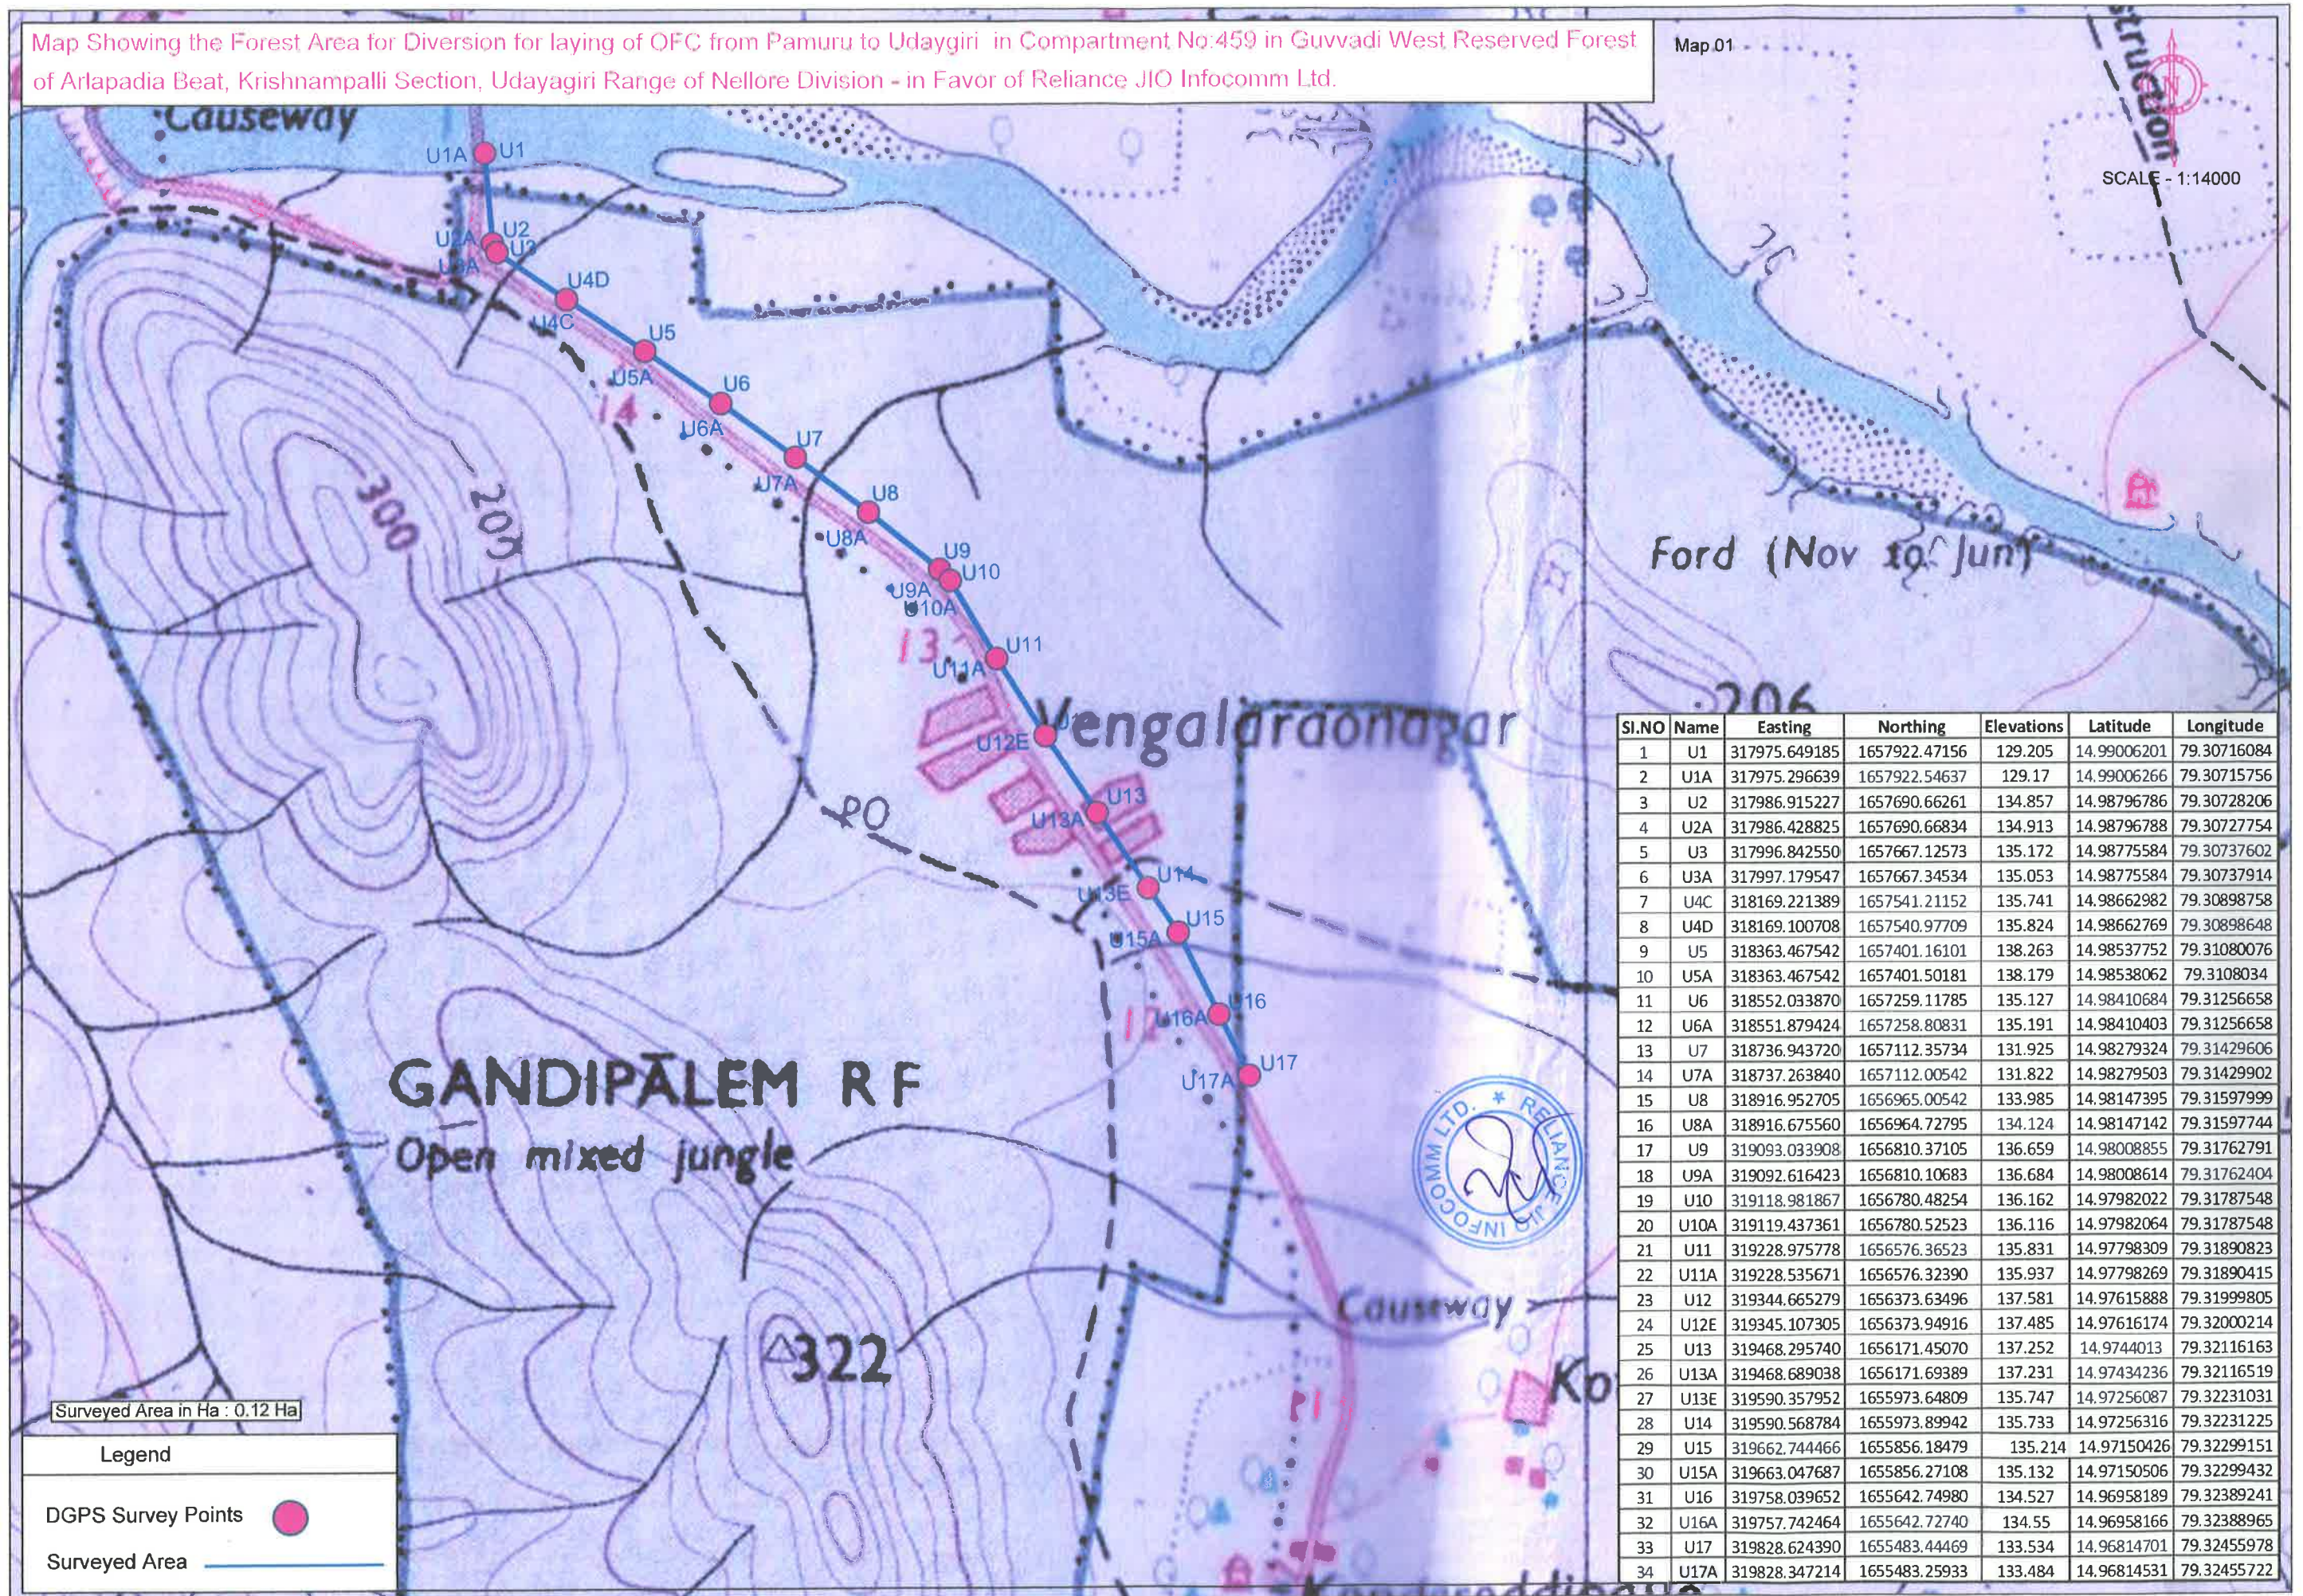


Map Showing the Forest Area for Diversion for laying of OFC from Pamuru to Udaygiri in Compartment No:467 Viruru Reserved Forest, Varikuntapadu Beat, Krishnampally Section & Udaygiri Range of Nellore Division - in Favor of Reliance JIO Infocomm Ltd.

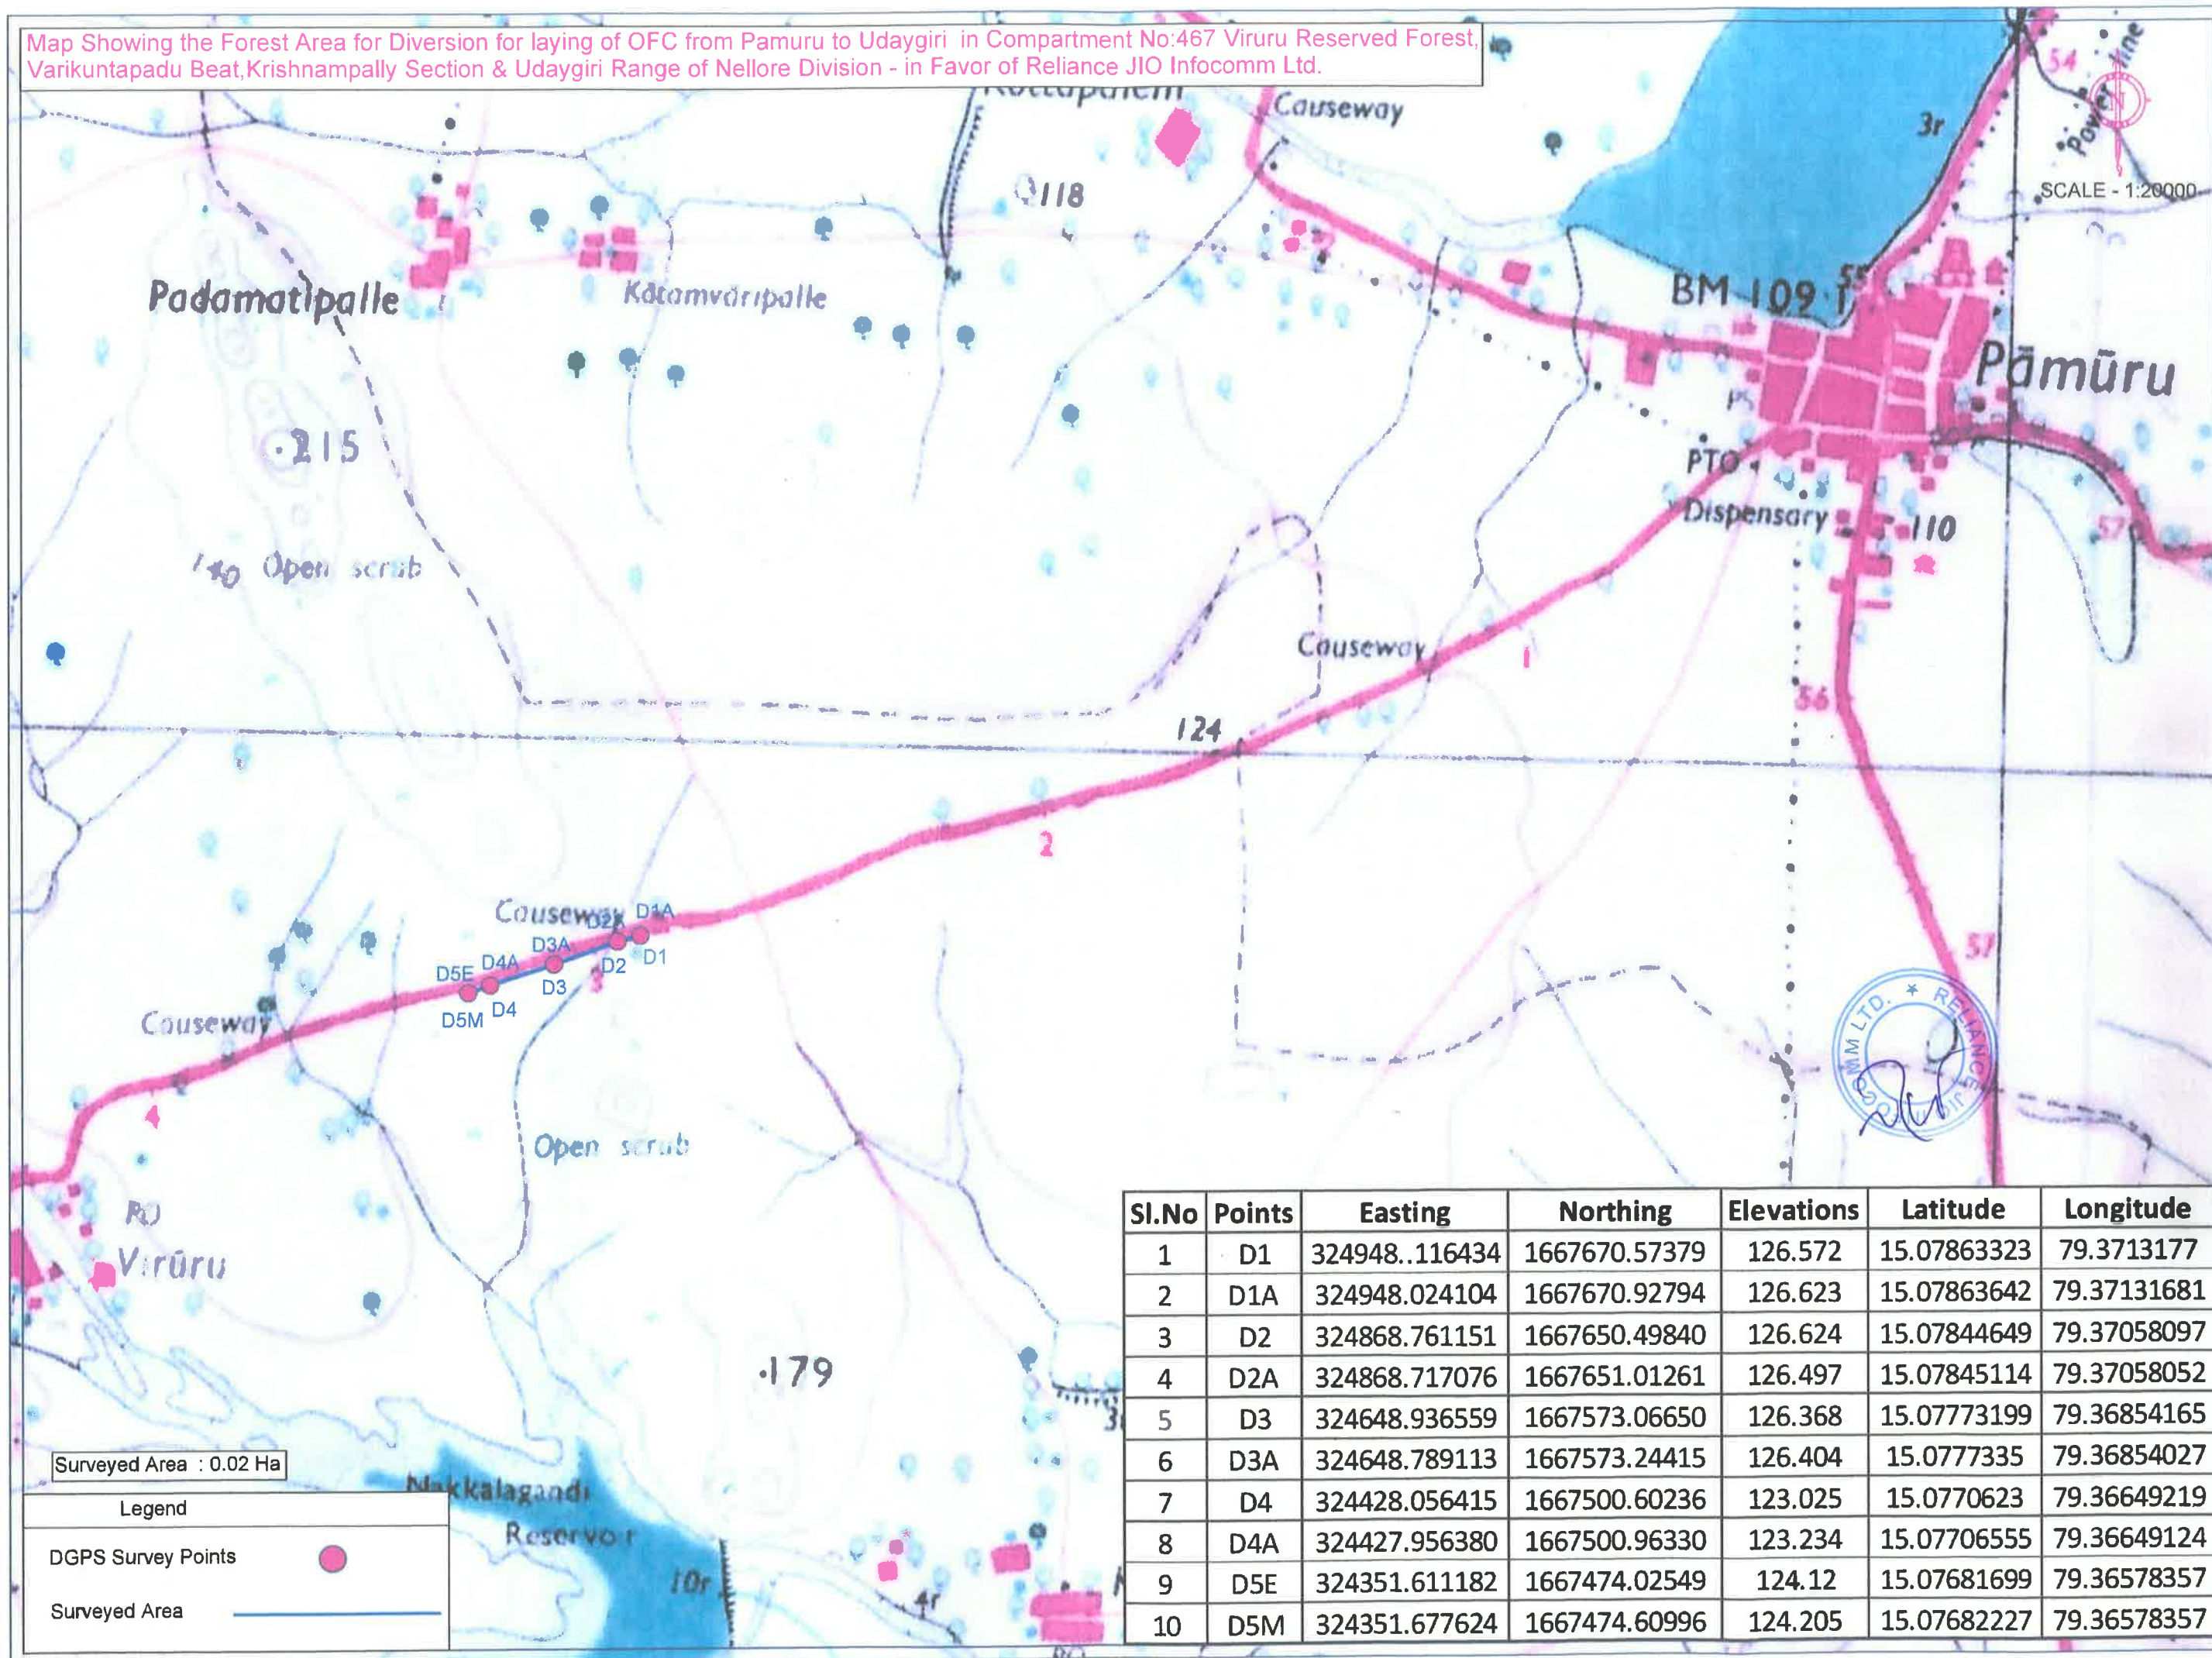


Sl.No	Points	Easting	Northing	Elevations	Latitude	Longitude
1	D1	324948.116434	1667670.57379	126.572	15.07863323	79.3713177
2	D1A	324948.024104	1667670.92794	126.623	15.07863642	79.37131681
3	D2	324868.761151	1667650.49840	126.624	15.07844649	79.37058097
4	D2A	324868.717076	1667651.01261	126.497	15.07845114	79.37058052
5	D3	324648.936559	1667573.06650	126.368	15.07773199	79.36854165
6	D3A	324648.789113	1667573.24415	126.404	15.0777335	79.36854027
7	D4	324428.056415	1667500.60236	123.025	15.0770623	79.36649219
8	D4A	324427.956380	1667500.96330	123.234	15.07706555	79.36649124
9	D5E	324351.611182	1667474.02549	124.12	15.07681699	79.36578357
10	D5M	324351.677624	1667474.60996	124.205	15.07682227	79.36578357

Map Showing the Forest Area for Diversion for laying of OFC from Naidupeta to Kota in Compartment No:169,170,172,173,174
Pudur & Yalasiri Reserved Forest,Venkatigiri Range,Chillamuru Beat & Naidupeta Section of Nellore Division - in Favor of Reliance JIO Infocomm Ltd.

SCALE - 1:26000

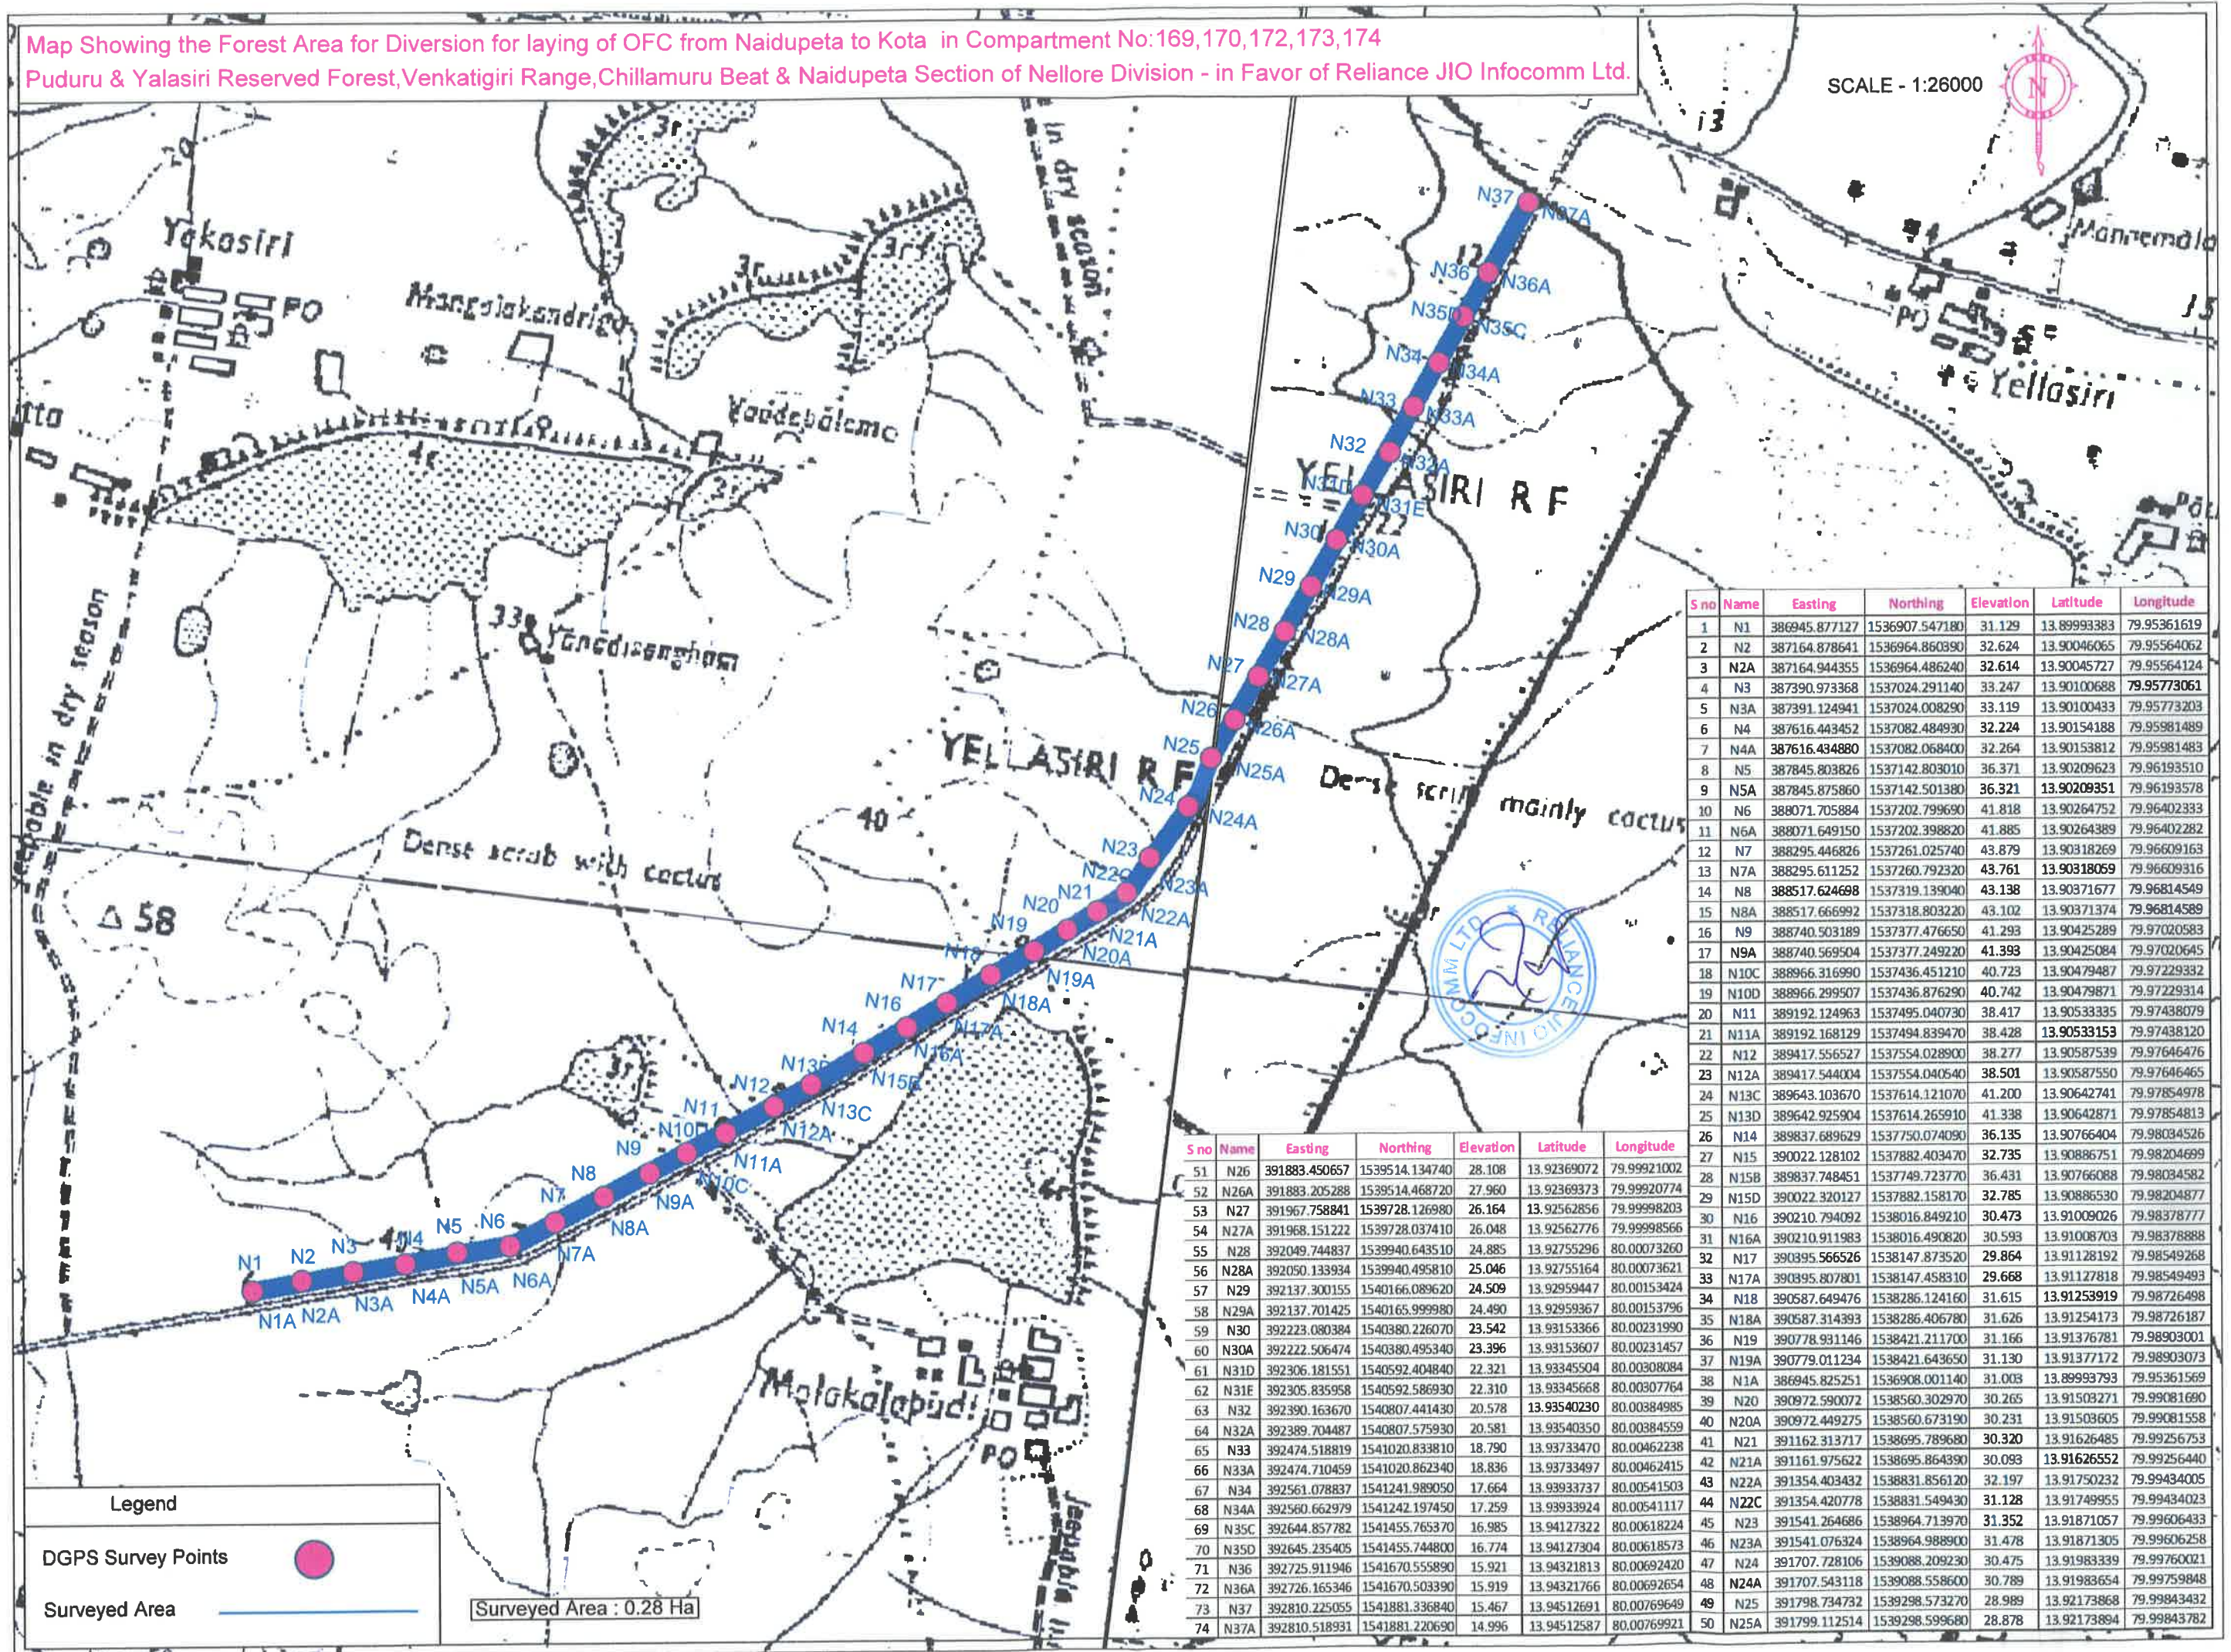

Map Showing the Forest Area for Diversion for laying of OFC from Srialahasthi to Venkatagiri in Compartment No:193,197 in Yathaluru & Perivaram Reserved Forest, Yathaluru & Gurujakunta Beat, Venkatagiri Range & Venkatagiri Section of Nellore Division - in Favor of Reliance JIO Infocomm Ltd.

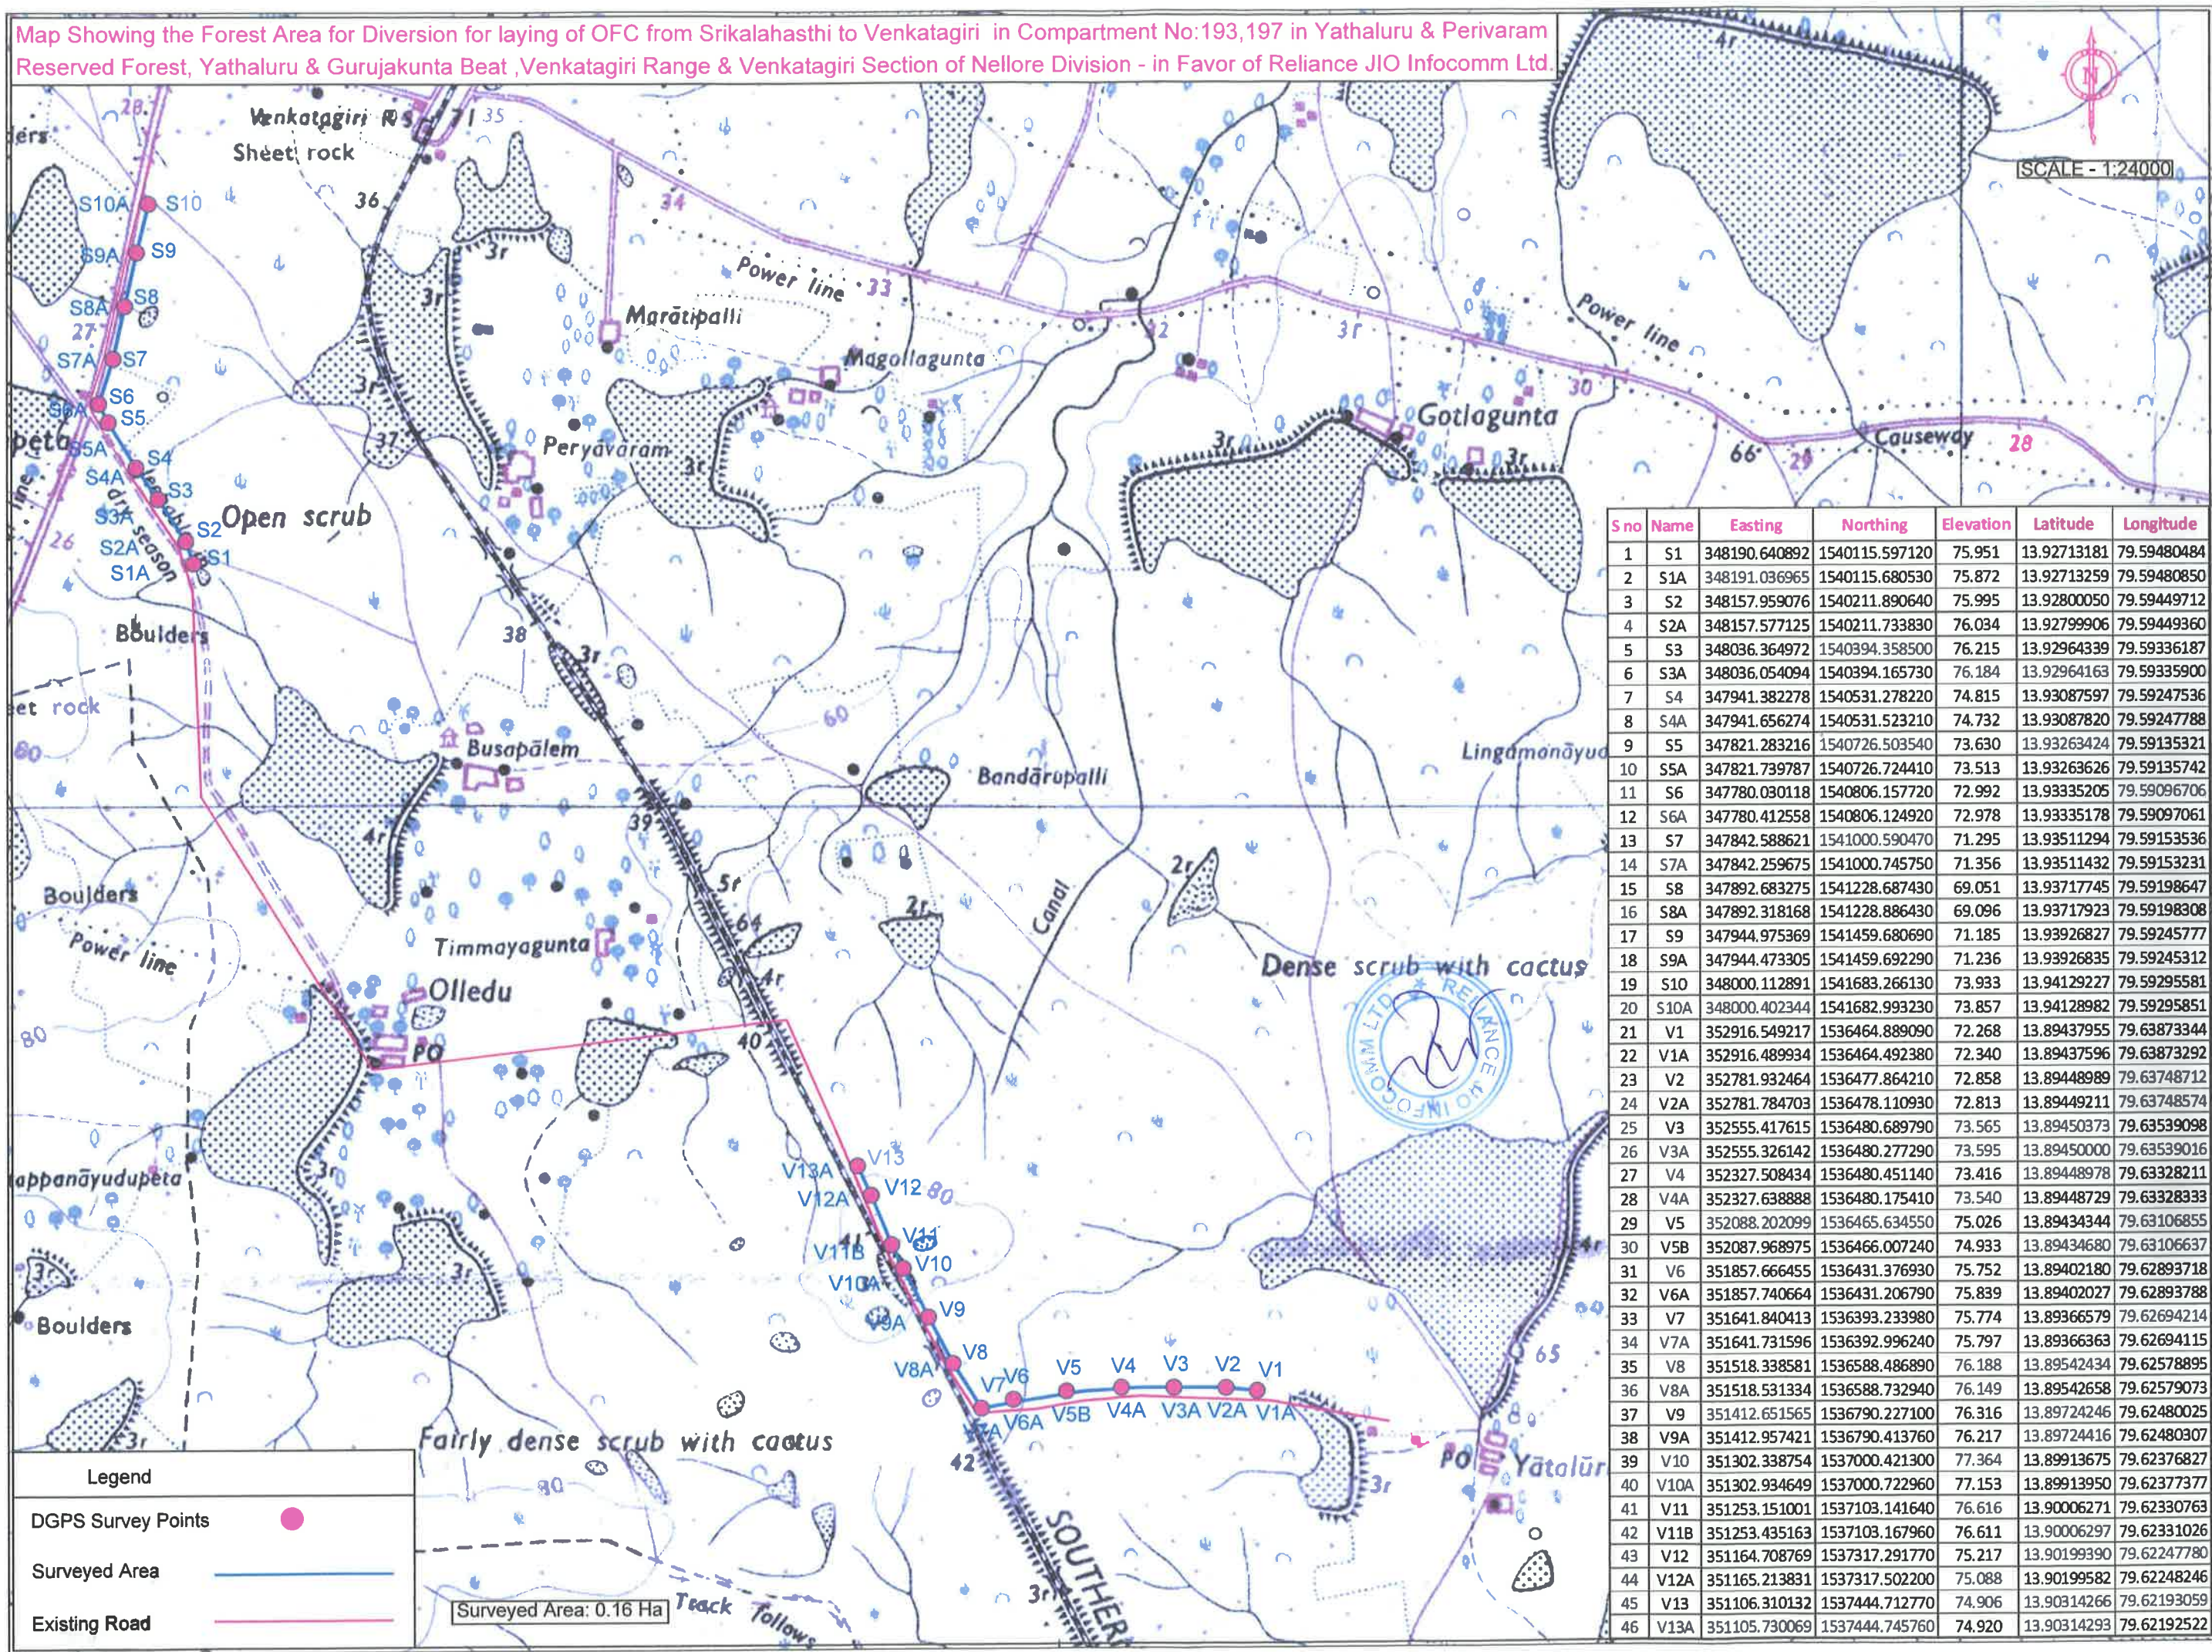

S no	Name	Easting	Northing	Elevation	Latitude	Longitude
1	S1	348190.640892	1540115.597120	75.951	13.92713181	79.59480484
2	S1A	348191.036965	1540115.680530	75.872	13.92713259	79.59480850
3	S2	348157.959076	1540211.890640	75.995	13.92800050	79.59449712
4	S2A	348157.577125	1540211.733830	76.034	13.92799906	79.59449360
5	S3	348036.364972	1540394.358500	76.215	13.92964339	79.59336187
6	S3A	348036.054094	1540394.165730	76.184	13.92964163	79.59335900
7	S4	347941.382278	1540531.278220	74.815	13.93087597	79.59247536
8	S4A	347941.656274	1540531.523210	74.732	13.93087820	79.59247788
9	S5	347821.283216	1540726.503540	73.630	13.93263424	79.59135321
10	S5A	347821.739787	1540726.724410	73.513	13.93263626	79.59135742
11	S6	347780.030118	1540806.157720	72.992	13.93335205	79.59096706
12	S6A	347780.412558	1540806.124920	72.978	13.93335178	79.59097061
13	S7	347842.588621	1541000.590470	71.295	13.93511294	79.59153536
14	S7A	347842.259675	1541000.745750	71.356	13.93511432	79.59153231
15	S8	347892.683275	1541228.687430	69.051	13.93717745	79.59198647
16	S8A	347892.318168	1541228.886430	69.096	13.93717923	79.59198308
17	S9	347944.975369	1541459.680690	71.185	13.93926827	79.59245777
18	S9A	347944.473305	1541459.692290	71.236	13.93926835	79.59245312
19	S10	348000.112891	1541683.266130	73.933	13.94129227	79.59295581
20	S10A	348000.402344	1541682.993230	73.857	13.94128982	79.59295851
21	V1	352916.549217	1536464.889090	72.268	13.89437955	79.63873344
22	V1A	352916.489934	1536464.492380	72.340	13.89437596	79.63873292
23	V2	352781.932464	1536477.864210	72.858	13.89448989	79.63748712
24	V2A	352781.784703	1536478.110930	72.813	13.89449211	79.63748574
25	V3	352555.417615	1536480.689790	73.565	13.89450373	79.63539098
26	V3A	352555.326142	1536480.277290	73.595	13.89450000	79.63539016
27	V4	352327.508434	1536480.451140	73.416	13.89448978	79.63328211
28	V4A	352327.638888	1536480.175410	73.540	13.89448729	79.63328333
29	V5	352088.202099	1536465.634550	75.026	13.89434344	79.63106855
30	V5B	352087.968975	1536466.007240	74.933	13.89434680	79.63106637
31	V6	351857.666455	1536431.376930	75.752	13.89402180	79.62893718
32	V6A	351857.740664	1536431.206790	75.839	13.89402027	79.62893788
33	V7	351641.840413	1536393.233980	75.774	13.89366579	79.62694214
34	V7A	351641.731596	1536392.996240	75.797	13.89366363	79.62694115
35	V8	351518.338581	1536588.486890	76.188	13.89542434	79.62578895
36	V8A	351518.531334	1536588.732940	76.149	13.89542658	79.62579073
37	V9	351412.651565	1536790.227100	76.316	13.89724246	79.62480025
38	V9A	351412.957421	1536790.413760	76.217	13.89724416	79.62480307
39	V10	351302.338754	1537000.421300	77.364	13.89913675	79.62376827
40	V10A	351302.934649	1537000.722960	77.153	13.89913950	79.62377377
41	V11	351253.151001	1537103.141640	76.616	13.90006271	79.62330763
42	V11B	351253.435163	1537103.167960	76.611	13.90006297	79.62331026
43	V12	351164.708769	1537317.291770	75.217	13.90199390	79.62247780
44	V12A	351165.213831	1537317.502200	75.088	13.90199582	79.62248246
45	V13	351106.310132	1537444.712770	74.906	13.90314266	79.62193059
46	V13A	351105.730069	1537444.745760	74.920	13.90314293	79.62192522