



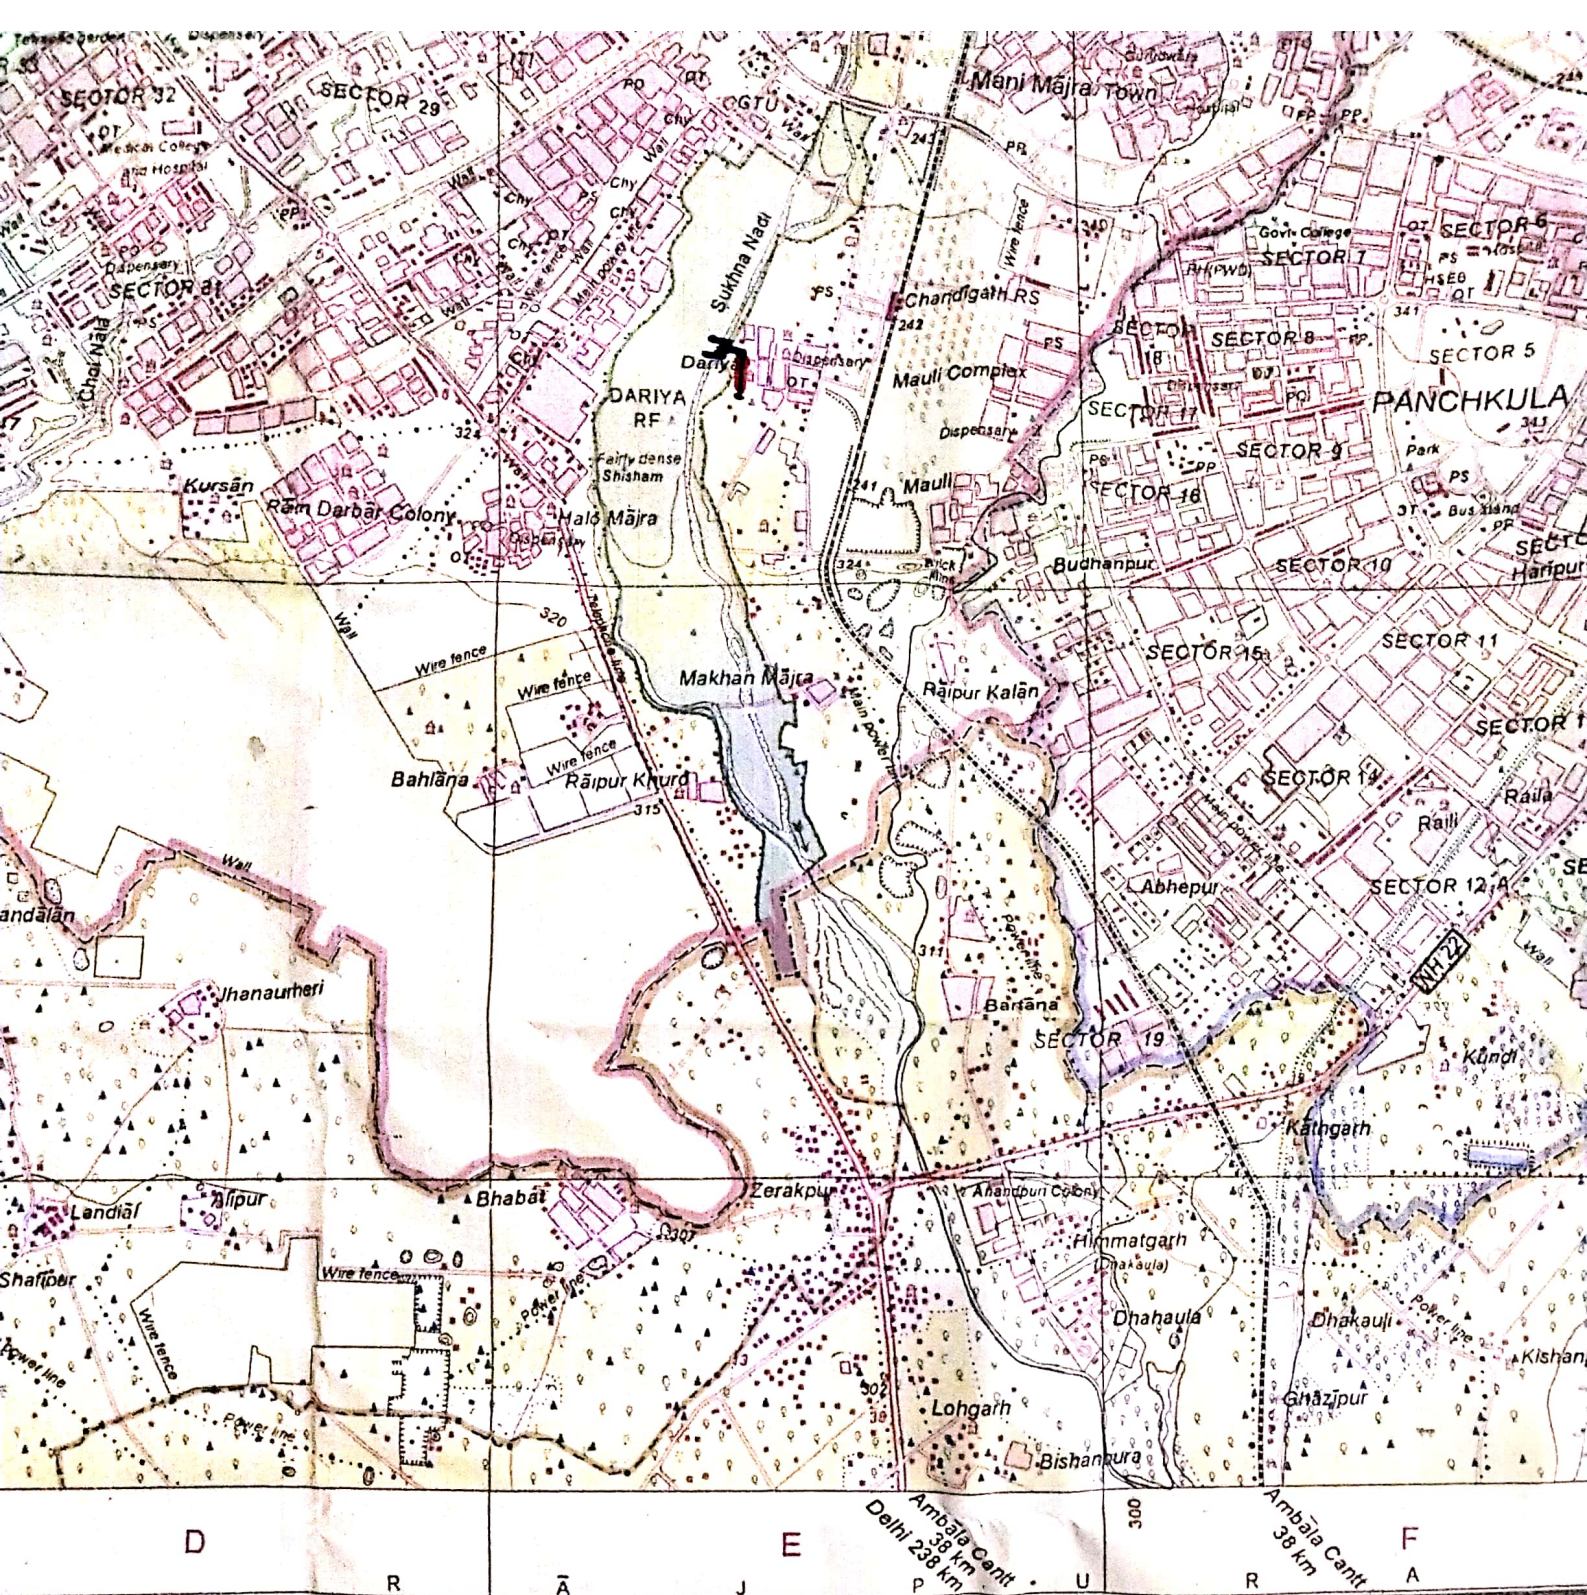

भारत के महासर्वेक्षक सेफ्टिनेट जनरल अशोक कुमार आहुजा, के निदेशन में प्रकाशित,
 blished under the direction of Lieutenant General Ashok Kumar Ahuja, Surveyor General of India.
 1997

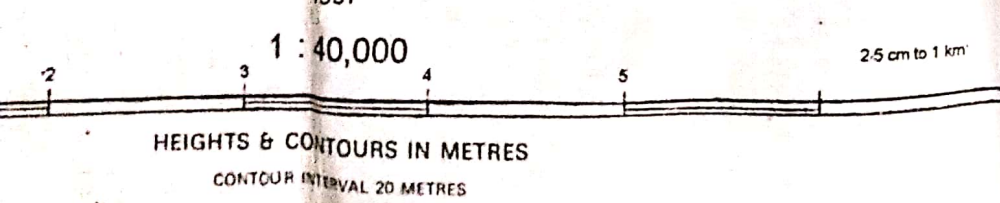

own in blue, where
 coloured yellow,
 of areas of
 are shown by

Contours are approximate.
 A relative height, .8r, represents the
 approximate height, in metres, between the
 top and bottom of a steep slope.
 Wooded areas are coloured green. Scattered
 trees and other vegetation are in green, but
 prominent surveyed trees are in black

Sagged sewer line
Sewer falling in choe
Gpal

Sub. Divisional Engineer,
 M.C.P.H. Sub Division No. 22,
 Chandigarh

