



WIND POWER PROJECT
AT GOGUDDA CHITRADURGA (DIST), KARNATAKA STATE.
AS BUILT MOSAIC MAP AT GOGUDDA SITE.

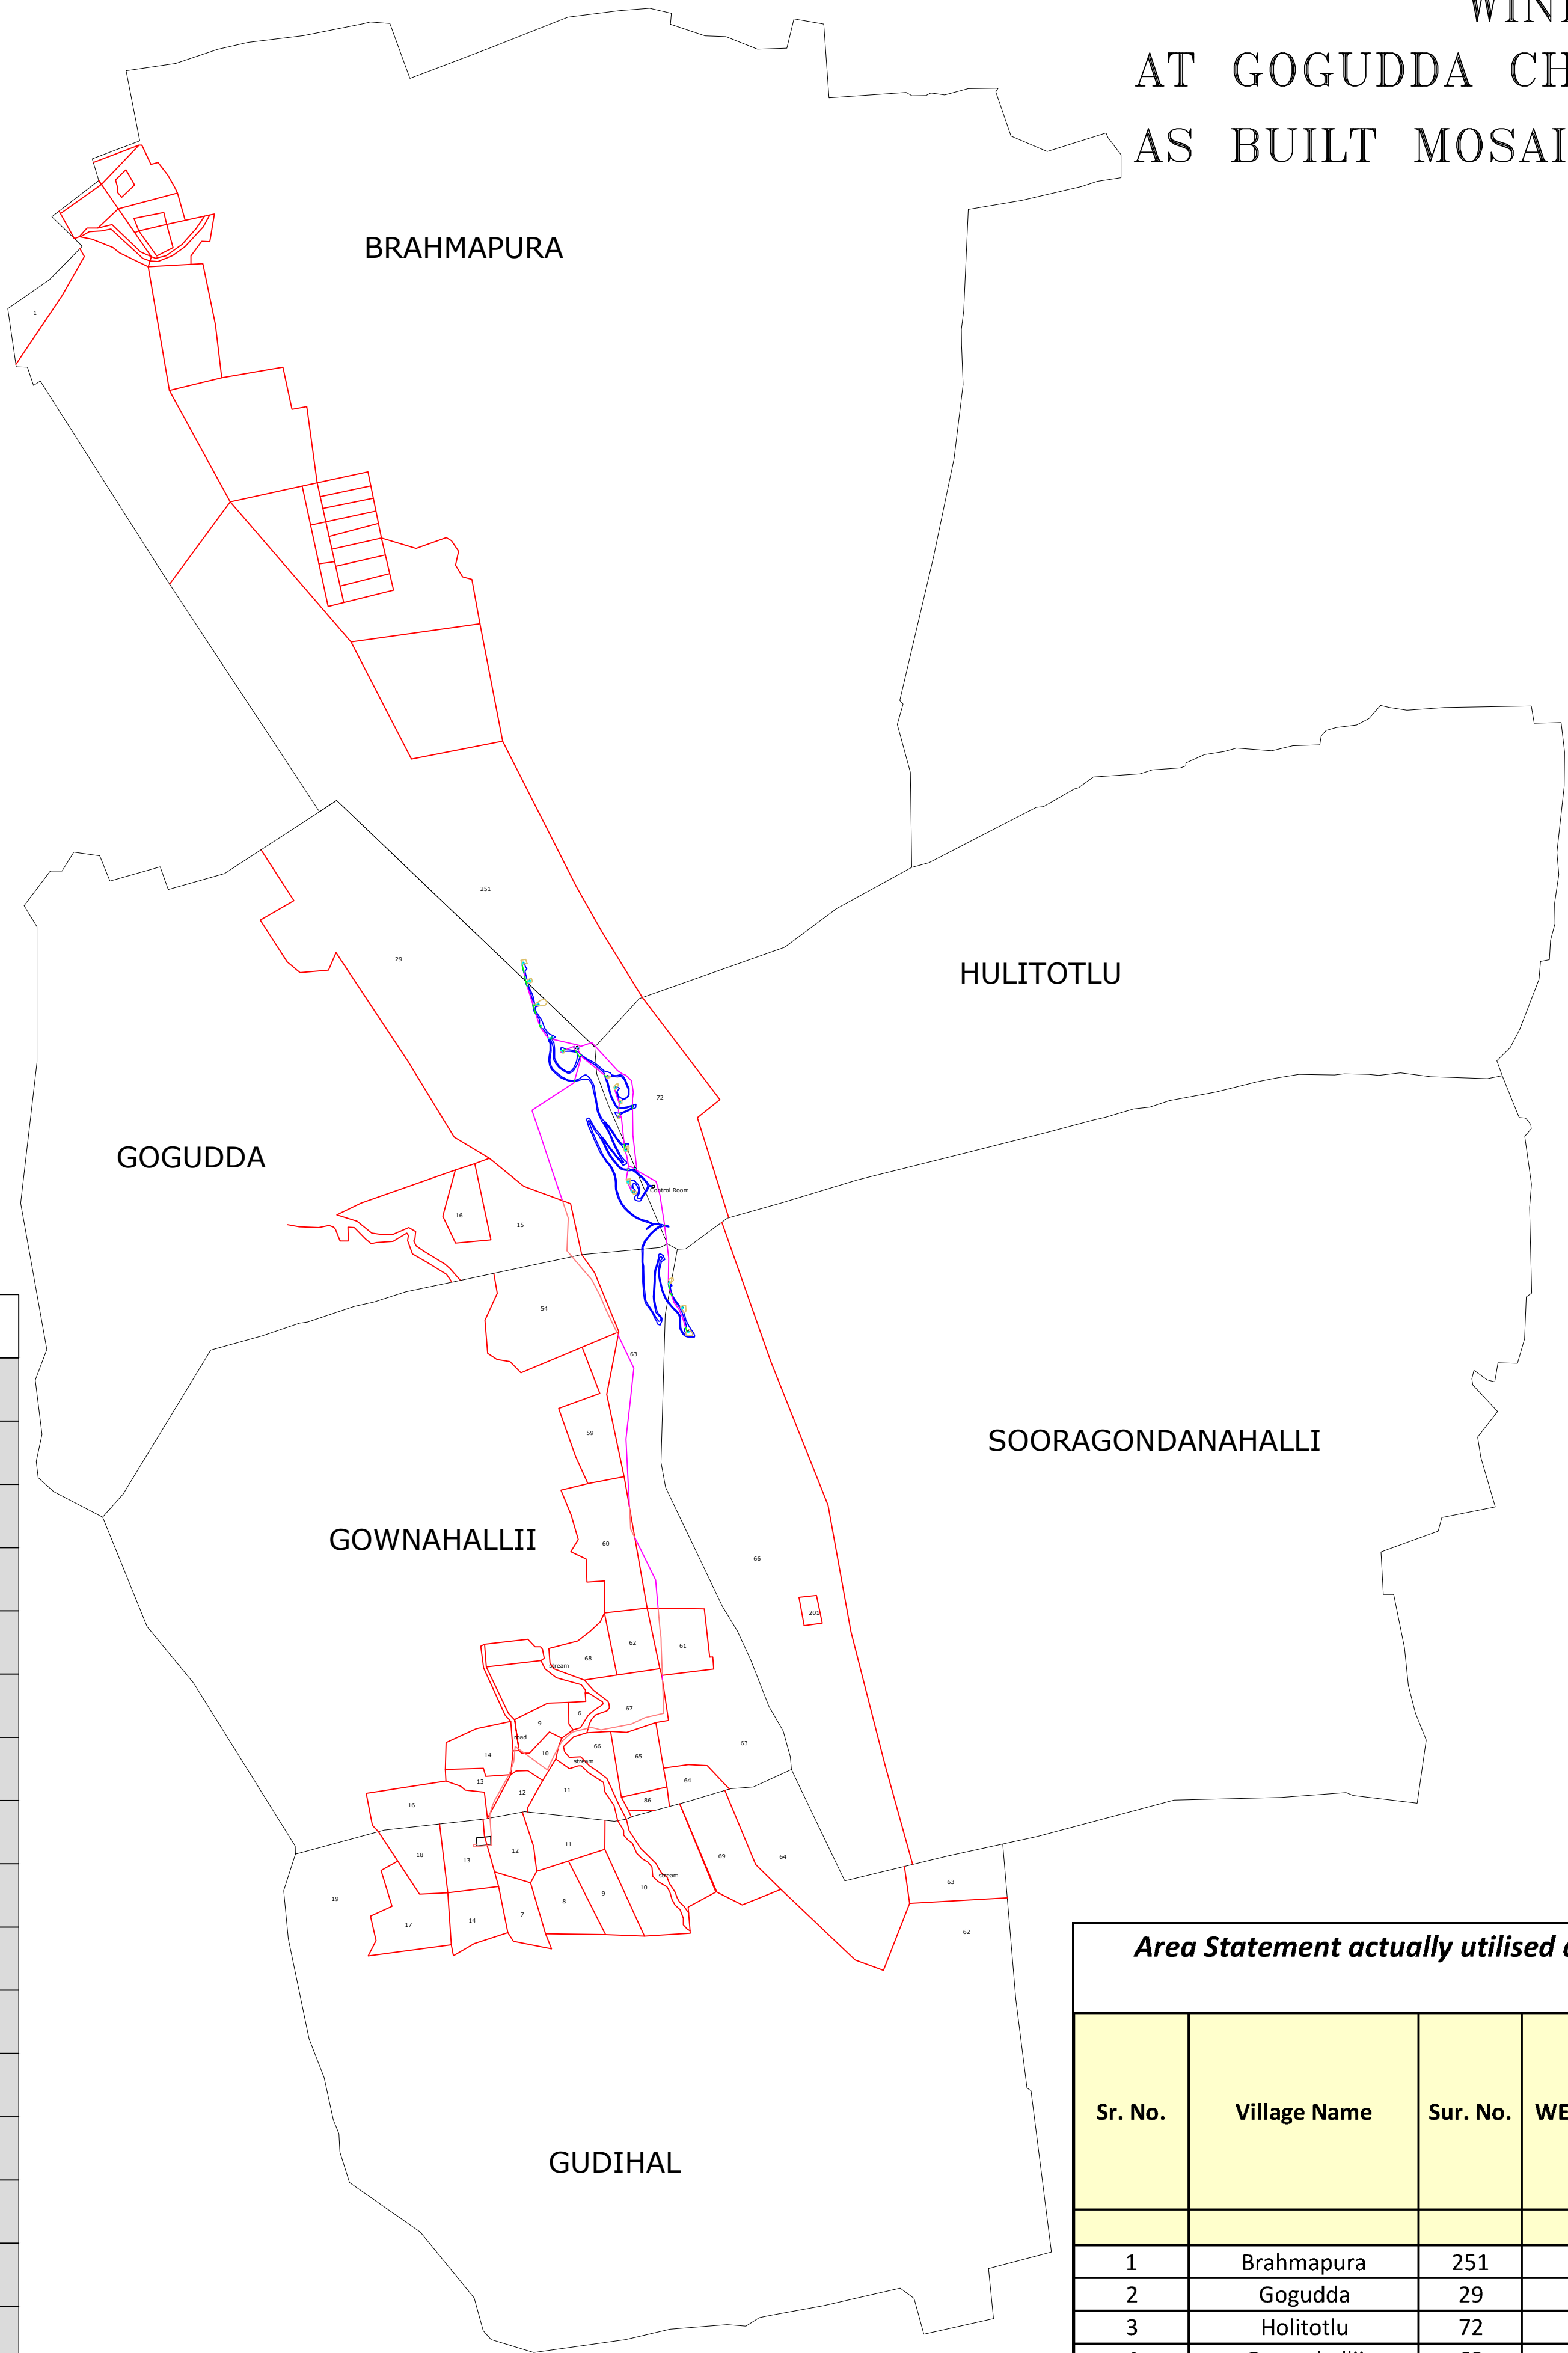

AS BUILT FEATURES	
FEATURE TYPE	LEGEND
	VILLAGE BOUNDARY
	FOREST AS BUILT ROAD
	NON FOREST ROAD
	FOREST AS BUILT ELECTRIC LINE
	NON FOREST ELECTRIC LINE
	FOREST AS BUILT VCB YARD
	NON FOREST VCB YARD
1	AS BUILT PLATFORM AREA WITH NOS
1	NON FOREST PLATFORM AREA WITH NOS
1 1	NOS.FOR COORDINATES OF ROAD & EP LINE

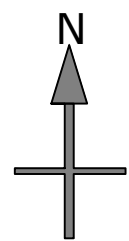

WIND WORLD (INDIA) LTD

-- formerly known as --

Scale:- 1 : 1000

PROJECT:- WIND POWER PROJECT
AT MALAPRABHA SITE BELGAUM (DIST)
KARNATAKA STATE



TITLE:- AS BUILT MOSAIC MAP FOR GOGUDDA SITE

DRAWING NO.:- KAR/GOGUDDA/1 ASBULT-1/1

Godudda Wind Mills Coordinates		
Sr.No.	X	Y
1	76.48802	14.02547
2	76.48838	14.02450
3	76.48886	14.02321
4	76.48900	14.02201
5	76.48961	14.02138
6	76.49024	14.02057
7	76.49273	14.01922
8	76.49319	14.01861
9	76.49343	14.01779
10	76.49332	14.01696
11	76.49375	14.01517
12	76.49388	14.01342
13	76.49415	14.01283
14	76.49613	14.00786
15	76.49687	14.00647
16	76.49718	14.00515


Area Statement actually utilised area in Hectare for Gogudda Wind Power Project, Chitradurga District, Karnataka by Wind World India Limited										
Sr. No.	Village Name	Sur. No.	WEC's No.	Platform Area in Ha.	Road Area In Ha.	Length of electrical line outside road,platform,VCB (Mtr)	Area for electrical line outside road,platform,VCB in Ha considering 15 mtr width	Vacuum Circuit Breaker (VCB) Area In Ha.	Control Room Area In Ha.	Total In Ha.
				A	B		C	D		Sum of (A+B+C+D)
1	Brahmapura	251	2	0.147	0.144	59.730	0.090			0.381
2	Gogudda	29	7	0.355	3.582	2108.01	3.162	0.027		7.126
3	Holitotlu	72	4	0.143	0.886	1736.28	2.604	0.001	0.019	3.653
4	Gownahallii	63	1	0.050	0.900	1803.35	2.705			3.655
5	Sooragondanahalli	66	2	0.227	0.533	245.84	0.369			1.129
Total			16	0.922	6.045	5953.21	8.930	0.028	0.019	15.944

WIND POWER PROJECT
AT GOGUDDA SITE CHITRADURGA (DIST), KARNATAKA STATE.
AS BUILT DRAWING SUPERIMPOSED ON CADASTRAL MAP
FOR VILLAGE BRAHMAPURA AT GOGUDDA SITE

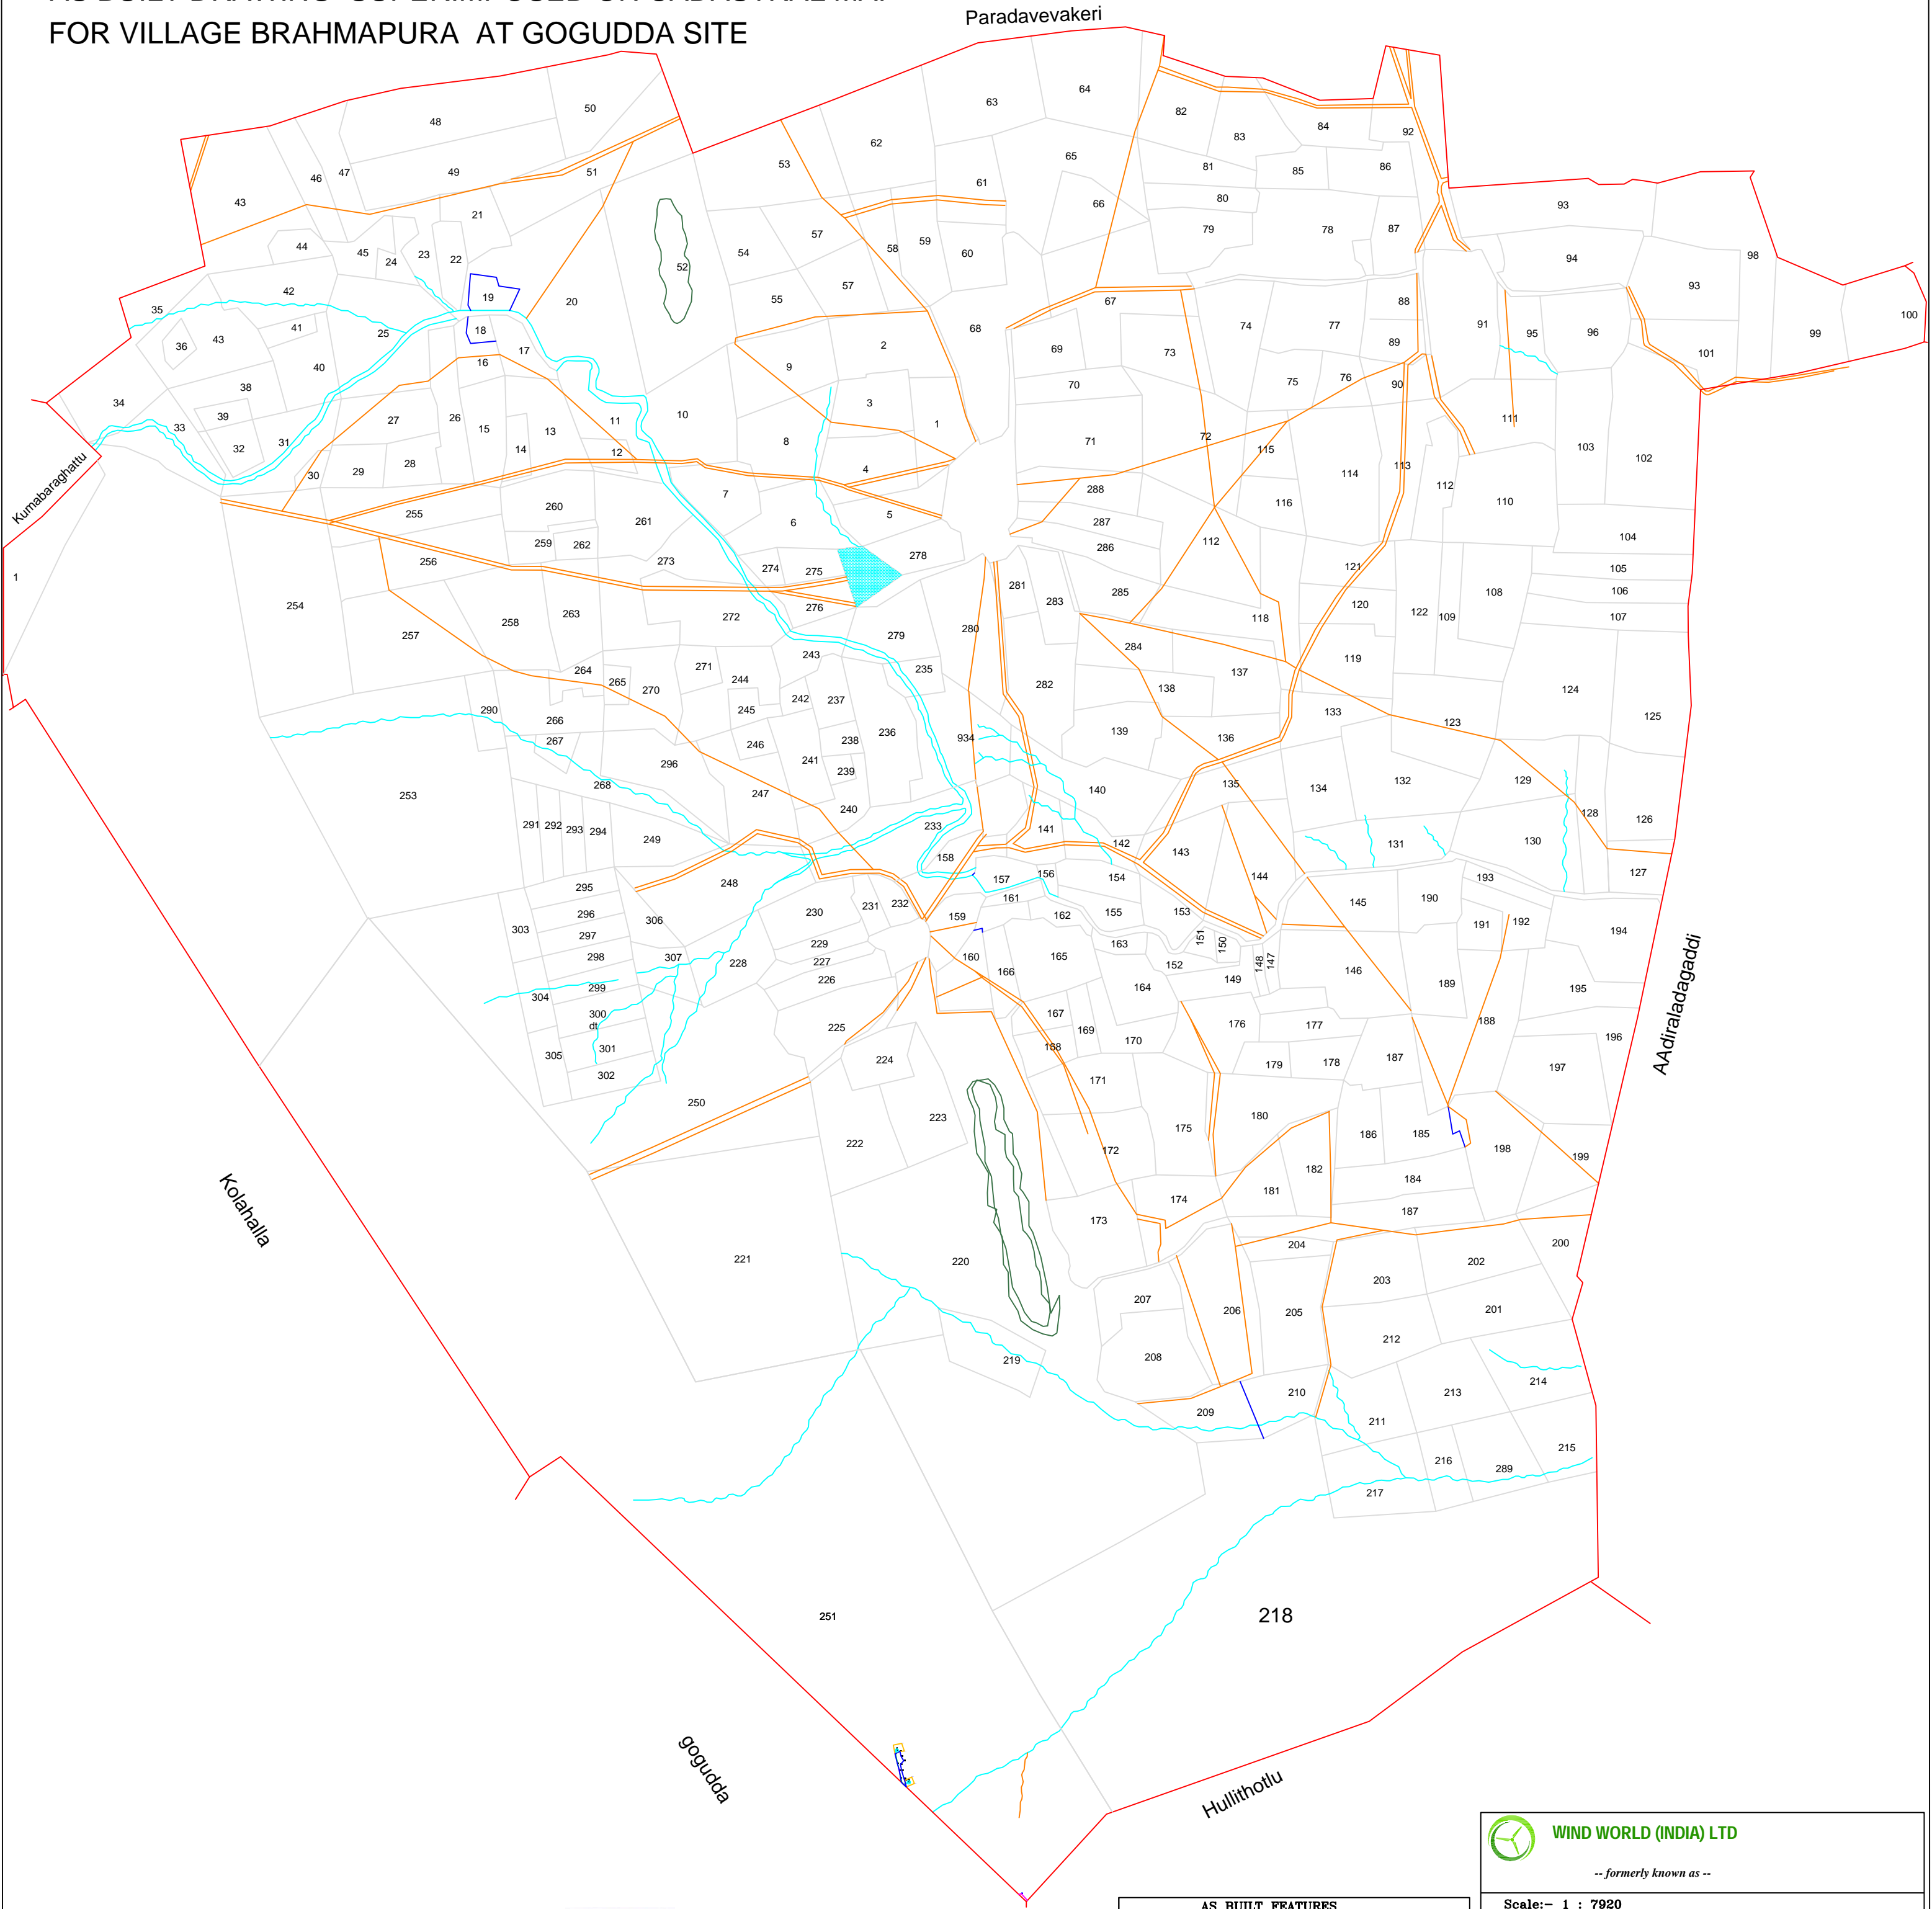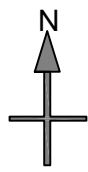

CADASTRAL MAP FEATURES	
FEATURE TYPE	LEGEND
	SURVEY BOUNDARY WITH NOS.
	ROAD
	STREAMS
	HILL

AS BUILT FEATURES	
FEATURE TYPE	LEGEND
	VILLAGE BOUNDARY
	AS BUILT ROAD
	NON FOREST ROAD
	AS BUILT ELECTRIC LINE
	NON FOREST ELECTRIC LINE
	AS BUILT VCB YARD
	NON FOREST VCB YARD
	AS BUILT PLATFORM AREA WITH NOS
	NON FOREST PLATFORM AREA WITH NOS
	NOS.FOR COORDINATES OF ROAD & EP LINE



WIND WORLD (INDIA) LTD
-- formerly known as --


Scale:- 1 : 7920

PROJECT:- WIND POWER PROJECT
AT GOGUDDA SITE CHITRADURGA (DIST)
KARNATAKA STATE

TITLE:- 7920 MAP FOR BRAHMAPURA VILLAGE


DRAWING NO.:- KAR/GOGUDDA/1

ASBULT-1/1

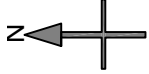


218

251

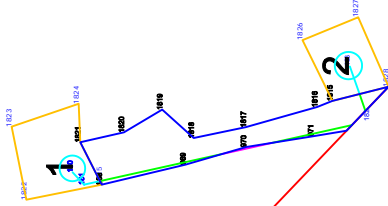

WIND POWER PROJECT
AT GOGUDDA SITE CHITRADURGA (DIST), KARNATAKA STATE.
AS BUILT SUPERIMPOSED ON CADASTRAL MAP AT GOGUDDA SITE (BRAHMAPURA VILLAGE)

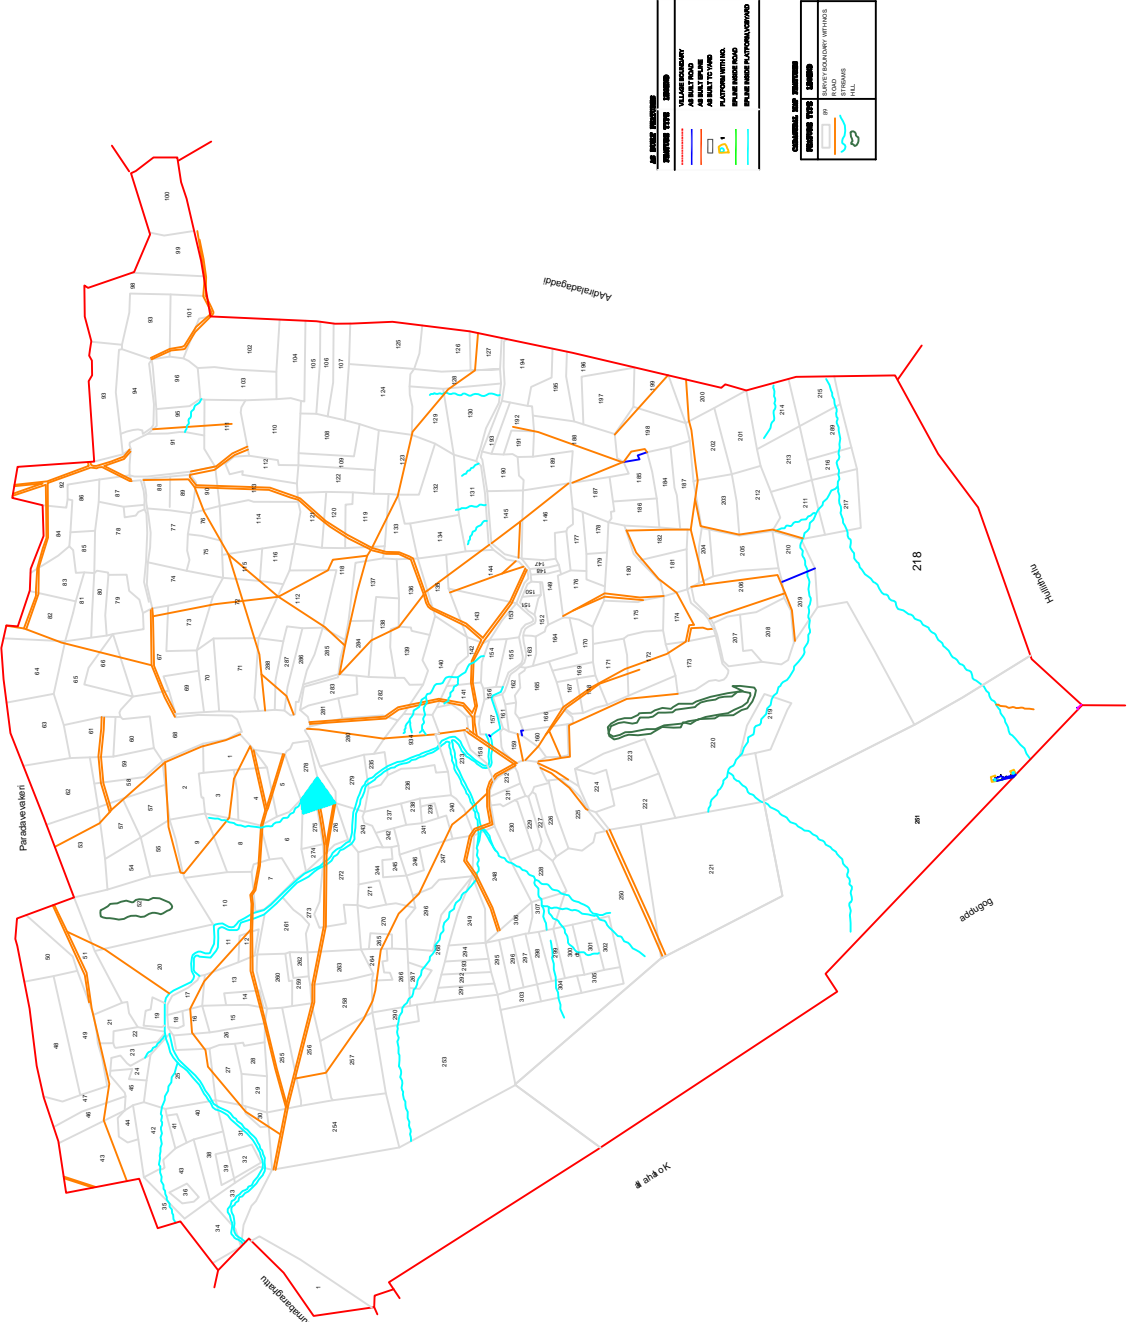



AT GOGUDDA SITE CHITRADURGA (DIST), KARNATAKA STATE
AS BUILT DRAWING SUPERIMPOSED ON SCALED MAP
FOR VILLAGE BRAHMAPURA AT GOGUDDA SITE

	WIND WORLD (INDIA) LTD <i>— formerly known as —</i>
Scale:-	NTS
PROJECT:-	WIND POWER PROJECT AT GOGUDDA SITE CHITRADURGA (VILLAGE) KARNATAKA STATE
TITLE:-	SCALED MAP FOR BRAHMAPURA VILLAGE
DRAWING NO.:-	KAN/GOGUDDA/1
DATE:-	-/-/

FEATURE TYPE	LEGEND
VILLAGE BOUNDARY	
AS BUILT ROAD	
AS BUILT ELECTRIC LINE	
NON FOREST ELECTRIC LINE	
AS BUILT VES YARD	
AS BUILT PLATFORM AREA	
NON FOREST PLATFORM AREA WITH NOS	
NOS FOR COORDINATES OF ROAD & BP LINE	

FEATURE TYPE	LEGEND
89	
ROAD	
STREAMS	
HILL	

WIND POWER PROJECT
AT GOGUDDA SITE CHITRADURGA (DIST), KARNATAKA STATE.
AS BUILT DRAWING SUPERIMPOSED ON CADASTRAL MAP
FOR VILLAGE GOGUDDA AT GOGUDDA SITE

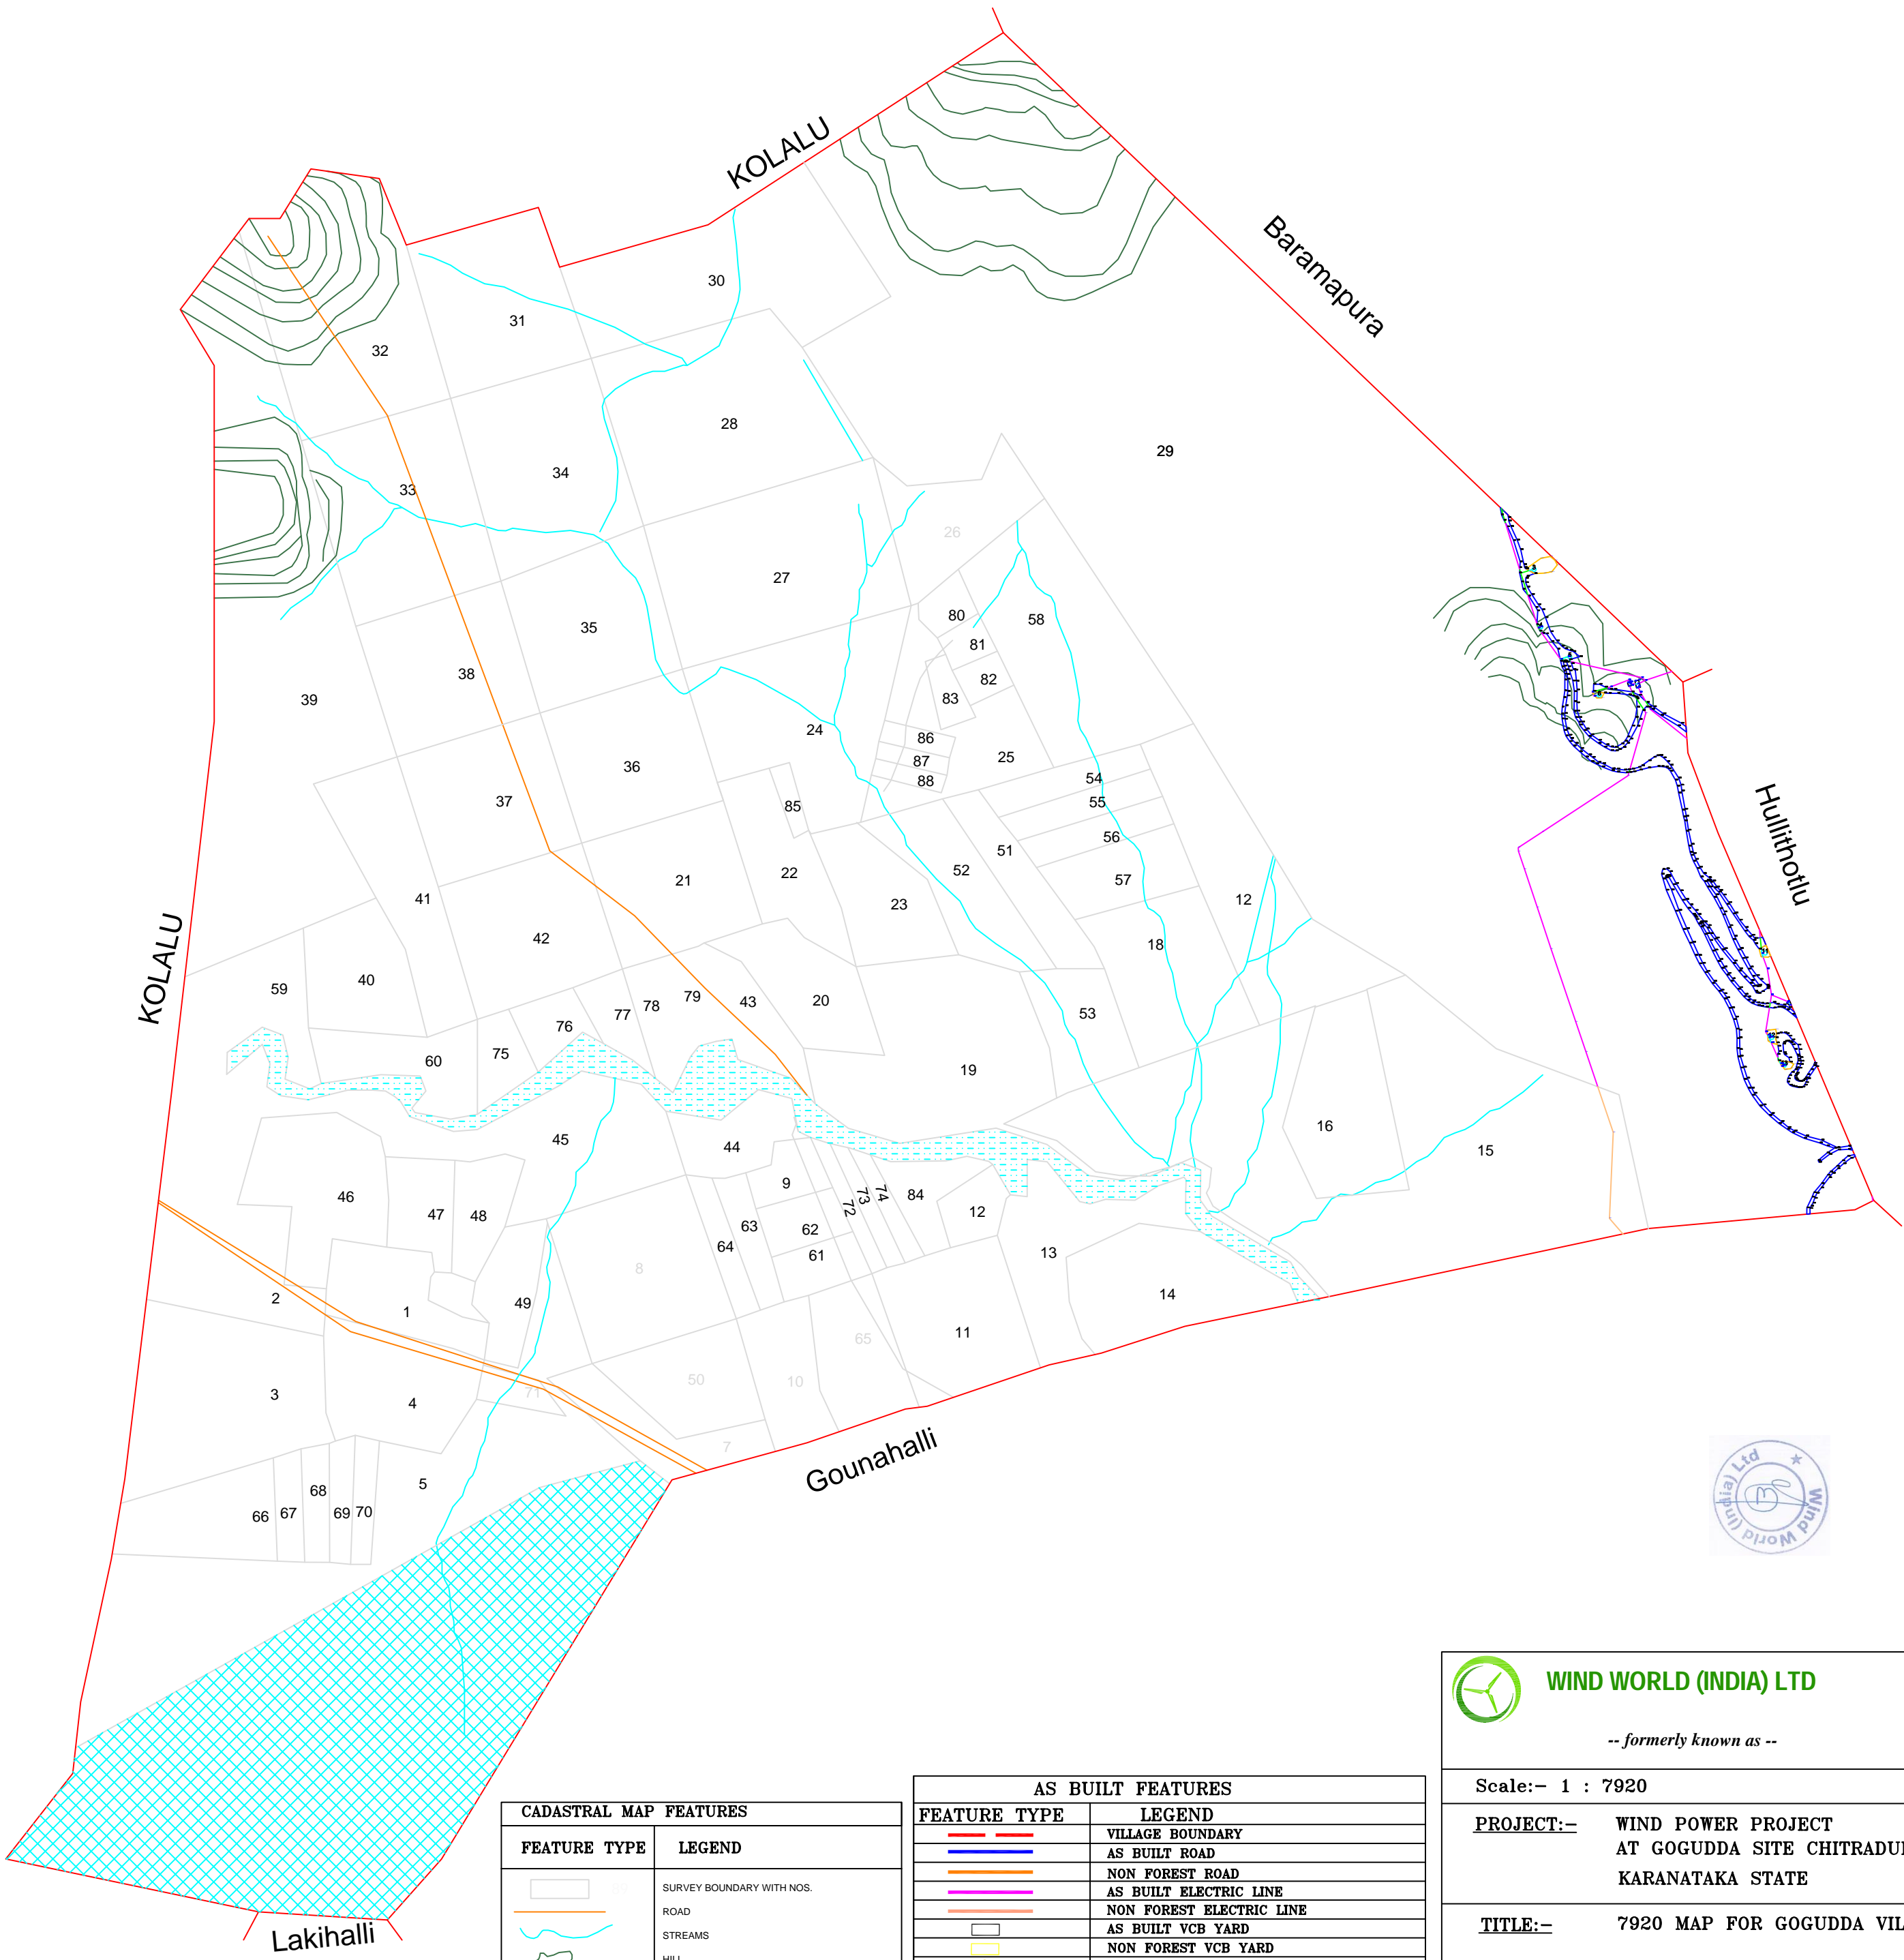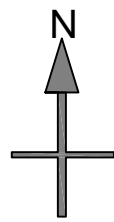

CADASTRAL MAP FEATURES	
FEATURE TYPE	LEGEND
	SURVEY BOUNDARY WITH NOS.
	ROAD
	STREAMS
	HILL

AS BUILT FEATURES	
FEATURE TYPE	LEGEND
	VILLAGE BOUNDARY
	AS BUILT ROAD
	NON FOREST ROAD
	AS BUILT ELECTRIC LINE
	NON FOREST ELECTRIC LINE
	AS BUILT VCB YARD
	NON FOREST VCB YARD
	AS BUILT PLATFORM AREA WITH NOS
	NON FOREST PLATFORM AREA WITH NOS
	NOS.FOR COORDINATES OF ROAD & EP LINE




WIND WORLD (INDIA) LTD



-- formerly known as --

Scale:- 1 : 7920	
PROJECT:- WIND POWER PROJECT AT GOGUDDA SITE CHITRADURGA (DIST) KARNATAKA STATE	
TITLE:- 7920 MAP FOR GOGUDDA VILLAGE	
DRAWING NO.:- KAR/GOGUDDA/1	ASBULT-1/1

WIND POWER PROJECT
AT GOGUDDA SITE CHITRADURGA (DIST), KARNATAKA STATE.

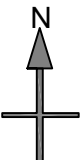


AS BUILT DRAWING SUPERIMPOSED ON SCALED MAP
FOR VILLAGE GOGUDDA AT GOGUDDA SITE

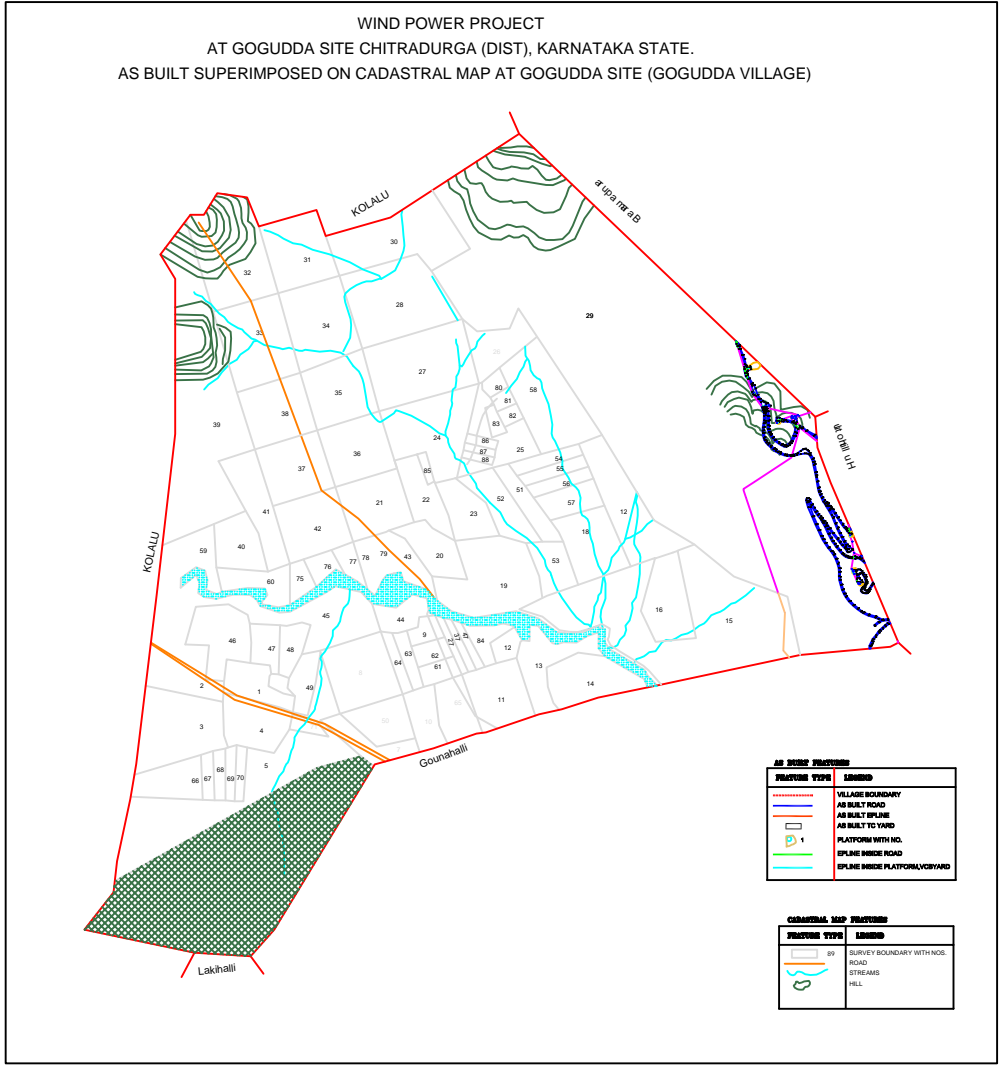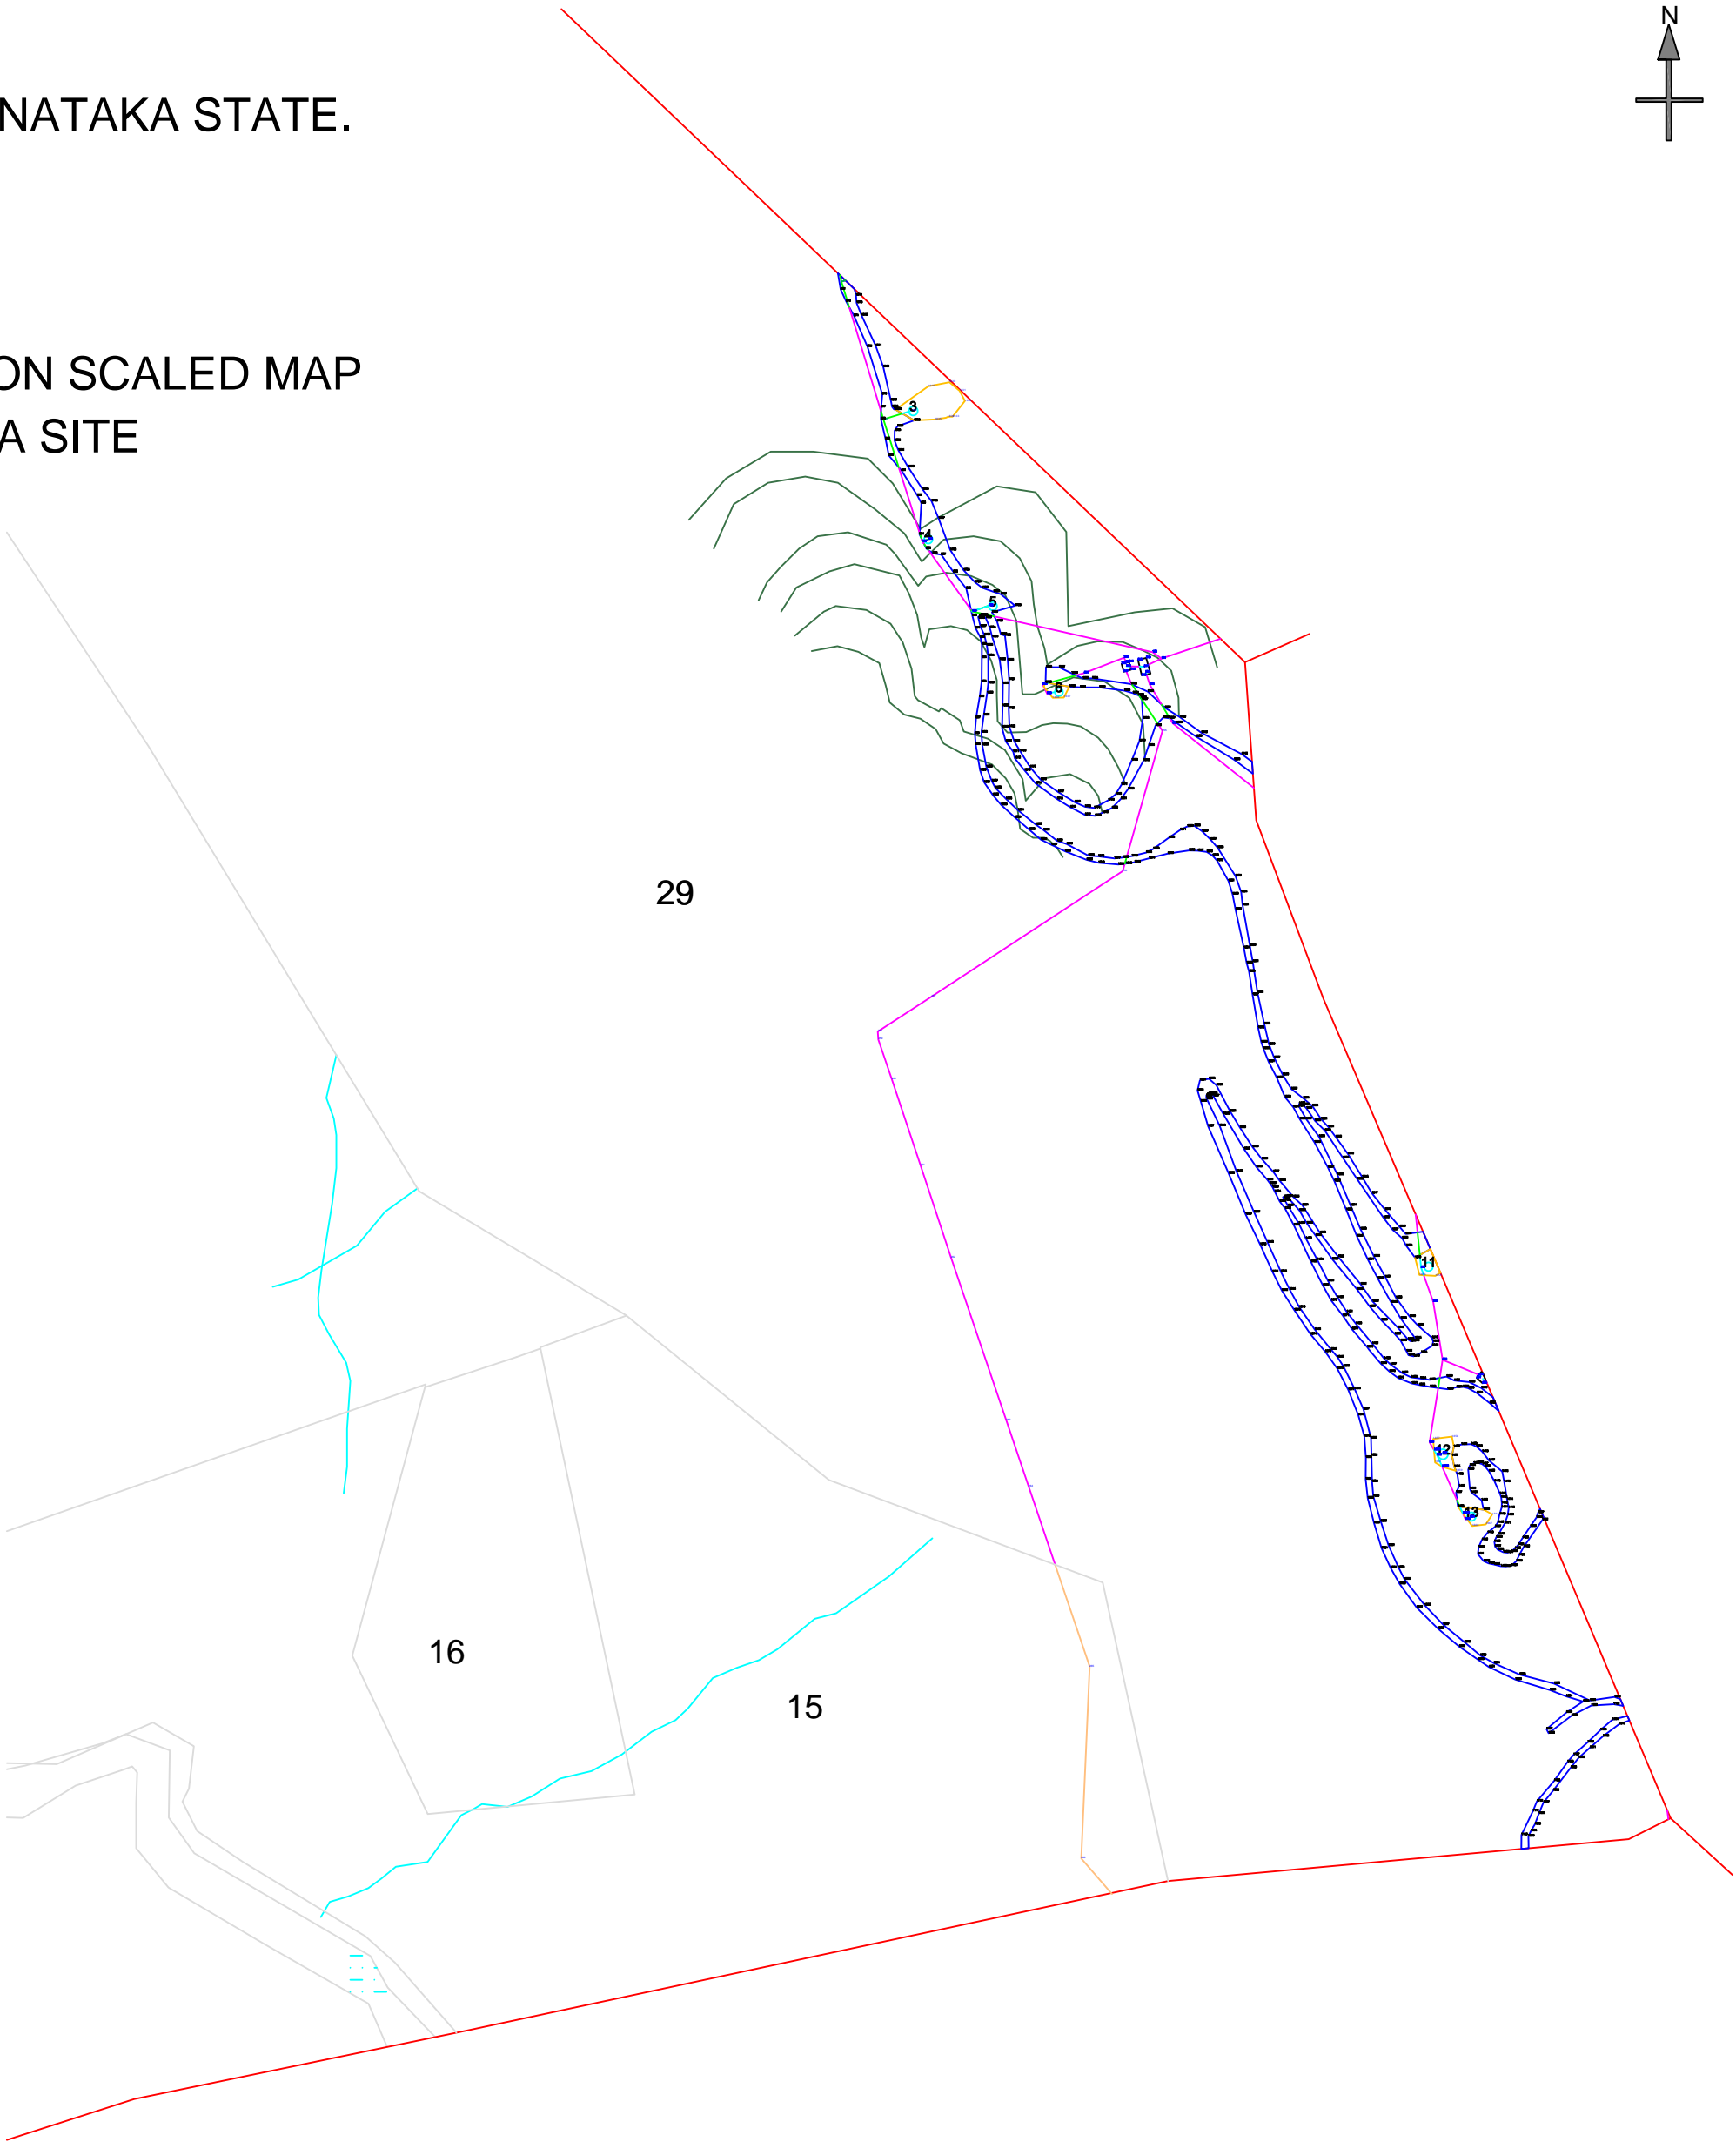

CADASTRAL MAP FEATURES	
FEATURE TYPE	LEGEND
89	SURVEY BOUNDARY WITH NOS.
	ROAD
	STREAMS
	HILL

AS BUILT FEATURES	
FEATURE TYPE	LEGEND
	VILLAGE BOUNDARY
	AS BUILT ROAD
	NON FOREST ROAD
	AS BUILT ELECTRIC LINE
	NON FOREST ELECTRIC LINE
	AS BUILT VCB YARD
	NON FOREST VCB YARD
1	AS BUILT PLATFORM AREA WITH NOS
1	NON FOREST PLATFORM AREA WITH NOS
1	NOS.FOR COORDINATES OF ROAD & EP LINE

**WIND WORLD (INDIA) LTD**
— formerly known as —

Scale:- NTS



PROJECT:- WIND POWER PROJECT
AT GOGUDDA SITE CHITRADURGA (DIST)
KARNATAKA STATE

TITLE:- SCALED MAP FOR GOGUDDA VILLAGE

DRAWING NO.:- KAR/GOGUDDA/1

ASBUILT-1/1

WIND POWER PROJECT
AT GOGUDDA SITE CHITRADURGA (DIST), KARNATAKA STATE.
AS BUILT DRAWING SUPERIMPOSED ON CADASTRAL MAP
FOR VILLAGE GOWNAHALLI AT GOGUDDA SITE

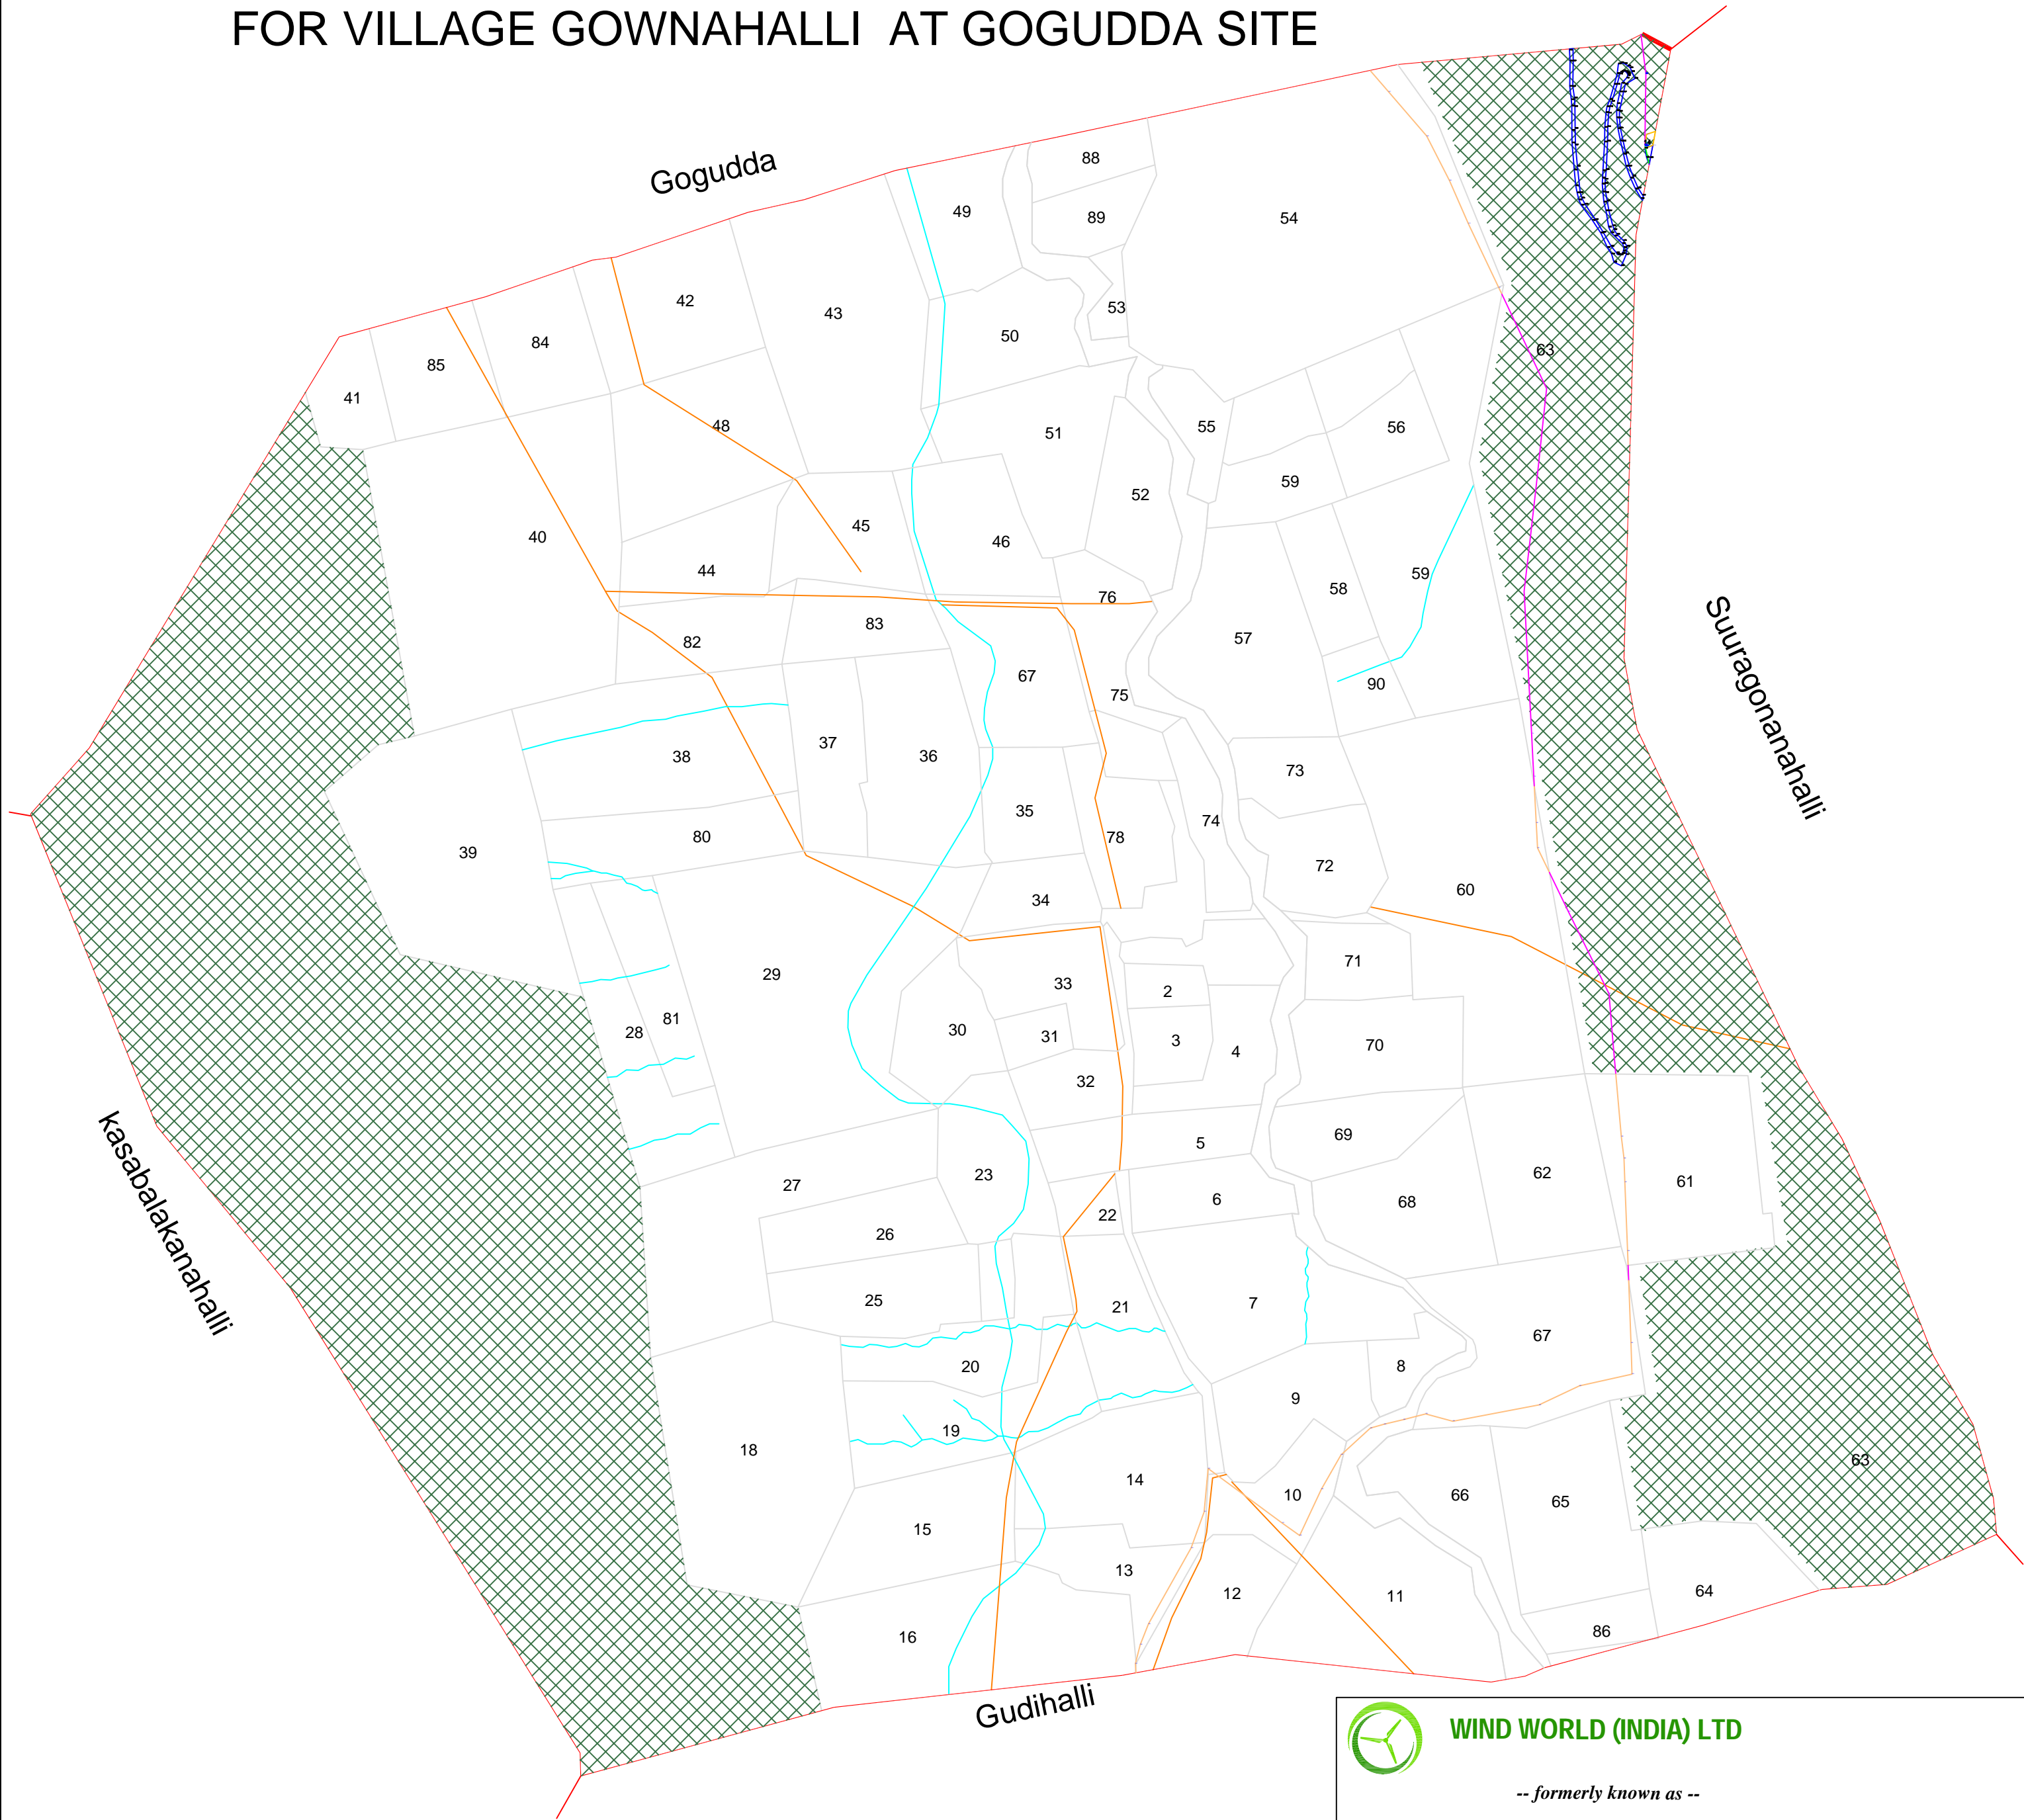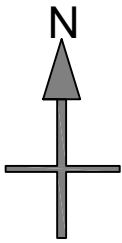

CADASTRAL MAP FEATURES	
FEATURE TYPE	LEGEND
	SURVEY BOUNDARY WITH NOS.
	ROAD
	STREAMS
	HILL

AS BUILT FEATURES	
FEATURE TYPE	LEGEND
	VILLAGE BOUNDARY
	AS BUILT ROAD
	NON FOREST ROAD
	AS BUILT ELECTRIC LINE
	NON FOREST ELECTRIC LINE
	AS BUILT VCB YARD
	NON FOREST VCB YARD
	AS BUILT PLATFORM AREA WITH NOS
	NON FOREST PLATFORM AREA WITH NOS
	NOS.FOR COORDINATES OF ROAD & EP LINE



WIND WORLD (INDIA) LTD

-- formerly known as --

Scale:- 1 : 7920



PROJECT:- WIND POWER PROJECT
AT GOGUDDA SITE CHITRADURGA (DIST)
KARNATAKA STATE

TITLE:- 7920 MAP FOR GOWNAHALLI VILLAGE


DRAWING NO.:- KAR/GOGUDDA/1

ASBULT-1/1

WIND POWER PROJECT
AT GOGUDDA SITE CHITRADURGA (DIST), KARNATAKA STATE.
AS BUILT DRAWING SUPERIMPOSED ON SCALED MAP
FOR VILLAGE GOWNAHALLI AT GOGUDDA SITE

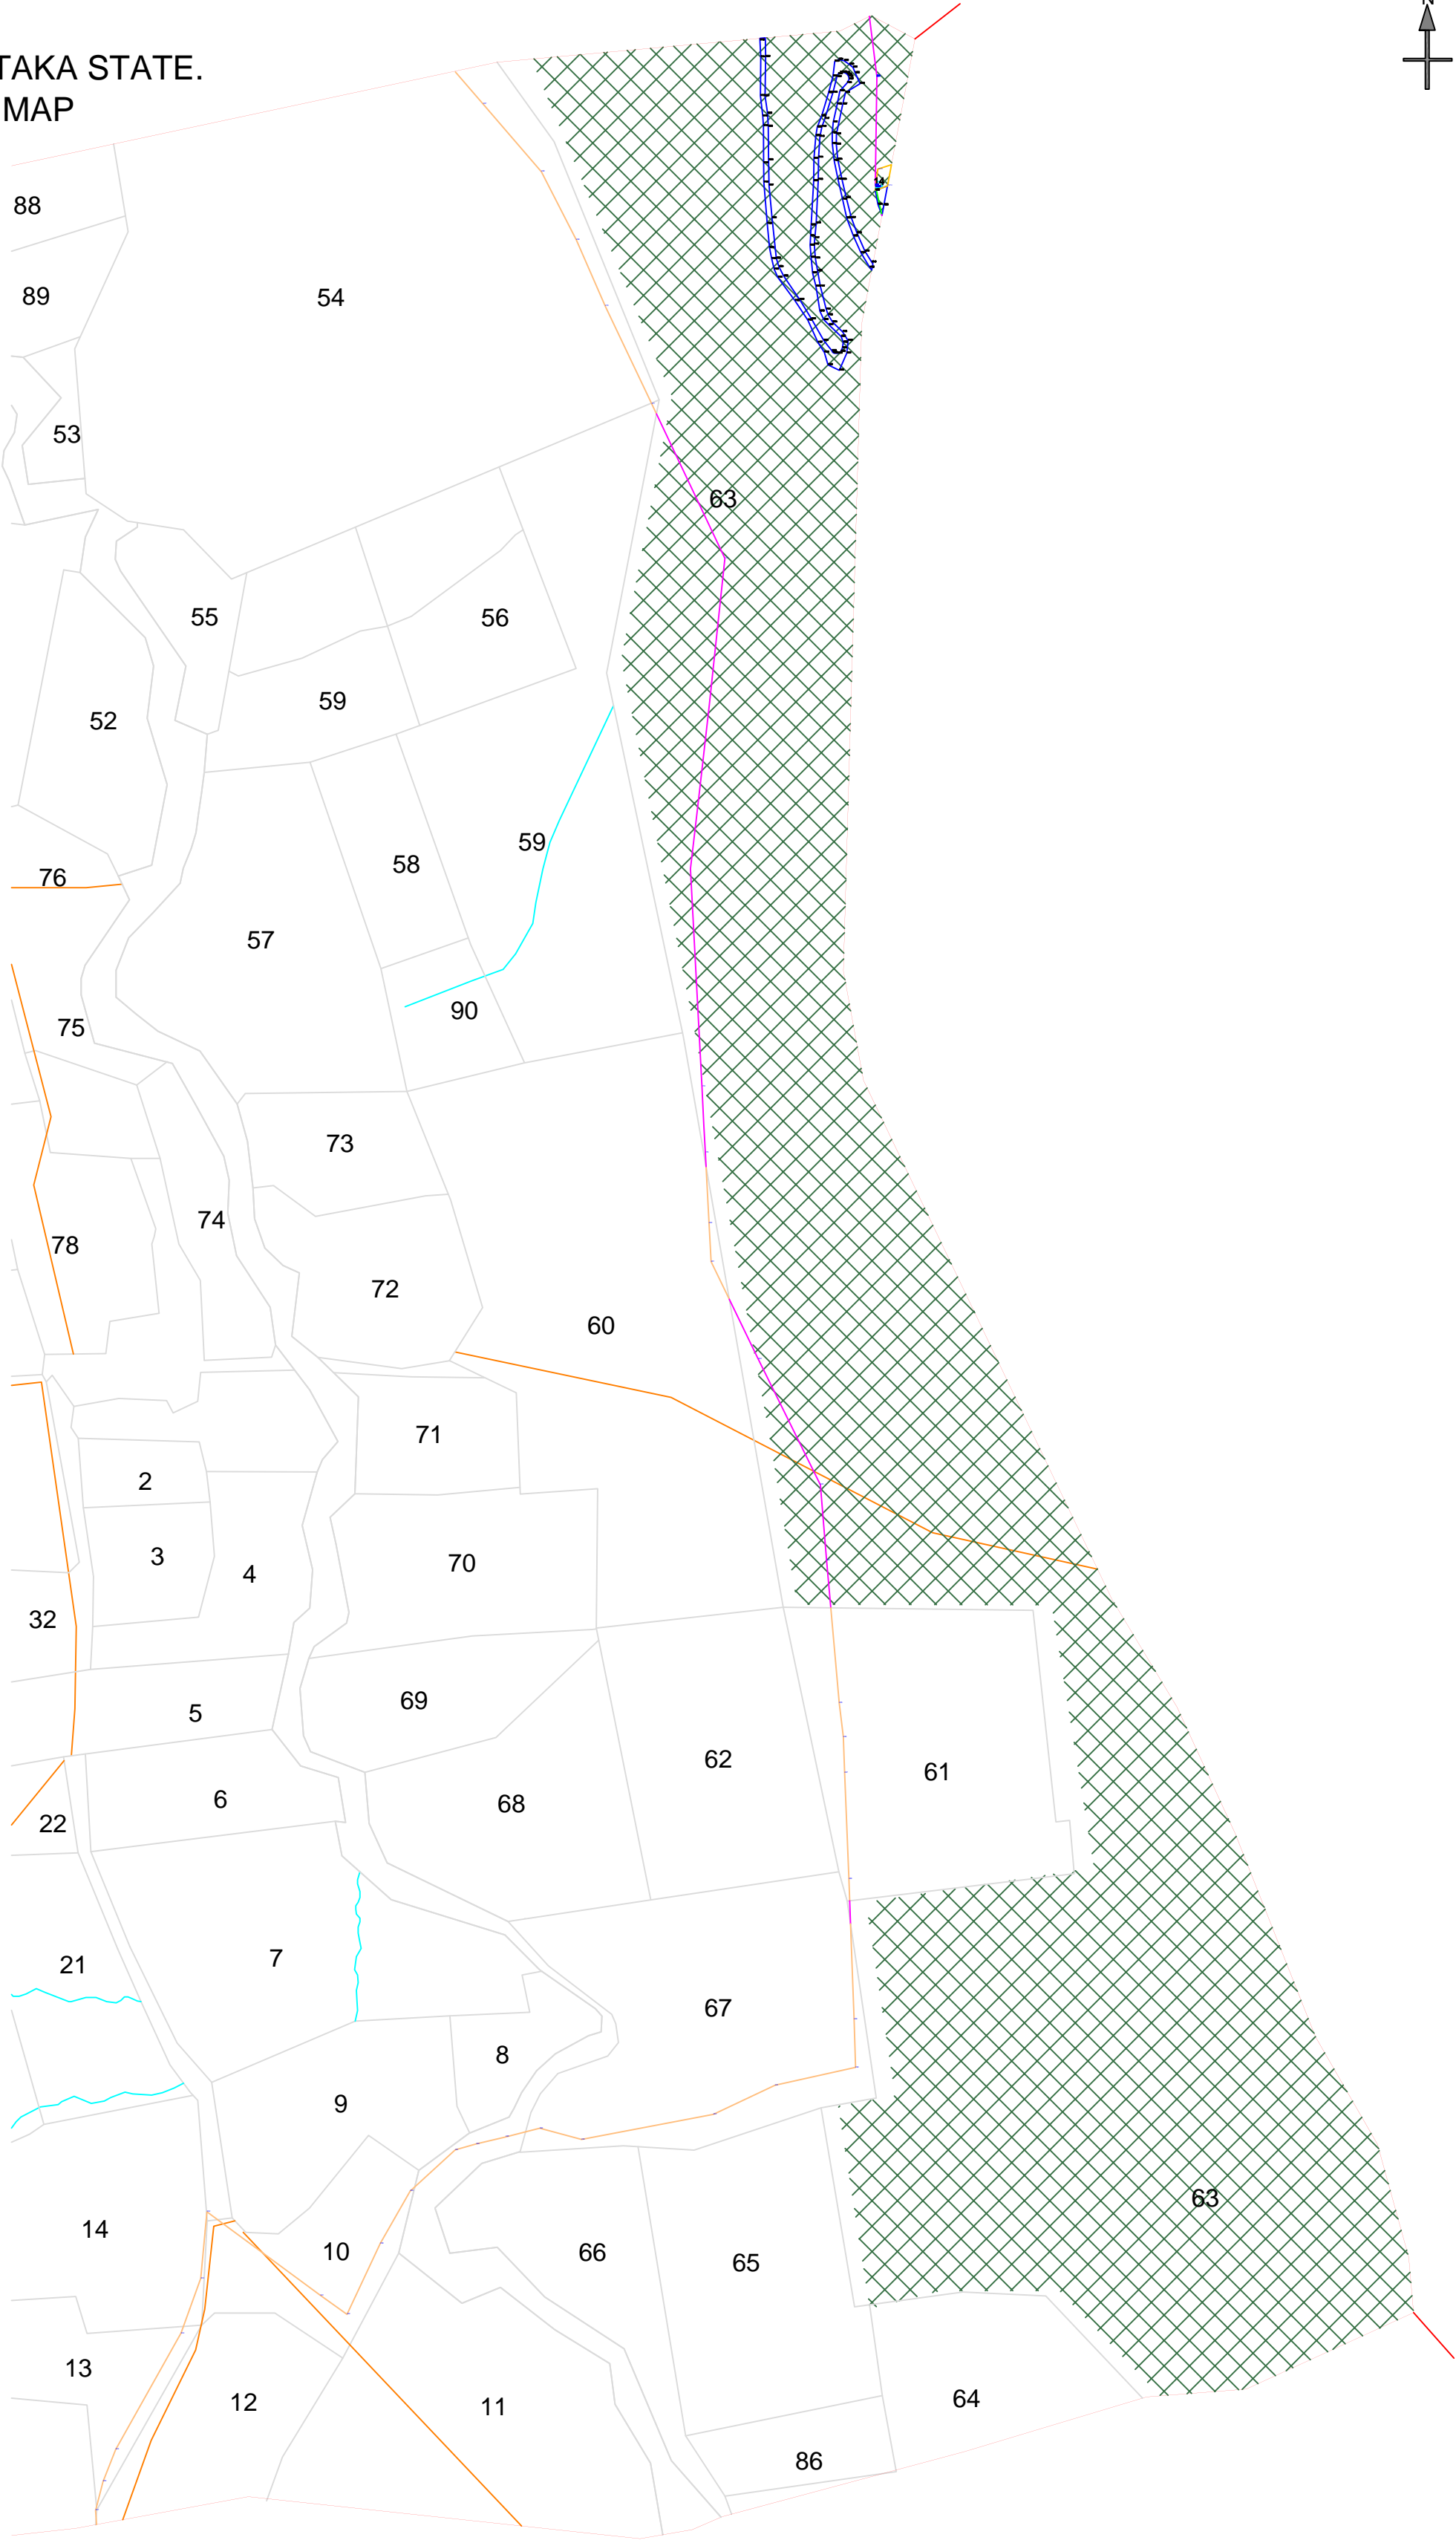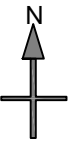

WIND POWER PROJECT
AT GOGUDDA SITE CHITRADURGA (DIST), KARNATAKA STATE.
AS BUILT SUPERIMPOSED ON CADASTRAL MAP AT GOGUDDA SITE GOWNAHALLI VILLAGE)


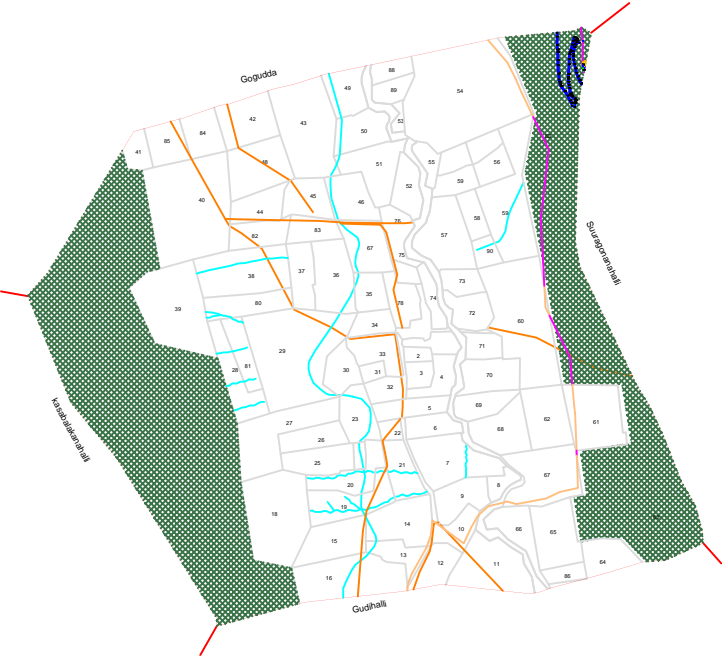


CADASTRAL MAP FEATURES	
FEATURE TYPE	LEGEND
	SURVEY BOUNDARY WITH NOS.
	ROAD
	STREAMS
	HILL

AS BUILT FEATURES	
FEATURE TYPE	LEGEND
	VILLAGE BOUNDARY
	AS BUILT ROAD
	NON FOREST ROAD
	AS BUILT ELECTRIC LINE
	NON FOREST ELECTRIC LINE
	AS BUILT VCB YARD
	NON FOREST VCB YARD
	AS BUILT PLATFORM AREA WITH NOS
	NON FOREST PLATFORM AREA WITH NOS
	NOS.FOR COORDINATES OF ROAD & EP LINE

WIND WORLD (INDIA) LTD — formerly known as —	
Scale:-	NTS
PROJECT:-	WIND POWER PROJECT AT GOGUDDA SITE CHITRADURGA (DIST) KARNATAKA STATE
TITLE:-	SCALED MAP FOR GOWNAHALLI VILLAGE
DRAWING NO.:-	KAR/GOGUDDA/1
	ASBUILT-1/1

WIND POWER PROJECT
AT GOGUDDA SITE CHITRADURGA (DIST), KARNATAKA STATE.
AS BUILT DRAWING SUPERIMPOSED ON CADASTRAL MAP
FOR VILLAGE HULITOTLU AT GOGUDDA SITE

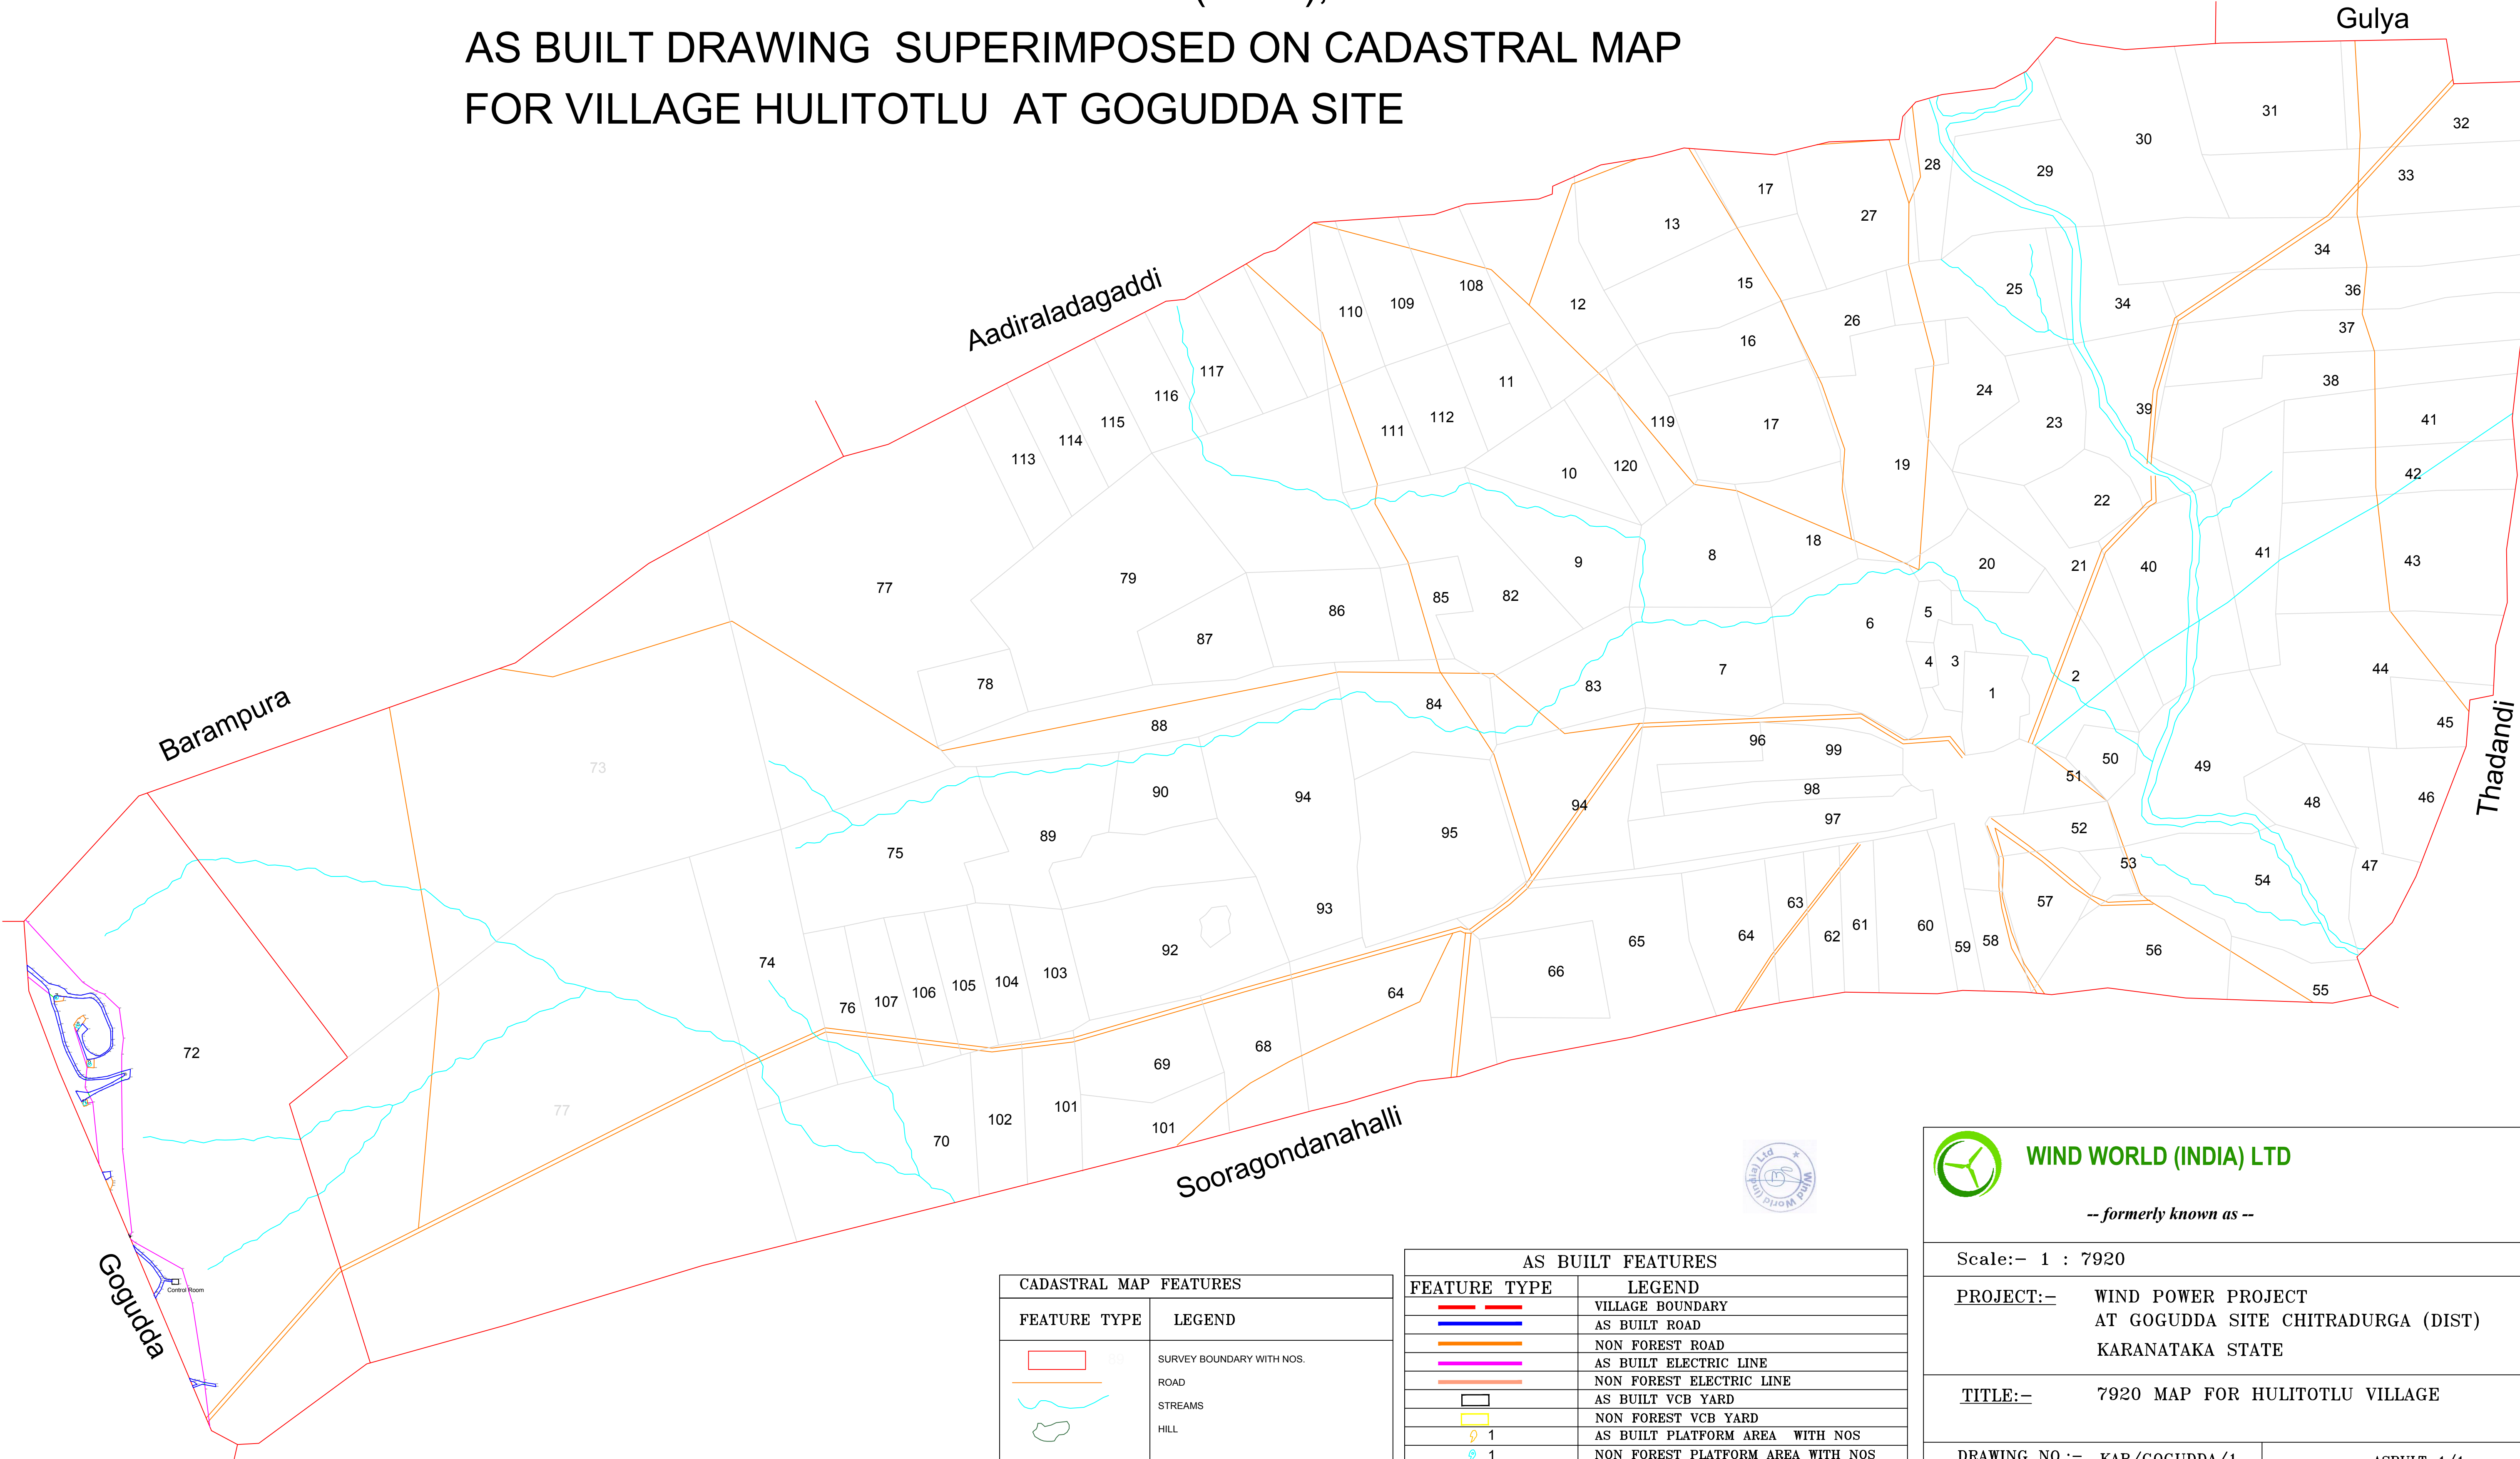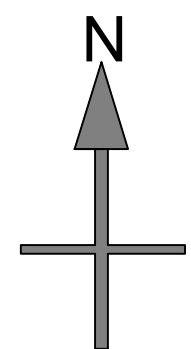

CADASTRAL MAP FEATURES	
FEATURE TYPE	LEGEND
	SURVEY BOUNDARY WITH NOS.
	ROAD
	STREAMS
	HILL

AS BUILT FEATURES	
FEATURE TYPE	LEGEND
	VILLAGE BOUNDARY
	AS BUILT ROAD
	NON FOREST ROAD
	AS BUILT ELECTRIC LINE
	NON FOREST ELECTRIC LINE
	AS BUILT VCB YARD
	NON FOREST VCB YARD
	AS BUILT PLATFORM AREA WITH NOS
	NON FOREST PLATFORM AREA WITH NOS
	NOS.FOR COORDINATES OF ROAD & EP LINE



WIND WORLD (INDIA) LTD

-- formerly known as --

Scale:- 1 : 7920



PROJECT:- WIND POWER PROJECT
AT GOGUDDA SITE CHITRADURGA (DIST)
KARNATAKA STATE

TITLE:- 7920 MAP FOR HULITOTLU VILLAGE


DRAWING NO.:- KAR/GOGUDDA/1

ASBULT-1/1

WIND POWER PROJECT
AT GOGUDDA SITE CHITRADURGA (DIST), KARNATAKA STATE.
AS BUILT DRAWING SUPERIMPOSED ON SCALED MAP
FOR VILLAGE HULITOTLU AT GOGUDDA SITE

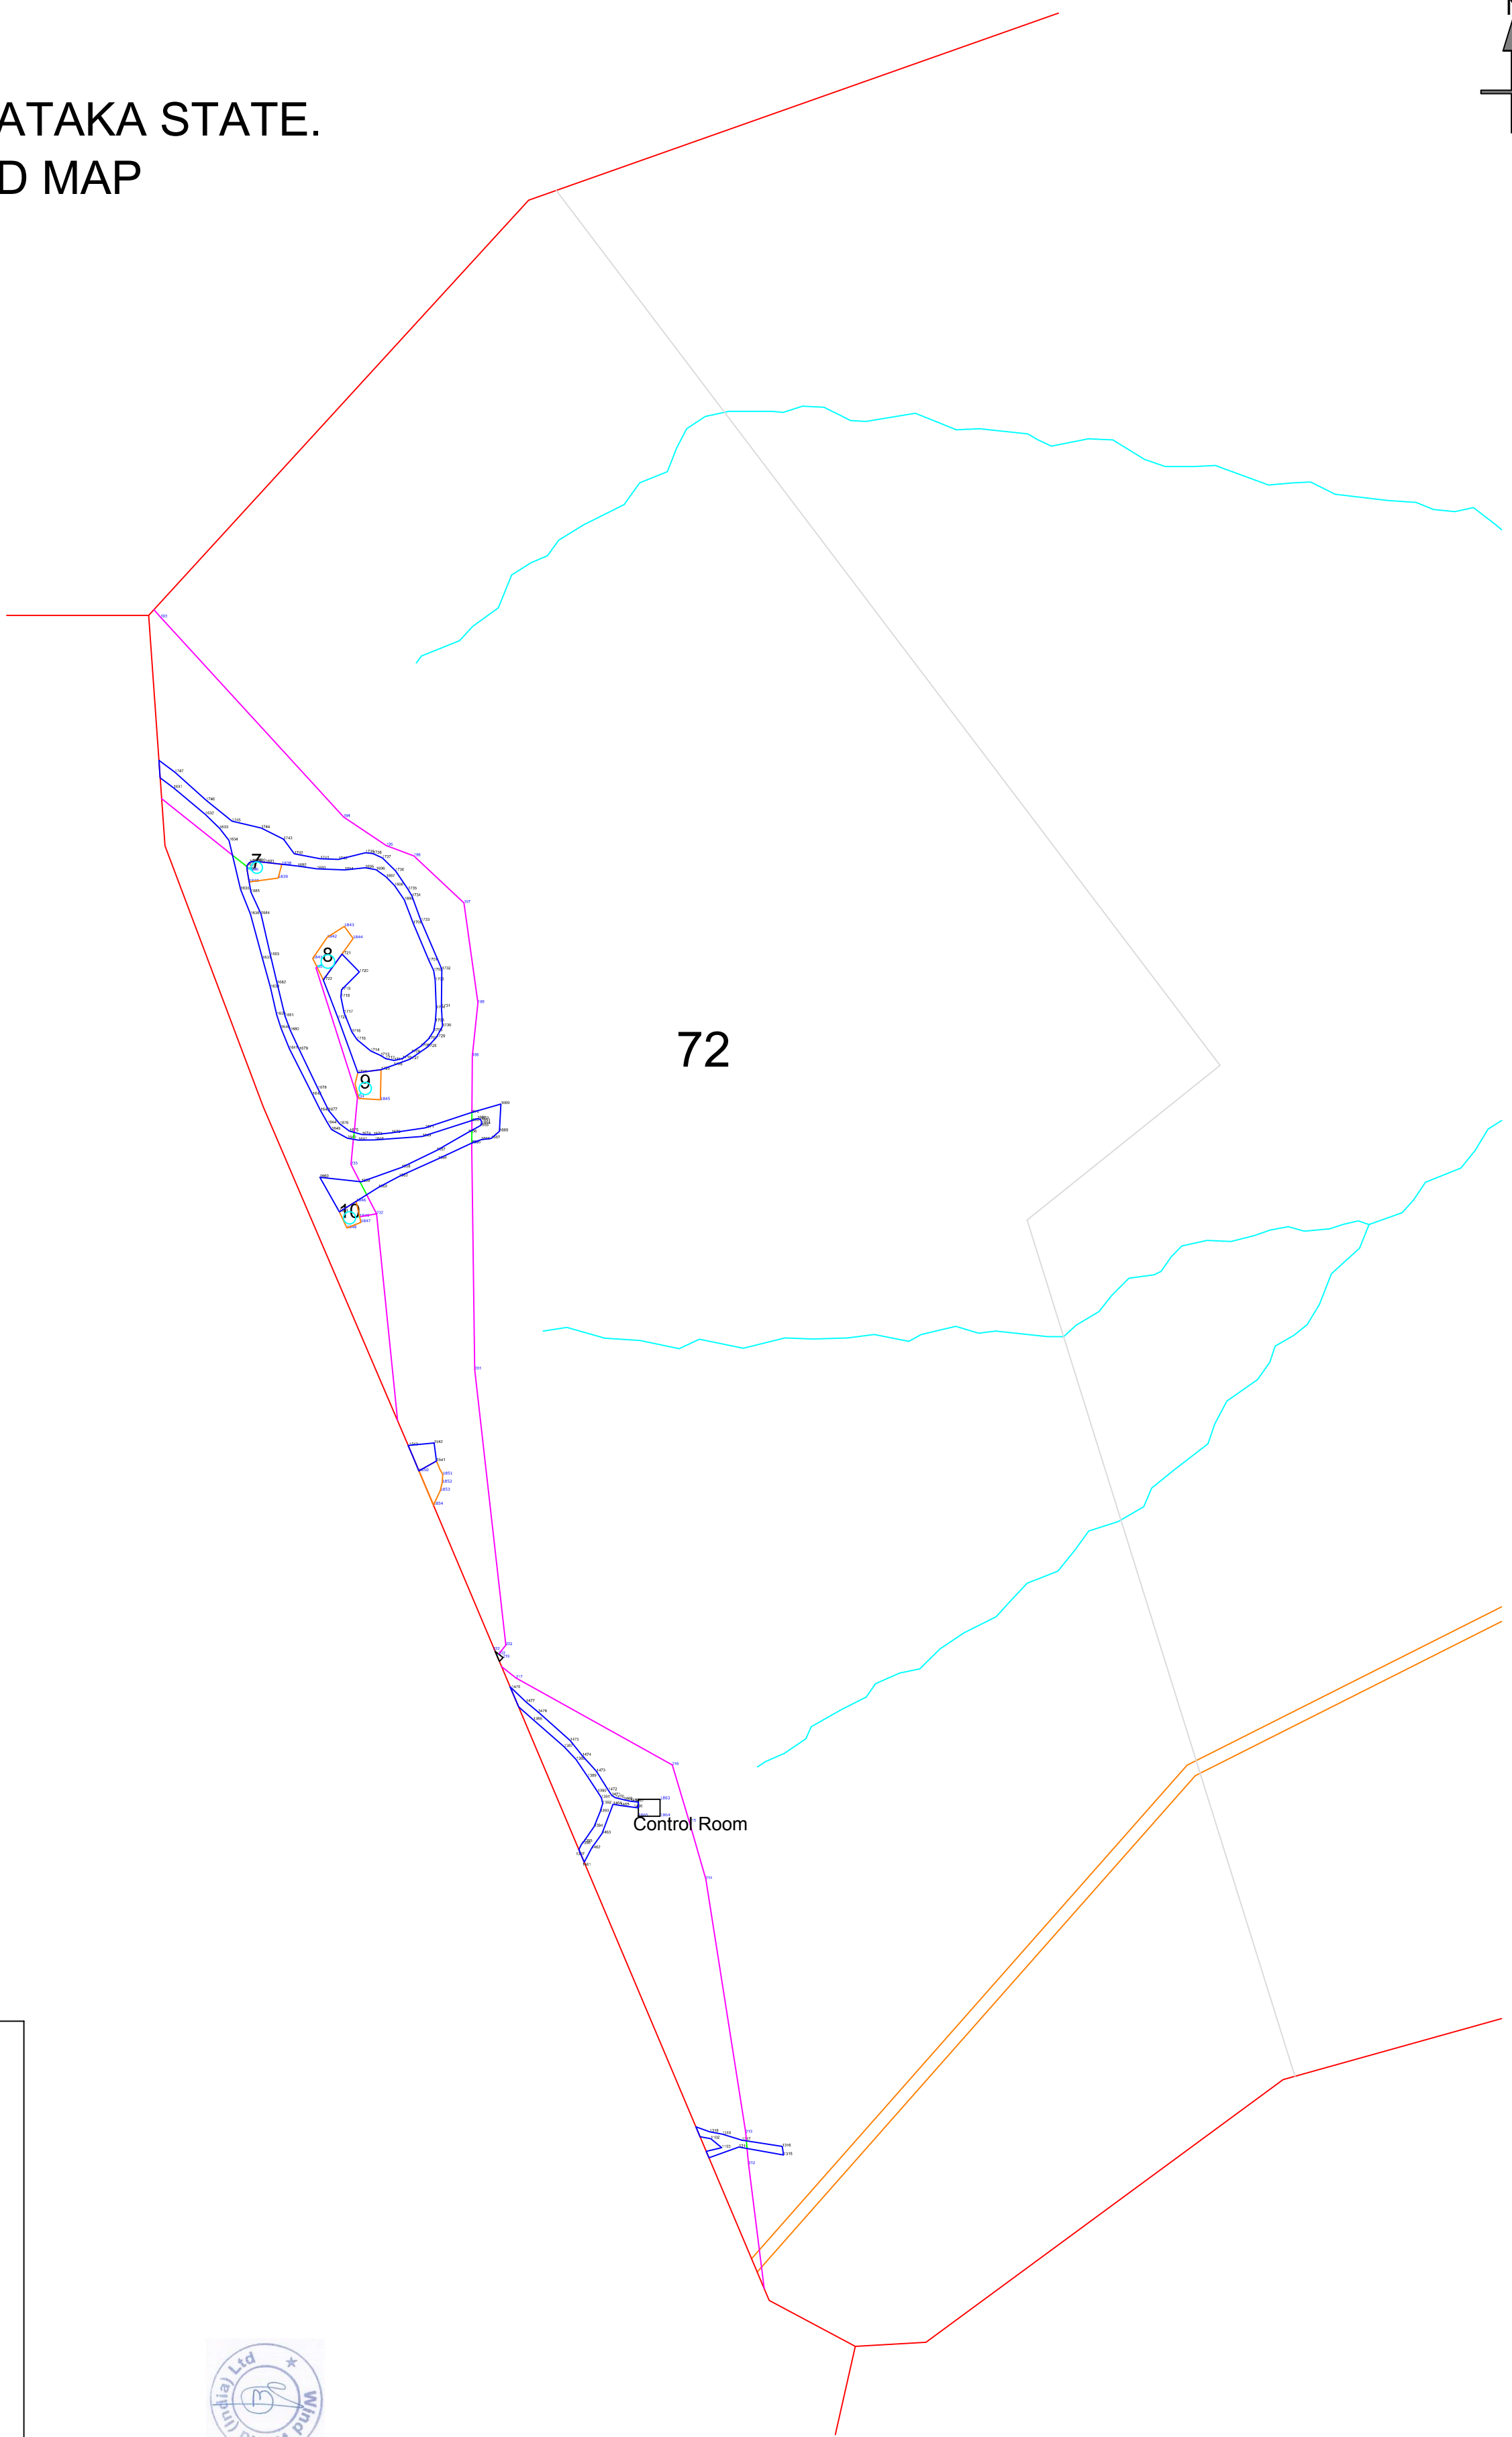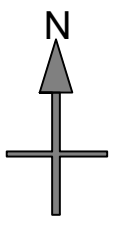


WIND POWER PROJECT
AT GOGUDDA SITE CHITRADURGA (DIST), KARNATAKA STATE.
AS BUILT SUPERIMPOSED ON CADASTRAL MAP AT GOGUDDA SITE (HULITOTLU VILLAGE)

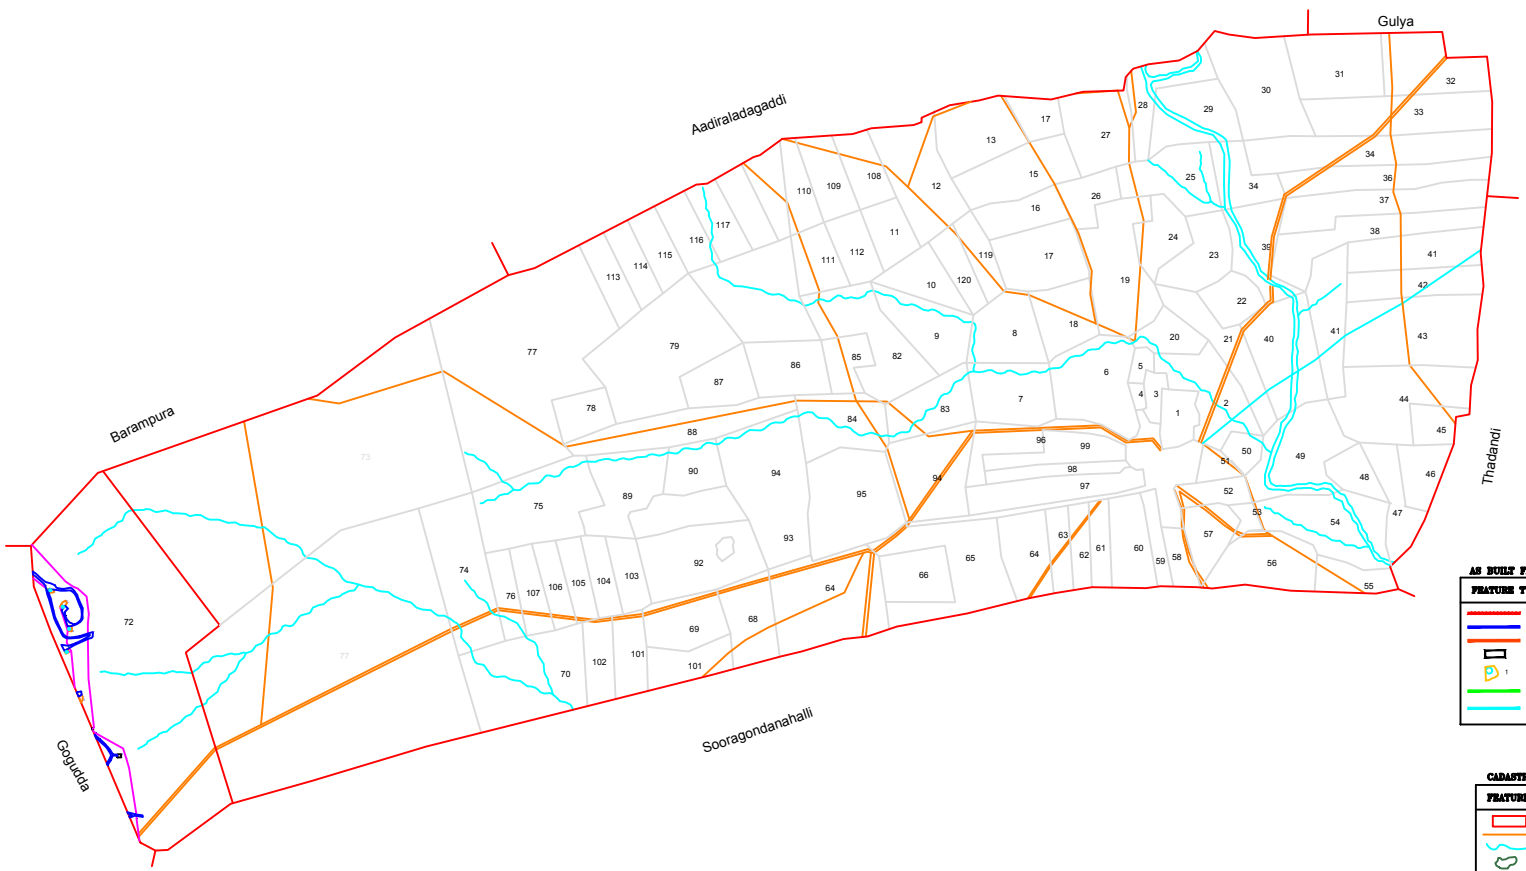

AS BUILT FEATURES	
FEATURE TYPE	LEGEND
AS BUILT ROAD	AS BUILT ROAD
AS BUILT ELECTRIC LINE	AS BUILT ELECTRIC LINE
AS BUILT YCB YARD	AS BUILT YCB YARD
AS BUILT PLATFORM AREA WITH NOS	AS BUILT PLATFORM AREA WITH NOS
AS BUILT PLATFORM AREA WITH NOS	AS BUILT PLATFORM AREA WITH NOS
NOS.FOR COORDINATES OF ROAD & EP LINE	NOS.FOR COORDINATES OF ROAD & EP LINE

CADASTRAL MAP FEATURES	
FEATURE TYPE	LEGEND
89	SURVEY BOUNDARY WITH NOS.
ROAD	ROAD
STREAMS	STREAMS
HILL	HILL

AS BUILT FEATURES	
FEATURE TYPE	LEGEND
VILLAGE BOUNDARY	VILLAGE BOUNDARY
AS BUILT ROAD	AS BUILT ROAD
NON FOREST ROAD	NON FOREST ROAD
AS BUILT ELECTRIC LINE	AS BUILT ELECTRIC LINE
NON FOREST ELECTRIC LINE	NON FOREST ELECTRIC LINE
AS BUILT YCB YARD	AS BUILT YCB YARD
NON FOREST YCB YARD	NON FOREST YCB YARD
AS BUILT PLATFORM AREA WITH NOS	AS BUILT PLATFORM AREA WITH NOS
NON FOREST PLATFORM AREA WITH NOS	NON FOREST PLATFORM AREA WITH NOS
NOS.FOR COORDINATES OF ROAD & EP LINE	NOS.FOR COORDINATES OF ROAD & EP LINE

**WIND WORLD (INDIA) LTD**
— formerly known as —

Scale:- NTS



PROJECT:- WIND POWER PROJECT
AT GOGUDDA SITE CHITRADURGA (DIST)
KARNATAKA STATE

TITLE:- SCALED MAP FOR HULITOTLU VILLAGE

DRAWING NO.:- KAR/GOGUDDA/1


ASBUILT-1/1

WIND POWER PROJECT
AT GOGUDDA SITE CHITRADURGA (DIST), KARNATAKA STATE.
AS BUILT DRAWING SUPERIMPOSED ON CADASTRAL MAP
FOR VILLAGE GUDIHAL AT GOGUDDA SITE

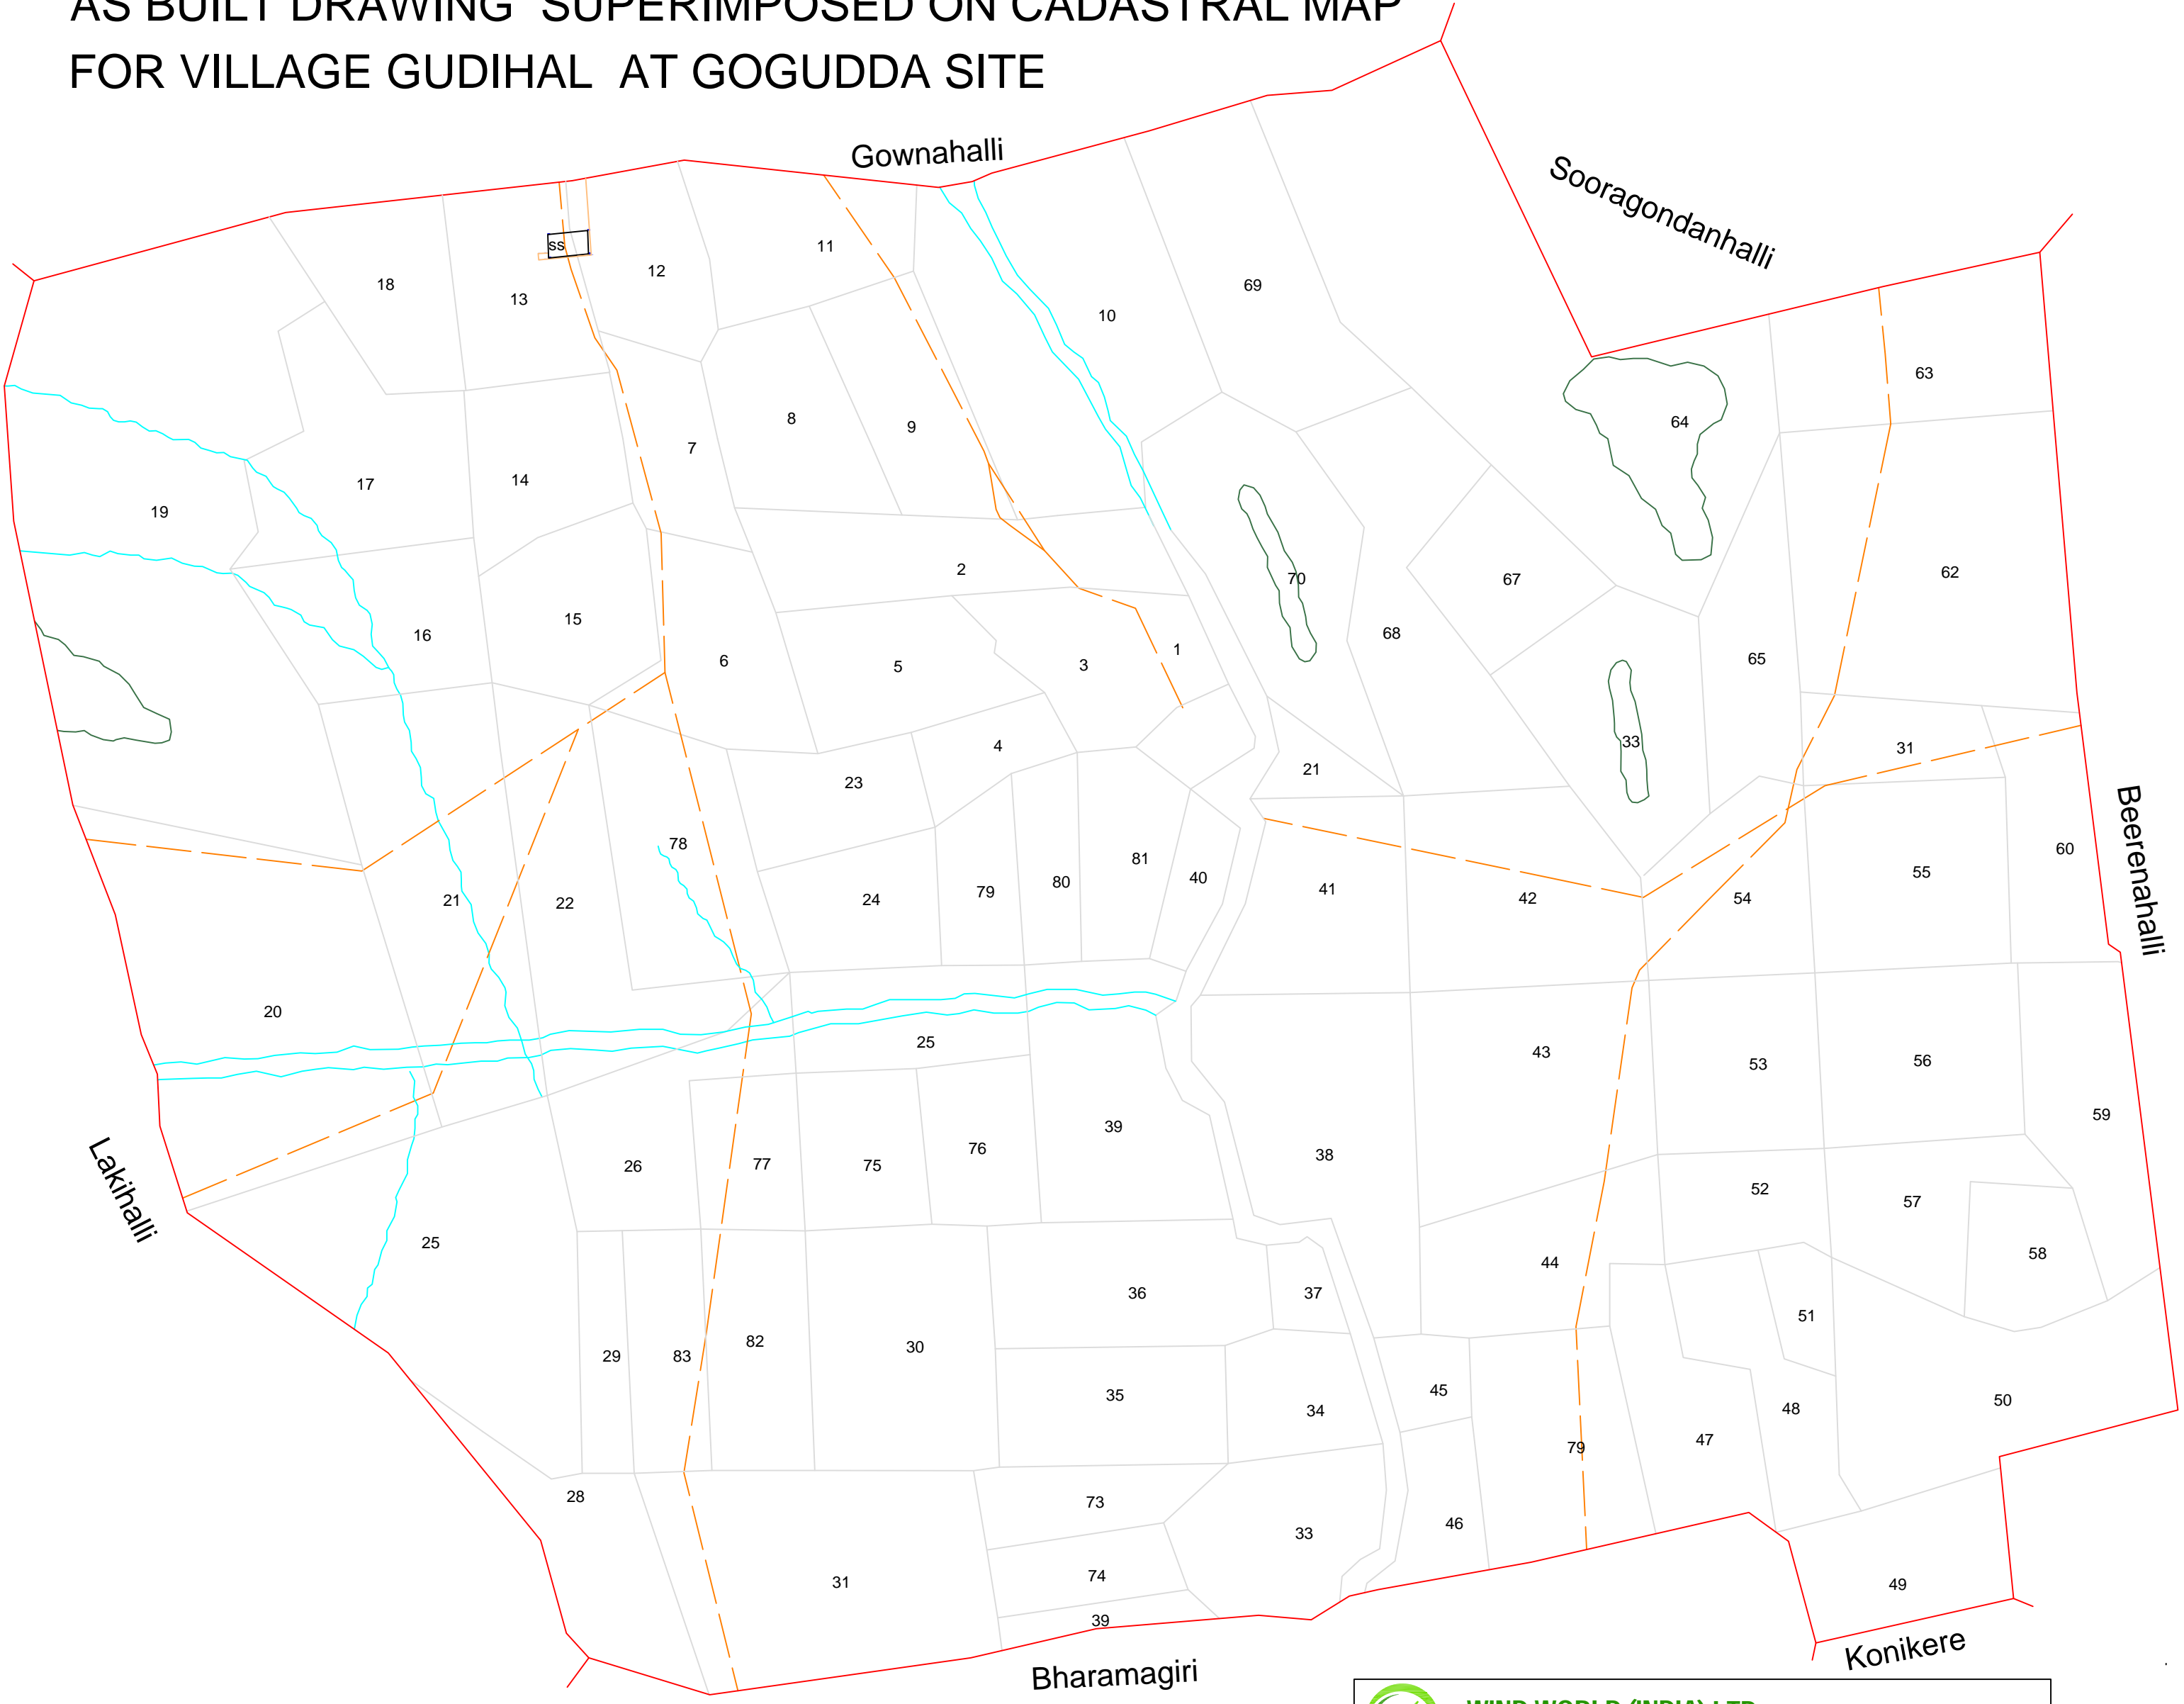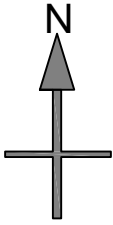

CADASTRAL MAP FEATURES	
FEATURE TYPE	LEGEND
	SURVEY BOUNDARY WITH NOS.
	ROAD
	STREAMS
	HILL

AS BUILT FEATURES	
FEATURE TYPE	LEGEND
	VILLAGE BOUNDARY
	AS BUILT ROAD
	NON FOREST ROAD
	AS BUILT ELECTRIC LINE
	NON FOREST ELECTRIC LINE
	AS BUILT VCB YARD
	NON FOREST VCB YARD
	AS BUILT PLATFORM AREA WITH NOS
	NON FOREST PLATFORM AREA WITH NOS
	NOS.FOR COORDINATES OF ROAD & EP LINE



WIND WORLD (INDIA) LTD
-- formerly known as --

Scale:- 1 : 7920

PROJECT:-

WIND POWER PROJECT
AT GOGUDDA SITE CHITRADURGA (DIST)
KARNATAKA STATE

TITLE:-




7920 MAP FOR GUDIHAL VILLAGE




 
DRAWING NO.:-




 


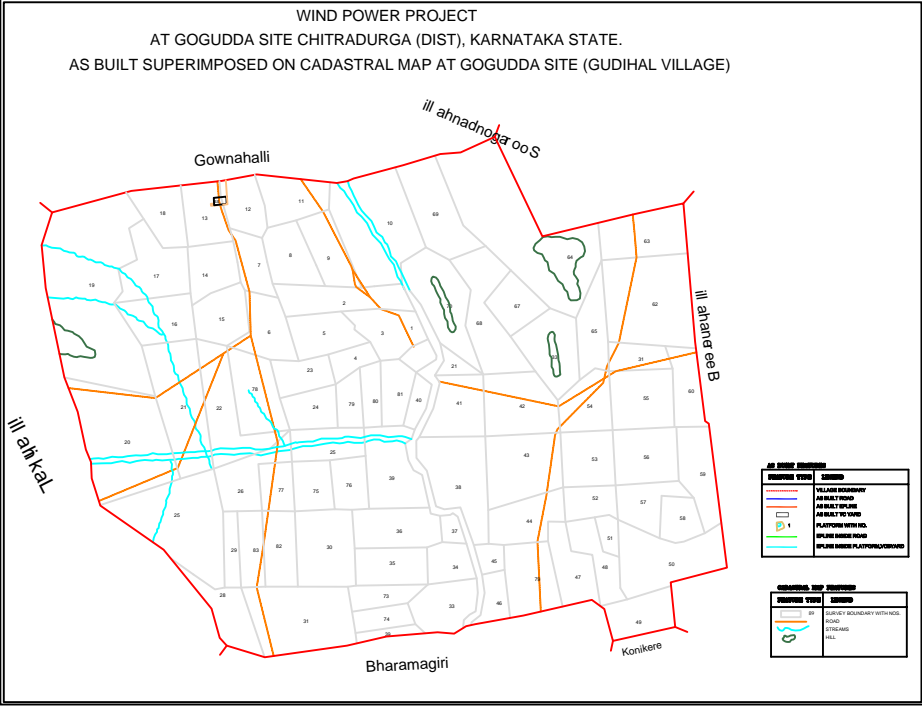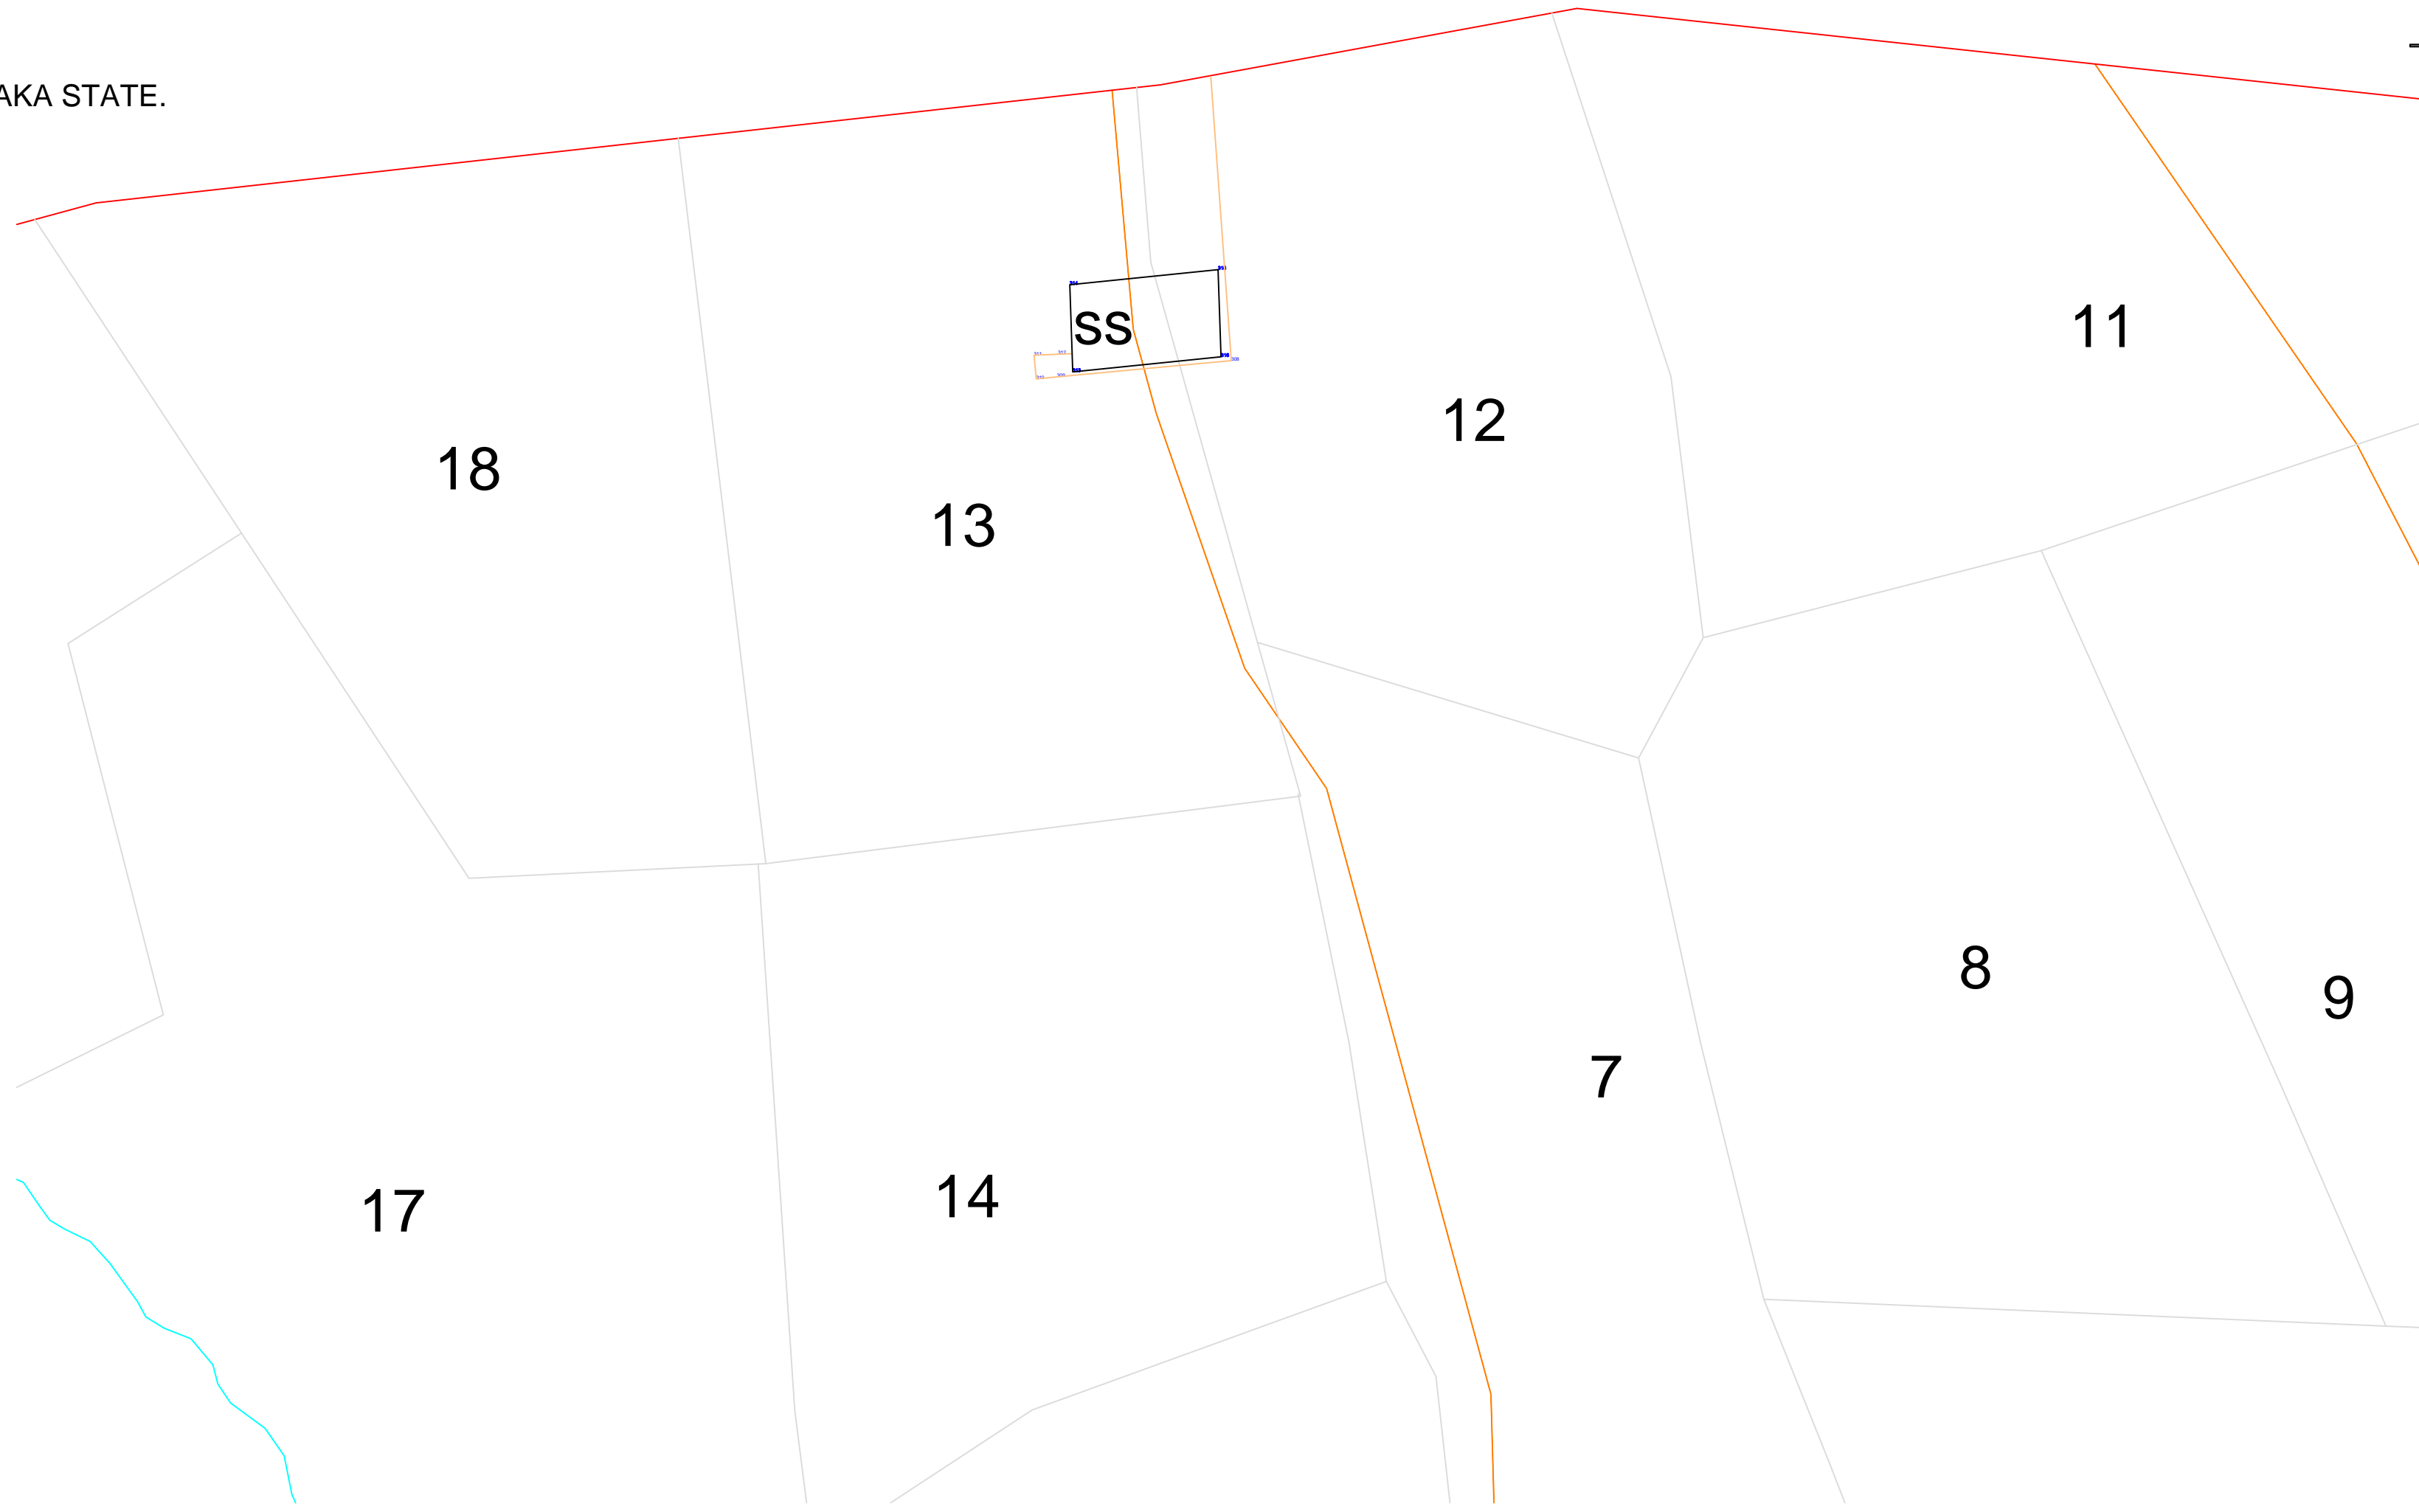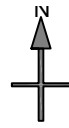



KAR/GOGUDDA/1


ASBULT-1/1

AS BUILT DRAWING SUPERIMPOSED ON SCALED MAP
FOR WIND POWER PROJECT AT GOGUDDA SITE CHITRADURGA (DIST), KARNATAKA STATE.



CADASTRAL MAP FEATURES	
FEATURE TYPE	LEGEND
	89 SURVEY BOUNDARY WITH NOS.
	ROAD
	STREAMS
	HILL

AS BUILT FEATURES	
FEATURE TYPE	LEGEND
	VILLAGE BOUNDARY
	AS BUILT ROAD
	NON FOREST ROAD
	AS BUILT ELECTRIC LINE
	NON FOREST ELECTRIC LINE
	AS BUILT YCB YARD
	NON FOREST YCB YARD
	AS BUILT PLATFORM AREA WITH NOS
	NON FOREST PLATFORM AREA WITH NOS
	NOS.FOR COORDINATES OF ROAD & RP LINE

**WIND WORLD (INDIA) LTD**
— formerly known as —

Scale:- NTS

PROJECT:- WIND POWER PROJECT
AT GOGUDDA SITE CHITRADURGA (DIST)
KARNATAKA STATE

TITLE:- SCALED MAP FOR GUDIHAI VILLAGE

DRAWING NO.:- KAR/GOGUDDA/1



ASHEET-1/1

WIND POWER PROJECT

AT GOGUDDA SITE CHITRADURGA (DIST), KARNATAKA STATE.


AS BUILT DRAWING SUPERIMPOSED ON CADASTRAL MAP

FOR VILLAGE SOORAGONDANAHALLI AT GOGUDDA SITE

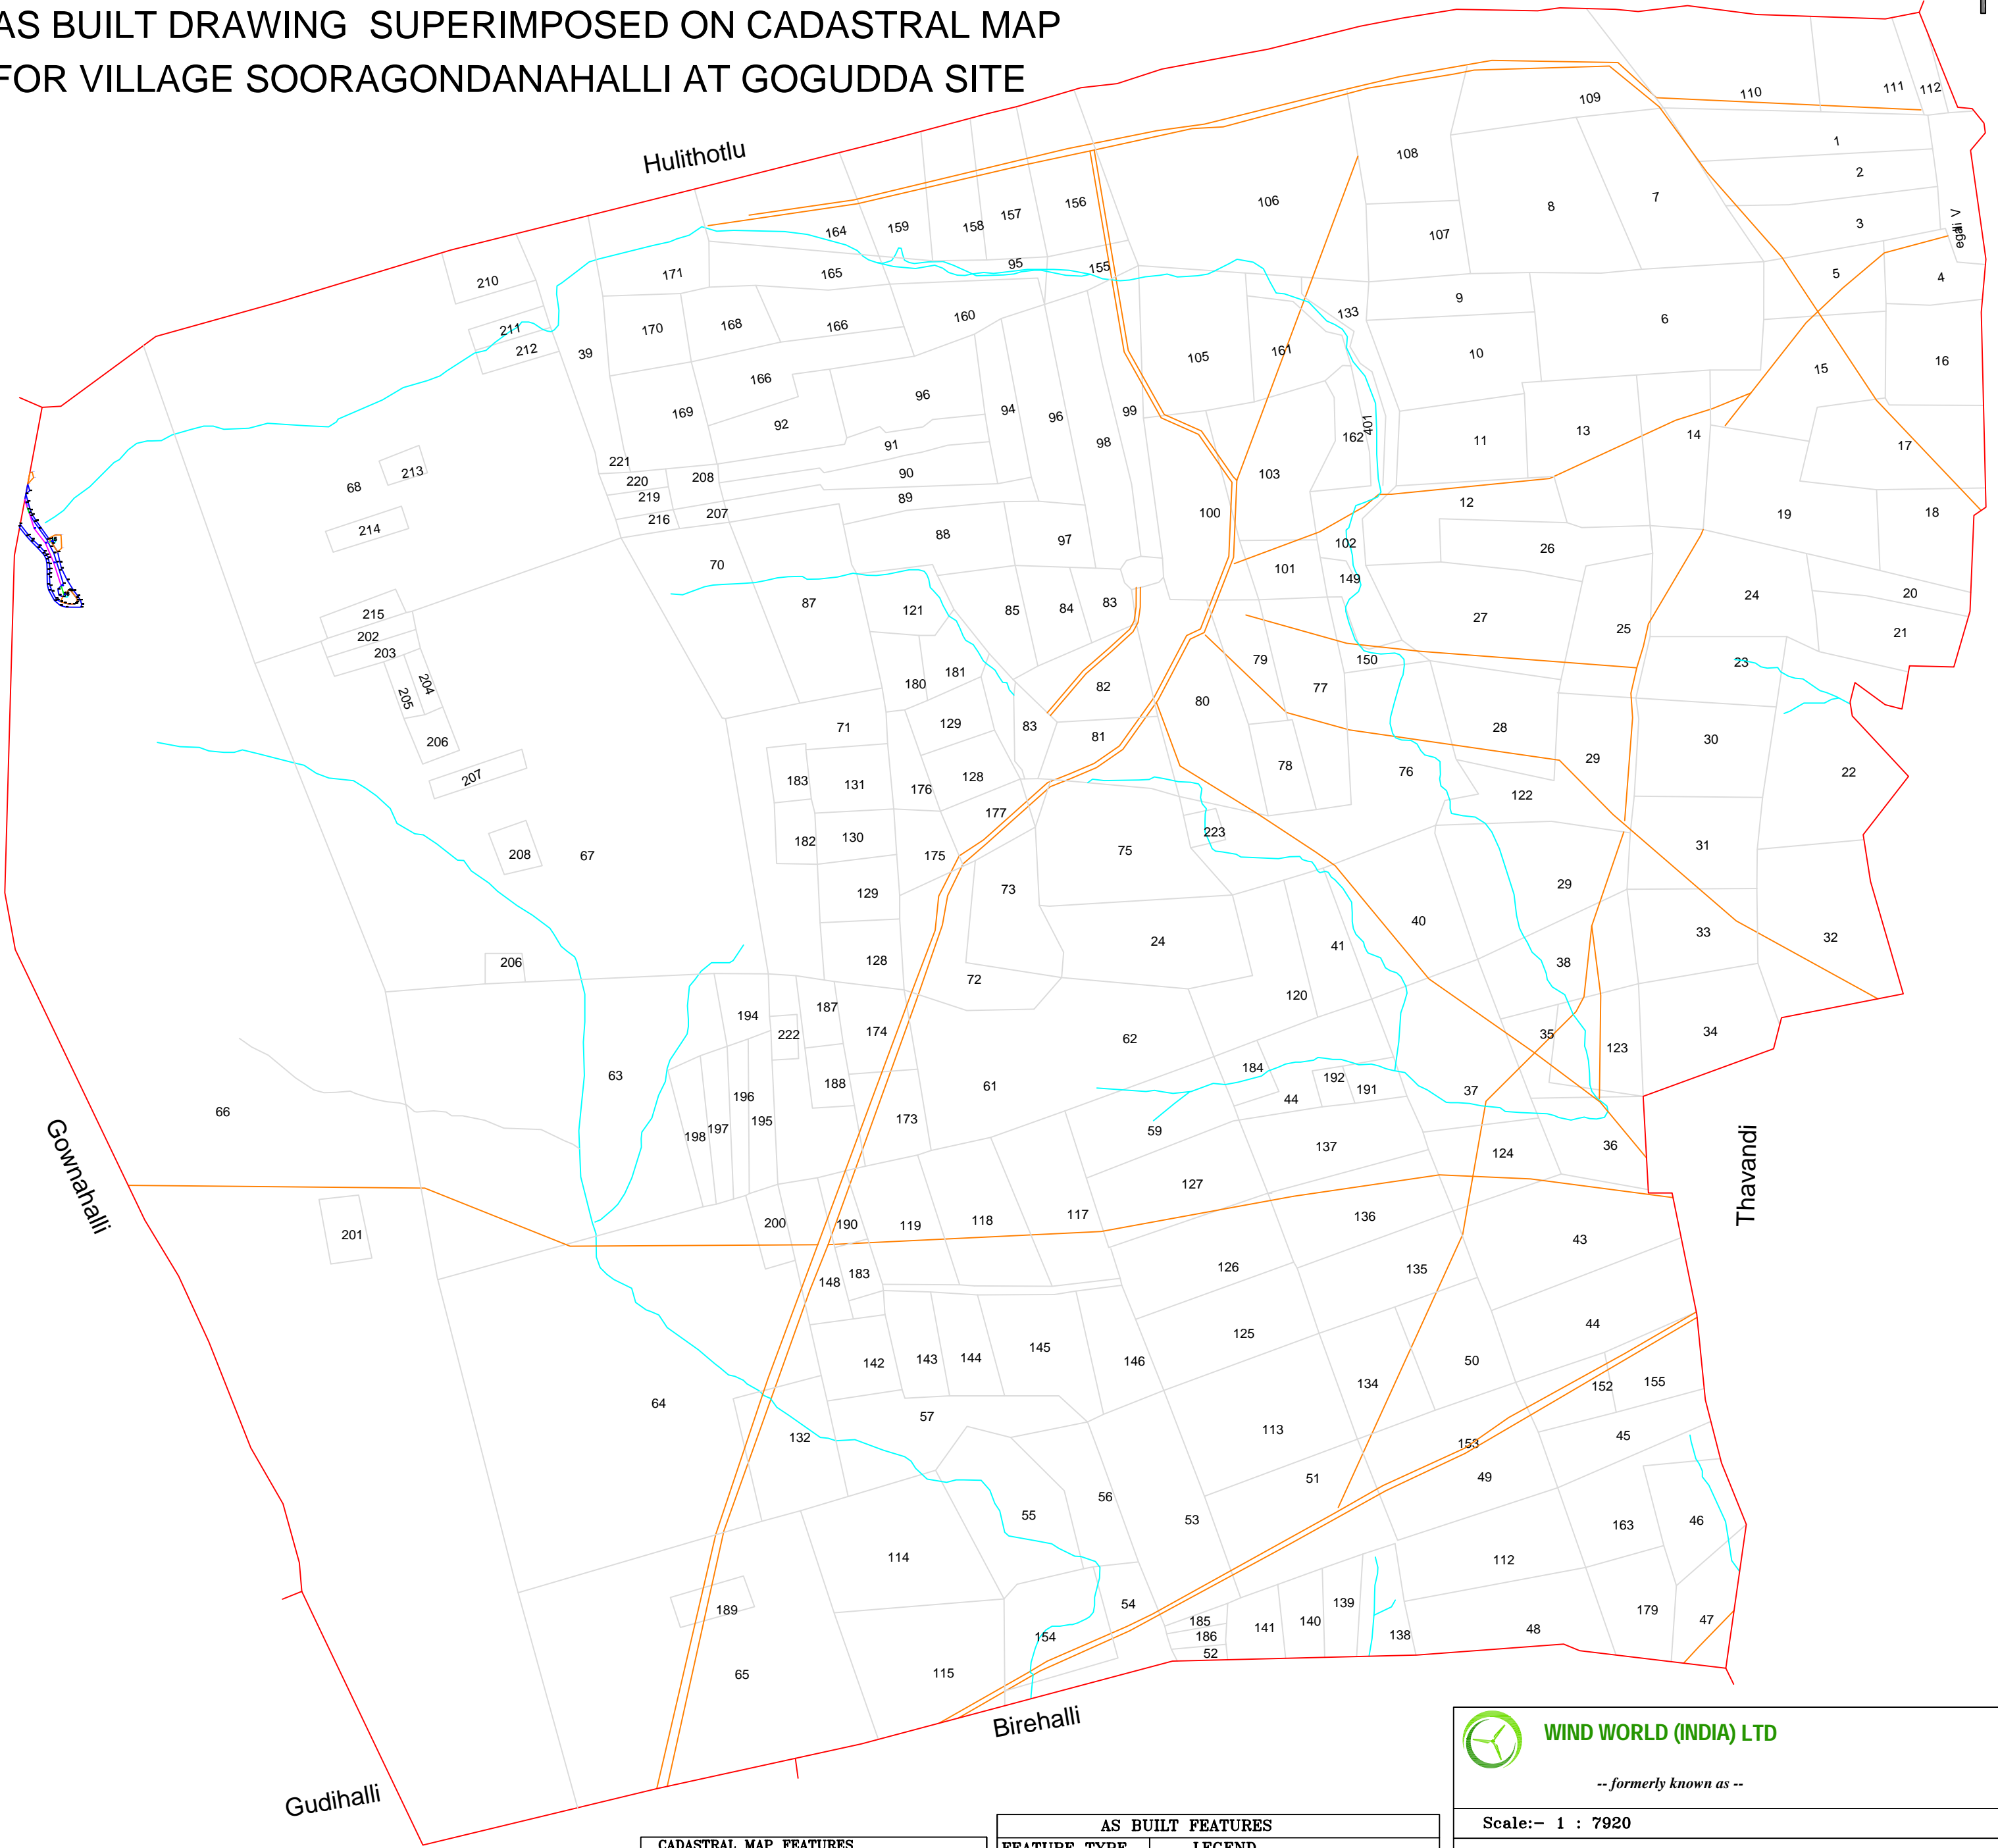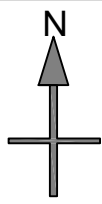

CADASTRAL MAP FEATURES	
FEATURE TYPE	LEGEND
	SURVEY BOUNDARY WITH NOS.
	ROAD
	STREAMS
	HILL

AS BUILT FEATURES	
FEATURE TYPE	LEGEND
	VILLAGE BOUNDARY
	AS BUILT ROAD
	NON FOREST ROAD
	AS BUILT ELECTRIC LINE
	NON FOREST ELECTRIC LINE
	AS BUILT VCB YARD
	NON FOREST VCB YARD
	AS BUILT PLATFORM AREA WITH NOS
	NON FOREST PLATFORM AREA WITH NOS
	NOS.FOR COORDINATES OF ROAD & EP LINE



WIND WORLD (INDIA) LTD
-- formerly known as --

Scale:- 1 : 7920




PROJECT:- WIND POWER PROJECT
AT GOGUDDA SITE CHITRADURGA (DIST)
KARNATAKA STATE

TITLE:- 7920 MAP FOR SOORAGONDANAHALLI VILLAGE

DRAWING NO.:- KAR/GOGUDDA/1


ASBULT-1/1

WIND POWER PROJECT
AT GOGUDDA SITE CHITRADURGA (DIST), KARNATAKA STATE.
AS BUILT DRAWING SUPERIMPOSED ON SCALED MAP
FOR VILLAGE SOORAGONDANAHALLI AT GOGUDDA SITE

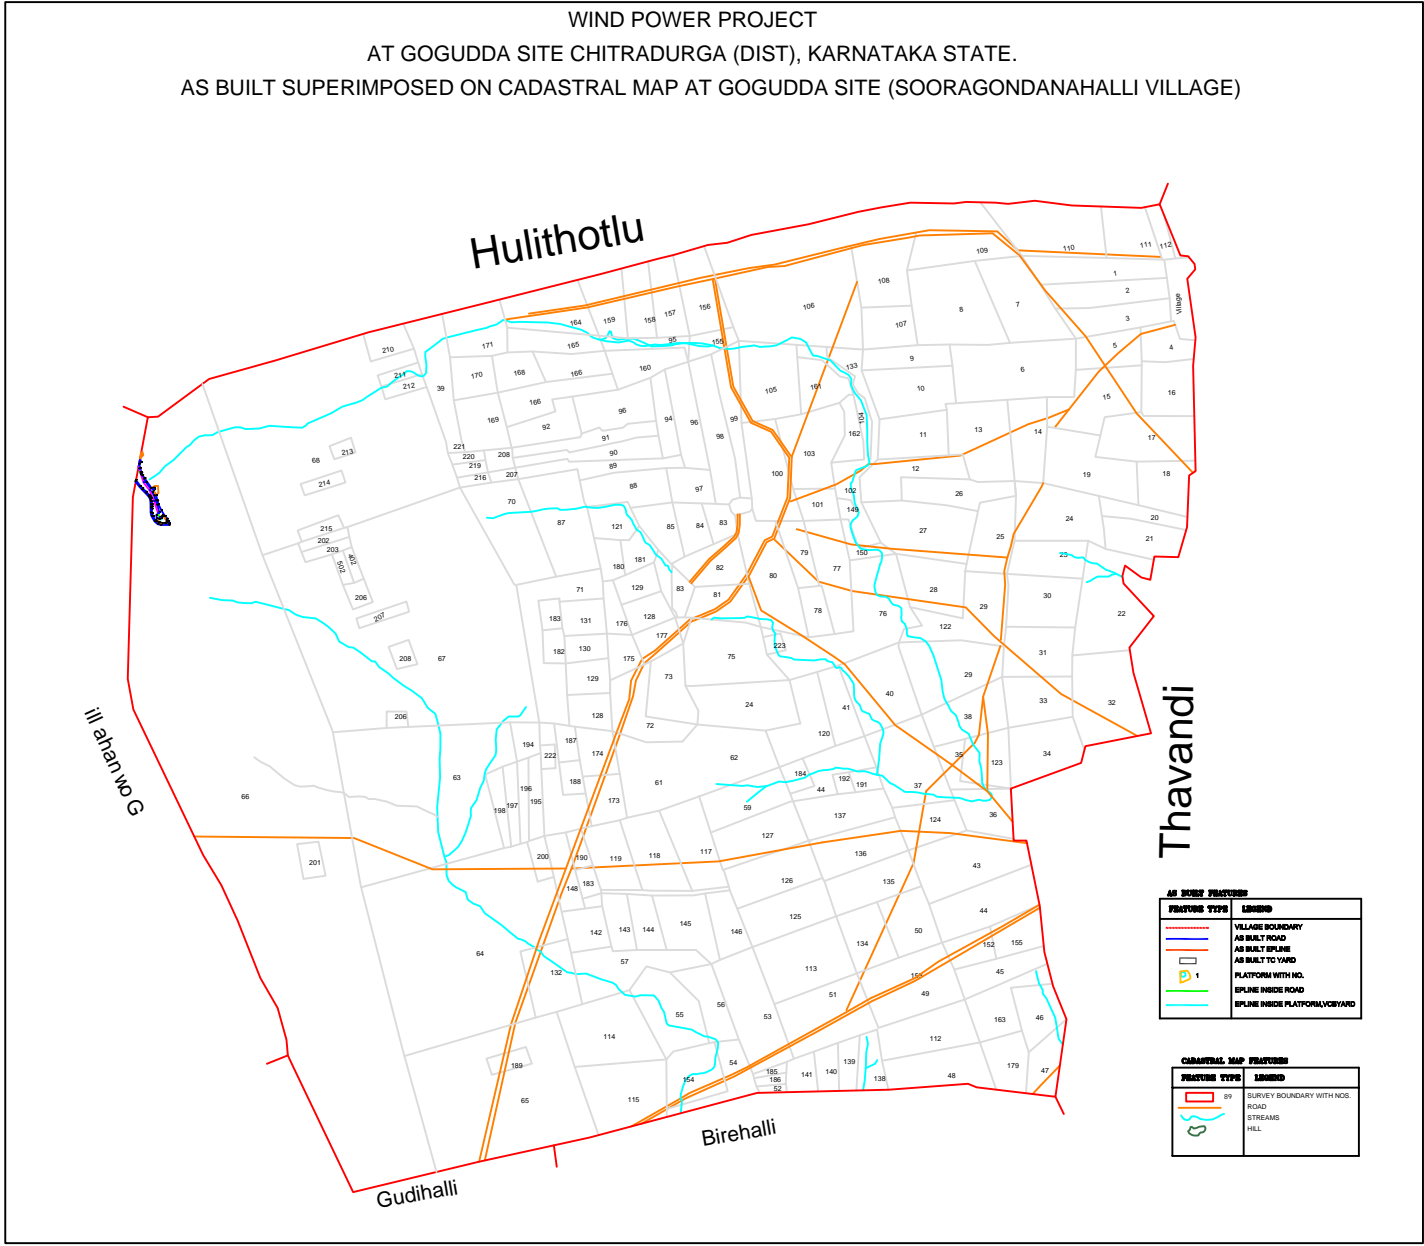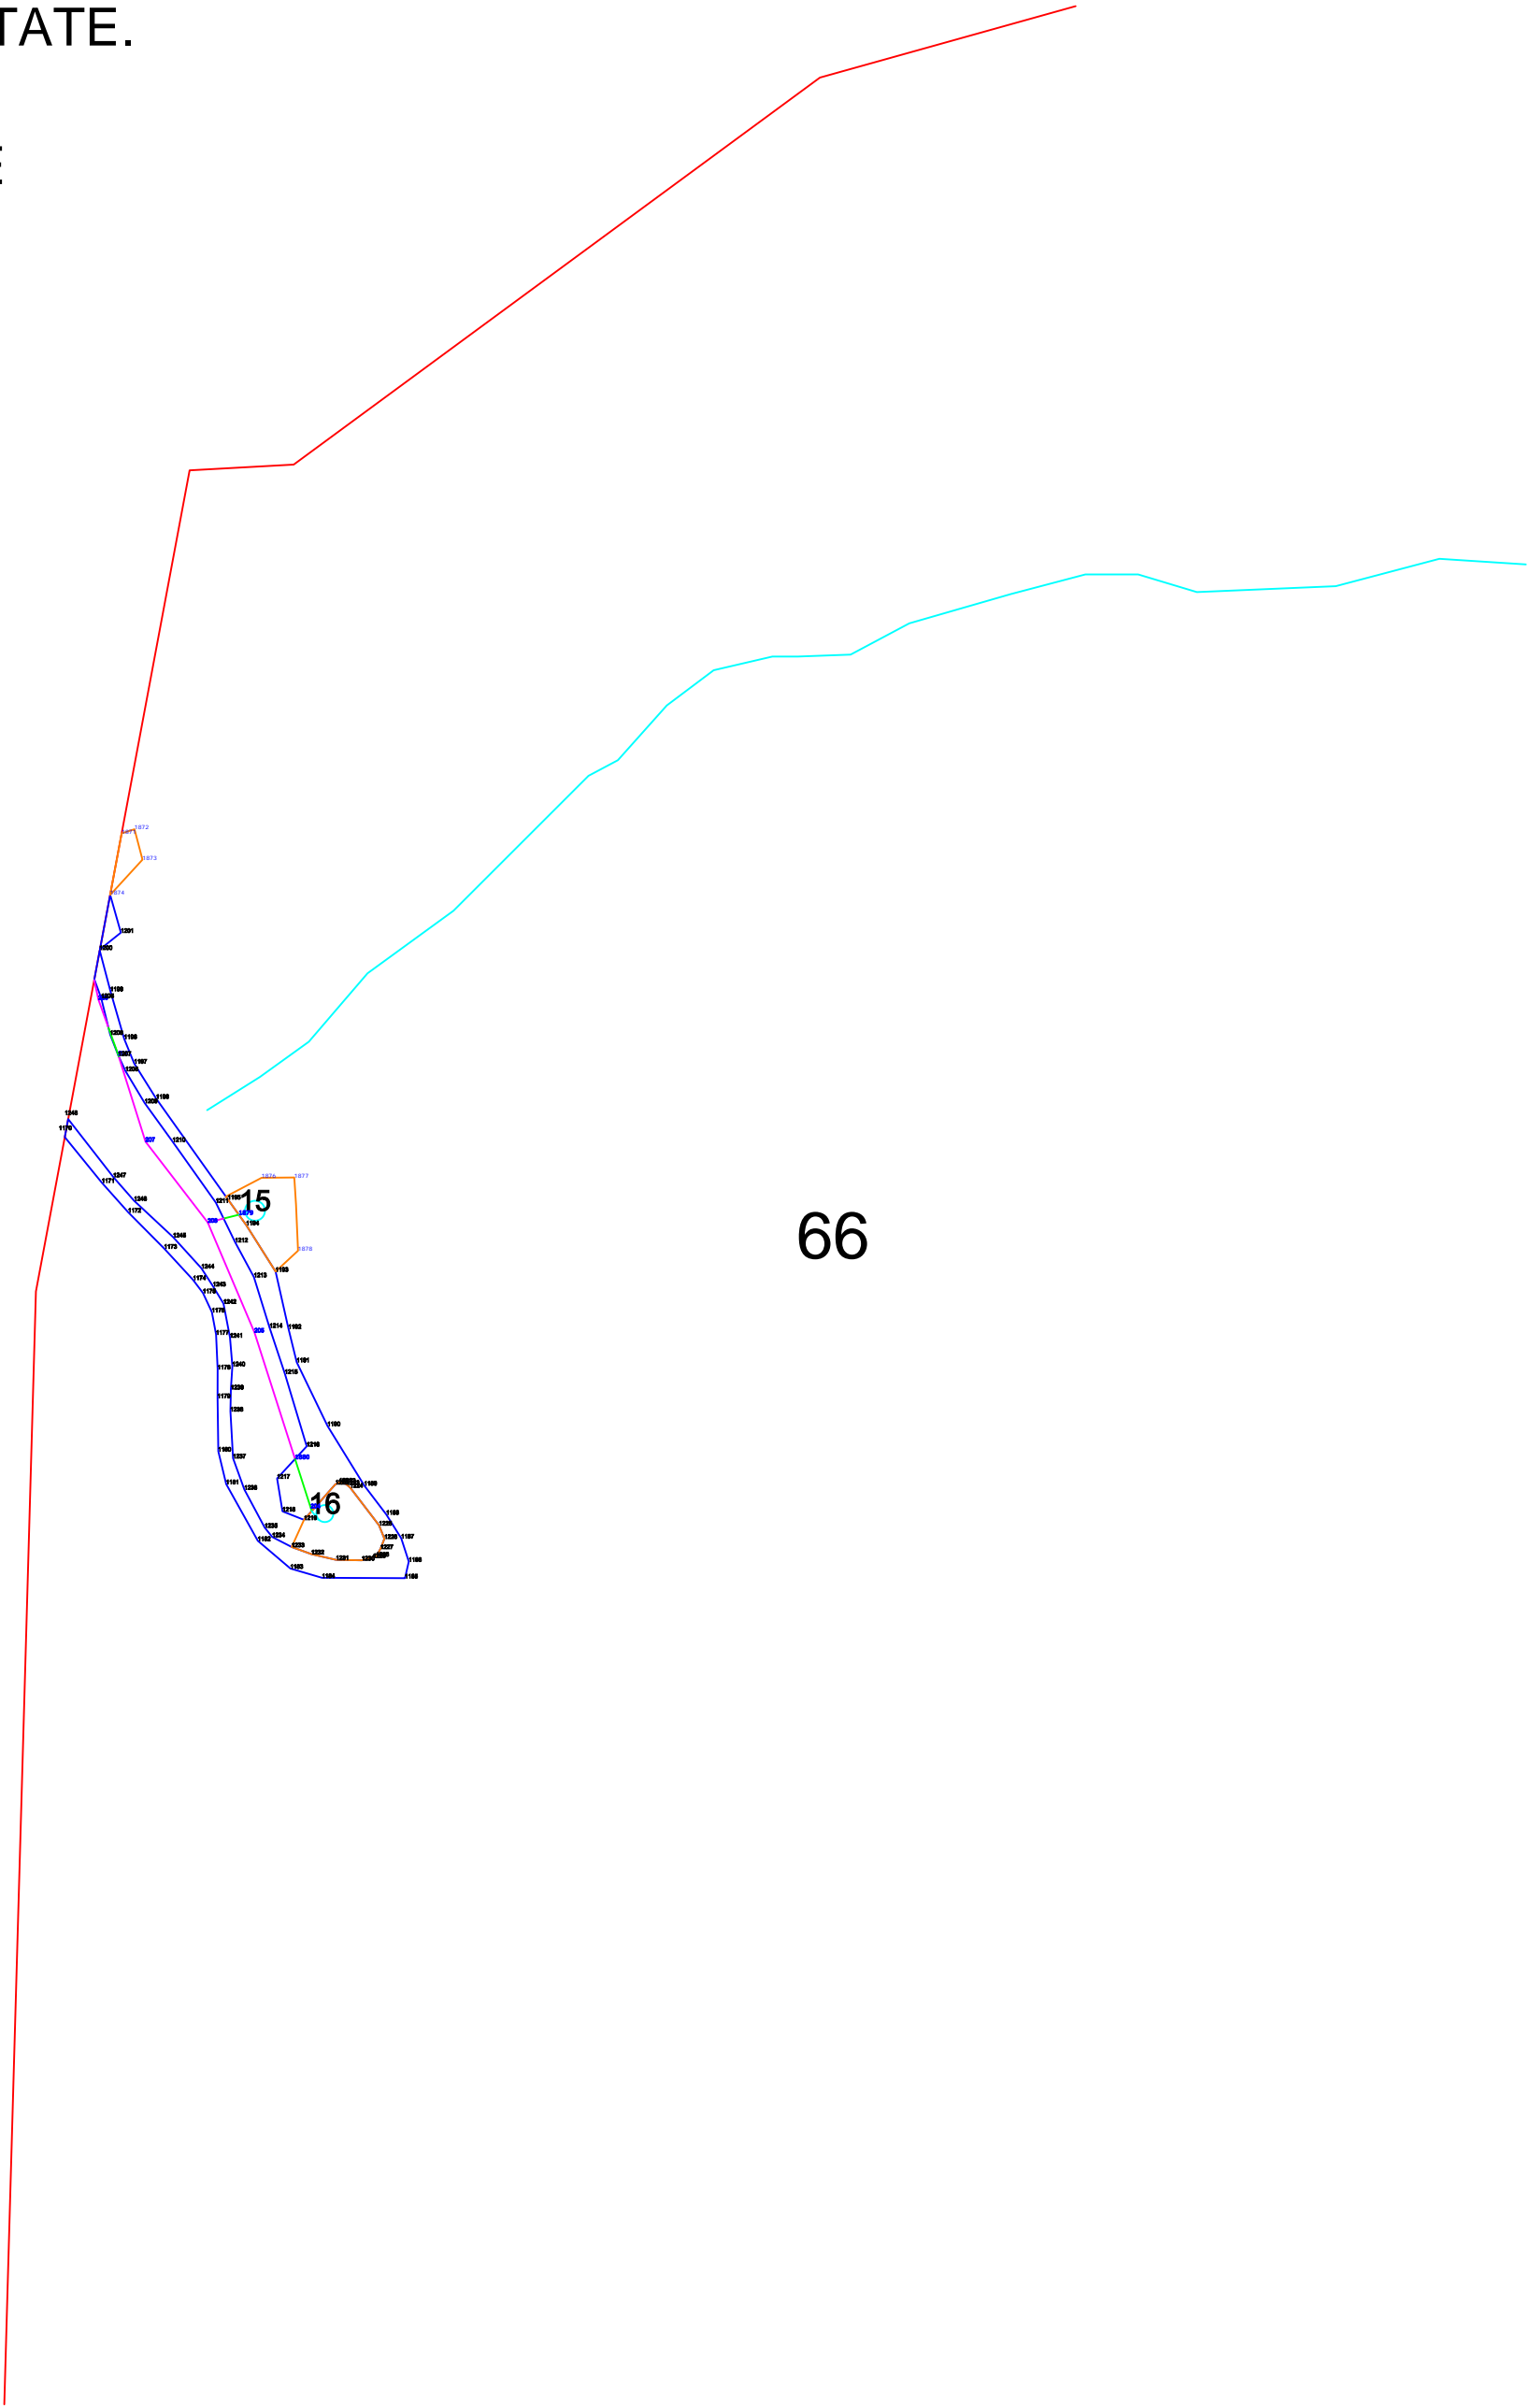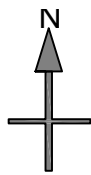

CADASTRAL MAP FEATURES	
FEATURE TYPE	LEGEND
	89 SURVEY BOUNDARY WITH NOS.
	ROAD
	STREAMS
	HILL

AS BUILT FEATURES	
FEATURE TYPE	LEGEND
	VILLAGE BOUNDARY
	AS BUILT ROAD
	NON FOREST ROAD
	AS BUILT ELECTRIC LINE
	NON FOREST ELECTRIC LINE
	NON FOREST VCB YARD
	AS BUILT PLATFORM AREA WITH NOS
	NON FOREST PLATFORM AREA WITH NOS
	NOS.FOR COORDINATES OF ROAD & EP LINE

**WIND WORLD (INDIA) LTD**
— formerly known as —

Scale:- NTS

PROJECT:- WIND POWER PROJECT
AT GOGUDDA SITE CHITRADURGA (DIST)
KARNATAKA STATE

TITLE:- SCALED MAP FOR SOORAGONDANAHALLI VILLAGE

DRAWING NO.:- KAR/GOGUDDA/1ASBULT-1/1