



South Central Railway

सं.No.GTL/CN/W.185/GNT-GTL/DL/Forest land

Office of Dy.Chief Engineer
Construction, Guntakal
दिनांक Date:15.06.2022

District Forest Officer
Kurnool District
Kurnool (T)

Sub: Guntakal Railway Division – Guntur-Guntakal section – Diversion of 1.36 Ha. of forest land in Compartment Nos.238 & 239 of North Dhone RF, Dhone Range, Kurnool Division for construction of new double line with electrification between Guntur and Guntakal stations at Dhone (Rly. Km.325/4 to 329/2) in favour of Dy.CE/C/GTL – Reg.

Ref: 1. Gol, MOEF&CC, IRO, Vijayawada F.No.4-APB167/2022-VIJ/323, dated.04.05.2022
2. Government of A.P./Energy & Forests (For.I) department G.O.Ms.No.174,
dated 24.8.1984
3. This office letter No.GTL/CL/W.185/GNT-GTL/DL/Forest land, dated 16.5.2022
4. Your office letter Rc.No.3699/2019/H5, dated 28-6-22
5. MOEFCC Letter to the Secretary (Forests), All State Governments/UT Administrations, dated 10.3.2022

Apropos the subject and cited reference 1, the Gol, MOEF&CC, IRO, Vijayawada has made some observations regarding the proposal submitted by S.C Railway (Vide Proposal No. FP/AP/Rail/149334/2021) and it has been requested the state government to examine the proposal in terms of applicability of FCA,1980.

Referring the letter (vide reference 2) in which the permission for diversion of 132.31ha of forest land for conversion of metre Guage line to broad Guage line between Giddalur and Dronachalam stations was accorded by State Government, it has been understood that the location of the subject (North Dhone Reserve forest) is also part of 132.31ha (as it is also in between Dronachalam and Giddalur stations). Accordingly, the reply has been given (vide reference 3) stating "The Railway have obtained diversion of forest area for the existing broad Guage line vide Government of A.P./Energy & Forests (For.I) Department (vide reference2)".

Of late, after scrutinisation of the files (sent by your office vide reference 4), it is understood that the land which is under Railway's custody in North Dhone reserve forest area, was not part of the forest land diversion done as part of "Metre Guage to Broad Guage conversion Project". Subsequently, the old project execution files of "Metre Guage to Broad Guage conversion project" have been verified and following information has been put up hereunder.

- As part of "Metre guage to Broad guage conversion Project in Hubli-Vijayawada stations", in few stretches (falling in forest area), alignment of broad guage track was planned away from the then existing alignment of metre guage track (in the range of 50m to 800m). In this connection, the diversion of forest land was sought and the same was permitted (vide reference 2) with the condition that the forest land along the old alignment should revert back to the forest department. Under this, the Railway sections between Panyam-Krishnammakona stations (in Panyam RF) and

Giddalur-Nandyal stations (in NANDYAL RF, Nadyal Extended.RF, Sirvel RF, Uyyalawada RF) were covered.

2. Whereas, the alignment of the broad guage track between Dronachalam to Malkapuram stations (section falling in North Dhone reserve forest area) was planned on the then existing alignment of "Metre guage" only and for this reason, no extra land was required at that time vis-a-vis, no diversion of forest land had sought in this section. The old working plans of all the Bridges (of Guage Conversion Project) in this stretch are here with enclosed for better understanding please.
3. The land which is under Railways custody in North Dhone reserve forest area between Dronachalam and Malakpuram stations, in which the then "Metre guage track" was and now the "Broad guage track" is there, is under the custody of Railways from 1932 onwards (which is evident when comparing the old land plan of 1932 and new land plan which is recently certified by revenue authorities. Copies are enclosed).

On these lines and in connection with the current proposal (Vide Proposal No. FP/AP/Rail/149334/2021), the information sought vide reference-4 is furnished below.

Sl.No	Point Raised by your office	Remarks
1	When the Meter gauge Railway line was laid down in the proposed diversion area i.e., in North Dhone RF	The Meter guage Railway line was laid down before 1932 (as per the land plans available with this office) in the proposed diversion area (North Dhone Reserve forest)
2	When it was upgraded from Meter Guage to Broad Guage Railway line in the proposed diversion area i.e., in North Dhone RF	The line was upgraded from Meter guage to Broad guage during 1994-1997. As said above, in this stretch, as the alignment was same as that of old metre guage line, no further diversion of forest land was arisen.
3	While upgrading the broad guage, whether or not the user agency had obtained any prior permission from the central government as per the Forest (Consevation) Act,1980	As said above, in this stretch, as the alignment was same as that of old metre guage line, no further diversion of forest land was arisen. Hence, No further permission from central government was sought as the work was executed within the land which under Railway's custody since 1932 (as per the land plans available with this office)

Further, on the matter of "Applicability of the Forest (Conservation) Act, 1980 on Railways land", a clarification has been advised by AIG (forests), MOEFCC, Government of India to all state Governments/UTS (Vide reference 5) which states that for execution or maintaining of Railway works on Railway owned land within Railway's right of way under section 11 of Railways act,1989, the need for obtaining the approval of the central government under section 2 of the Forest (Conservation) Act,1980 will not arise.

In line with this, the proposal (Vide Proposal No. FP/AP/Rail/149334/2021) for diversion of forest land (which is additionally required to complete the doubling of track in Dhone and Malkapuram Stations) has been processed for Forest clearance (as per FCA act,1980). For the land (lying vacant adjacent to existing railway track within Railway boundaries as per the Revenue records and Land plans), the forest clearance may not be

required (as the land is under Railway's custody since 1932 and ownership lies with Railways as per Revenue records and Land plans) as per AIG (forest)'s clarification vide Reference-5.

In view of the above, It is requested to please process the subject proposal (Vide Proposal No.FP/AP/Rail/149334/2021) for early forest clearance.

- Encl: 1. Old and new Land Plans
2. Copies of Revenue records
3. Copies of working plans of "Metre guage to Broad guage conversion" project



S. Varun Babu, IRSE
Dy.Chief Engineer
(Construction), Guntakal

Copy: Chief Engineer (Construction-I), SC for kind information please

Re-Survey and Re-Settlement Register of the Village of

Phone, No 105, Ramalshot Taluk, Kurnool District,


1	2	3	Old Survey Number and letter, if any కొన్కనొండు - 6 రెవెర్ నెఱెర్ రాజ్యాలు						Re-Survey Number. కొన్కనొండు - 6 రెవెర్ నెఱెర్ రాజ్యాలు	Sub-Number. కొన్కనొండు - 6 రెవెర్ నెఱెర్ రాజ్యాలు									
			4	5	6	7	8	9	10										
591	591	-	I	a	D	9	5-2	...	7	0	8	-	"	Wet from.	Dry from.	Rate per Acre. కోట్లలు	Rate per Acre. కోట్లలు	Class and sort of soil. ప్రతి భూత్రా ప్రతి వీధి.	
592	592	-	G	n	P	5	-	-	-	-	-	-	-	1	70	-	1	70	
593	593	-	I	a	D	9	5-2	7	0	8	-	-	-	9	28	4	10	1822	Dry, Irrigable Dry, Wet or Perambika ప్రతి భూత్రా ప్రతి వీధి, కోట్లలు
594	594	-	G	n	D	9	5-2	7	0	8	-	-	-	3	6	1	9	276	Chitakonda Yerra Balayya, చితకొండ యెర్ర బలయా,
595	595	-	G	n	D	9	5-2	8	0	4	-	-	-	4	5	1	0	-	
596	596	-	G	n	D	9	8-2	8	0	4	-	-	-	1	46	0	6	41	Kaju Niganna and Sunkanna కాజు నిగాన్న అండ సుక్కన్న
597	597	-	G	n	D	9	8-2	8	0	4	-	-	-	4	35	1	1	...	
598	598	-	G	n	D	9	8-2	8	0	4	-	-	-	17	30	4	5	206	Guli Ramireddi and Vadda Venkatagadu గులి రామిరెడ్డి అండ వెంకటగాదు
599A	599	-	G	n	D	9	8-2	8	0	4	-	-	-	7	2	1	12	795	...
599B	-	-	G	n	P	5	-	-	-	-	-	-	-	14	14	7	1	1731	Alamaddileth, Chitakonda Ramayya and 5 others అలమాడిలెథ, చితకొండ రామయా మరొకుండ్రాలు 5 లోట్లు

Area included in Survey No. 5

Railway B Class
రైల్వే బ్రిస్టల్ కోమెన్స్

Railway A Class
రైల్వే ఎంప్లిమెంట్

Railway B Class
రైల్వే బ్రిస్టల్ కోమెన్స్

Railway A Class
రైల్వే ఎంప్లిమెంట్

Re-Survey and Re-Settlement Register of the Village of

Dhoni, No 105, Ramalakot Taluk, Kurnool District.

1	Re-Survey Number புதிய போது		Old Survey Number and letter, if any. ஏதும் போது விடும்	Government or Inam கிராம அல்லது இனம்	D, y, Irrigable Dry, Wet or Poambuke கும், வெற்றும் வகும் கும், கும், வெற்றும் வகும்	Source of Irrigation நீர்வாச	Class and sort of soil நில கல்வி	Dry கும்	Wet கும்	Rate per Acre கிராம அல்லது இனம் கும்	Rate per Acre கிராம அல்லது இனம் கும்	Rate per Acre கிராம அல்லது இனம் கும்
	2	3										
609	A	...	609 C.B	...	G	P
609	B	-	609 B	...	G	P
610	..	610	G	P
611	.	611	-	-
612	..	612	Q	D
613	..	613	0	..	Q	D
613	A	613	Q	D
613	B	613	B	..	Q	D
613	C	613	C	..	Q	D
614	..	614	Q	D
614	A	614 A	Q	D
614	B	614 B	Q	D
614	C	614 C	Q	D
614	D	614 D	Q	D
614	E	614 E	615 B	..	Q	D
615	..	615
615	A	615 A
615	B	615 B
616	..	616
616	A	616 A
616	B	616 B
617	..	617 A, 618 A
618	..	618 A, 619 A
619	..	619
620	..	620
621	..	621
622	..	622

14	15	16	17	18	Name of Paddar or Inamdar or the Manager of the Institution to which the land belongs நில வரவேற்றும் பேர் அல்லது நிலையாளர் அல்லது இனம்பார் நிலையாளர்	Remarks கீழே
1	40	Hill Stream. கிராம அல்லது இனம் கும்		
0	29	Railway A Class கிராம அல்லது இனம் கும்		
2	4	0	8	Railway B Class கிராம அல்லது இனம் கும்		
182	66	45	11	Railway C, T.S. கிராம அல்லது இனம் கும்		
1	76	0	7	do		
14	64	3	11	do		
0	11	do		
0	13	do		
2	2	do		
0	80	do		
2	55	0	10	do		
0	3	do		
0	58	do		
0	78	do		
0	70	do		
1	68	do		
98	0	88	..	do		
1	68	do		









M.L./R.S.
M&S M.R.C. LTD.
(INCORPORATED IN ENGLAND)
GUNTAKAL - BEZVADA

M.G.
LAND PLAN

FROM MILE 280 TO 281
BETWEEN ONACHELLAM & MALLAIPURAM

SCALE 100 FEET TO 1 INCH

NOTE:-
THIS PLANS ALL THE PREVIOUS PLANS FOR THE ABOVE MILEAGE

 


CERTIFIED THAT THE LIMITS OF THE RAILWAY PERMANENT LANDS
SHOWN IN THIS PLAN WITH THEIR SURVEY NUMBERS
AND TEXTURE WERE VERIFIED BY ME AND FOUND CORRECT.


(SD) D. KRISHNA RAJ
TANILDAH, PHONE: 5-322
1.2.32


(SD) T. DRAISAMY MADIU
R.V. SURVEYOR
2.2.32


H.C./L
UPPER DRAWING OFFICE


GEN. DRAW. OFFICE SURVEY SECTION
DRAWN BY: _____
SEN'T BY: _____
TRACED BY: _____
CHECKED BY: _____
FROM GOVERNMENT OF
TENNEKONDA DISTRICT
DRAFTED BY: _____
DO. CHECKED BY: _____

 

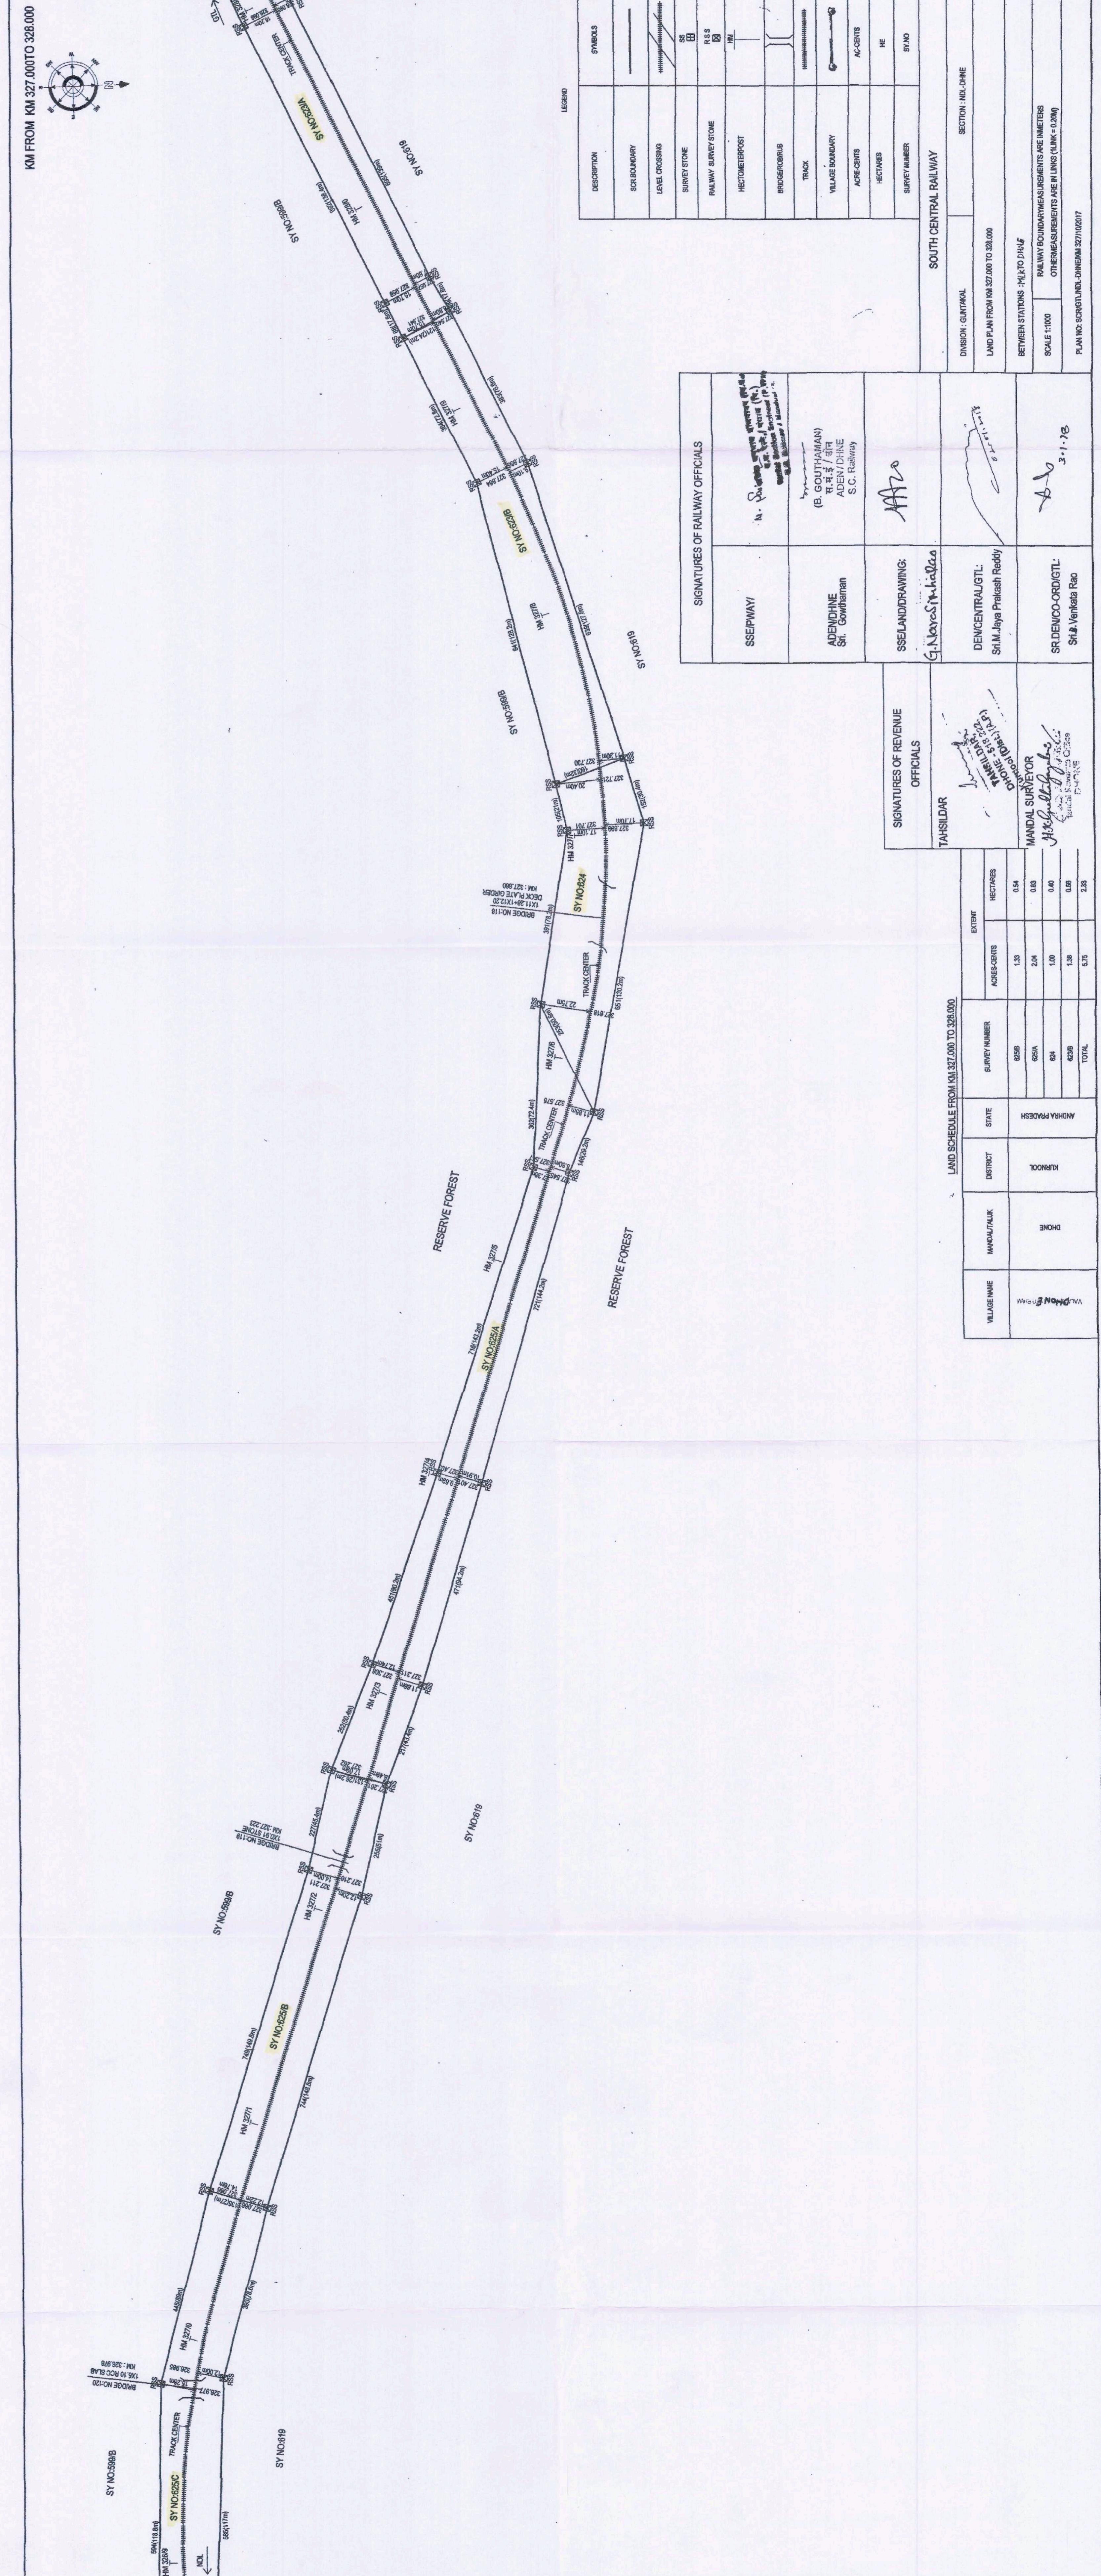


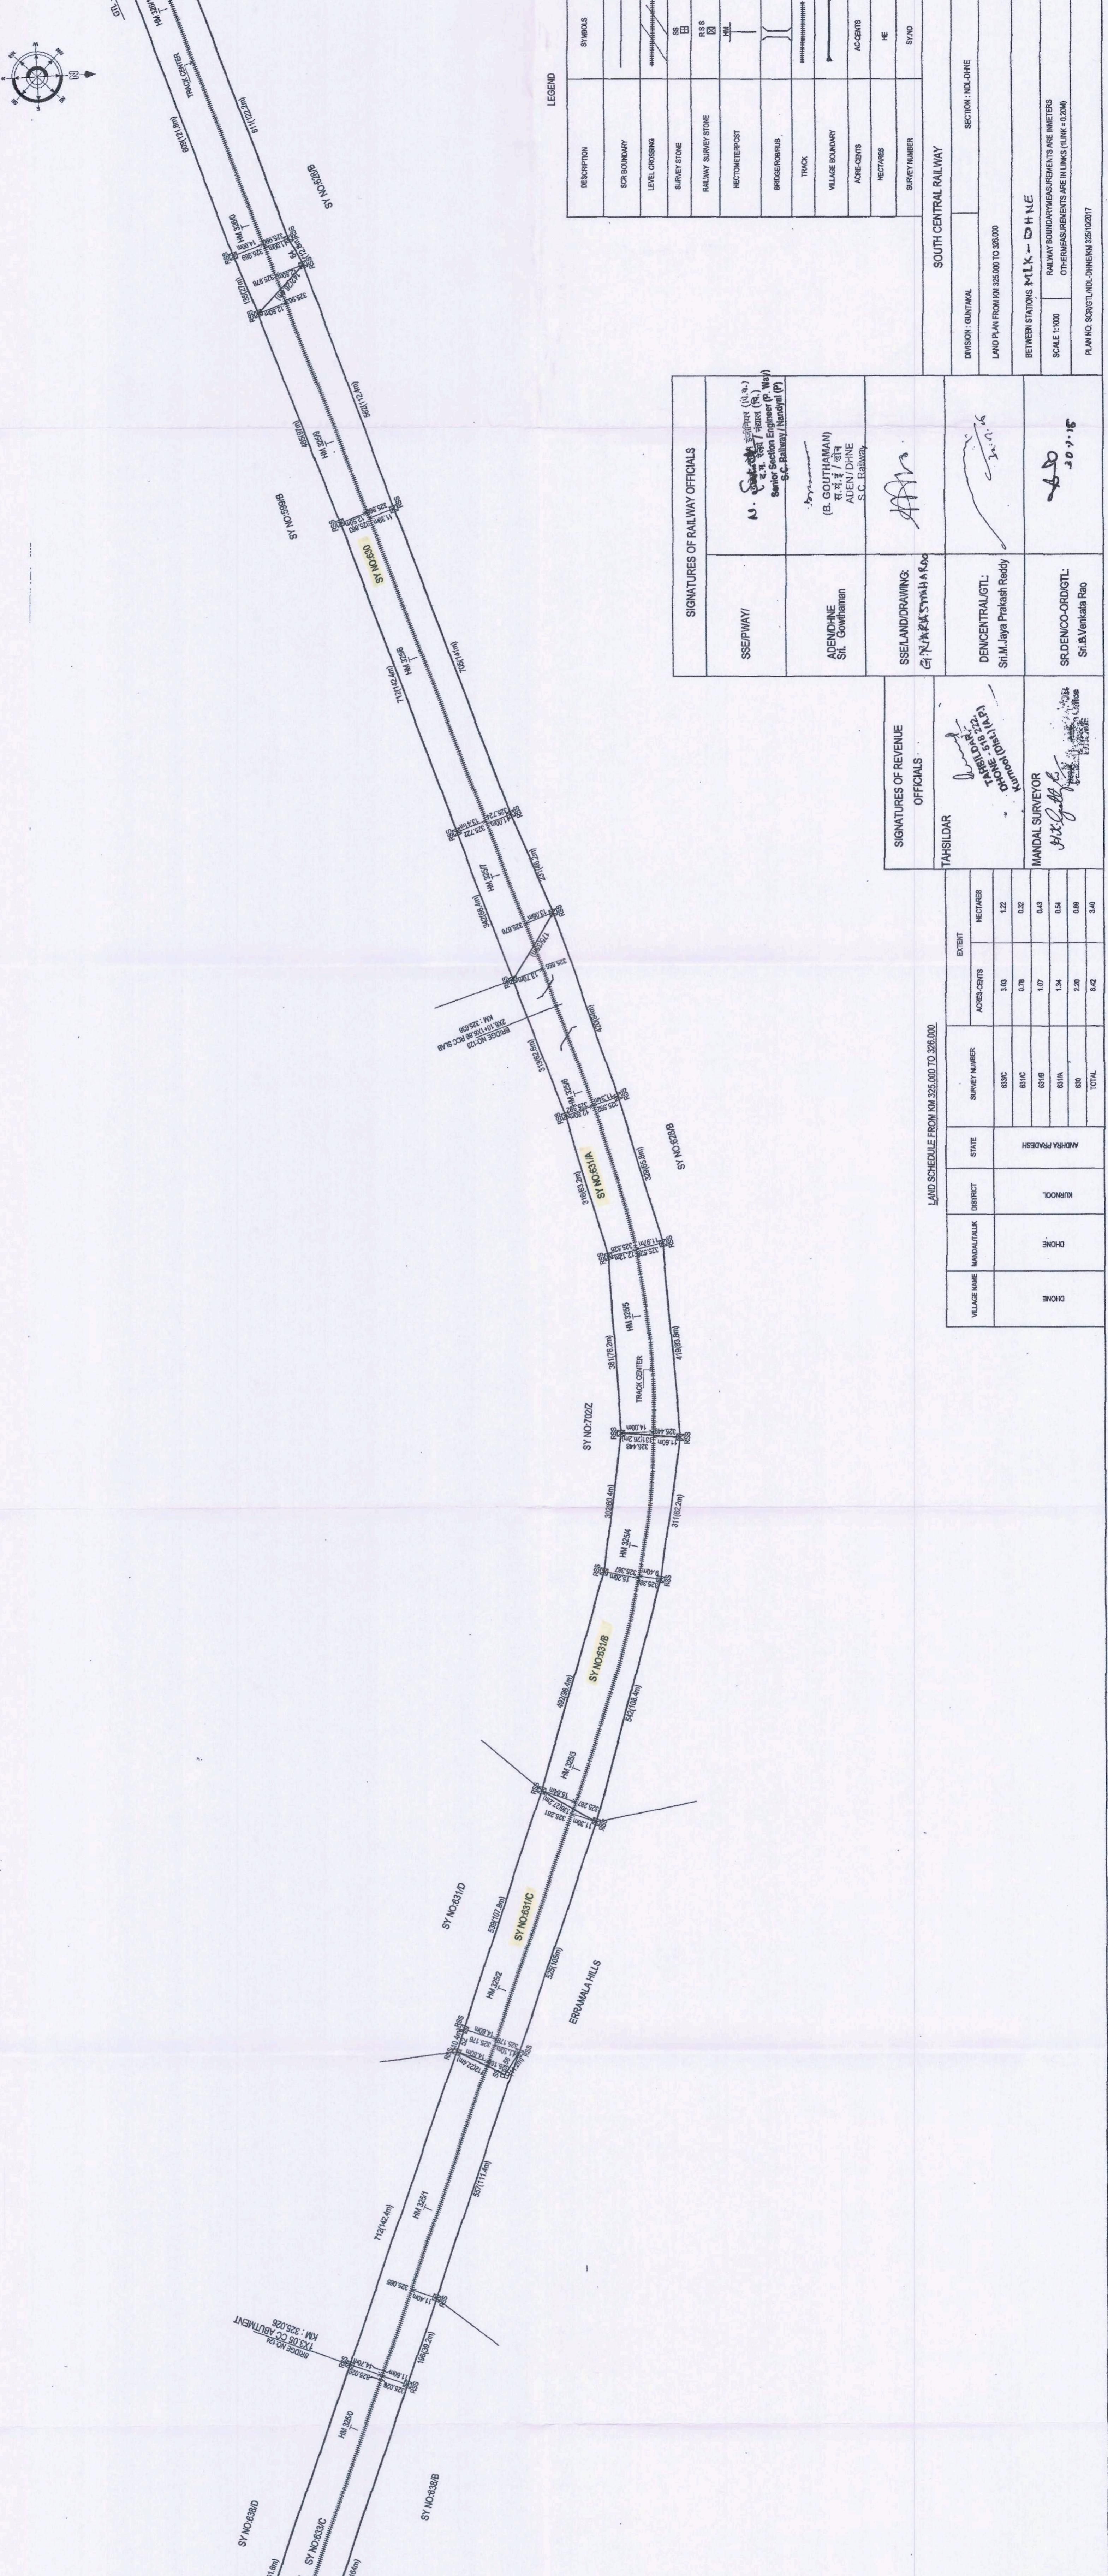

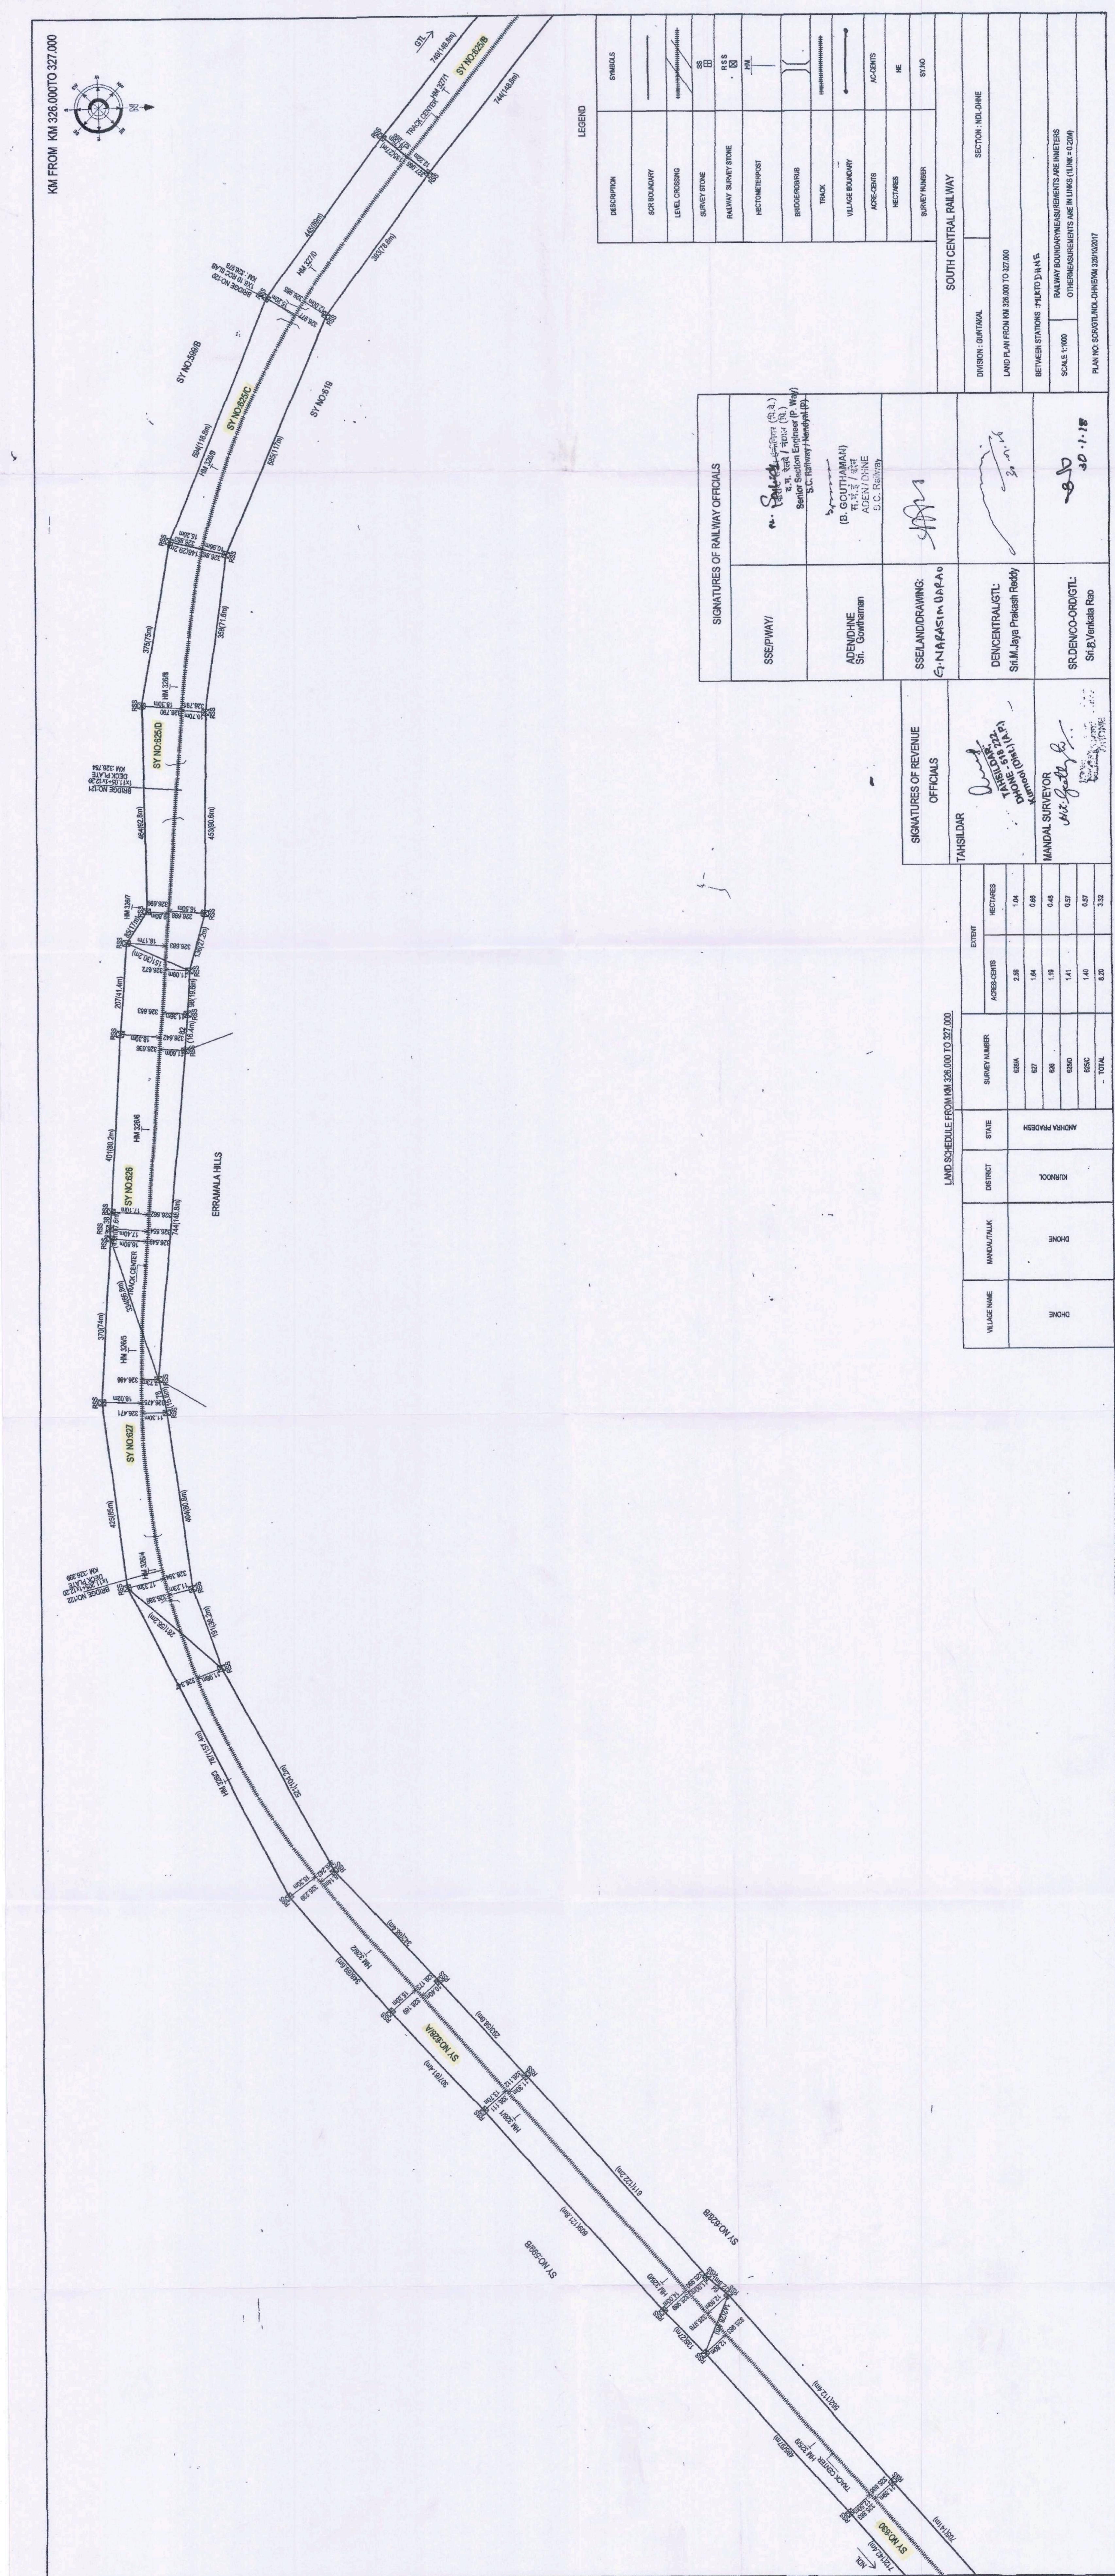

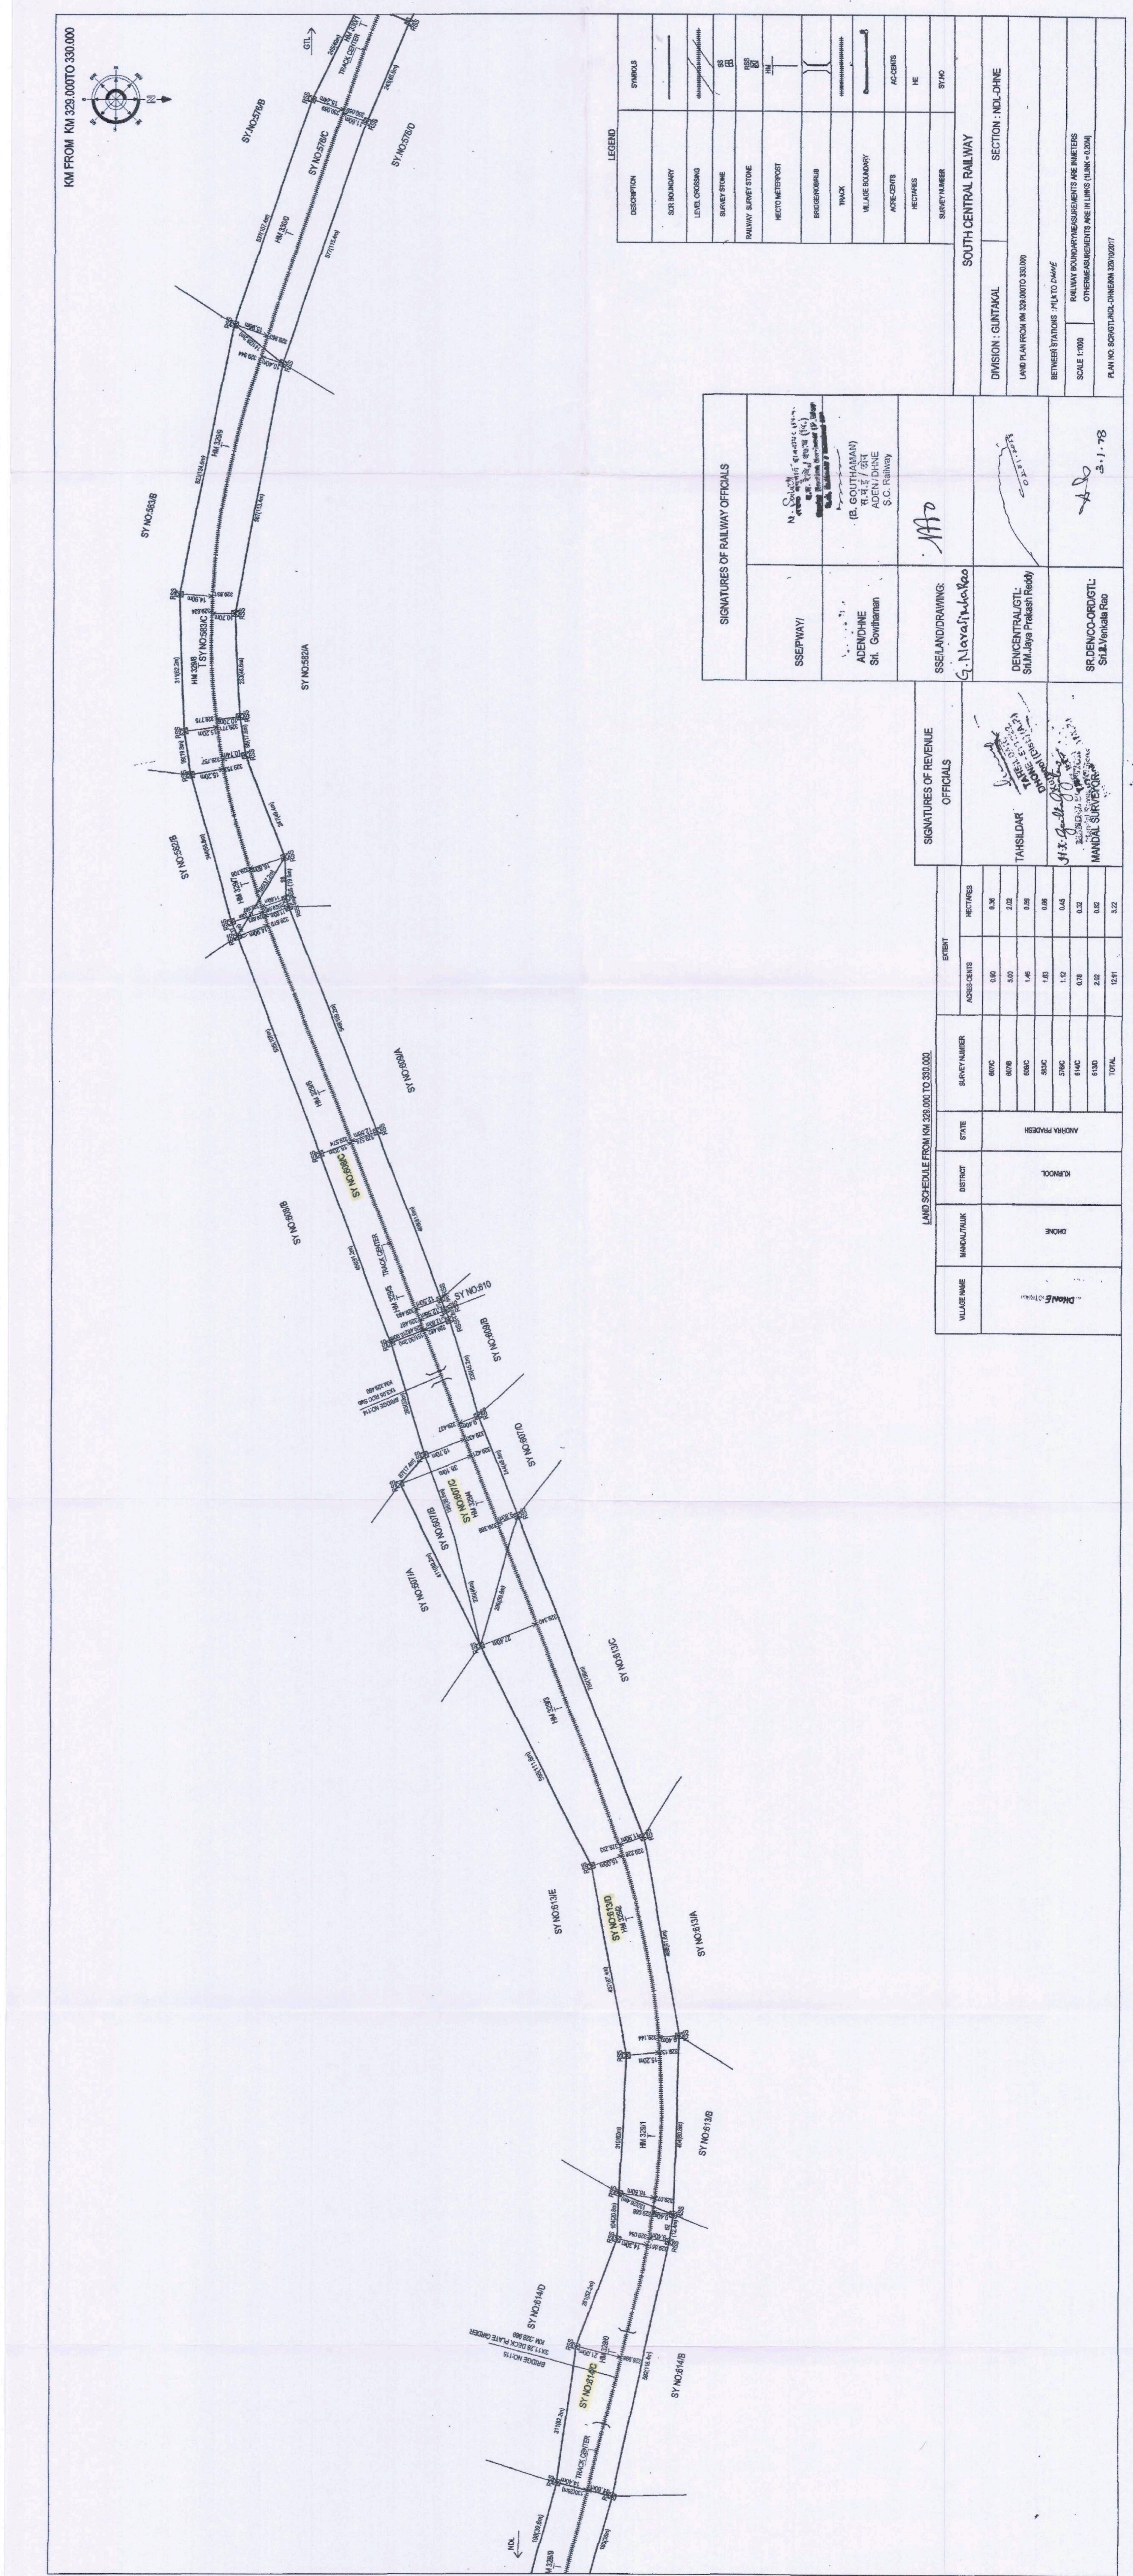

COMPLETION DRAWING

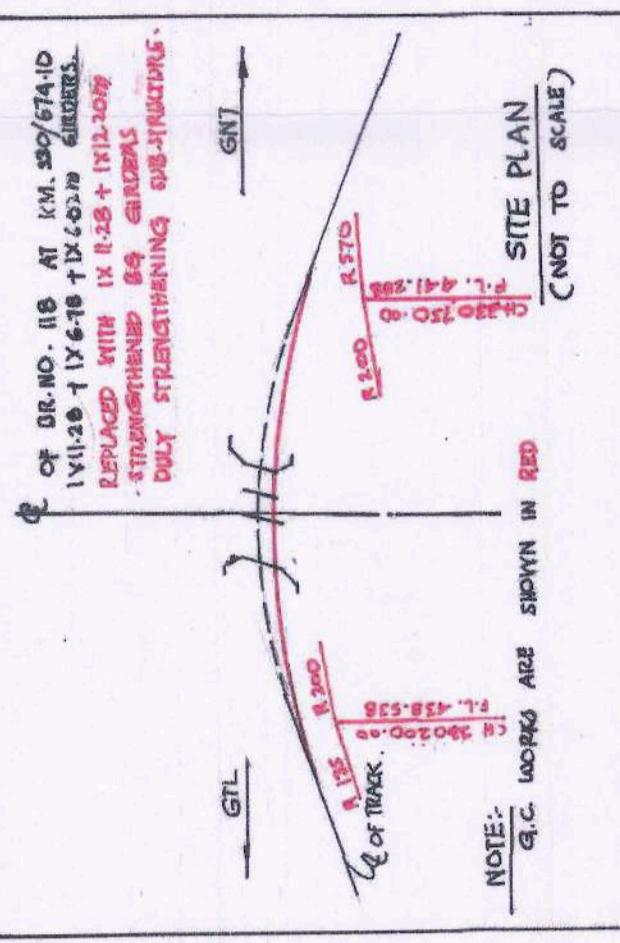



SPECIFICATIONS:-

1. ALL DIMENSIONS ARE SHOWN IN MILLIMETRES DURING GRADING CONVERSION
 2. THE WORKS ARE CARRIED OUT AS PER DRAWINGS IN RED.
 3. DEPTH OF FOUNDATION SHOWN IN THE DRAWING IS ACTUAL AND AS EXECUTED AT SITE
- NOTE: G.C. WORKS ARE SHOWN IN RED


REFERENCES:-

1. ALL THE WORKS ARE CARRIED OUT AS PER THE FOLLOWING AND STANDARDS SPECIFICATION FOR MATERIALS AND CONDUCTIONS WITH RELEVANT SPECIFICATIONS MENTIONED THEREIN.
2. I.S.C. RAILWAY BRIDGES AND STRUCTURES - CONTROLLED MASS < 1120 TONS.
3. IAS CONCRETE BRIDGE CODE 1962 CARRIED OUT IN CONJUNCTION WITH RELEVANT SPECIFICATIONS MENTIONED THEREIN.
4. IAS BRIDGE RULES.
5. FOUNDATION AND BRIDGE UNITS 40 MM. SIZE GRADED HARD AGGREGATE OF APPROVED QUALITY.
6. RCC SP. BLOCKS - CONTROLLED CC IN 25 GRADE DAMS 20 INTO MAX. SIZE GRADED HARD AGGREGATE OF APPROVED QUALITY.
7. CORNER - CONTROLLED CC IN 20 GRADE USING 20 MM THICK STONE AGGREGATE OF APPROVED QUALITY.
8. SIDE GUARDED HARD STONE AGGREGATE OF APPROVED QUALITY.
9. PITCHING - HARD PACKED ROUGH STONE PIGMENTS 300 THICK OVER GRAVEL BACKING CONCRETE OR WALL GRAVEL ON TOP SURFACE BEING 50 MM DRY TURBLE TIE WALL.
10. SOIL SIZE 60X60.

SOIL PARTICULARS
(NOT TO SCALE)

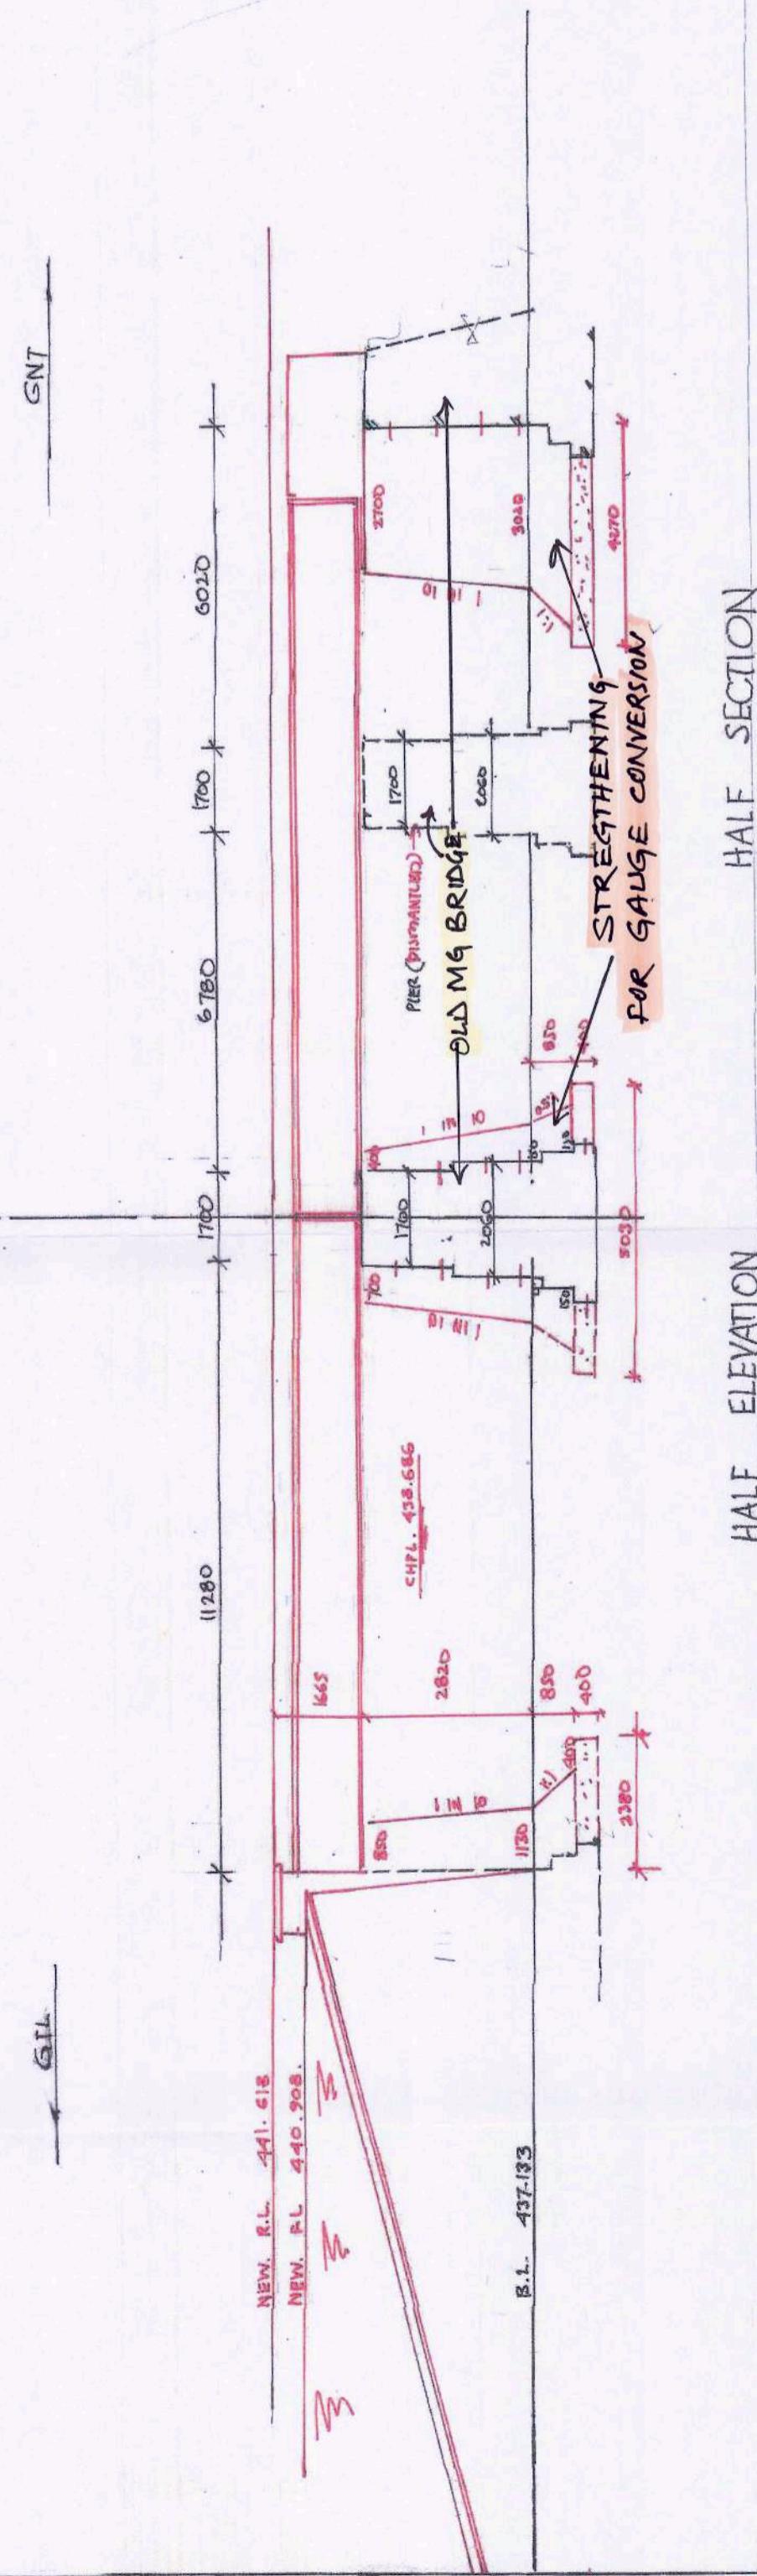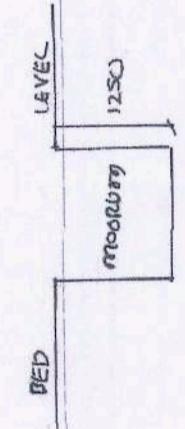

HALF ELEVATION

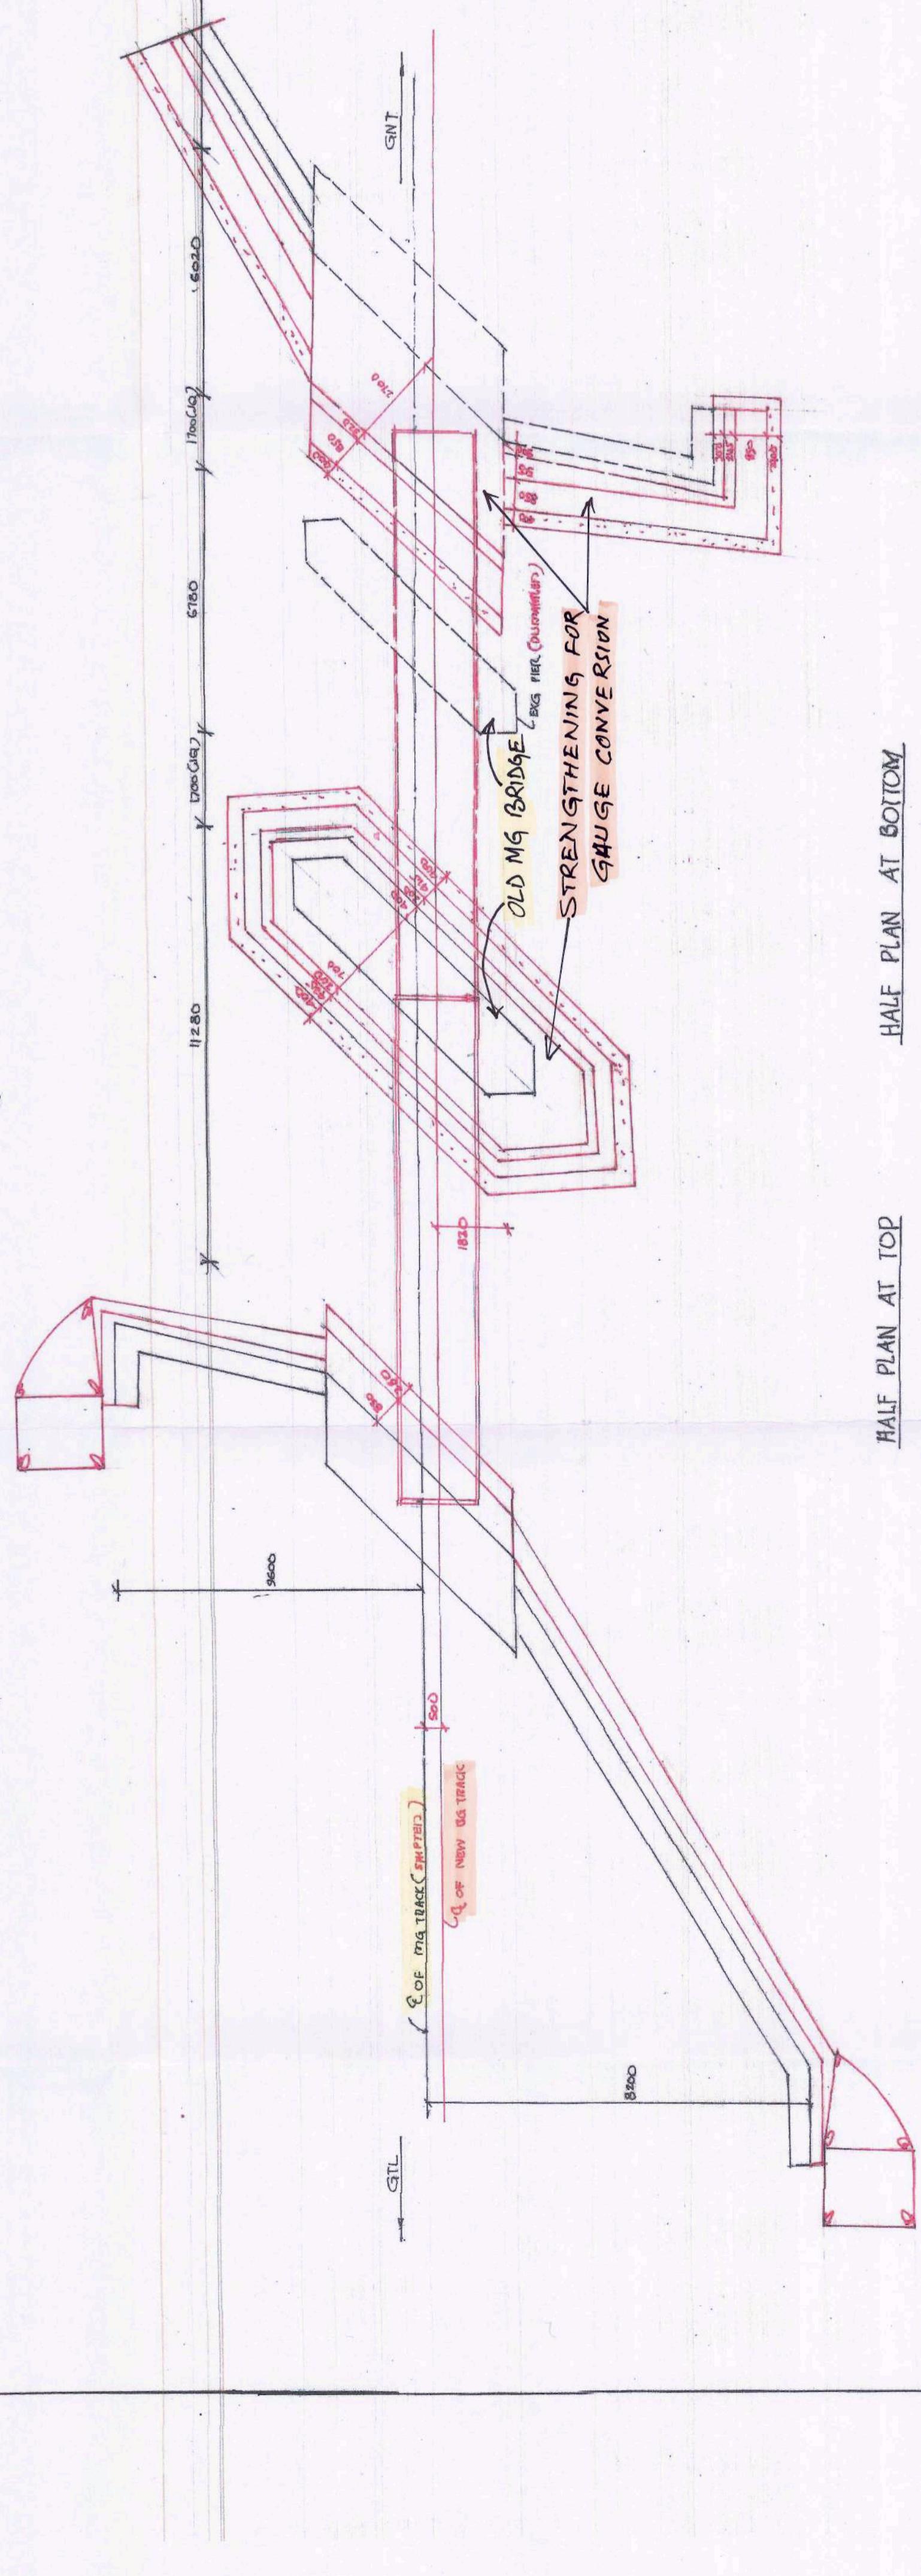

DATA FOR COMPLETION DRAWING	
REFERENCE OF WORKING DRAWING	CHD/CY/BR/490-96
DATE OF COMMENCEMENT	2 - 7 - 96
DATE OF COMPLETION	14 - 3 - 97
AGREEMENT NO.	BS / CAY / S / 9 / 96 / 10-6-96
ASSESSMENT	SRI. R. NARAYANA SUBBIAH SRI. V. SUBRAMANIAM SRI. R. NARAYANA SUBBIAH SRI. V. SUBRAMANIAM
NAMES OF CHIEF IN-CHARGE	
CHIEF ENGINEER	SRI. MOHAN LAL
ASSISTANT ENGINEER	SRI. C. SHARMINA
JUNIOR ENGINEER	SRI. P. STEPHENRAO
TRACK DETAILS	
LOADING	2 WD RGS
ALIGNMENT	2 LINE
GRADE	1:1 IN 50
NEW R.L.	941.618
Old P.L.	440.908

GAUGE CONVERSION COMPLETION
DRAWING FOR BR NO. 118

CERTIFIED THAT THE WORK HAS BEEN EXECUTED
AND COMPLETED AS PER THIS DRAWING.

SOUTH CENTRAL RAILWAY	DRAWING NO. CHD/CY/BR/ 16-97 (CONT)
GUNTUR - GUNTAKAL SECTION	
CONVERSION OF TRACK FROM M.G. TO B.G. BETWEEN NANDYAL AND DRONACHELLAM STATIONS	
BRIDGE NO. 118. AT KM. 330+ 672.00 1 X II 25 m +	1 X 6.02 m GROEPS CNG) REPLACED WITH
1 X II 26 + XI 2.20 m STRENGTHENED BG GROEPS	DULY STRENGTHENING SUB. STRUCTURE BETWEEN
MALKAPURAM AND DRONACHELLAM STATIONS	S.C. RAILWAY
SCALE: 1:100	S.C. RAILWAY

SIGNATURE	NAME	DESIGNATION
C. SHARMINA	SRI. V. SUBRAMANIAM	ASST. CHIEF ENGINEER

FOR CHIEF ADMINISTRATIVE OFFICER (C.A.O.)
S.C. RAILWAY

CONTRACTOR

C. SHARMINA



P. STEPHENRAO

SIGNATURE

NAME

DESIGNATION

Asst. CHIEF ENGINEER

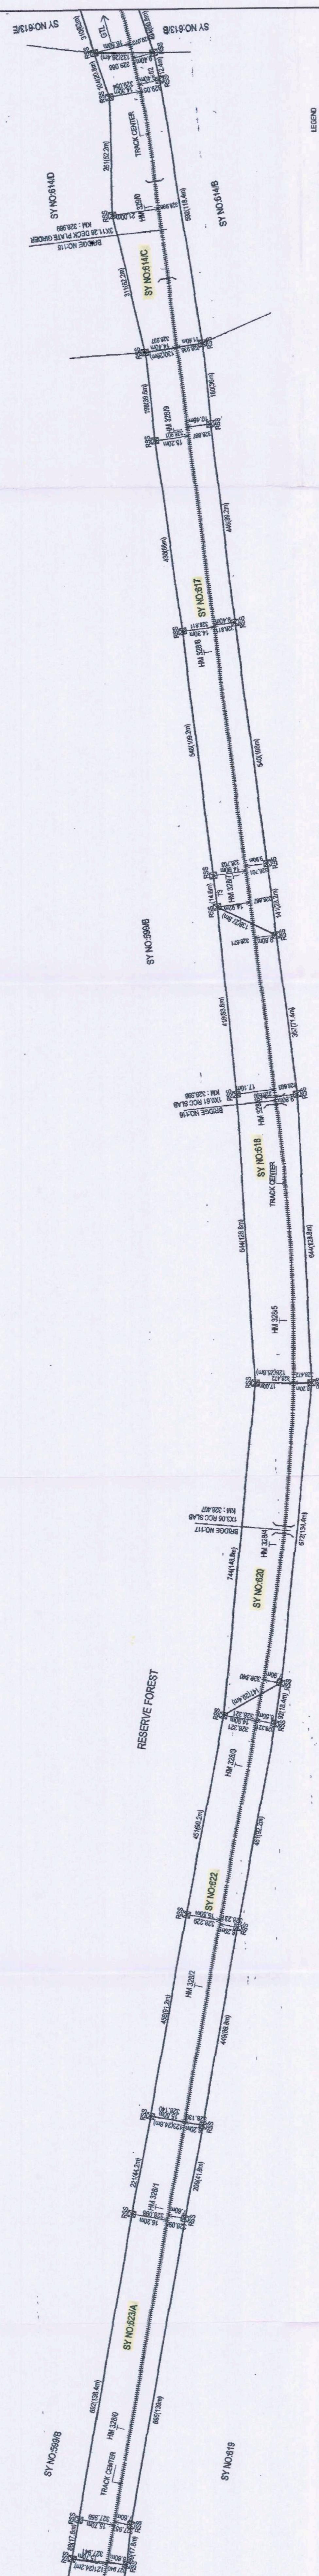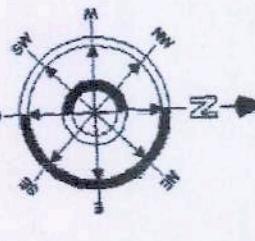

DESCRIPTION	SYMBOLS
STATE BOUNDARY	—
LEVEL CROSSING	—
SURVEY STONE	SS
RAILWAY SURVEY STONE	RSS
NECTOME TERPOST	HM
BRIDGE/RIBBON	—
TRACK	—
VILLAGE BOUNDARY	—
ACRE-CENTS	—
HECTARES	HE
SURVEY NUMBER	SY NO


SIGNATURES OF RAILWAY OFFICIALS	
SSEIPWAY/	
ADENOHNE Sh. Gowthaman	
TAHSILDAR C. Nagaas, Jaffer Rao	

LAND SCHEDULE FROM KM 328.000 TO 329.000		SOUTH CENTRAL RAILWAY	
DIVISION: GUNTAKAL		SECTION: ND-LINE	
LAND PLAN FROM KM 328.000 TO 329.000		BETWEEN STATIONS: PLK TO DHNE	
VILLAGE NAME	MANDAL/TALUK	DISTRICT	STATE
ANDHRA PRADESH	KURNOOL	KURNOOL	ANDHRA PRADESH
EXTENT		SURVEY NUMBER	
ACRE-CENTS		HECTARES	
623A	1.06	0.44	
622	1.14	0.46	
620	0.96	0.36	
618	2.30	0.93	
617	1.60	0.64	
TOTAL	6.96	2.87	

COMPLETION DRAWING





NOTES

1. ALL DIMENSIONS ARE SHOWN IN MILLIMETRES UNLESS OTHERWISE STATED.
2. WORKS DONE UNDER CONSTRUCTION ARE SHOWN IN RED
3. THE CHANGES ARE RECORDED FROM % OF PROB(CN) AT GUNTUR STATION

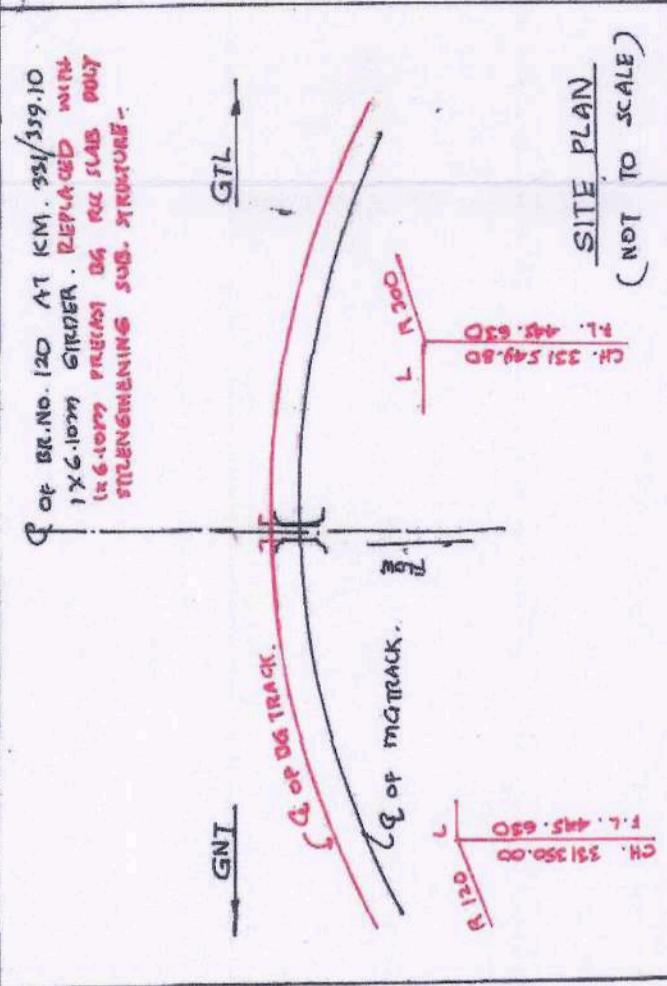

SPECIFICATIONS:-

1. ALL WORKS CARRIED OUT AS PER THE FOLLOWING.
- i) S.C. PLY STANDARD SPECIFICATIONS FOR MATERIALS AND WORKS OF STATION
- ii) ICS CONCRETE SLAB CODE IS:62 (RED) READ IN CONJUNCTION WITH RELEVANT I.S. SPECIFICATIONS MENTIONED THEREIN.
- iii) ICS BRIDGE SUB-STRUCTURE CODE IS:62
- iv) ICS BRIDGE CODE
- v) FOUNDATION:- CONTROLLED MASS C.C.M20 GRADE WITH 40MM MAX SIZE GRADED HARD STONE AGGREGATE OF APPROVED QUALITY.
- vi) SUB-STRUCTURE:- CONTROLLED MASS C.C. M20 GRADE WITH 40MM MAX SIZE GRADED HARD STONE AGGREGATE OF APPROVED QUALITY.
- vii) JACKETTING:- CONTROLLED C.C. M20 GRADE WITH 20MM MAX SIZE GRADED HARD STONE AGGREGATE OF APPROVED QUALITY.
- viii) R.C.C. SLABS:- CONTROLLED R.C.C. M20 GRADE WITH 20MM MAX SIZE GRADED HARD STONE AGGREGATE OF APPROVED QUALITY.
- ix) CORNERS:- CONTROLLED C.C. M20 GRADE WITH 20MM MAX SIZE GRADED HARD STONE AGGREGATE OF APPROVED QUALITY.
- x) PITCHING:- HAND PACKED ROUGH STONE PITCHING 300MM THICK OVER 150MM GRAVEL BACKING CONSISTING OF WELL GRADED GRAVEL OF MAX SIZE BEING 15MM DIA WITH DRY RUBBLE TOE WALL OF SIZE 600X600 MM.

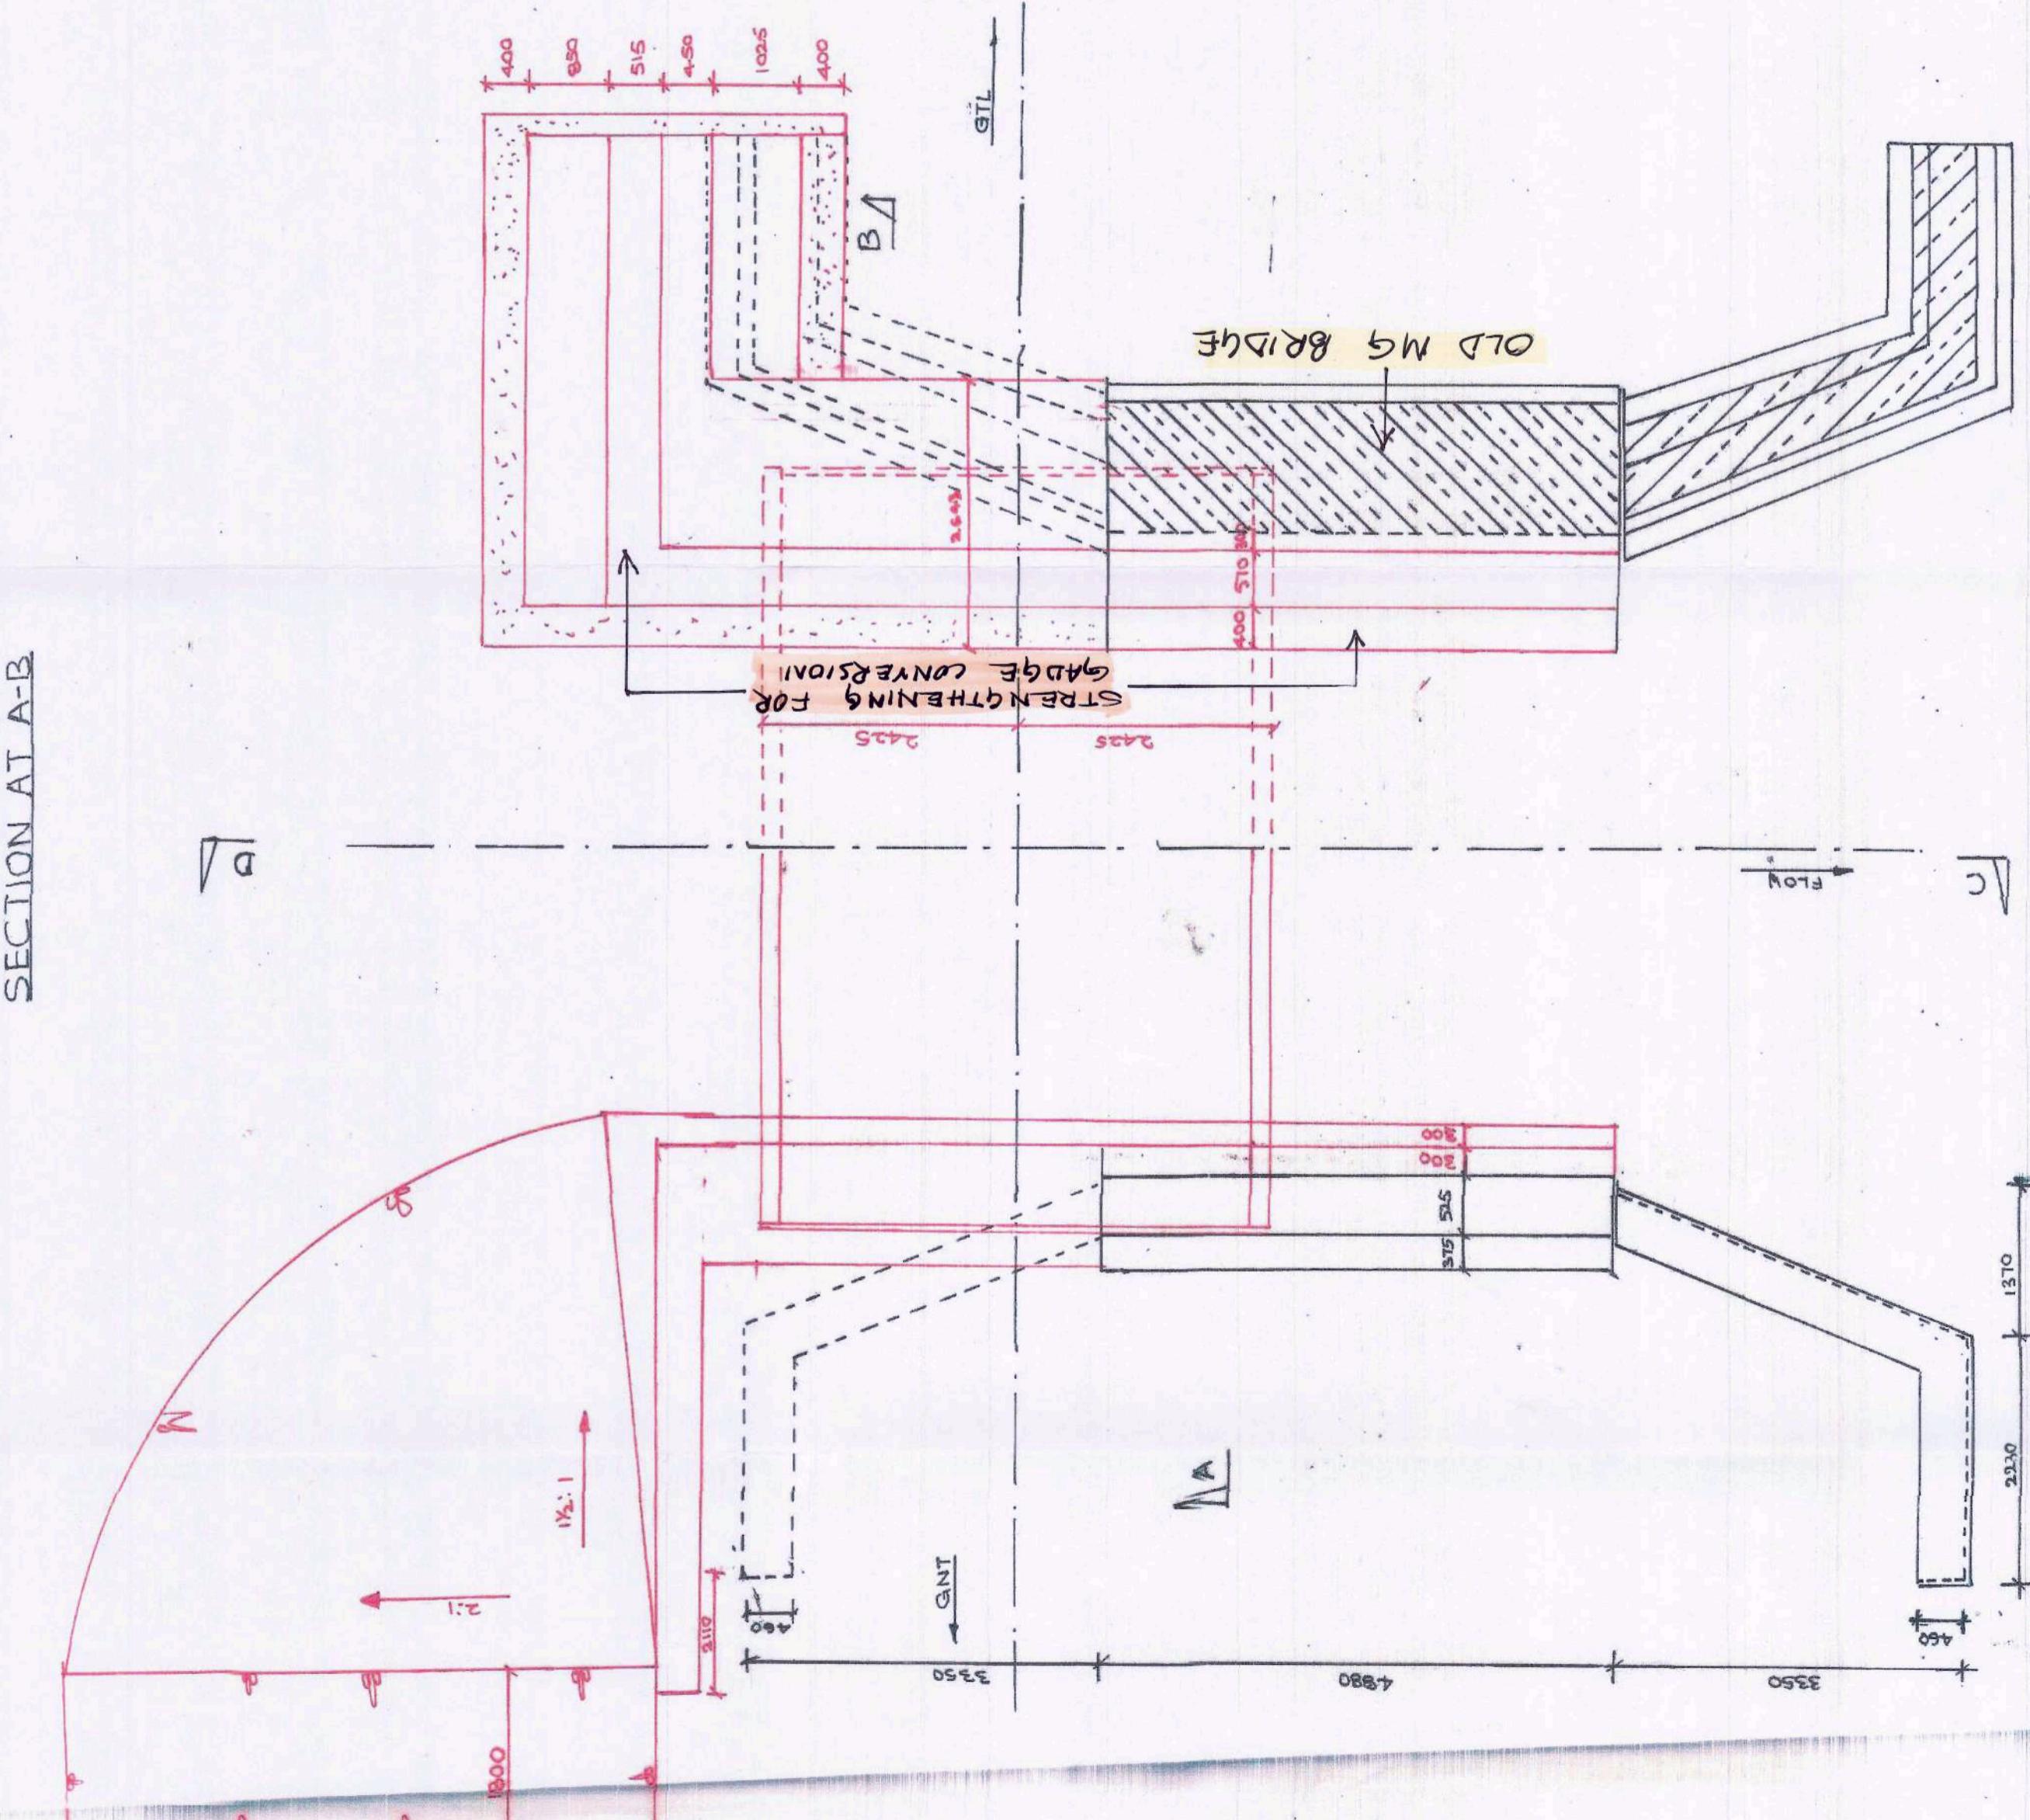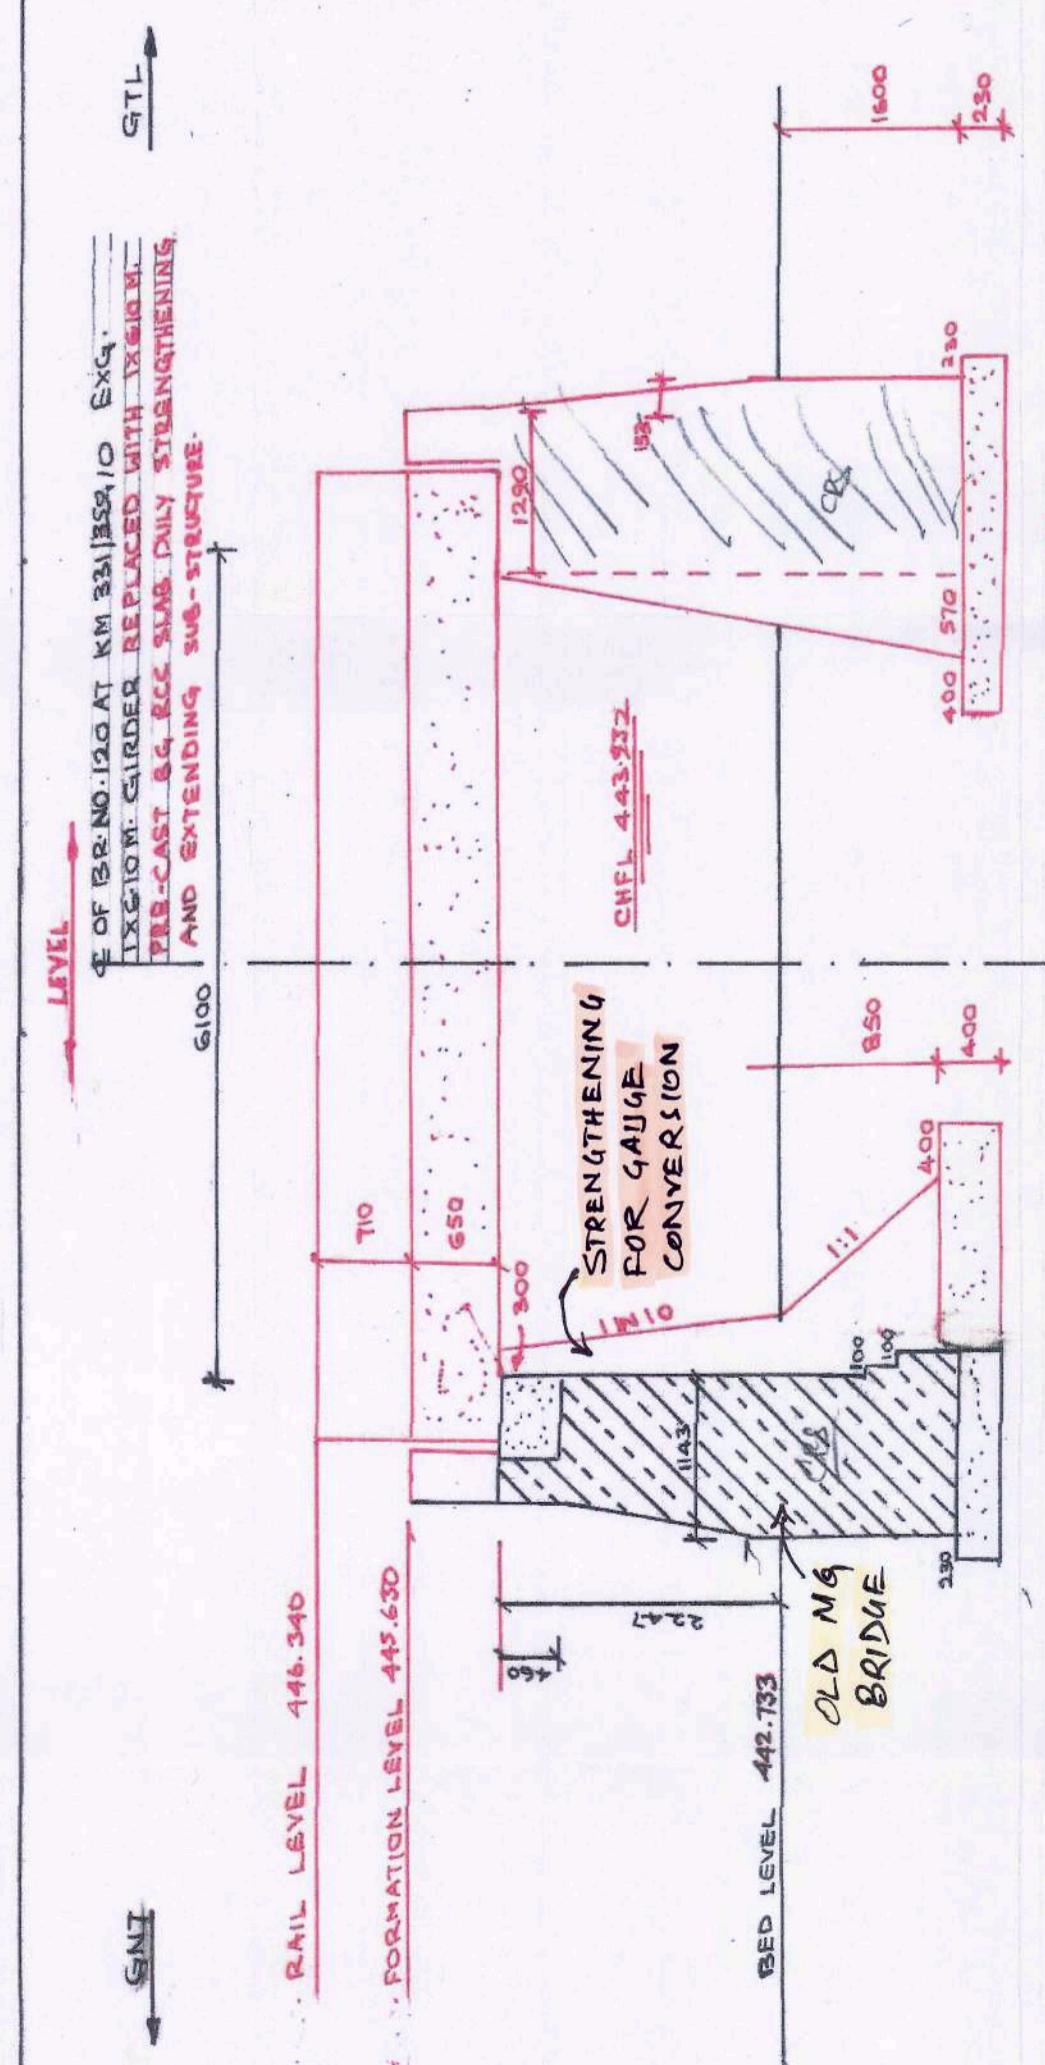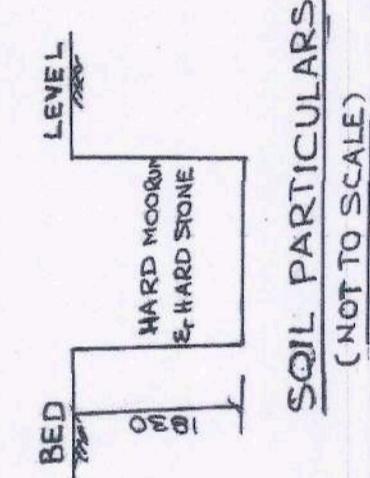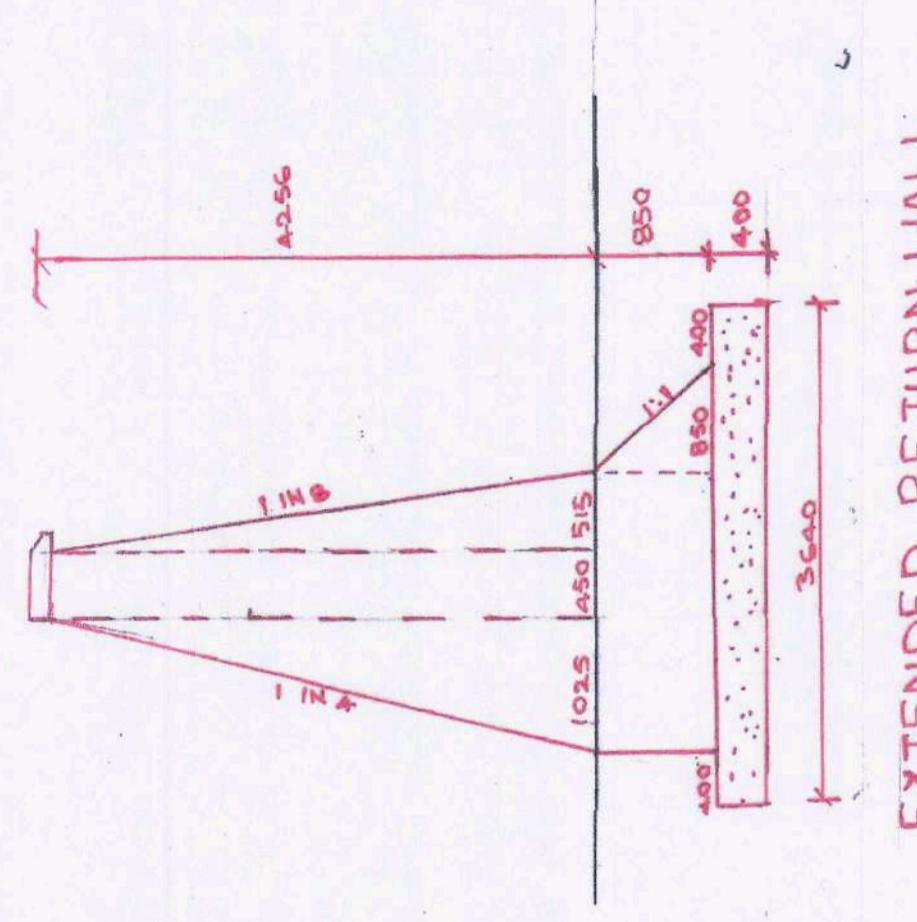

HALF PLAN AT TOP-HALF PLAN AT BOTTOM.

DATA FOR COMPLETION DRAWING					
REFERENCE TO WORKING DRAWING NO. CAO/C/BRI/1164-95					
DATE OF COMMENCEMENT	19 - 9 - 96				
DATE OF COMPLETION	13 - 3 - 97				
AGREEMENT NO.	SEAL-AO/C/BRI/1164-94-95				
AGENCY	1. SEZ, RANI BATU 2. RANI BATU 3. VENKATESWARA 4. MOHAN LAL				
NAME AND DESIGNATION OF OFFICIAL-IN-CHARGE	SAC. C. SHANMUGAM				

Gauge Conversion Completion

DRAWING BRIDGE No. 120

- REFERENCE:-
1. RCC SLAB DETAILS AS PER DRG. NO. CAO/C/BRI/674-94
 2. NEEPH HOLES AND BACK FILLING DETAILS AS PER DRG. NO. CAO/C/BRI/1164-95

TRACK DETAILS					
LOADING	MBS PMP	ALIGNMENT	CURVE	GRADE	LEVEL
NEW RL	446.340	NEW RL	446.340	NEW RL	446.340
NEW PL	445.630	NEW PL	445.630	NEW PL	445.630

CERTIFIED THAT THE WORK HAS BEEN EXECUTED
AND COMPLETED AS PER THIS DRAWING

[Signature]
DR. C. SHANMUGAM
ASST. ENGR.
Dy. Dir. (Engr.)
Am-GT-BR-INDL

SOUTH CENTRAL RAILWAY


DRAWS. NO. CAO/C/BRI/1164-95 (COMP)
GUNTUR-GUNTAKAL SECTION
CONVERSION OF TRACK FROM MG TO BG
BETWEEN NANDYAL AND DRONACHELLAM STATIONS
BRIDGE NO. 120 AT KM 331.1359.10

EX.G.10 M PRE-CAST B.G. R.C.C. SLAB DULY
STRENGTHENING AND EXTENDING SUB-STRUCTURE
BETWEEN MALKAPURAM AND DRONACHELLAM STATIONS
SCALE: 1:50

SCALE: 1:50

VERIFIED BY ME	
SIGNATURE	<i>[Signature]</i>
NAME	C. SHANMUGAM
DESIGNATION	AEN (Civil Engg.)

COMPLETION DRAWING

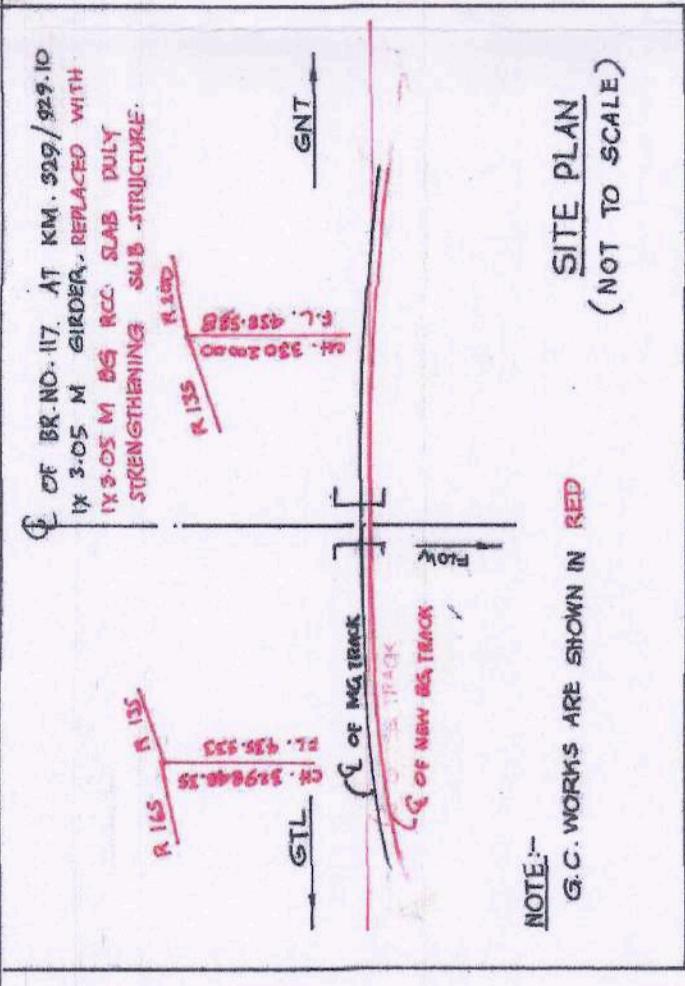

NOTES:-
1. ALL DIMENSIONS ARE SHOWN IN MILLIMETRES
2. THE WORKS CARRIED OUT UNDER GAUGE CONVERSION
3. DEPTH OF FOUNDATION SHOWN IN THE DRAWING IS ACTUAL
AND AS EXECUTED AT SITE

SPECIFICATIONS
1. ALL WORKS ARE CARRIED OUT AS PER THE FOLLOWING
I. S.C. RAILWAY STANDARD SPECIFICATIONS FOR MATERIALS AND
WORKS OF 1970.
ii. IRS CONCRETE BRIDGE CODE 1962 (REVISED) READ IN
CONJUNCTION WITH RELEVANT I.S. SPECIFICATIONS MENTIONED
THEREIN.
iii. IRS BRIDGE SUB. STRUCTURE CODE 1985 (REV'D)
iv. IRS BRIDGE RULES.
2. FOUNDATION AND SUB. STRUCTURE :- CONTROLLED MASS CC M 20
GRADE USING 40 MM MAX. SIZE GRADED HARD STONE
AGGREGATE OF APPROVED QUALITY.
3. R.C.C. SLAB:- CONTROLLED CC M 25 GRADE USING 20 MM MAX.
SIZE GRADED HARD STONE AGGREGATE OF APPROVED QUALITY.
4. COINING:- CONTROLLED CC M 20 GRADE USING 20 MM MAX.
SIZE GRADED HARD STONE AGGREGATE OF APPROVED QUALITY.
5. PITCHING:- HAND PACKED ROUGH STONE PITCHING 300 THICK OVER
150 MM THICK GRAVEL BACKING CONSISTING OF WELL GRADED
GRAVEL OF MAX. SIZE BEING 150MM WITH DRY RUBBLE TOE WALL
OF SIZE 600X600.
6. FLOORING:- ROUGH STONE FLOORING 300 THICK WITH UCRS MASONRY
DROP WALL IN OM 1:6 OVER CC FOUNDATION

REFERENCES:-
1. RCC SLAB PROVIDED AS DRG NO CAO/C/BR/15-91.
2. WEEP HOLES AND BACK FILLING PROVIDED AS PER
DRG. NO. GM(W)SC/BR/1455-90.
3. BOWEL BARS AND JACKETING PROVIDED AS PER
RODO DRG. NO. EDO-B-1997.

DATA FOR COMPLETION DRAWING	
REFERENCE OF WORKING DRAWING	CAO/C/BR/81-75.
DATE OF COMMENCEMENT	15-7-96
DATE OF COMPLETION	10-3-97
AGREEMENT NO.	85/CAO/C/SC/96/ Dr. 10-6-1996
AGENCY	SRI. R. NARAYANA REDDY SRIRUKHANAGAR
NAMES OF OFFICIALS IN CHARGE	
DEPUTY CHIEF ENGINEER	SRI. MICHAN LAL.
ASSISTANT ENGINEER	SRI. C. SHAMANNA
JUNIOR ENGINEER	SRI. P. SRINIVASA RAO
TRACK DETAILS	
LOADING	M.B.G. 1087
ALL GIRDERS	R.I. IN 15S
GRADE	NEW R.L. 437.241 436.581
NEW R.L.	NEW W.F.L.

GAUGE CONVERSION DRAWING FOR BE No. 117

SOUTH CENTRAL RAILWAY



CAO / C / O / SC DRG. NO. CAO/C/BR/15-91 (cont)

GUNTUR - GUNTAKAL SECTION

CONVERSION OF TRACK FROM MG TO BG BETWEEN
NANDYAL AND DRONACHELLAM STATIONS
BRIDGE NO. 117. AT KM. 329/329.102.1X 3.05 M. GIRDER
REPLACED WITH 1X 3.05 M PRE CAST BG RCC SLAB
DULY STRENGTHENING SUB. STRUCTURE BETWEEN
MALKAPURAM AND DRONACHELLAM STATIONS

VERIFIED BY ME	
SIGNATURE	
NAME	C. SHAMANNA
DESIGNATION	AB / C / GC / NDL JE / C / GC / NDL

SCALE 1: 50.

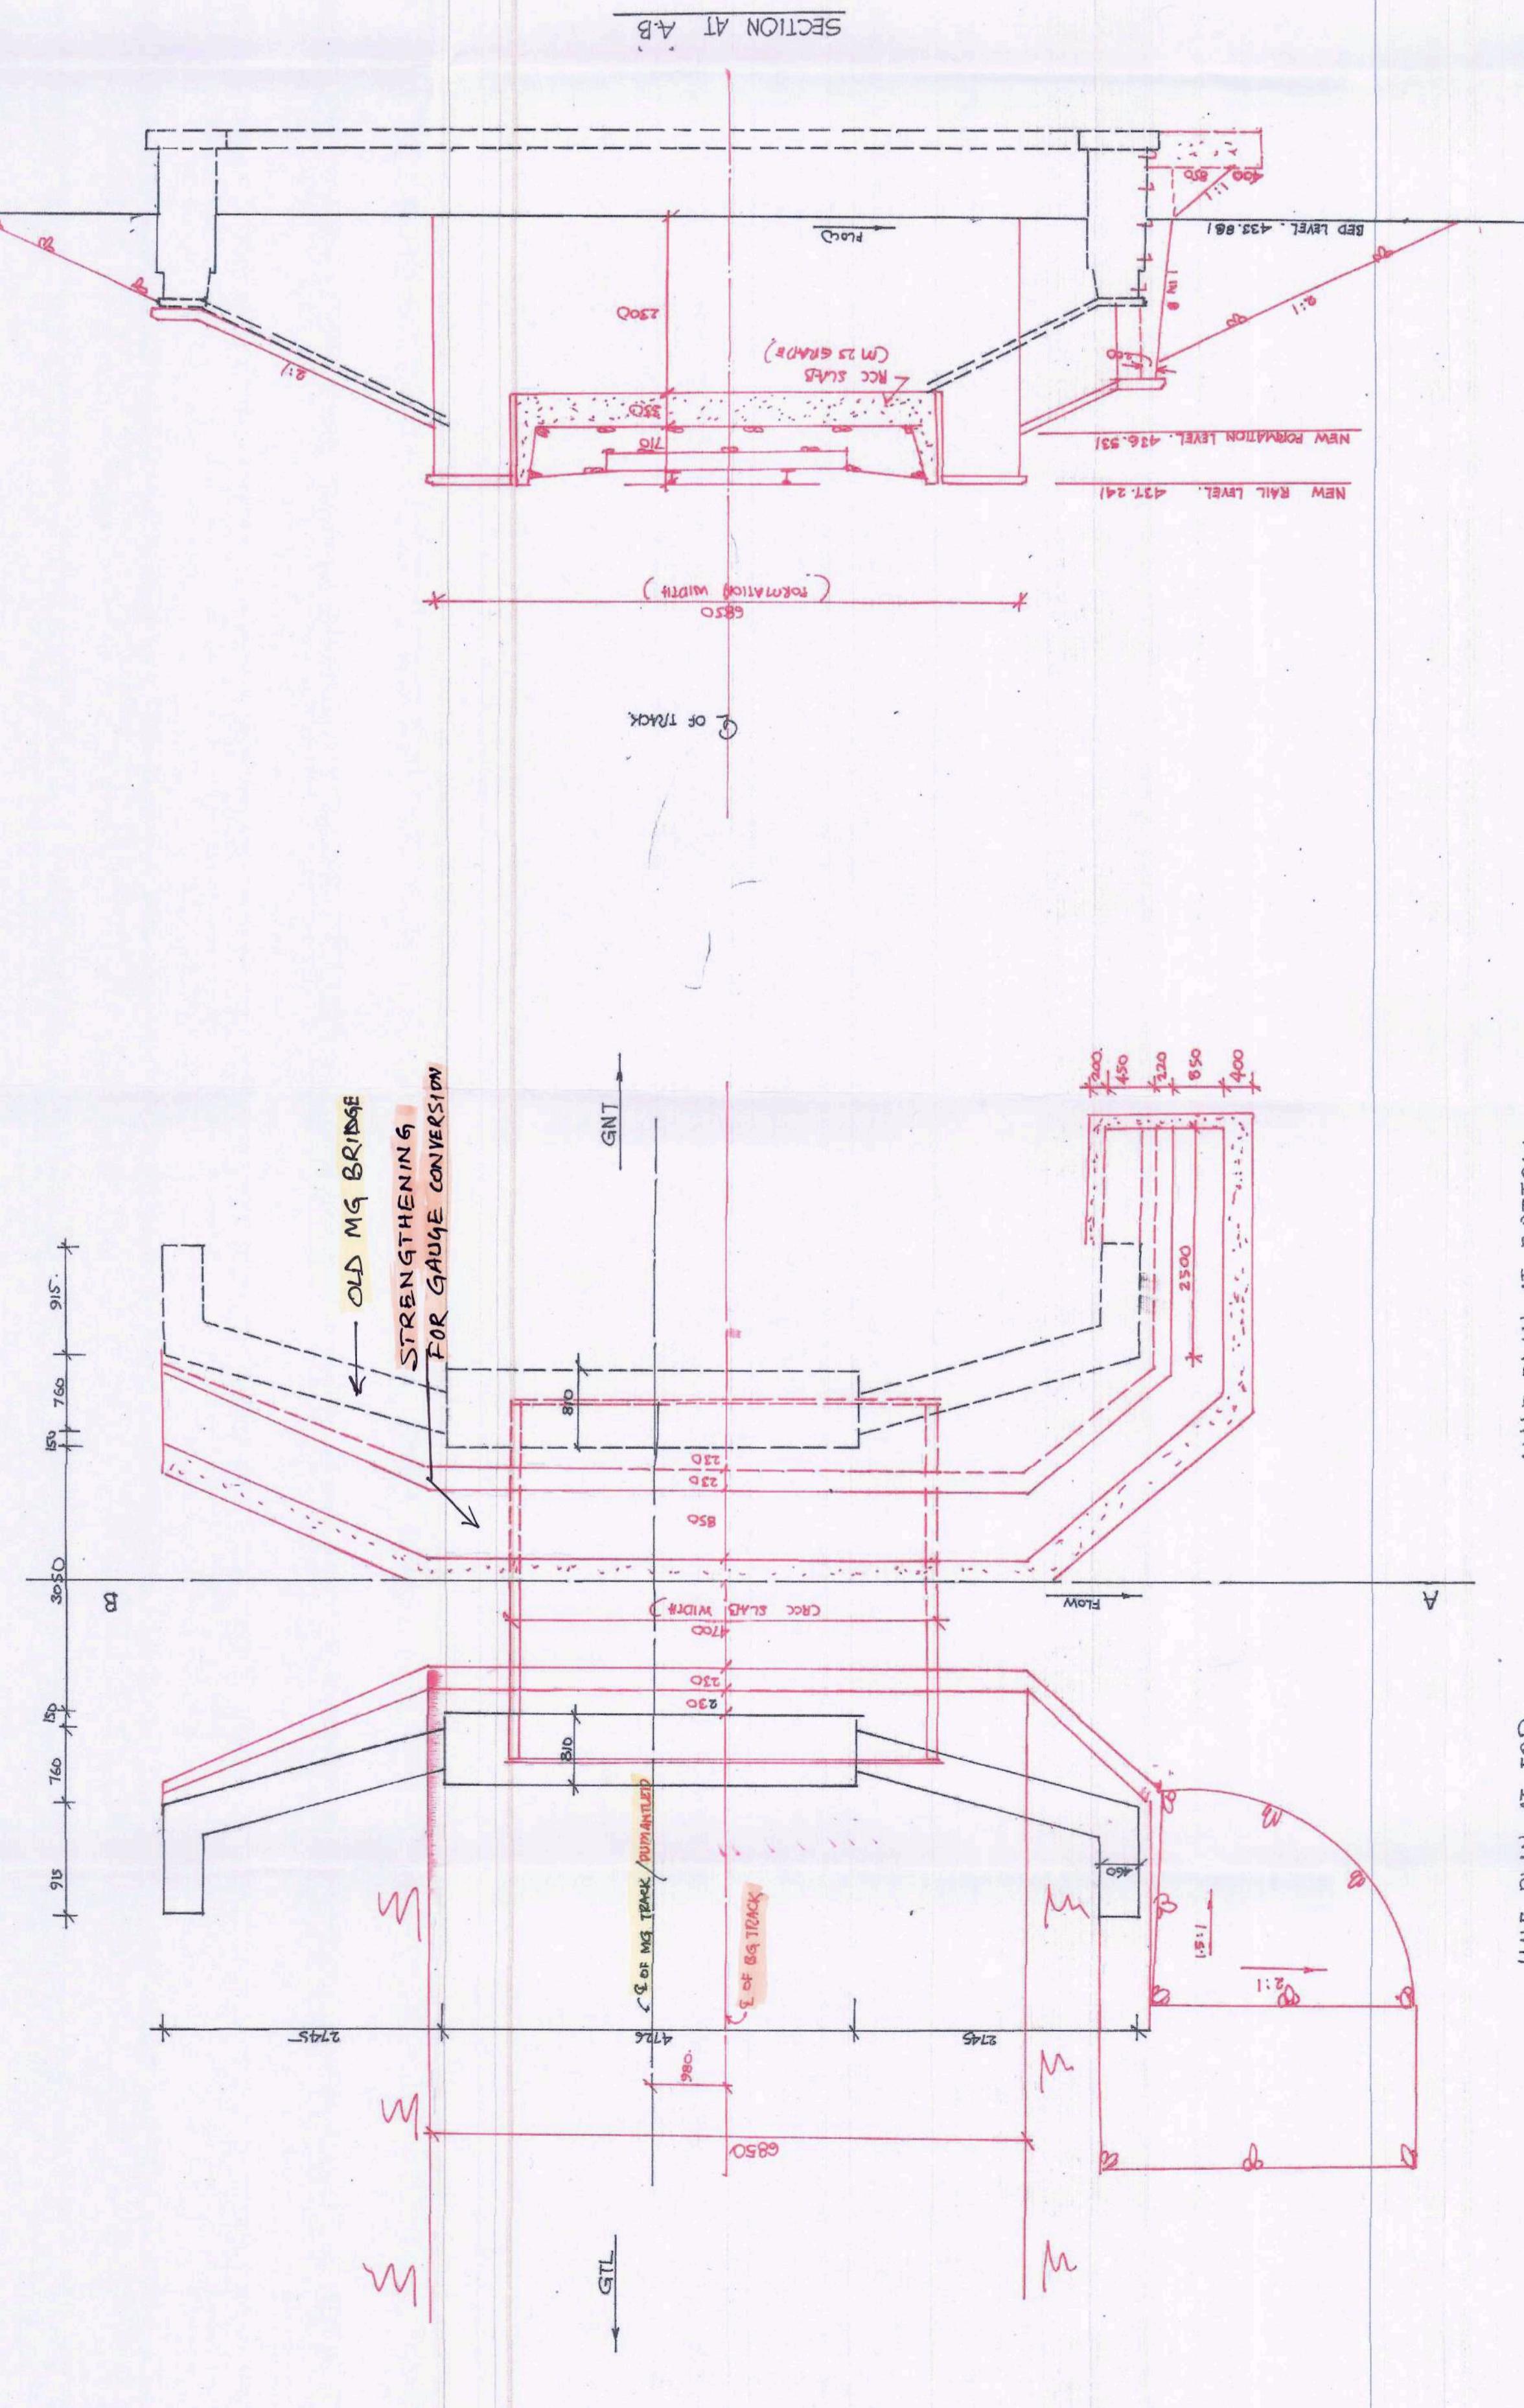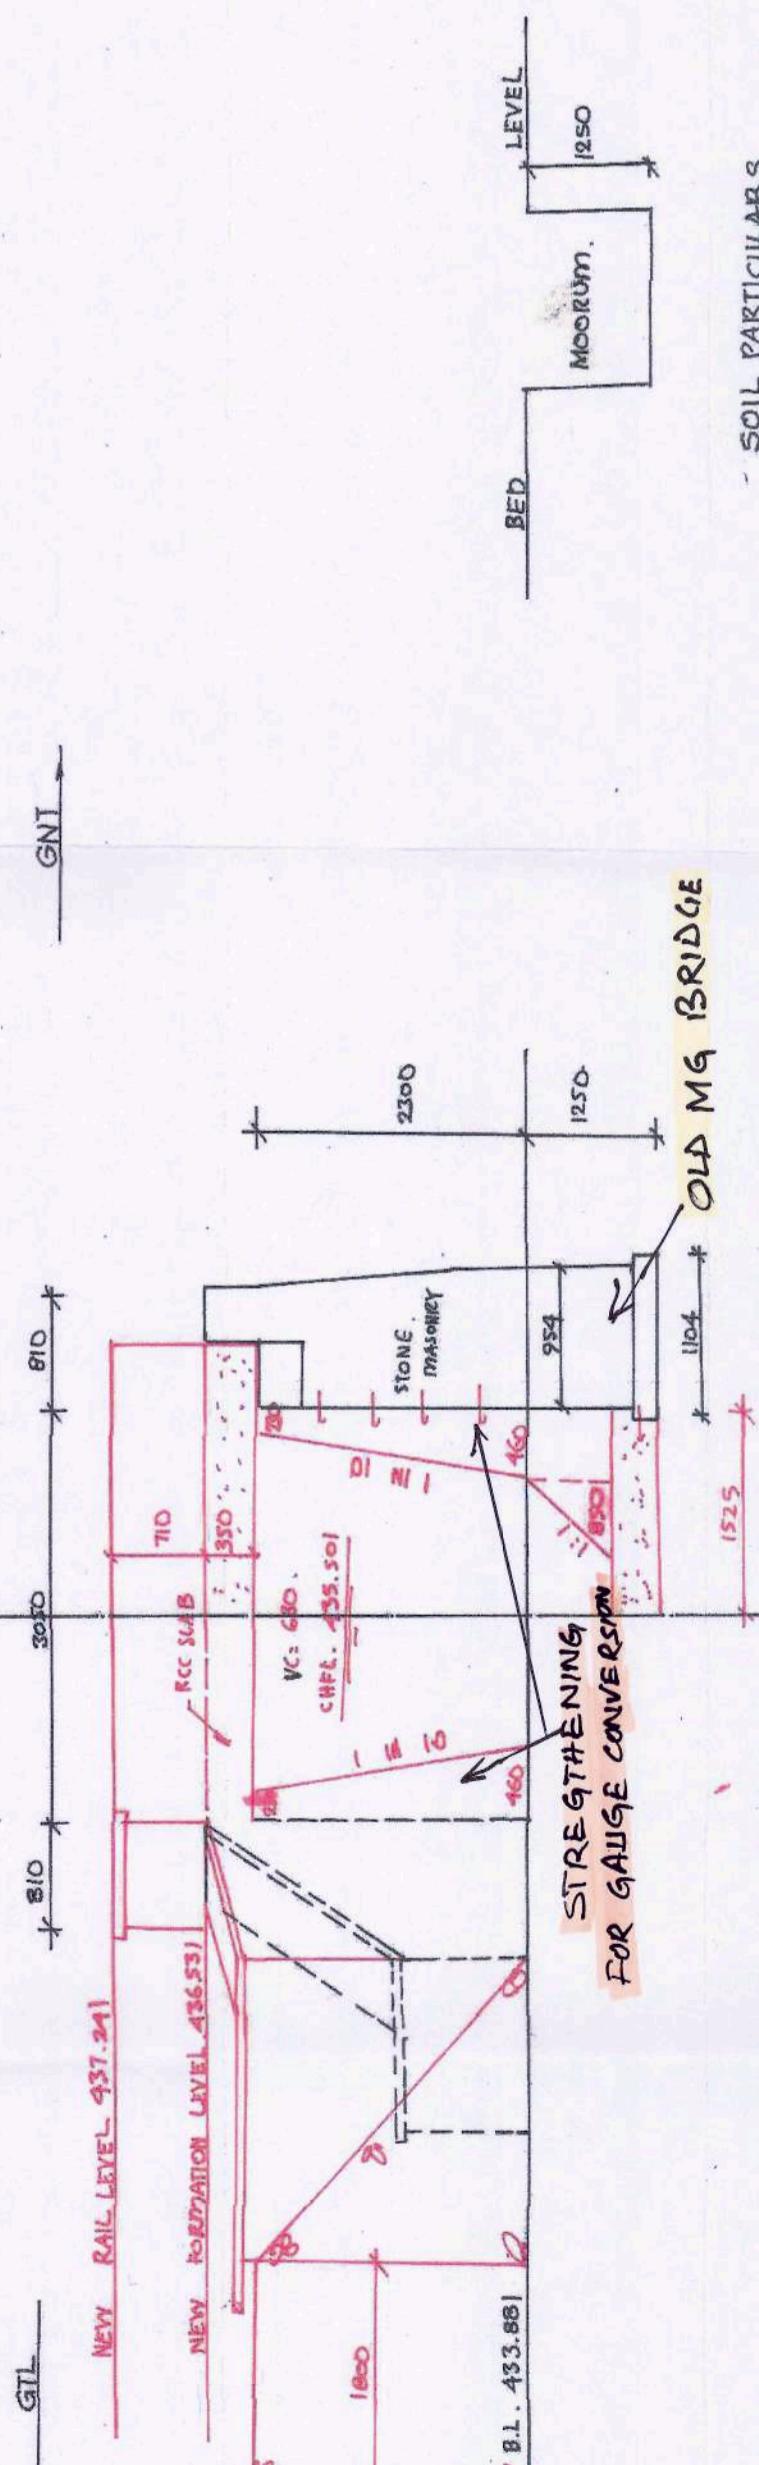


CERTIFIED THAT THE WORK HAS BEEN EXECUTED
AND COMPLETED AS PER THIS DRAWING

COUNTER SIGNED

(R. SUNDARA RAJAN, CE-C-HL/SC)
FOR CHIEF ADMINISTRATIVE OFFICER (Cen)
S.C. RAILWAY, SECUNDERABAD.

COMPLETION DRAWING

Q. of BR NO. 123 At Km. 332/7M N.D

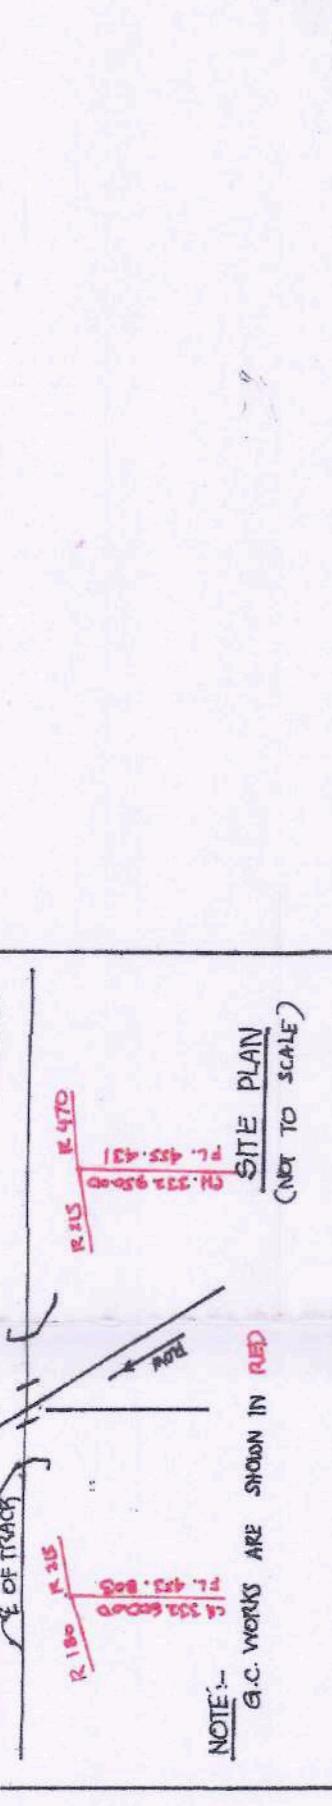

NOTES:-
1. ALL DIMENSIONS ARE SHOWN IN MILLIMETERS.
2. THE WORKS ARE TO BE DONE DURING CONSTRUCTION.
3. DEPTH OF FOUNDATION SHOWN IN THE DRAWING IS ACTUAL AND AS ERECTED AT SITE.







**GALLE CONVERSION COMPLETION
DRAWING FOR BR NO. 123**

SOUTH CENTRAL RAILWAY
CAO/ C/ O/ SC DRG. NO. C/ BR/ 21-37 (CONT'D)



GUNTUR - GUNTAKAL SECTION
CONVERSION OF TRACKS FROM M.G TO S.G. BETWEEN
NANDYAL AND DRONACHALAM STATIONS
BRIDGE NO. 123 AT KM. 332.70M. C-2X6.10M.
1x 6.86m. + 1x 6.86m. PRE CAST RC SPAN
2X 6.10m + 1x 6.86m PRE CAST RC SPAN
STRENGTHENING SUB STRUCTURE
BETWEEN MALKAPURAM AND DRONACHELLAM STATIONS
SCALE: 1:500

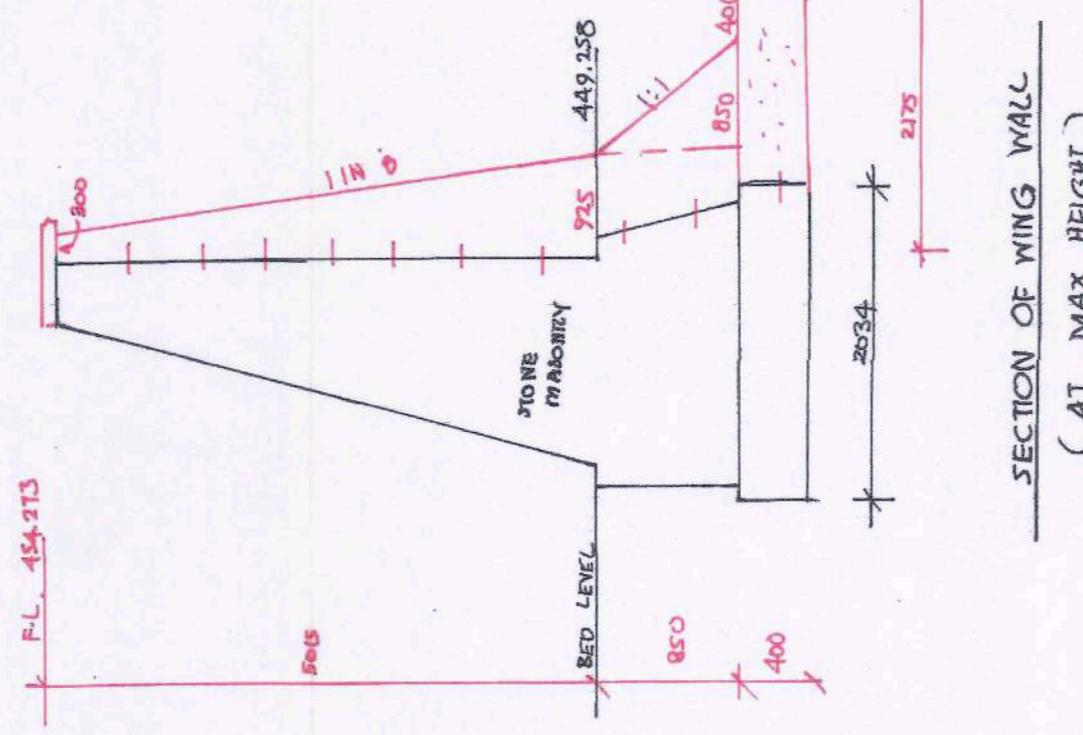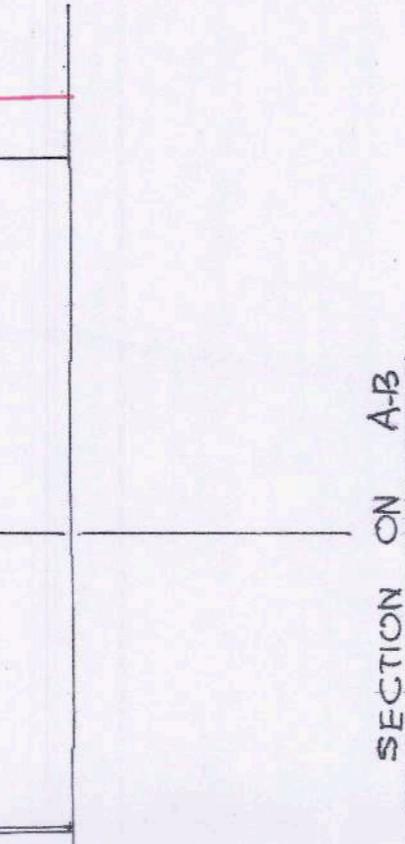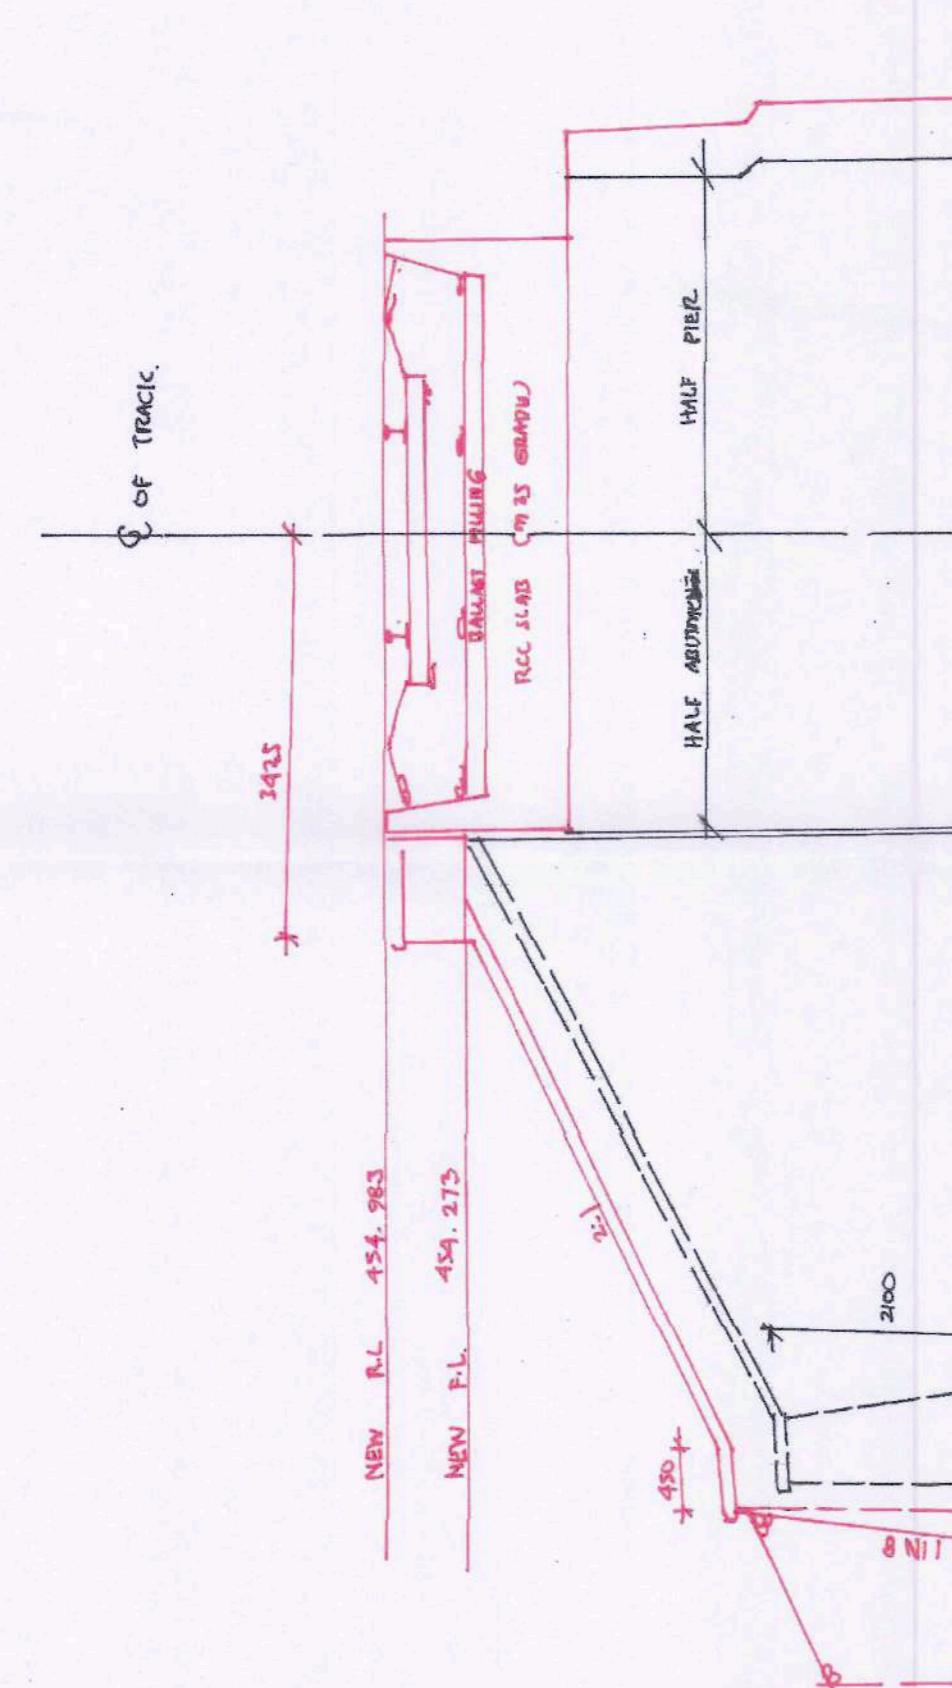

DATA FOR COMPLETION DRAWING	
REFERENCE OF WORKING DRAW.	DRG. NO. C/ BY/ 551-96
DATE OF COMMENCEMENT	7- 8- 96
DATE OF COMPLETION	8- 3- 97
AGREEMENT NO.	SI/ C/ 15/ 96/ 2- 96
AGENCY	SR. D.-H. RAU HYDRAULIC
NAME OF OFFICIAL IN CHARGE	MR. MICHAN LAL.
DEPUTY CHIEF ENGINEER	SRI. C. SIVAPPAIA
ASSISTANT ENGINEER	SRI. V. SIVARAM
SENIOR SECTION ENGINEER	ENR. R. KUMAR




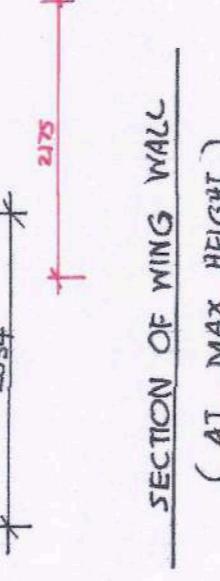


SECTIONAL ELEVATION

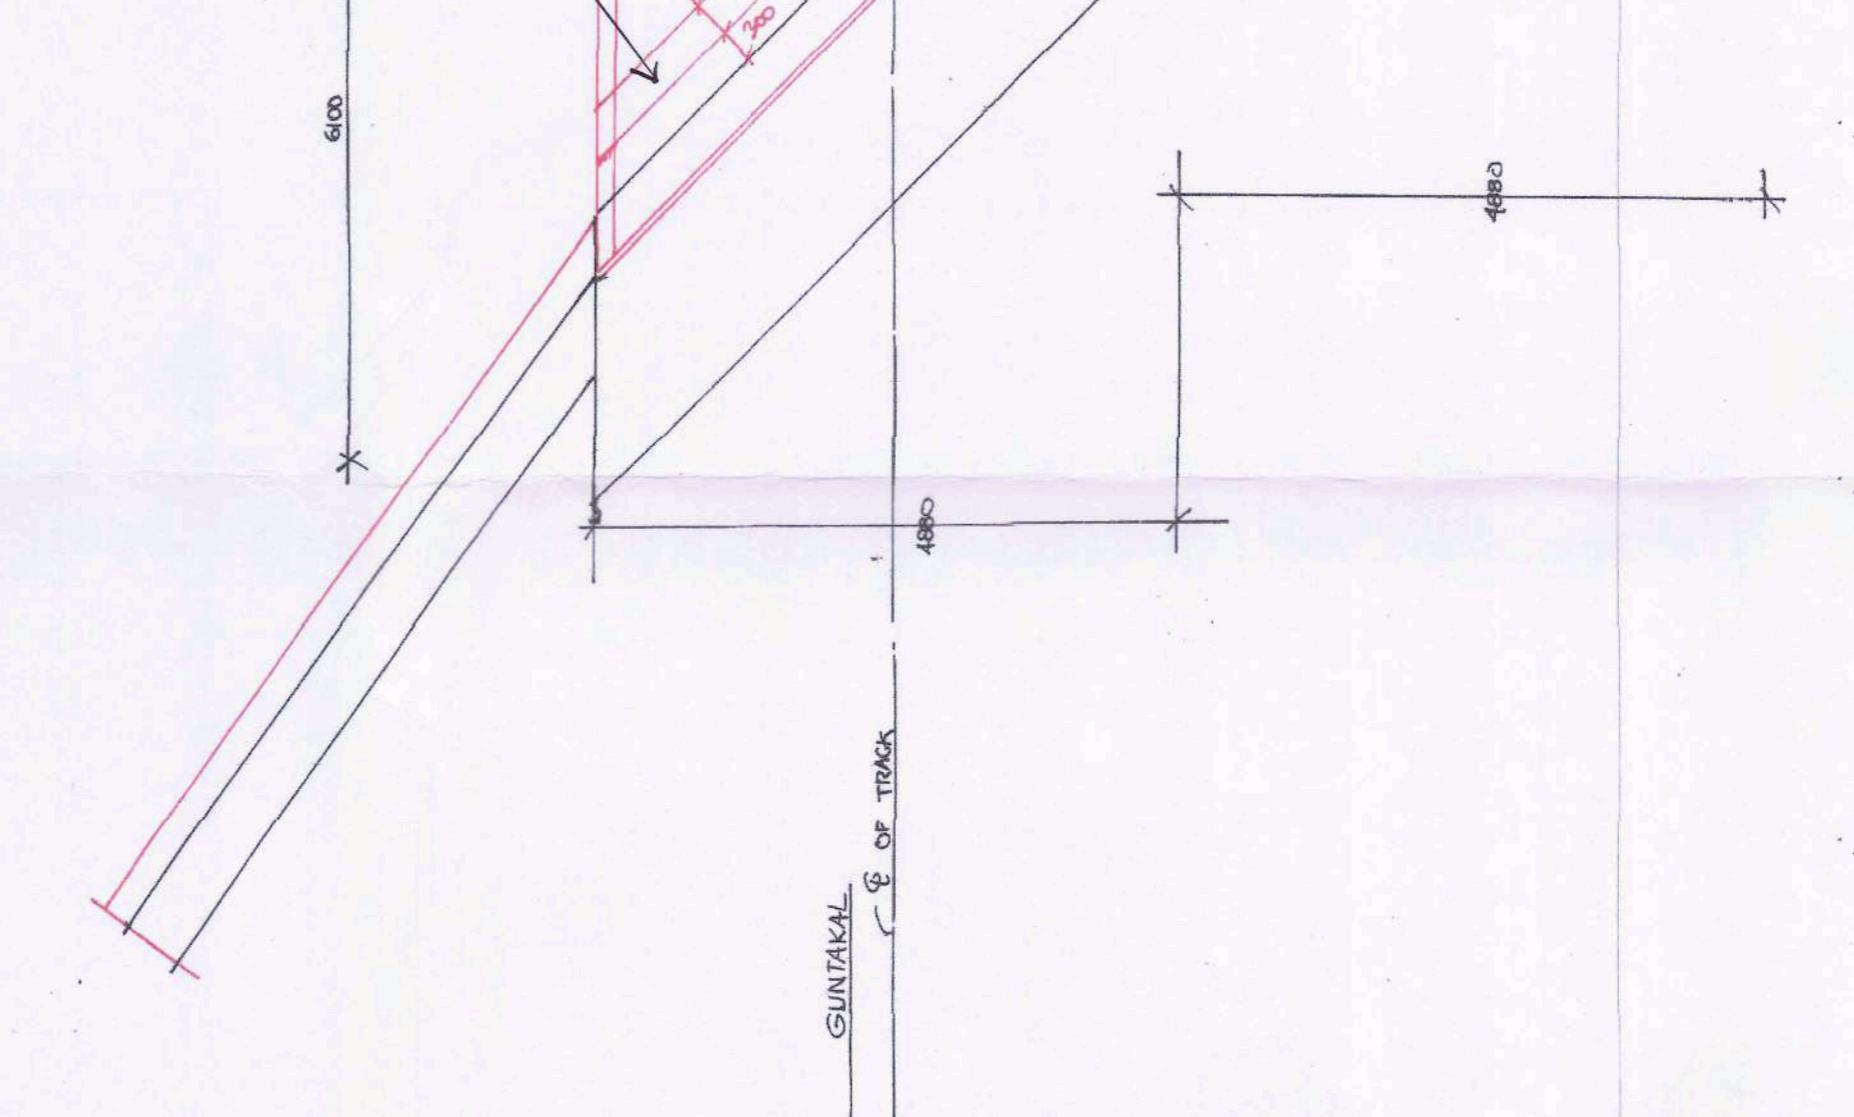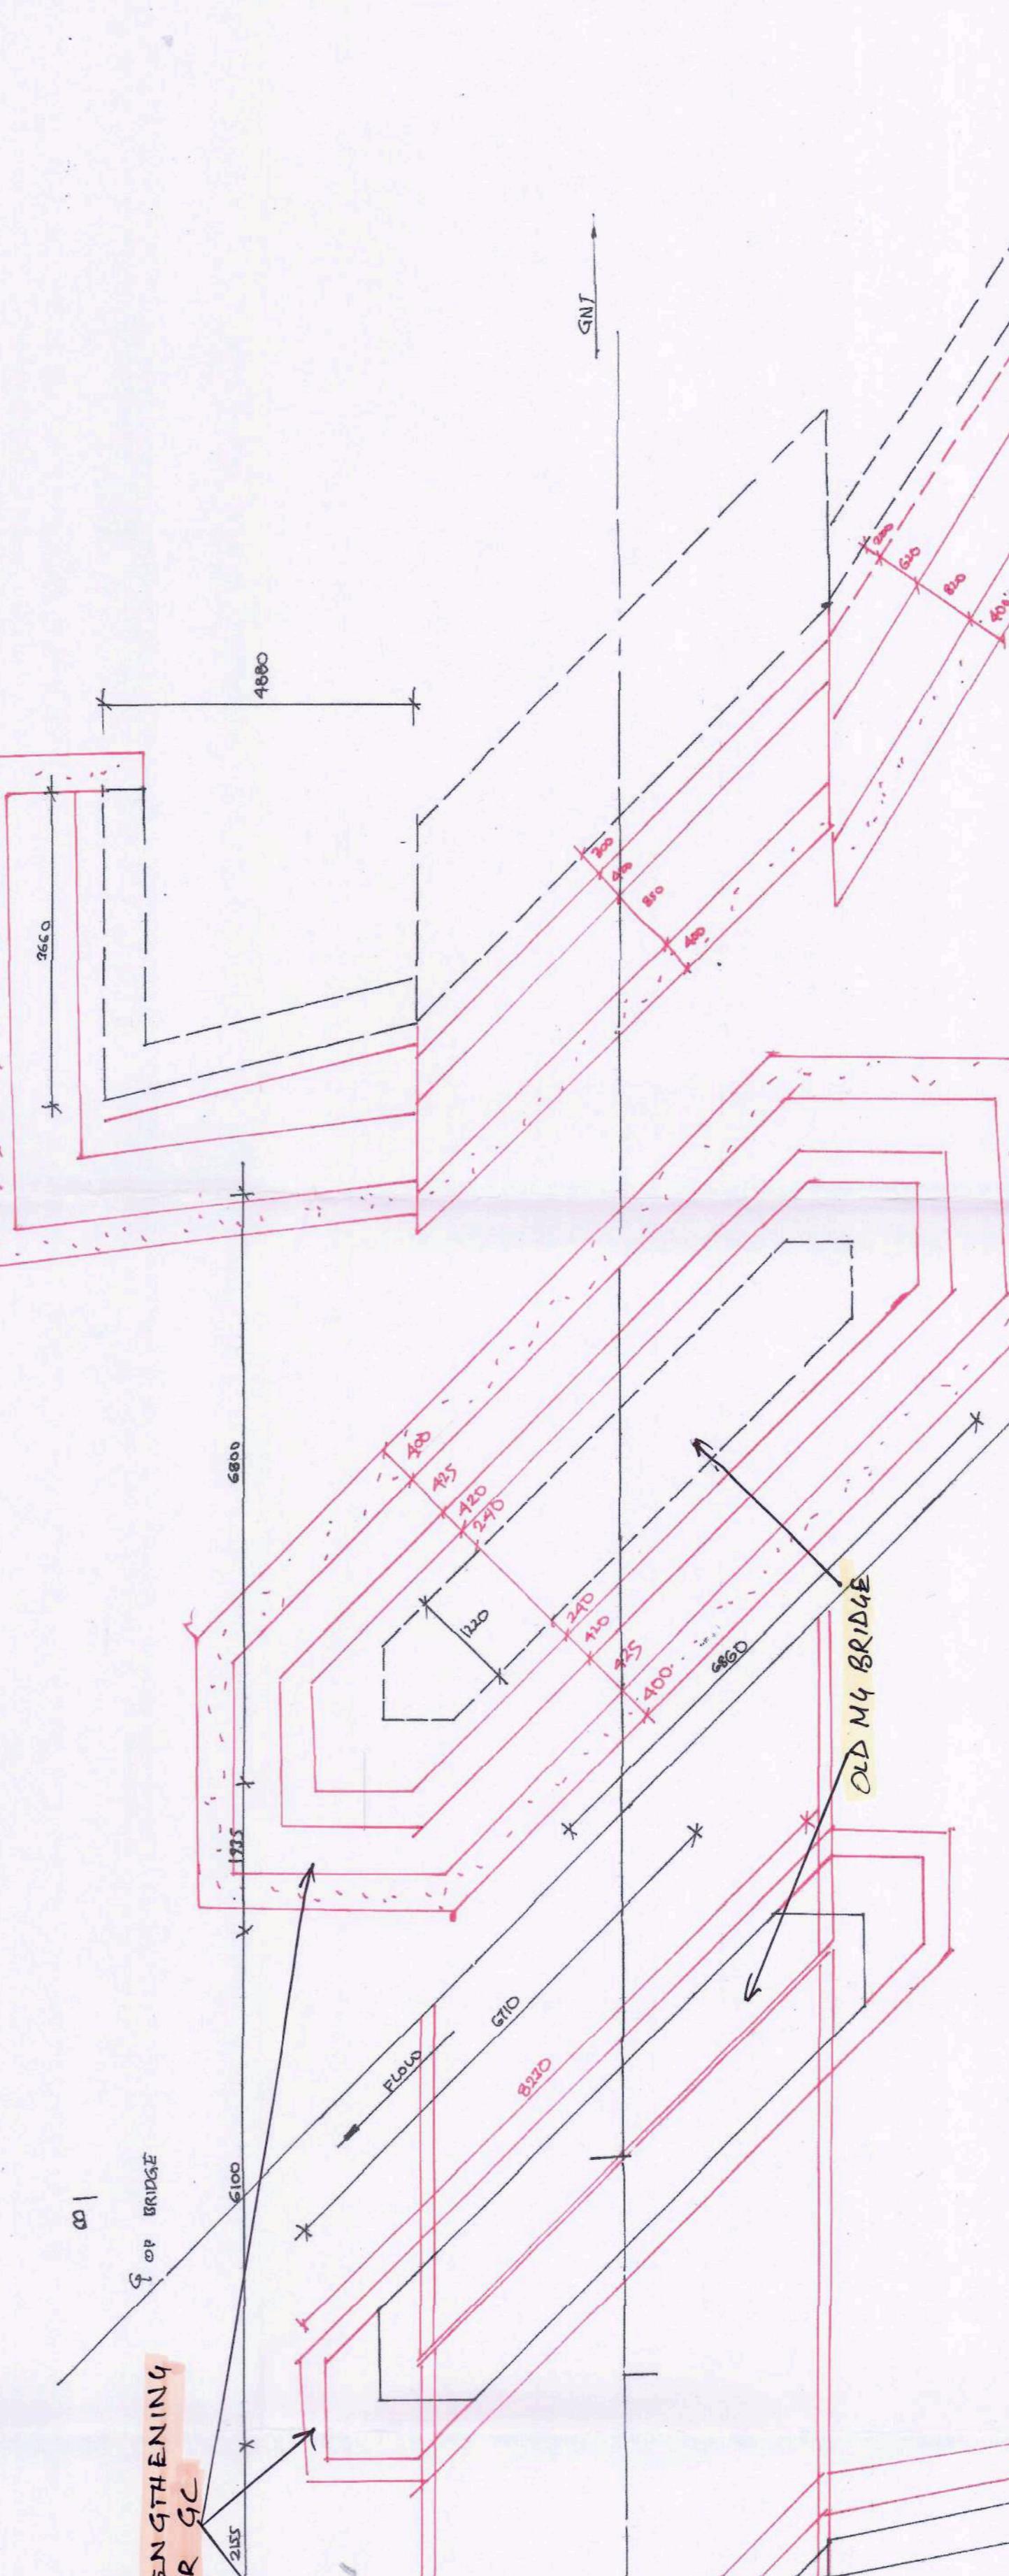

HALF PLAN AT TOP

HALF PLAN AT BOTTOM

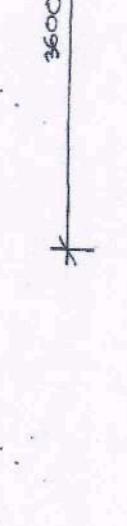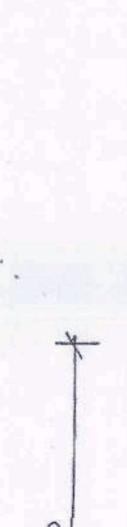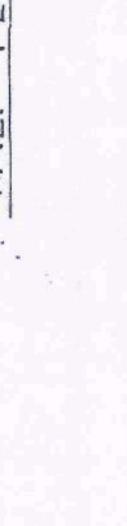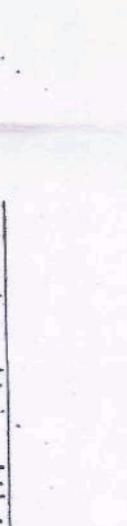

**CERTIFIED THAT THE WORK HAS BEEN EXECUTED
AND COMPLETED AS PER THIS DRAWINGS**






COMPLETION DRAWING

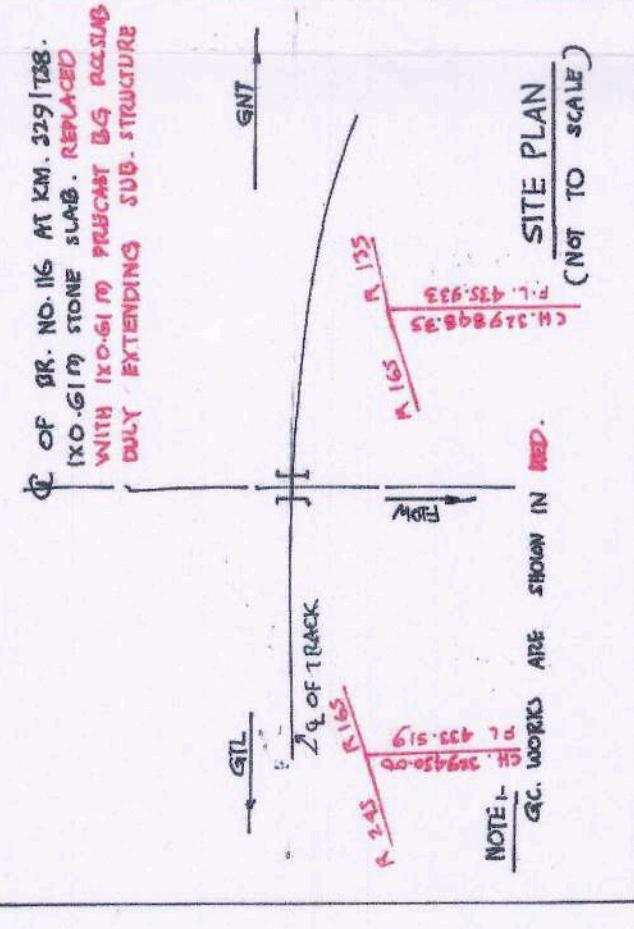

SPECIFICATIONS

- ALL DIMENSIONS ARE SHOWN IN MILLIMETERS.
- THE WORKS ARE DRAWN AS PER THE FOLLOWING STANDARD SPECIFICATIONS FOR MATERIALS AND WORKS OF 1970.
- BRIDGE CODE 1962, C (2007) READ IN CONJUNCTION WITH RELEVANT I-S. SPECIFICATIONS MENTIONED THEREIN.
- IRIS BRIDGE SUB. STRUCTURE CODE (985 C20)
- IRIS BRIDGE RULES AS PER DRGS NO. RDG/15/96.
- FOUNDATION AND SUB. STRUCTURE - CONTROLLED MASS C-20.
- GRABE LUCING 40 MM. MAX. SIDE GRADING.
- ASSESSMENT OF APPROVED QUALITY.
- IRIS SLABS > CONTROLLED CC IN 25 GRADE USING 20 MM MAX SIDE GRADED HARD SIGN AGREEMENT OF APPROVED QUALITY.
- COPING - CONTROLLED CC IN 20 GRADE USING 20 MM MAX SIDE GRADED HARD SIGN AGREEMENT OF APPROVED QUALITY.
- PITCHING - HAND PACKED ROUGH STONE PITCHING 300 THICK CERED 150 MM THICK GRAVEL BACKING CONSISTING OF WELL GRAVEL OR 100 MM. GRAVEL BINS IS DIA. WITH 5% RISES TO THE WALL OP. SPKE 600 X 600.

REFERENCES

- RCC SLABS PROVIDED AS PER DRGS NO. RDG/15/96.
- WEEP HOLES AND BACK FILLING PROVIDED AS PER DRGS. NO. GAN/C/20/193/90.
- DOWEL BARS AND ZIPPLING PROVIDED AS PER RDG DRGS NO. EPC-B/1997.

TOOKER DETAILS	


GAUGE CONVERSION WORKING
DRAWING FOR BR/NO. 16

CERTIFIED THAT THE WORK HAS BEEN EXECUTED
AND COMPLETED AS PER THIS DRAWING.


CAO / C / O / SC	DRGS. NO. GAN/C/BR/1A-97 (compe)
GUNTUR. GUNTAKAL SECTION	

CONVERSION OF TRACK FROM M.G. TO BG BETWEEN
NANDYAL AND DRONACHELLAM STATIONS
BG RCC SLAB DULY EXTENDING SUB. STRUCTURE
BETWEEN MALKAPURAM AND DRONACHELLAM
STATIONS.

SCALE: 1:50.

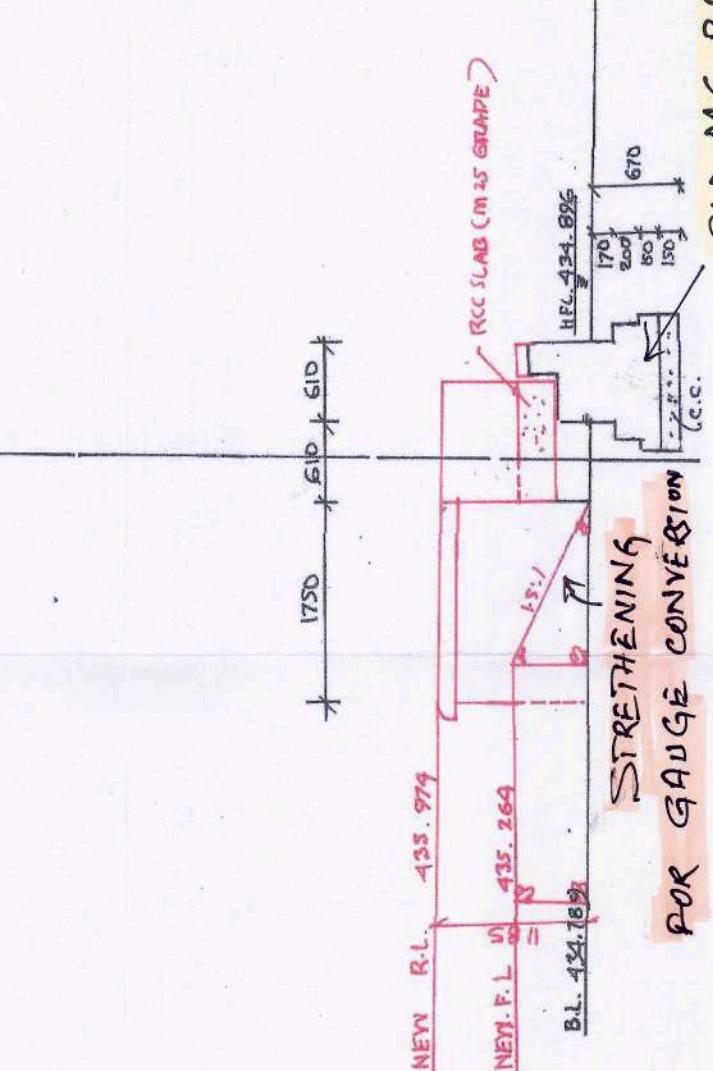

HALF ELEVATION HALF SECTION



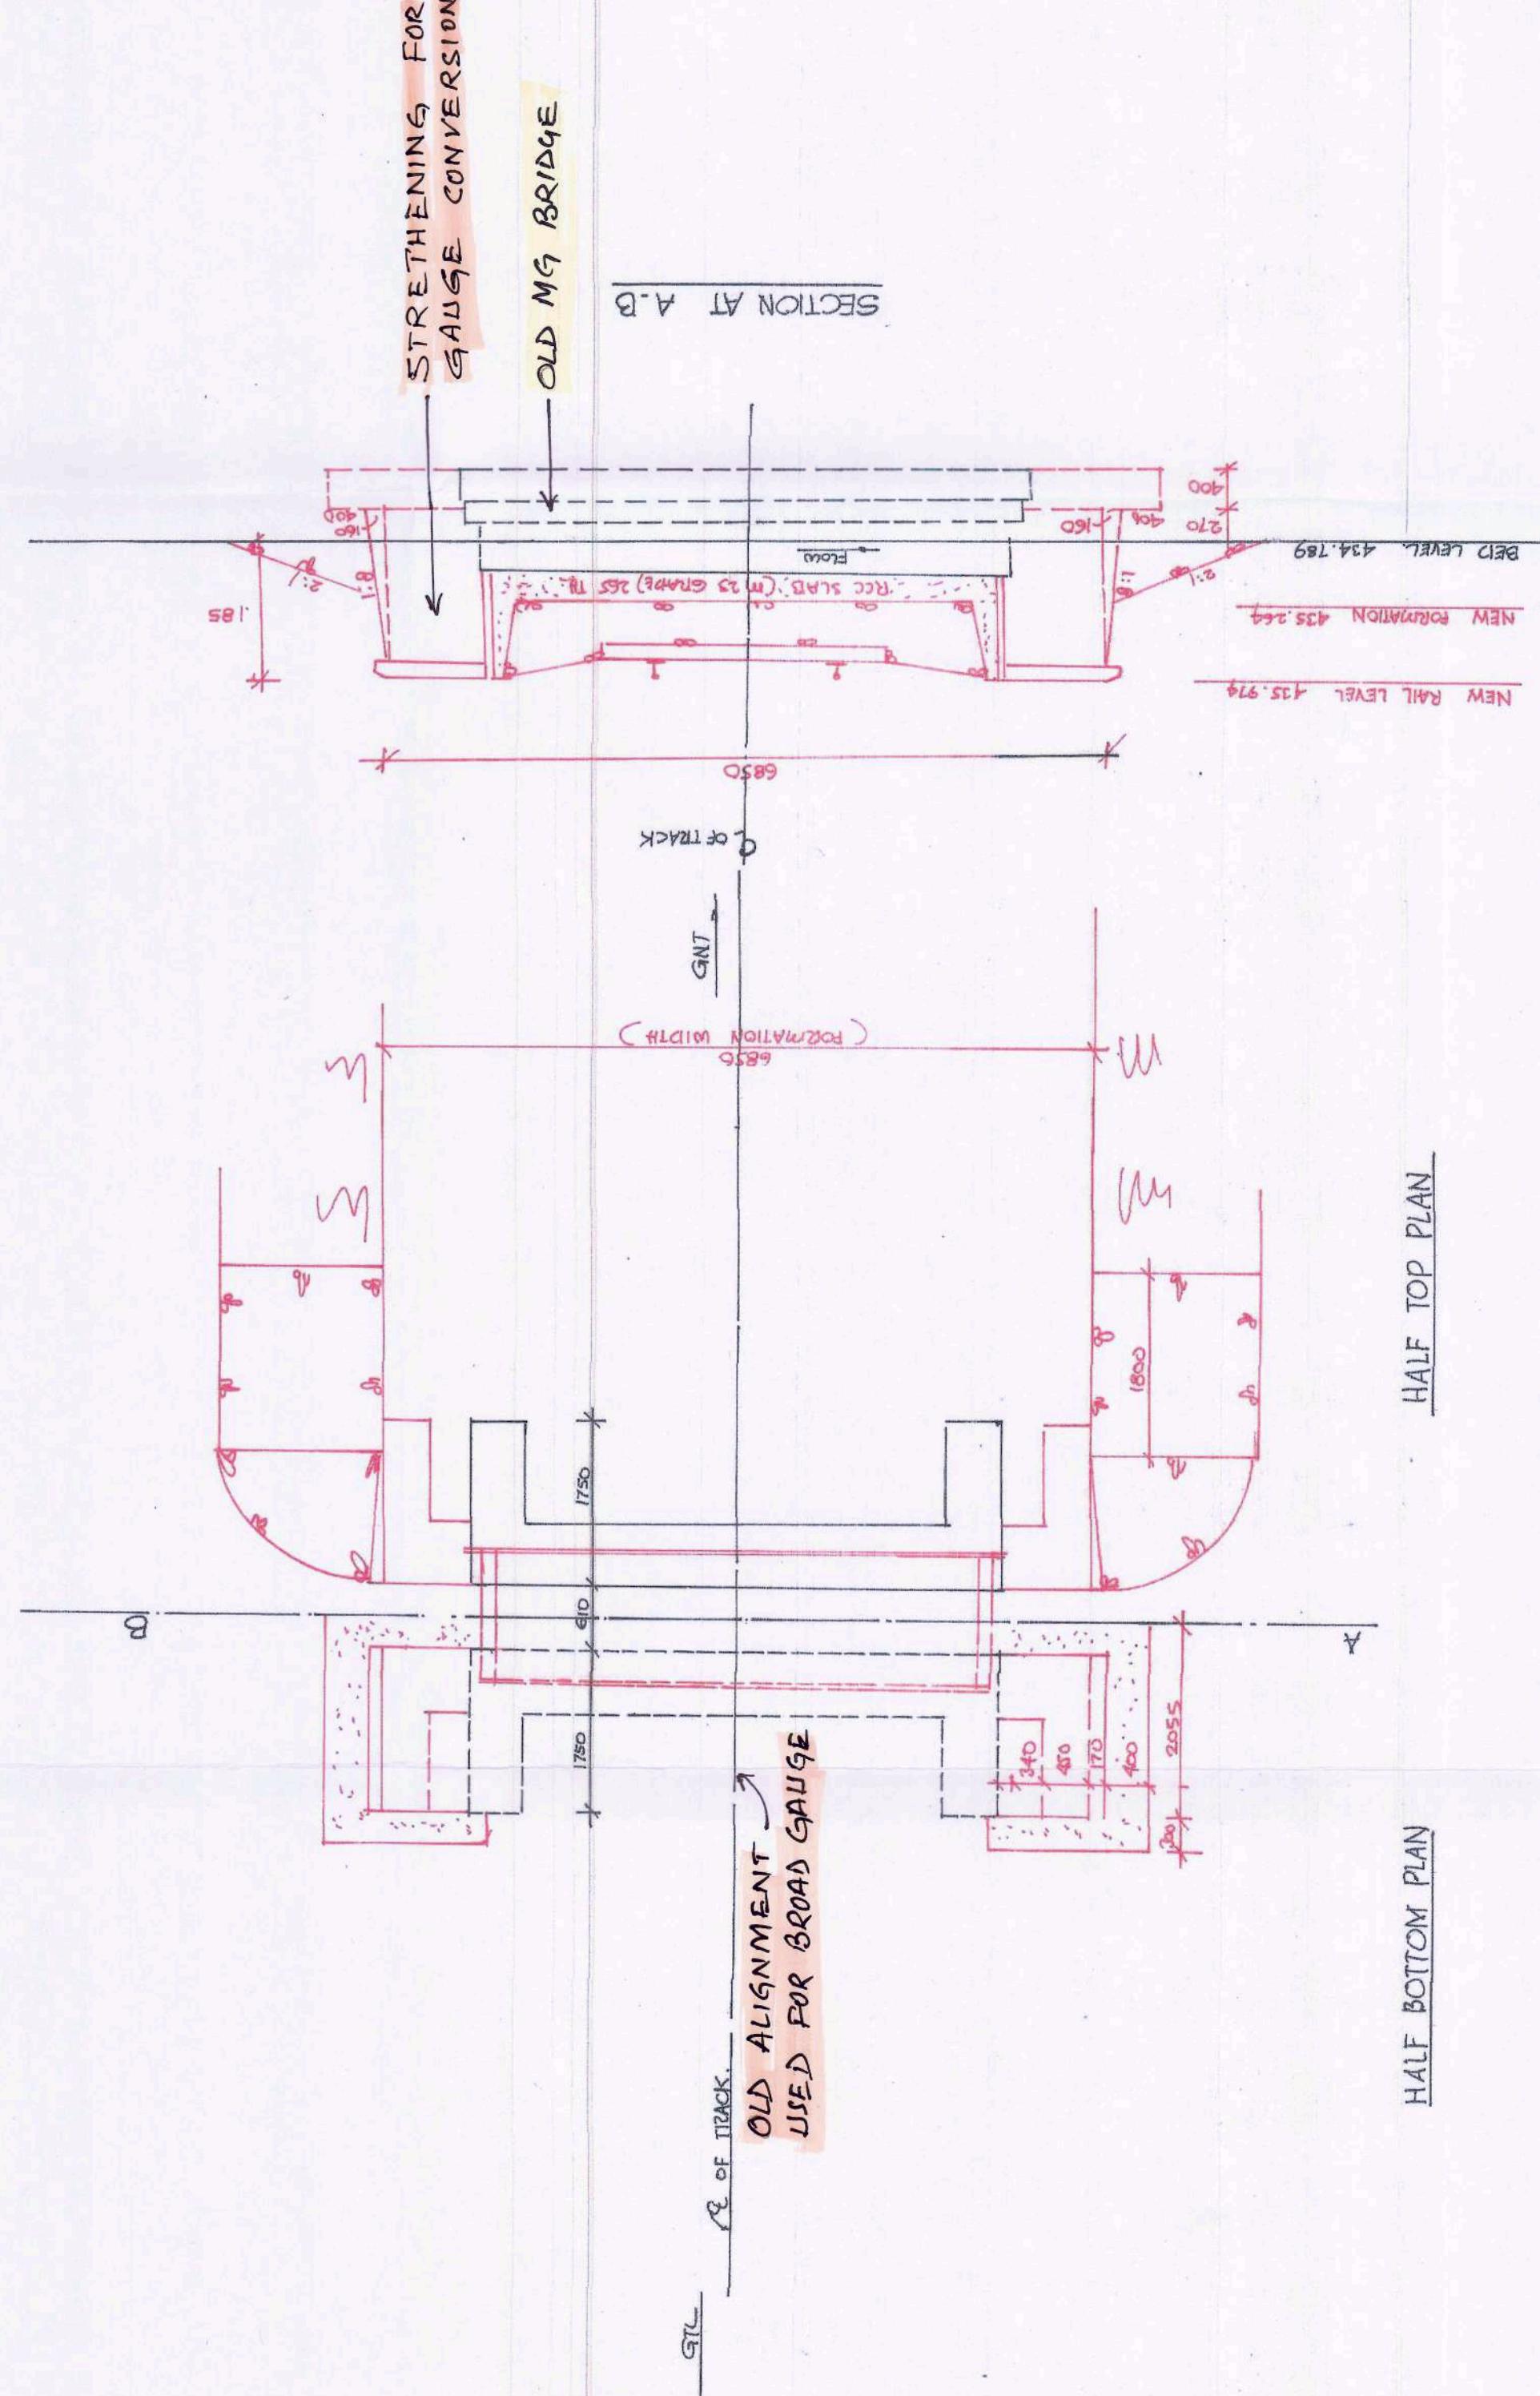


HALF BOTTOM PLAN HALF TOP PLAN

VERIFIED BY ME	SIGNATURE
NAME: G. SHARMA	
DESIGNATION: Asstt Engrg/SC/NNDL Site/C/GC/NNDL	

COUNTER SIGNED	SIGNATURE
DR. CP/C/SC	(Signature)
C. R. JADAVRAO RAYAN CE/CIV/SC CHIEF ADMINISTRATIVE OFFICER, COASTAL RAILWAY, SECUNDERABAD	

COMPLETION DRAWING

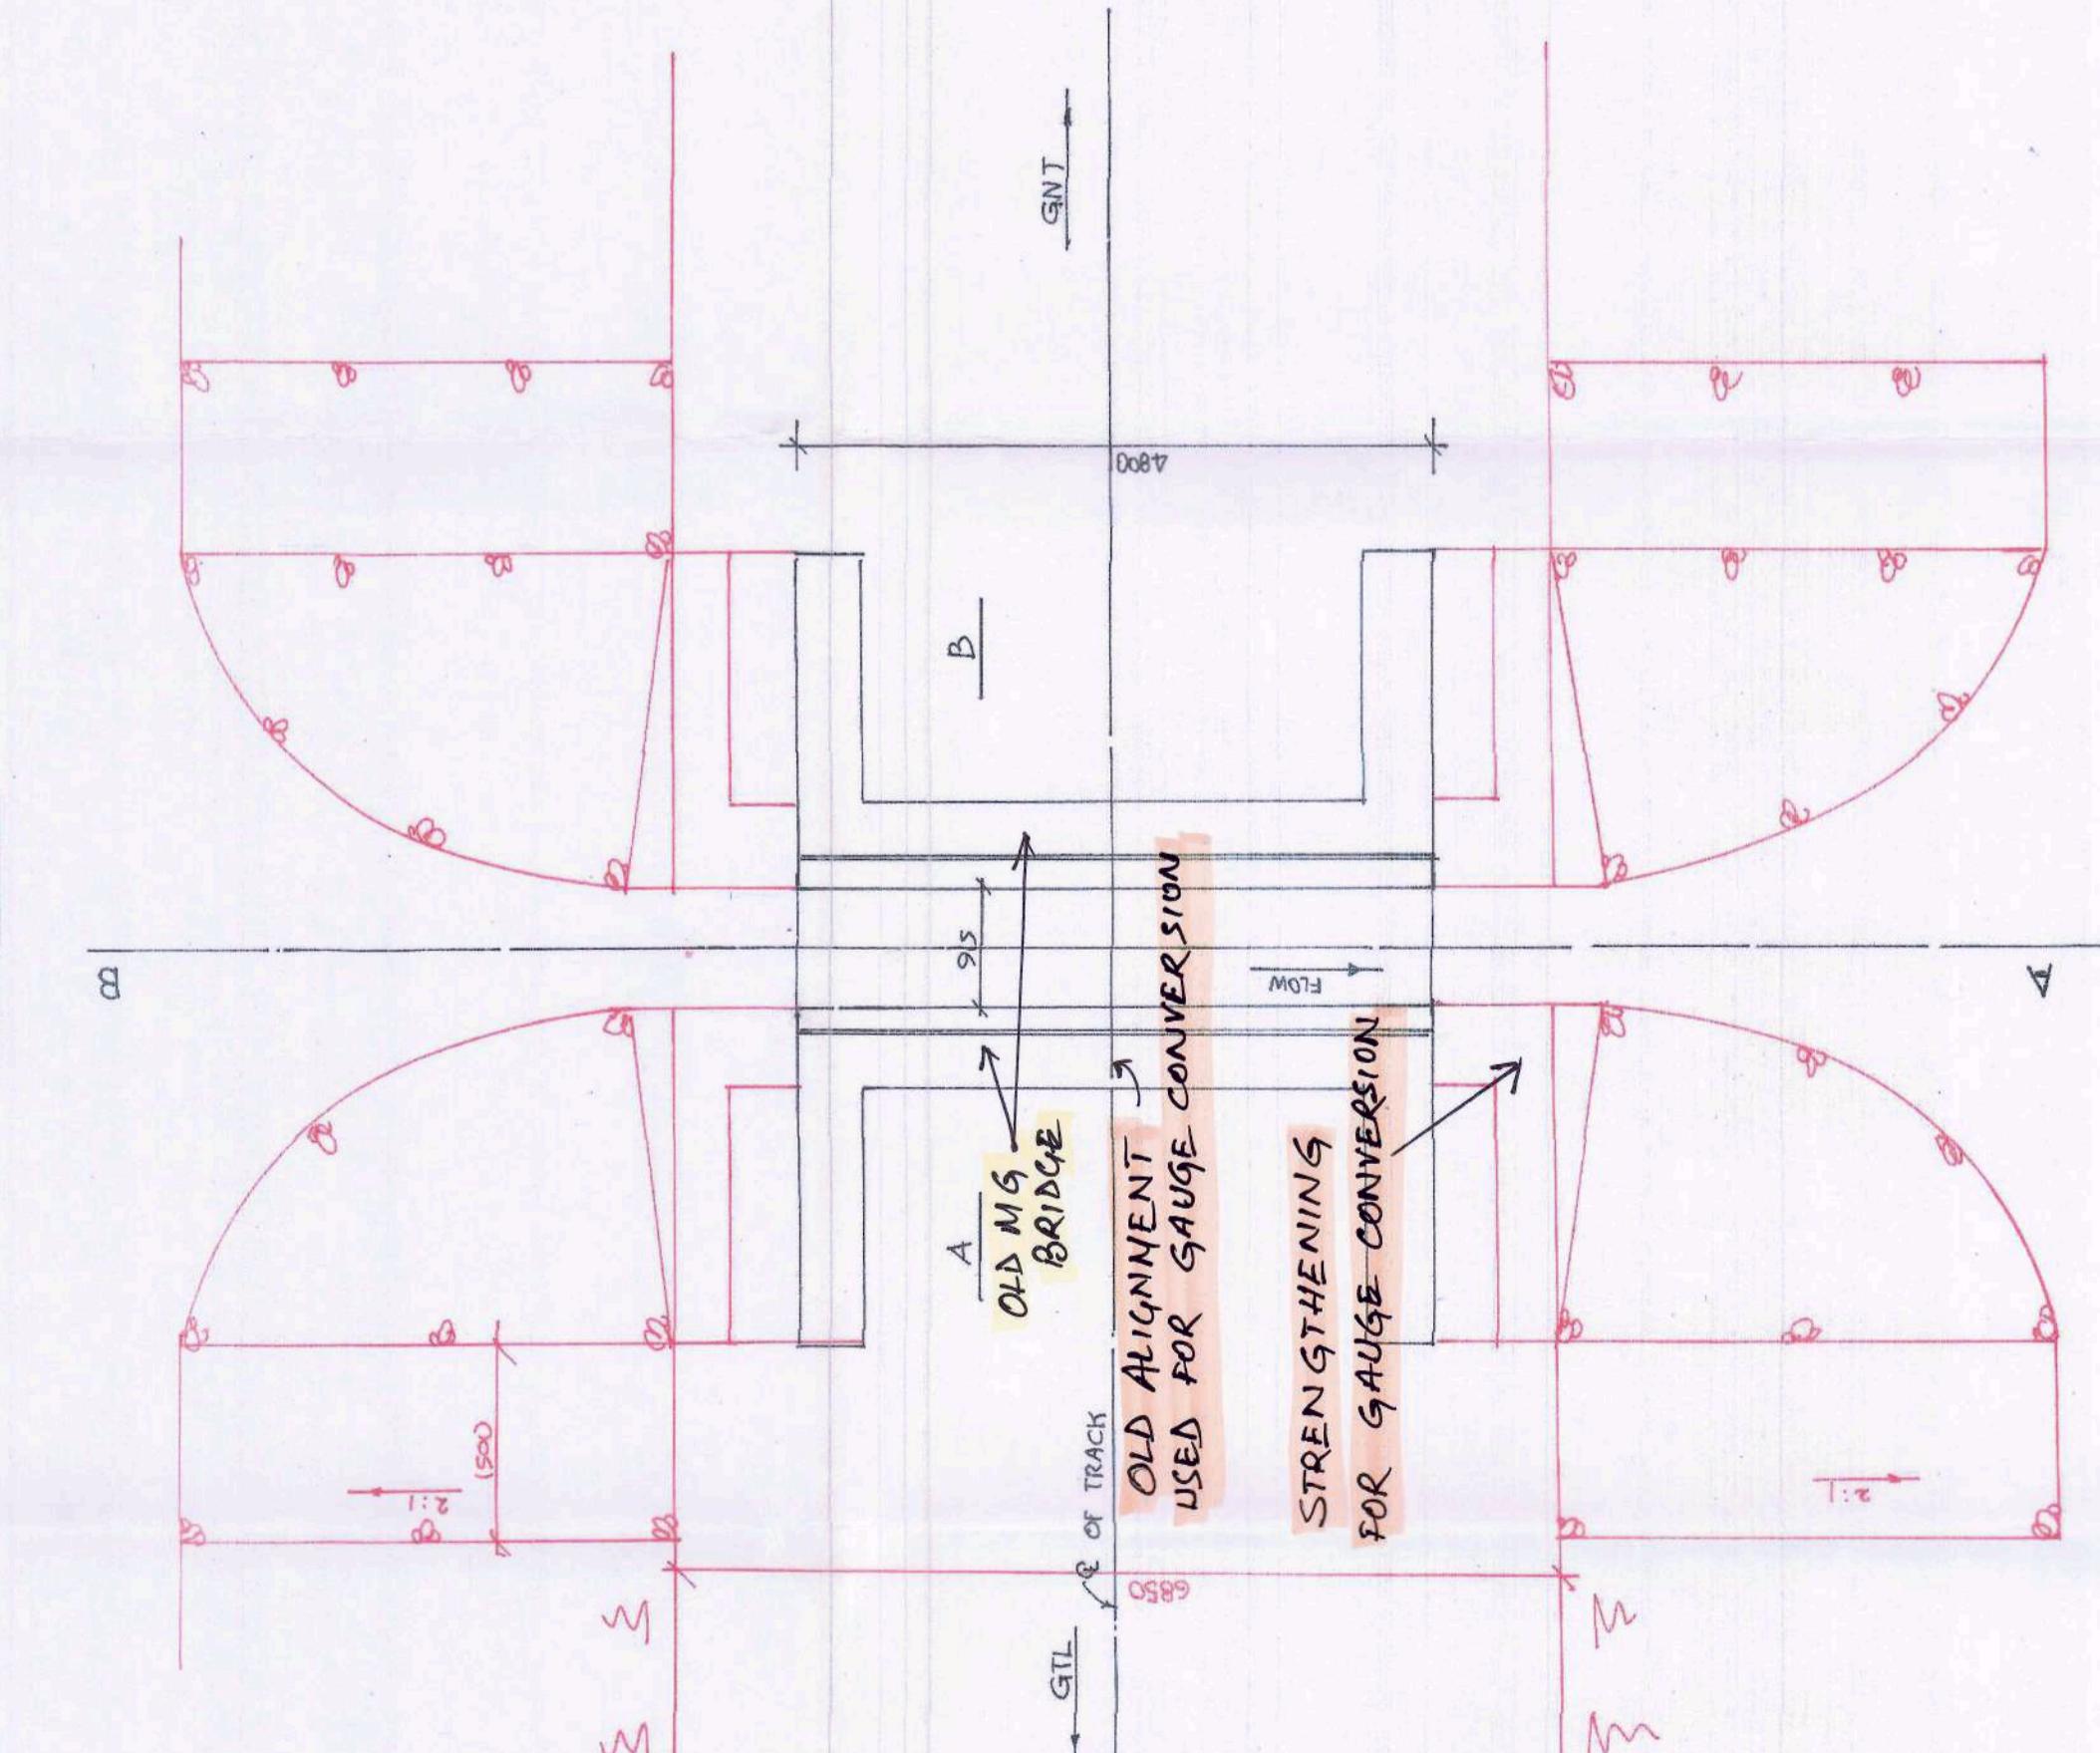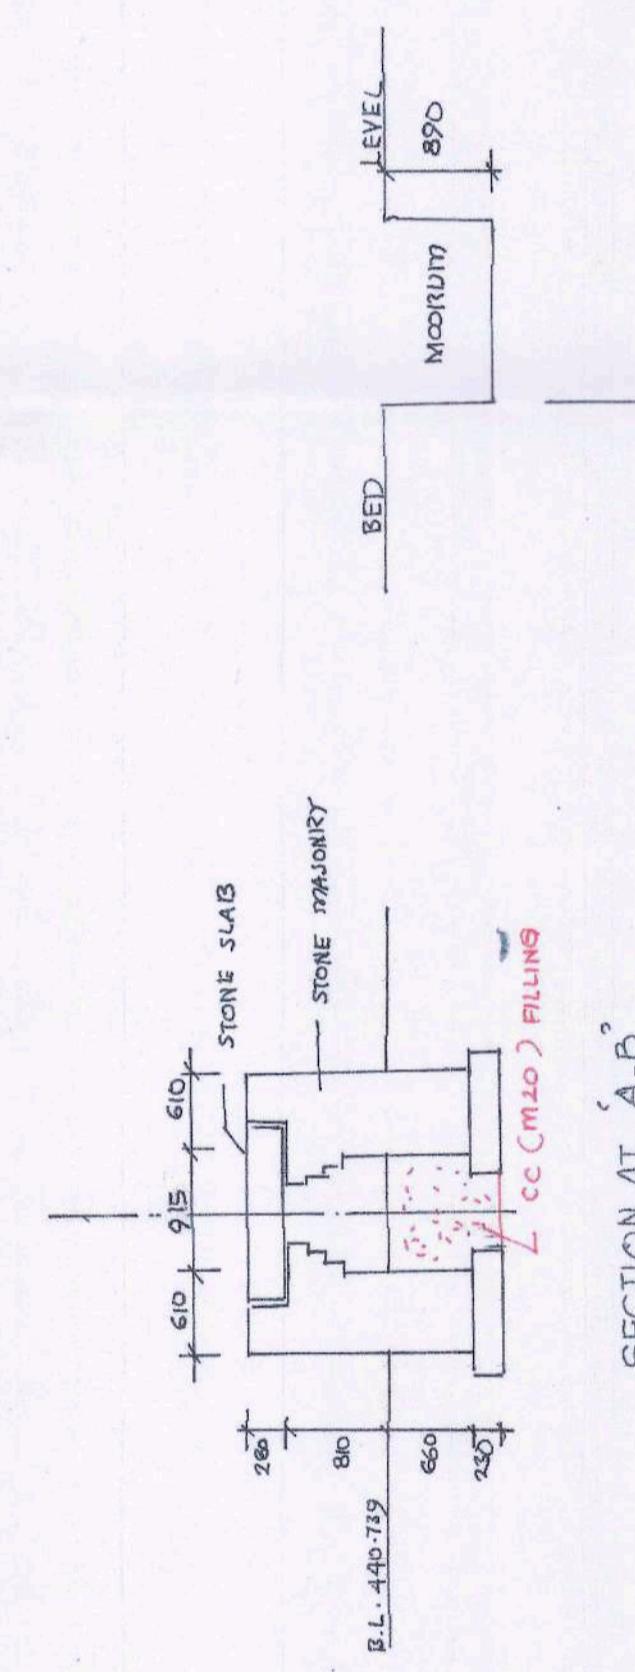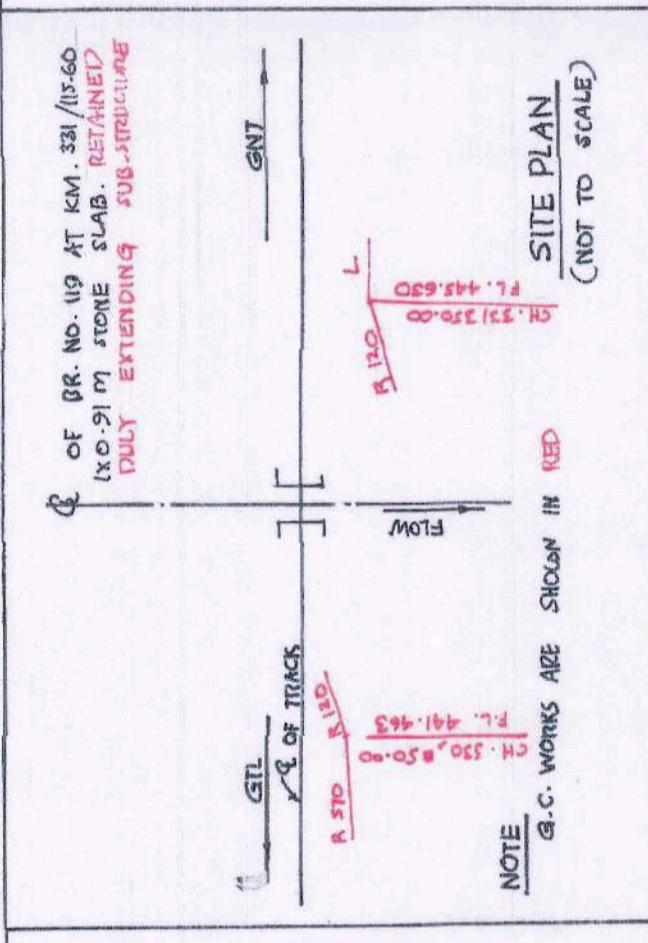

REFERENCES

1. ALL DIMENSIONS ARE SHOWN IN MILLIMETRES CUT AS PER THE FOLLOWING CUT AS FOR THE FOLLOWING STANDARD SPECIFICATIONS FOR MATERIAL AND WORKS OF IRIS BRIDGE STANDARDS AS PER IRIS CODE 945 (CODE) READ IN CONJUNCTION WITH RELEVANT I.S. SPECIFICATIONS MENTIONED THEREIN.
2. FOUNDATION :- CONTROLLED MASS. C.I. IN 2D GRAINED HARD STONE ASSEMBLIES OF APPROVED QUALITY.
3. SUB STRUCTURE :- CONTROLLED MASS. C.I. IN 2D GRAINED HARD STONE ASSEMBLIES OF APPROVED QUALITY.
4. GROUTING :- CONTROLLED CC IN 2D GRAINED HARD STONE ASSEMBLIES OF APPROVED QUALITY.
5. PITCHING :- HAND PICKED ROUGH STONE PITCHING 300 THICK OVER GRAVEL OF MAX. SIDE BEING 150 MM. SIDE BEING 150 MM. SIDE BEING 150 MM.
6. FLOORING:- ROUGH STONE PLADING 300 THICK WITH UCAU MACHINERY DROPPED ON TO THE CHIR. CC. FOUNDATION.


REFERENCES

DATA FOR COMPLETION DRAWING	
REFERENCE OF WORKING DRAWING	C.R.O./C/BR/ 835/35
DATE OF COMMENCEMENT	20-6-96
DATE OF COMPLETION	17-11-96
AGREEMENT NO.	73/C.R.O./C/8/96 Dt 16.5.96
AGENCY	SRI. A. VENKATESWARA REDDY HYDERABAD.
NAMES OF OFFICIAL IN-CHARGE	
DEPUTY CHIEF ENGINEER,	SRI. TIRUPATHI LAL.
ASSISTANT ENGINEER,	SRI. C. SHARANNA
SENIOR SECTION ENGINEER	SRI. R. SUNDARAM.

TRACK DETAILS	
LOADING - 2 WHEELS	STRAIGHT
GRADE	NEW R.L. 444.366
NEW F.L.	443.616
NEW R.L.	443.616

GAUGE CONVERSION COMPLETION DRAWING FOR BRIDGE NO. 119

CERTIFIED THAT THE WORK HAS BEEN EXECUTED
AND COMPLETED AS PER THIS DRAWING.

C. SHARANNA AEV/C/AC/NDL	C. SHARANNA DR/C/AC/NDL
CONVERSION OF TRACK FROM M.G. TO B.G. BETWEEN NANDYAL AND DRONACHELLAM STATIONS	
BRIDGE NO. 119 AT K.M. 331 / 15.00 IX O.R.N. STONE SLAB, RETAINED DULY EXTENDING SUB-STRUCTURE BETWEEN MALKAPURAM AND DRONACHELLAM STATIONS	
SCALE: 1:50	

PLAN

C. SHARANNA AEV/C/AC/NDL	C. SHARANNA DR/C/AC/NDL
CONVERSION OF TRACK FROM M.G. TO B.G. BETWEEN NANDYAL AND DRONACHELLAM STATIONS	
BRIDGE NO. 119 AT K.M. 331 / 15.00 IX O.R.N. STONE SLAB, RETAINED DULY EXTENDING SUB-STRUCTURE BETWEEN MALKAPURAM AND DRONACHELLAM STATIONS	
SCALE: 1:50	

VERIFIED BY ME
<i>C. SHARANNA</i>
NAME : C. SHARANNA DESIGNATION : AEV/C/AC/NDL

