

आंध्र प्रदेश
ANDHRA PRADESH

FIRST EDITION


INDIA
REFER TO THIS MAP AS 1:50,000
SHEET 48 1/16 FIRST EDITION

VISHAKHAPATNAM DISTRICT.

Surveyed 1975-76


No. 65 1/16

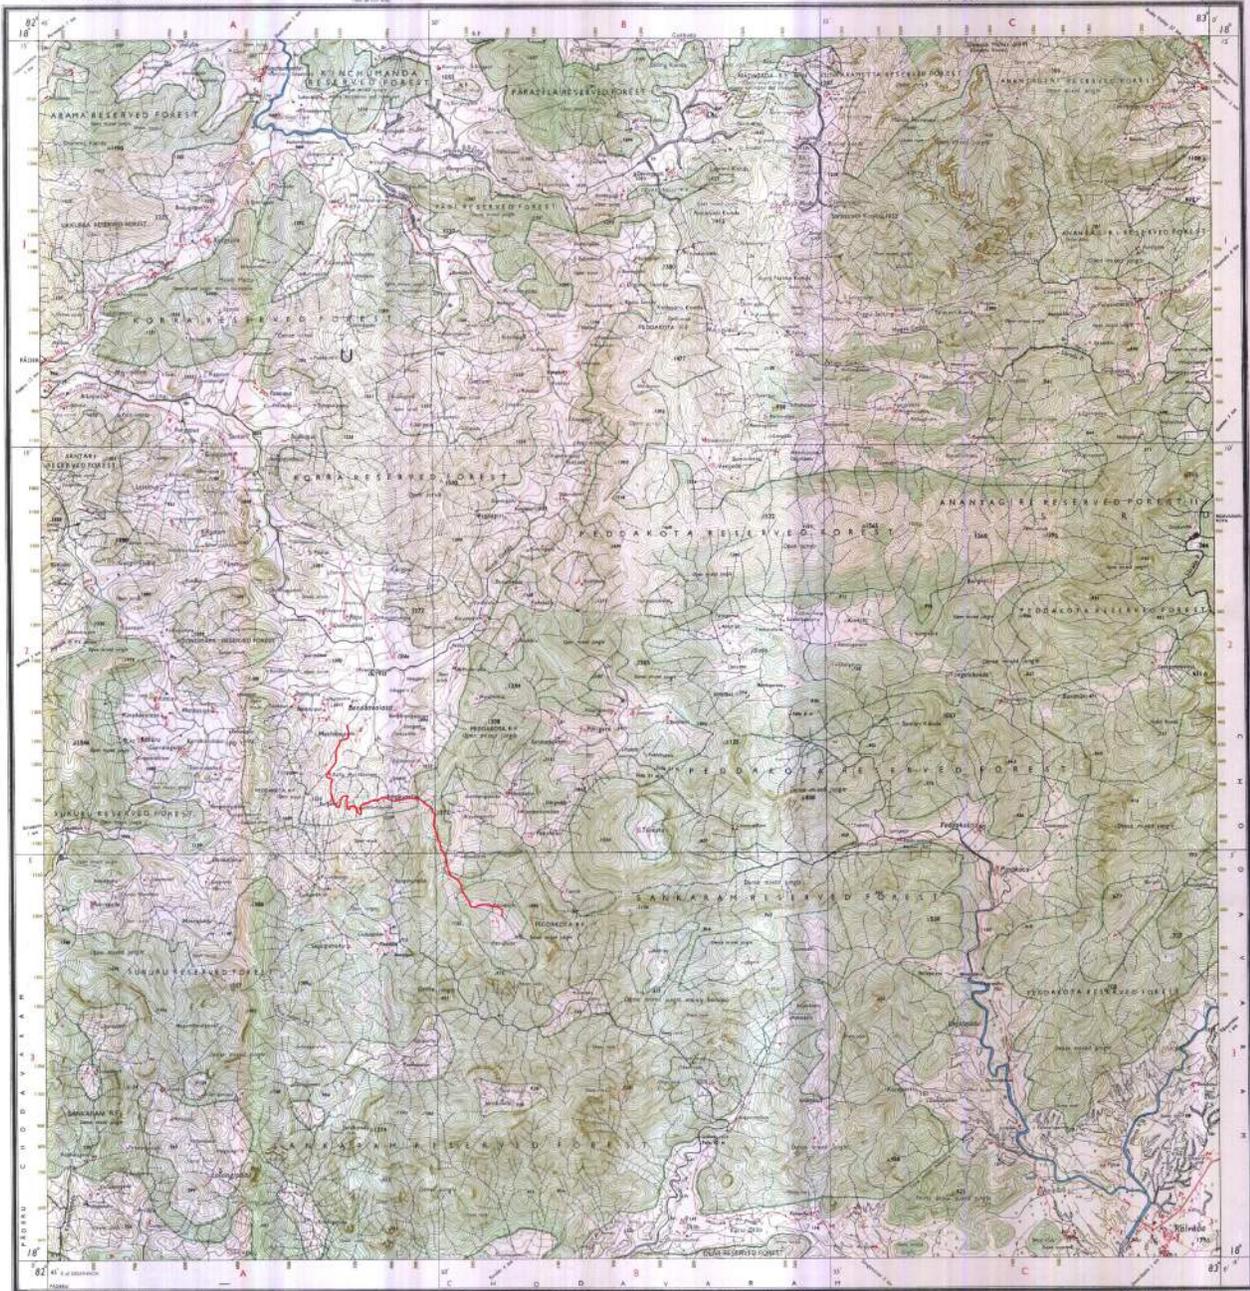

INDEX TO SHEETS

48 1/16	48 2/16	48 3/16	48 4/16
48 5/16	48 6/16	48 7/16	48 8/16
48 9/16	48 10/16	48 11/16	48 12/16

SYMBOLS


HEIGHTS & CONTOURS IN METRES

CONTOUR INTERVAL: 20 METRES





1:50,000

Scale: 1:50,000











REFER TO THIS MAP AS 1:50,000
SHEET 48 1/16 FIRST EDITION
INDIA

Copyright © 1976 Survey of India
Printed in India