





Sheet No-3

INDIA
REFER TO THIS MAP AS - 1:50,000
SHEET 63L/7 FIRST EDITION

MADHYA PRADESH

FIRST EDITION

No. 63 L

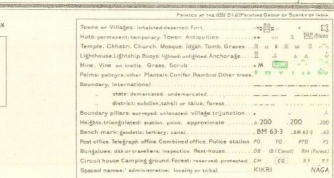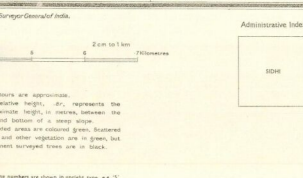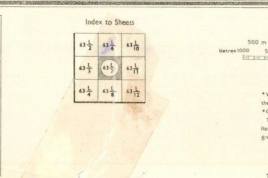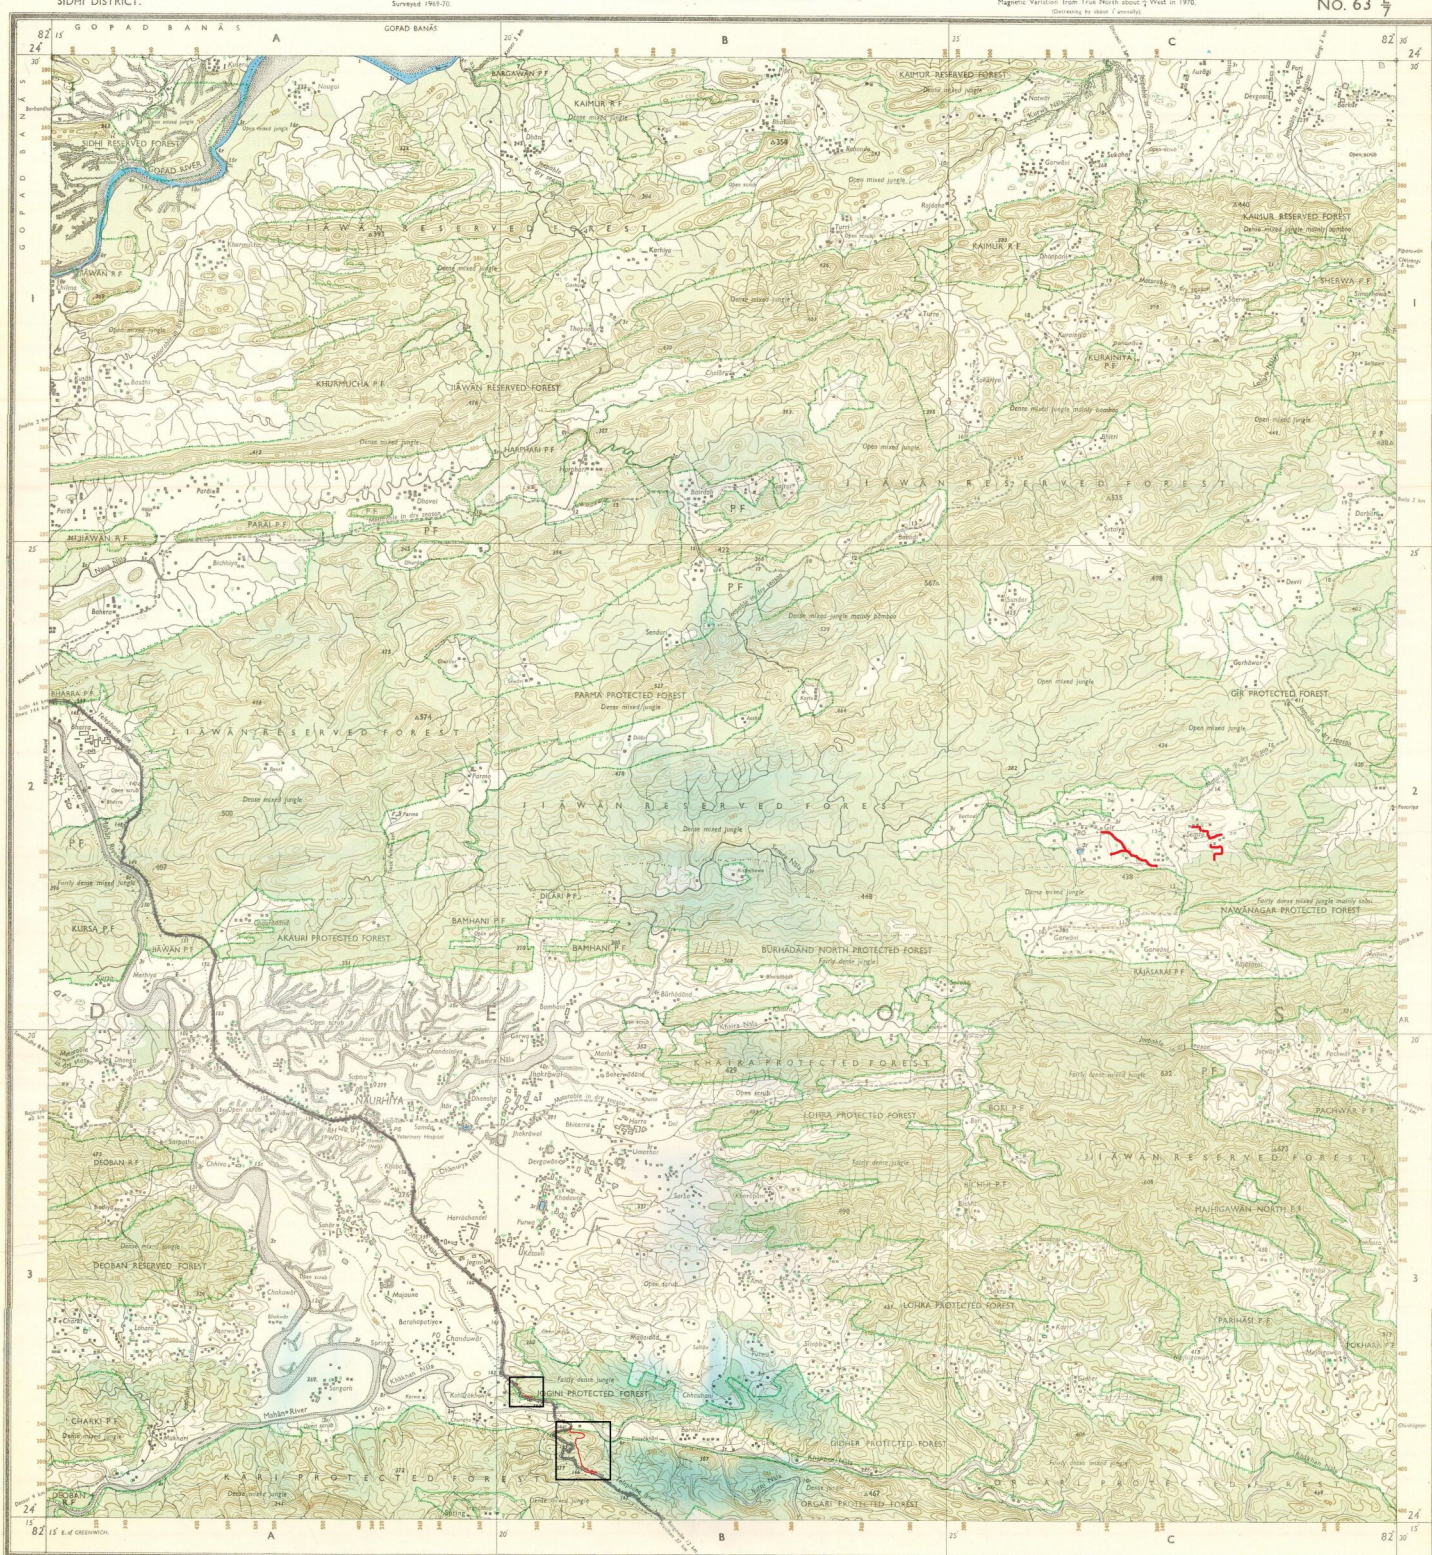

REFER TO THIS MAP AS - 1:50,000
SHEET 63 L/7 FIRST EDITION
INDIA

GOVERNMENT OF INDIA COPYRIGHT, 1975.
Price: Five Rupees.

SIDHI DISTRICT.

Surveyed 1969-70




Published under the direction of Major-General K.L. Khosla, B.Sc., B.E. (Civil), F.I.S., F.I.E., F.I.G.U., M.A.S.C.E. (U.S.A.), Surveyor General of India.

1976.
52,000

Administrative Index

PRINTED AT THE 104 (MID) PRINTING GROUP OF SURVEY OF INDIA

[illegible]

GOVERNMENT OF INDIA COPYRIGHT, 1976.

REFER TO THIS MAP AS :- 1:50,000
SHEET 63 L/8 FIRST EDITION

INDIA

MADHYA PRADESH
UTTAR PRADESH


FIRST EDITION

Magnetic Variation from True North about $\frac{1}{4}^{\circ}$ West in 1970.
(Decreasing by about $1'$ annually).

No. 63 $\frac{L}{12}$

SIDHI DISTRICT.
MIRZĀPUR DISTRICT.

Surveyed 1969-70

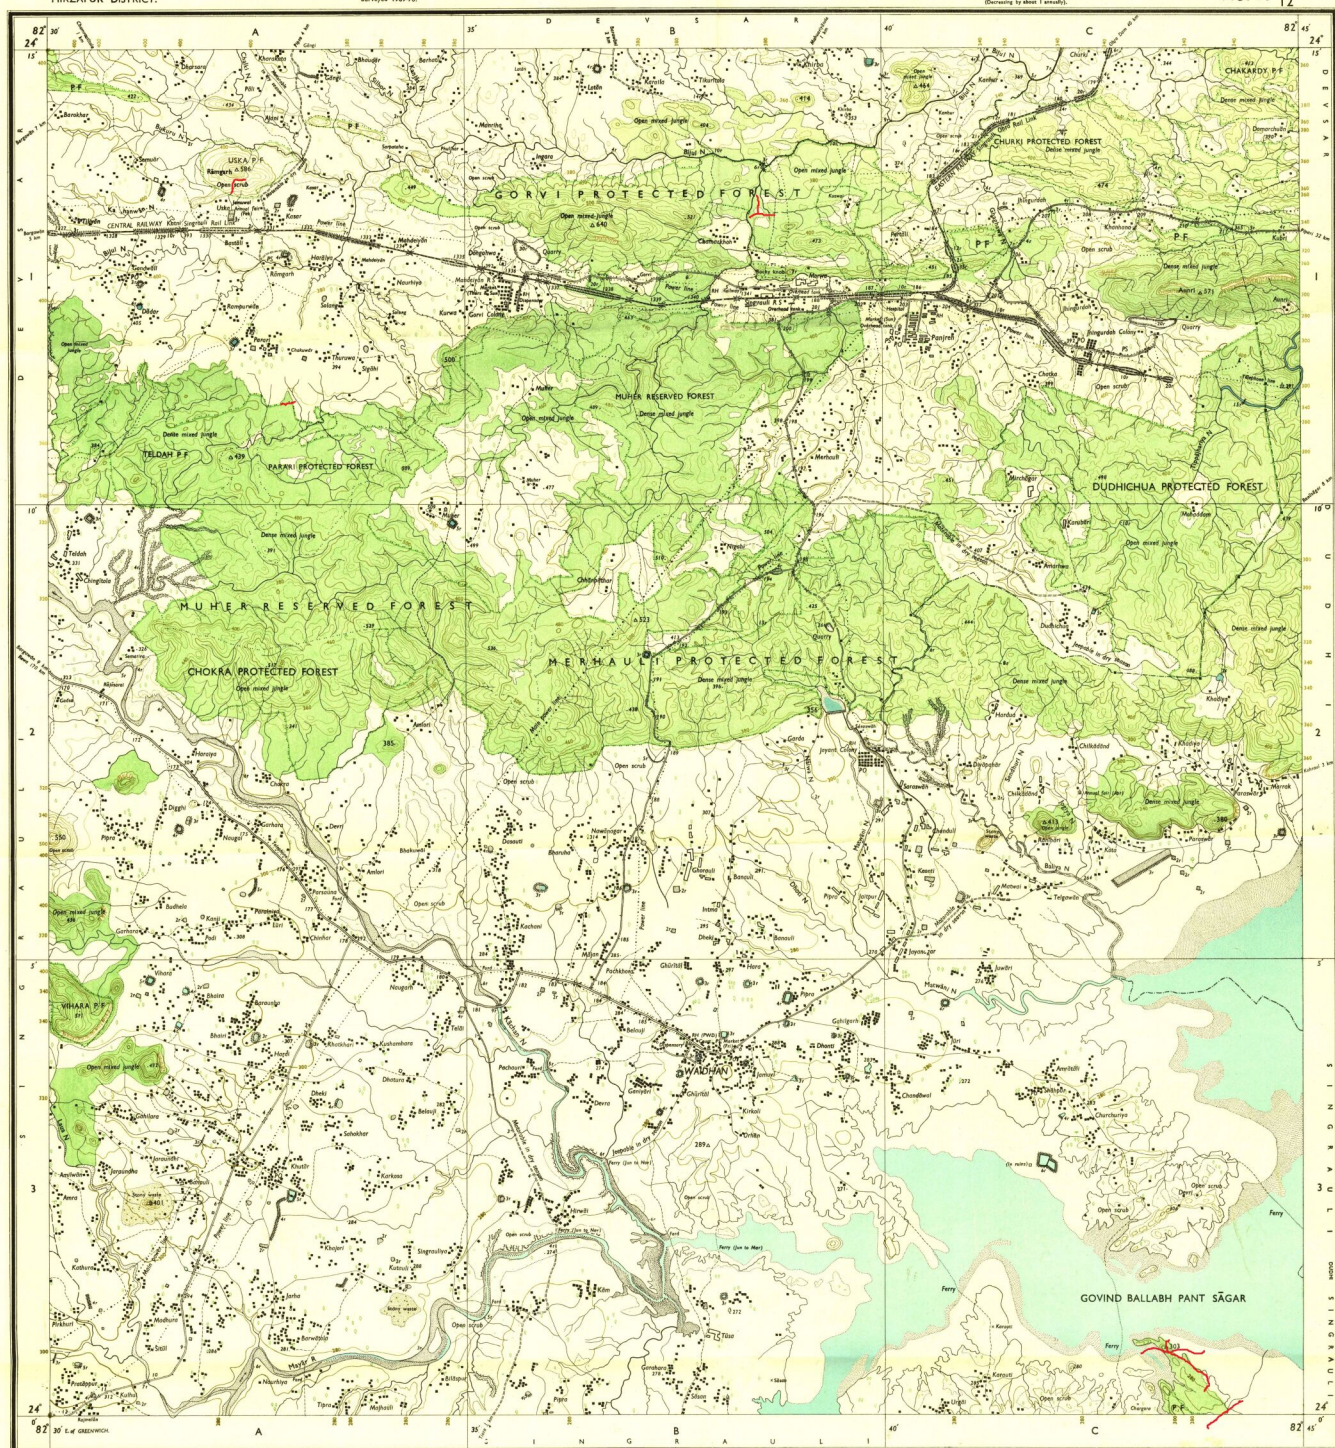[illegible]

$63\frac{L}{7}$	$63\frac{L}{11}$	$63\frac{L}{15}$
$63\frac{L}{8}$	$63\frac{L}{12}$	$63\frac{L}{14}$
$64\frac{1}{5}$	$64\frac{1}{9}$	$64\frac{1}{13}$

Published under the direction of Major-General K. L. Khosla, BSc, BE (Civil), FIS, FIE, FIGU, MASCE (U.S.A.), Surveyor General of India.

500 m to 1 cm

1:50,000

2 cm to 1 km

HEIGHTS & CONTOURS IN METRES
CONTOUR INTERVAL 20 METRES

*Water features are shown in blue where they generally contain water.

The exterior boundaries of areas of Reserved or Protected Forests are shown by



The state boundary between Madhya Pradesh and Uttar Pradesh States has been surveyed as pointed out by the local officials on the ground but has not been verified by the Government concerned.

For the first time, reports by the appropriate agencies:

Administrative Index

[illegible]

© GOVERNMENT OF INDIA. COPYRIGHT, 1976

REFER TO THIS MAP AS :- 1:50,000
SHEET 63 L/12 FIRST EDITION
INDIA

निर्यात के लिए नहीं NOT FOR EXPORT

MADHYA PRADESH
UTTAR PRADESH

FIRST EDITION

INDIA
REFER TO THIS MAP AS - 1:50,000
SHEET 63 L/16 FIRST EDITION

No. 63 L/16

SIDHI DISTRICT
MIRZAPUR DISTRICT.







Surveyed 1966-67

Magnetic Variation from True North about 1° West in 1970.
(Decreasing by about 1° annually)



Index to Sheets


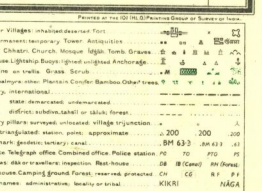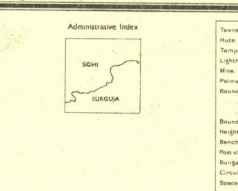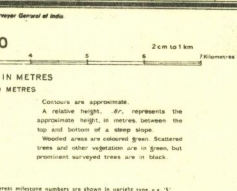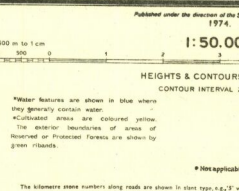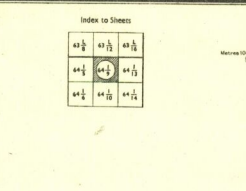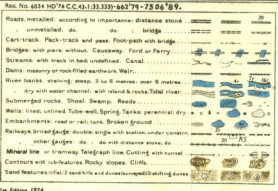

MADHYA PRADESH
UTTAR PRADESH

FIRST EDITION

Magnetic Variation from True North about 4° West in 1975.
(Changing at about 1° annually)

No. 64 1/13

SIDHI & SURGUJA DISTRICTS.
MIRZAPUR DISTRICT.

Surveyed 1967-68.



Scale 1:50,000
500 m to 1 cm
1 inch to 1.25 miles

HEIGHTS & CONTOURS IN METRES
CONTOUR INTERVAL 20 METRES

Water features are shown in blue where they generally contain water. Cultivated areas are coloured yellow. The exterior boundaries of areas of Reserved or Protected Forests are shown by green lines.

* Not applicable

Index to Sheets


Administrative Index


