



Scale: 1:50,000

HEIGHTS & CONTOURS IN METRES  
CONTOUR INTERVAL 20 METRES

Water features are shown in blue where they generally contain water. Cultivated areas are coloured yellow. The exterior boundaries of areas of Reserved or Protected Forests are shown by green ribbons.

Contours are approximate. A relative height, *dr*, represents the approximate height, in metres, between the top and bottom of a steep slope. Wooded areas are coloured green. Scattered trees and other vegetation are in green, but prominent surveyed trees are in black.

Cart-tracks and unmetalled roads in this sheet are generally motorable in dry season. Permission to use those inside forest areas is required from the forest authorities. The kilometre stone numbers along roads are shown in slant type, e.g. '5' whereas milestone numbers are shown in upright type, e.g. '5'.

Tanks, shown dry in this area, usually contain water from July to March. Wells are numerous in squares C/1, 2, and 3, only the important ones have been shown.

Administrative Index

HAZARIBAG  
PALAMU

Plotted at the 1:25,000 (P.L.O.) Planning Group or Surveyor's Office

Towns or Villages: inhabited, deserted, Fort, Hill post, permanent temporary, Fort, Fortification, Temple, Chhatra, Chhatra, Mosque, Light, Tomb, Green, Lighthouse, Lightship, Buoy, Lighted, unlighted, Anchorage, Mine, Vine, on walls, Grass, Scrub, Palms: palm, other, Platanus, Conifer, Bamboo, Other trees, Boundary, International, State demarcated, undemarcated, district, sub-division, taluk, or taluk, forest, Boundary pillars surveyed, unvisited, village, junction, Height, unvisited, station, point, approximate, BM 63.3, 14.43, 43, Post office, Telegraph office, Combined office, Police station, P.O. 10, P.O. 15, Bungalow, dak or travellers, inspection, Rest-house, DB, BH (Cantt), BH (Forest), Circuit house, Camping ground, Forest, Rest-house, CH, CG, BH, P.F. Spaced names: administrative, locality or town, KIKKI, NAGA

1st Edition 1975. (Previous Edition on 1-inch scale: 1st 1928).

REFER TO THIS MAP AS: 1:50,000 SHEET 72 D/16 FIRST EDITION INDIA भारत

GOVERNMENT OF INDIA COPYRIGHT, 1978. Price: Ten Rupees.

SIGNATURE BY DFO

SIGNATURE BY APPLICANT

(ANNEXURE - II)

PROJECT ROAD  
REALIGNMENT  
FOREST AREA

DATE: 18/07/2016 - 12:00pm  
PATH: X:\VAD 21002\BAGHIND (PACKAGE-1)\Baghmore to Palam Road\FORST\TPO FOR FOREST BAGHIND\_PALAMU.dwg

# बिहार BIHAR

FIRST EDITION


भारत INDIA  
REFER TO THIS MAP AS : 1:50,000  
SHEET 72 D/12 FIRST EDITION

HAZARIBAG & PALAMU DISTRICTS.

Surveyed 1978-79.

Magnetic Variation from True North about  $\frac{1}{2}^{\circ}$  West in 1975.  
(Decreasing by about 1' annually).

No. 72 D/12

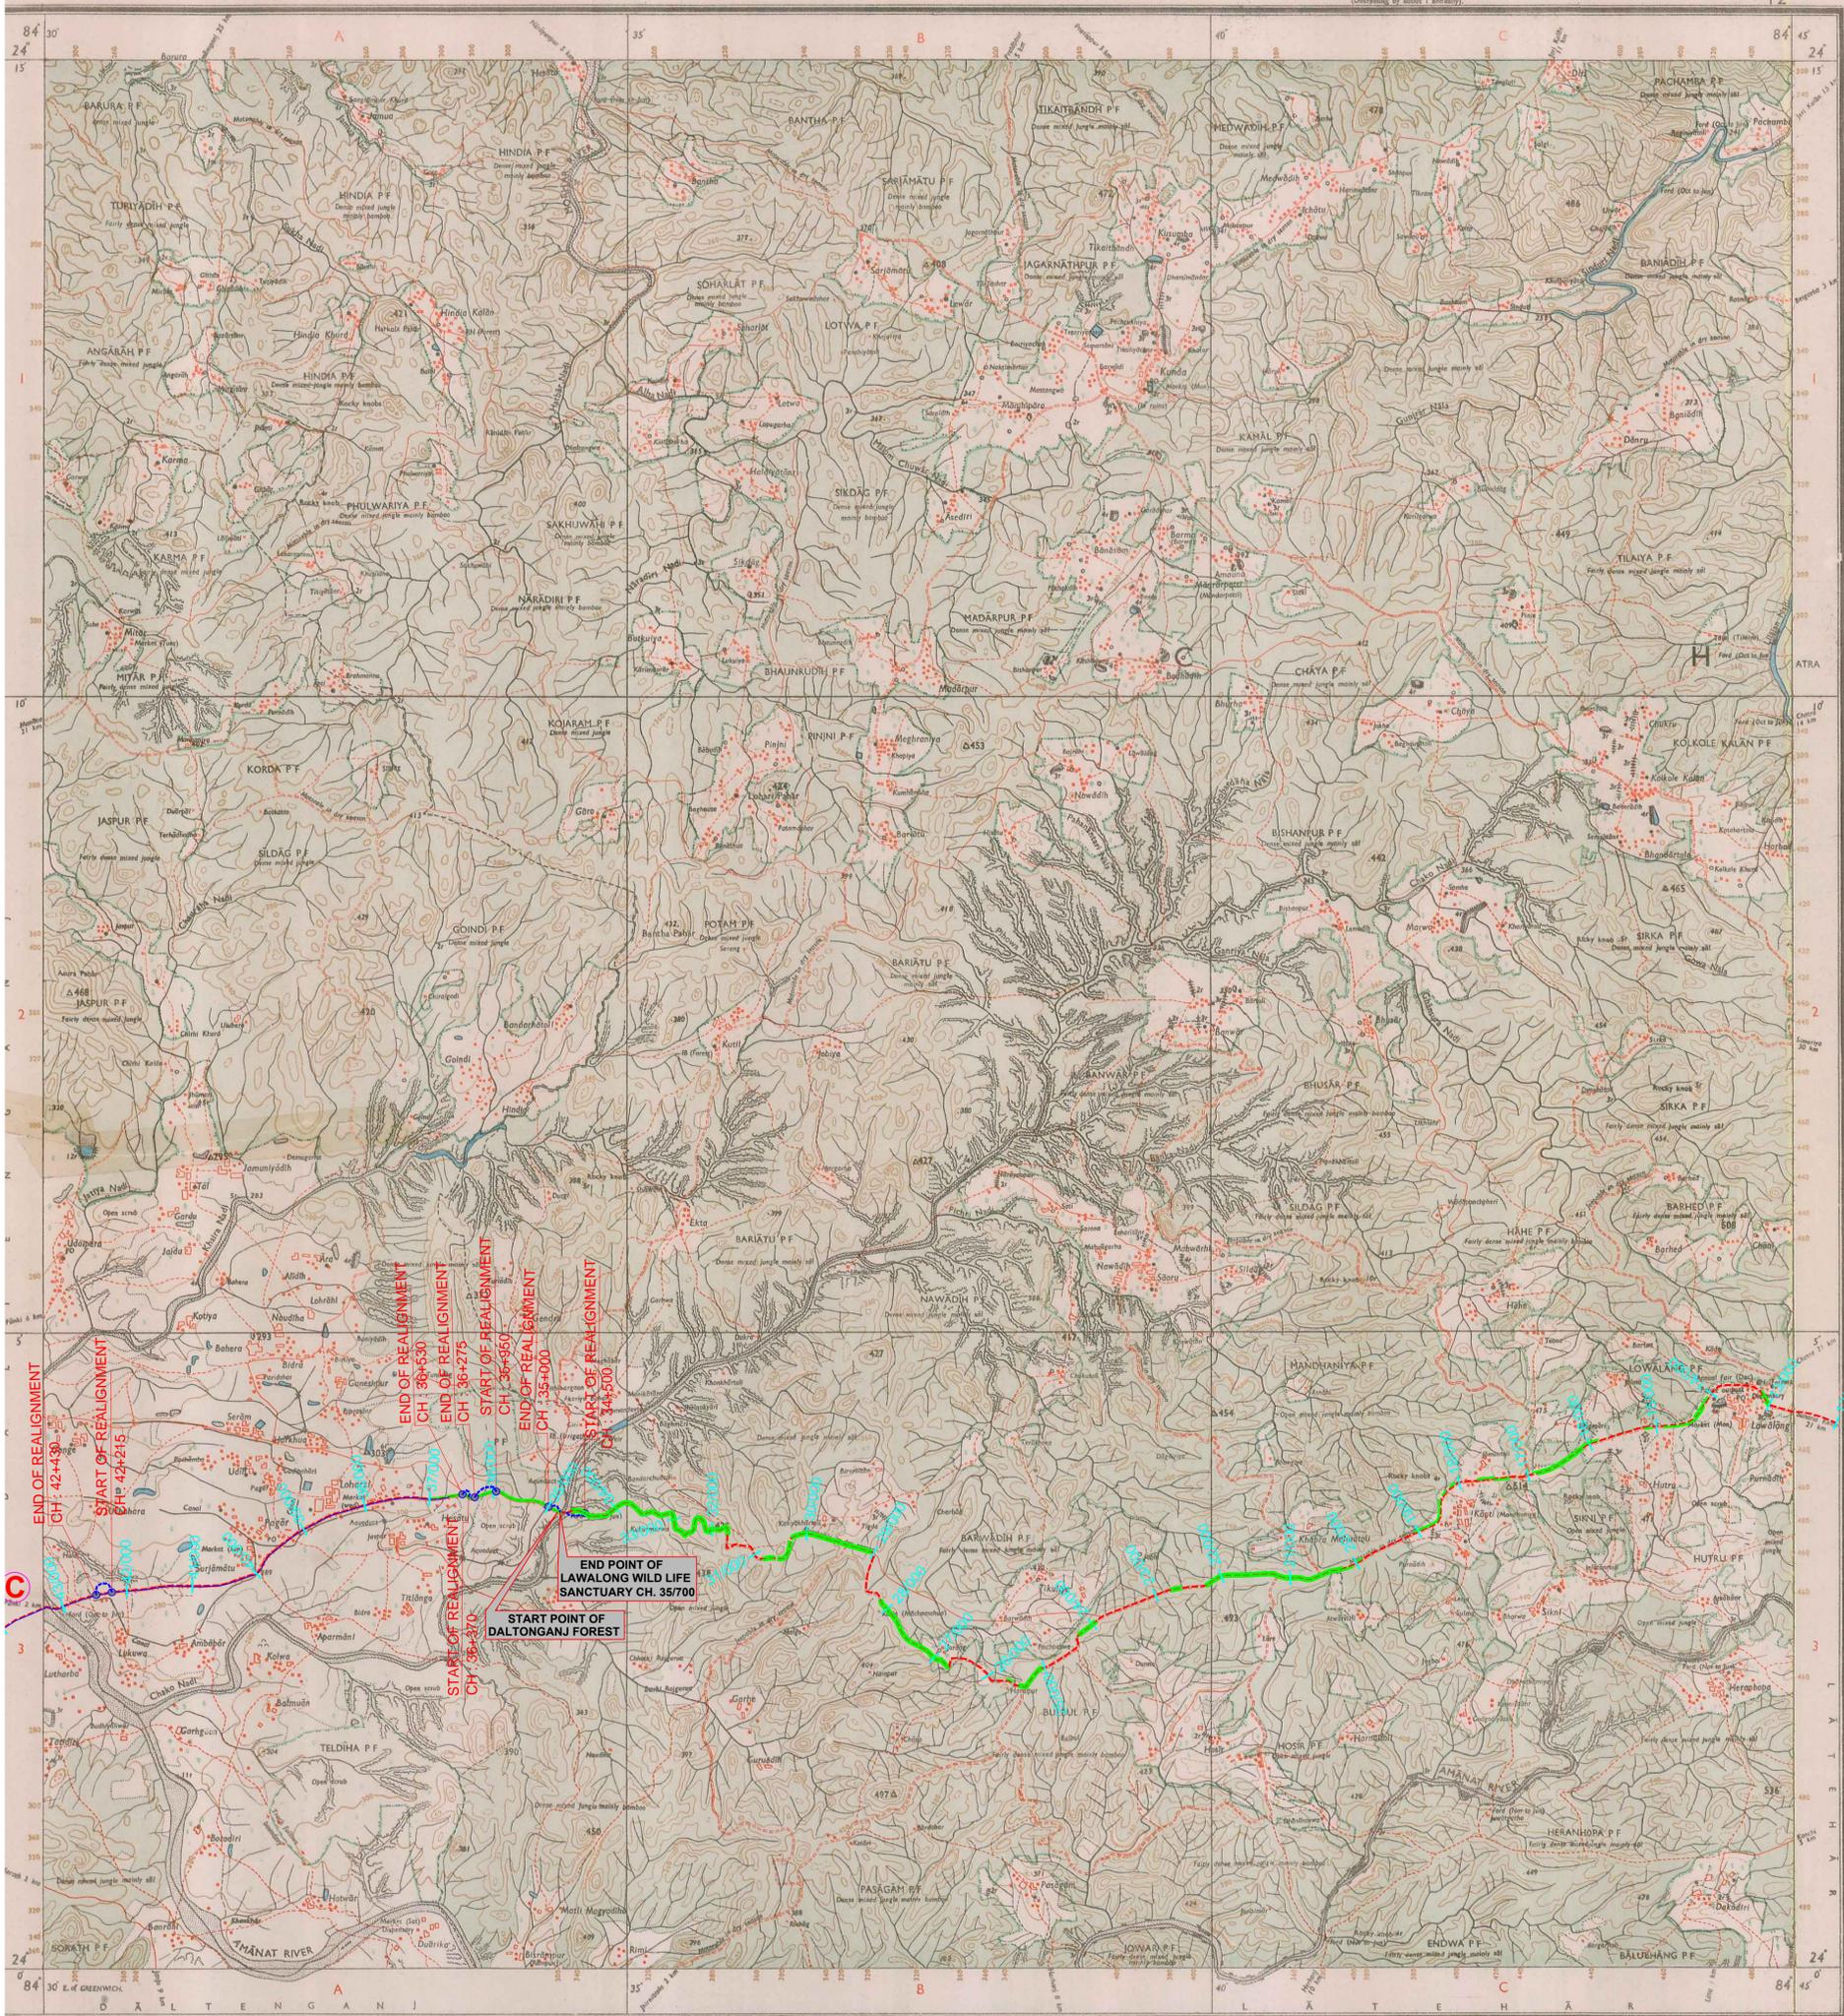

No. 4757 D/12 (S.C. 241-11333) & O/2/84


Index to Sheets


Scale: 1:50,000  
500 m to 1 cm  
2 cm to 1 km  
750 metres

HEIGHTS & CONTOURS IN METRES  
CONTOUR INTERVAL 20 METRES

\*Water features are shown in blue where they generally contain water.  
\*scattered areas are coloured yellow.  
The exterior boundaries of areas of Reserved or Protected Forests are shown by green ribbons.

Contours are approximate.  
A minimum height, 20', represents the approximate height, in metres, between the top and bottom of a steep slope.  
Wooded areas are coloured green. Scattered trees and other vegetation are in green, but prominent surveyed trees are in black.

\*Not applicable.

The milestone stone numbers along roads are shown in slant type, e.g., '5' whereas milestone numbers are shown in upright type, e.g., '5'.

Forest boundaries at some places have not been shown for want of reliable information.  
Tracks in this area usually contain water from July to October.  
Cultivation is periodic and dependent on rainfall.



Spaced names, administrative, locality or tribal	KIKRI, NAGA

SIGNATURE BY D F O

SIGNATURE BY APPLICANT

REFER TO THIS MAP AS : 1:50,000  
SHEET 72 D/12 FIRST EDITION  
INDIA भारत

GOVERNMENT OF INDIA COPYRIGHT, 1981.  
Price: Five Rupees.  
(ANNEXURE - II)  
PROJECT ROAD  
REALIGNMENT  
FOREST AREA

DATE: 18/02/2016 - 15:01:16  
PATH: K:\72 D\3302\BANKING (PACKAGE-1)\BANKING-1\TOPIC FOR FOREST BANKING.dwg